


2" FLEX FROM MODULE 1
CONT'D
DRG. NO. FF 83-20-10-2565

INTERMEDIATE DRILLING DECK

LOWER DRILLING DECK

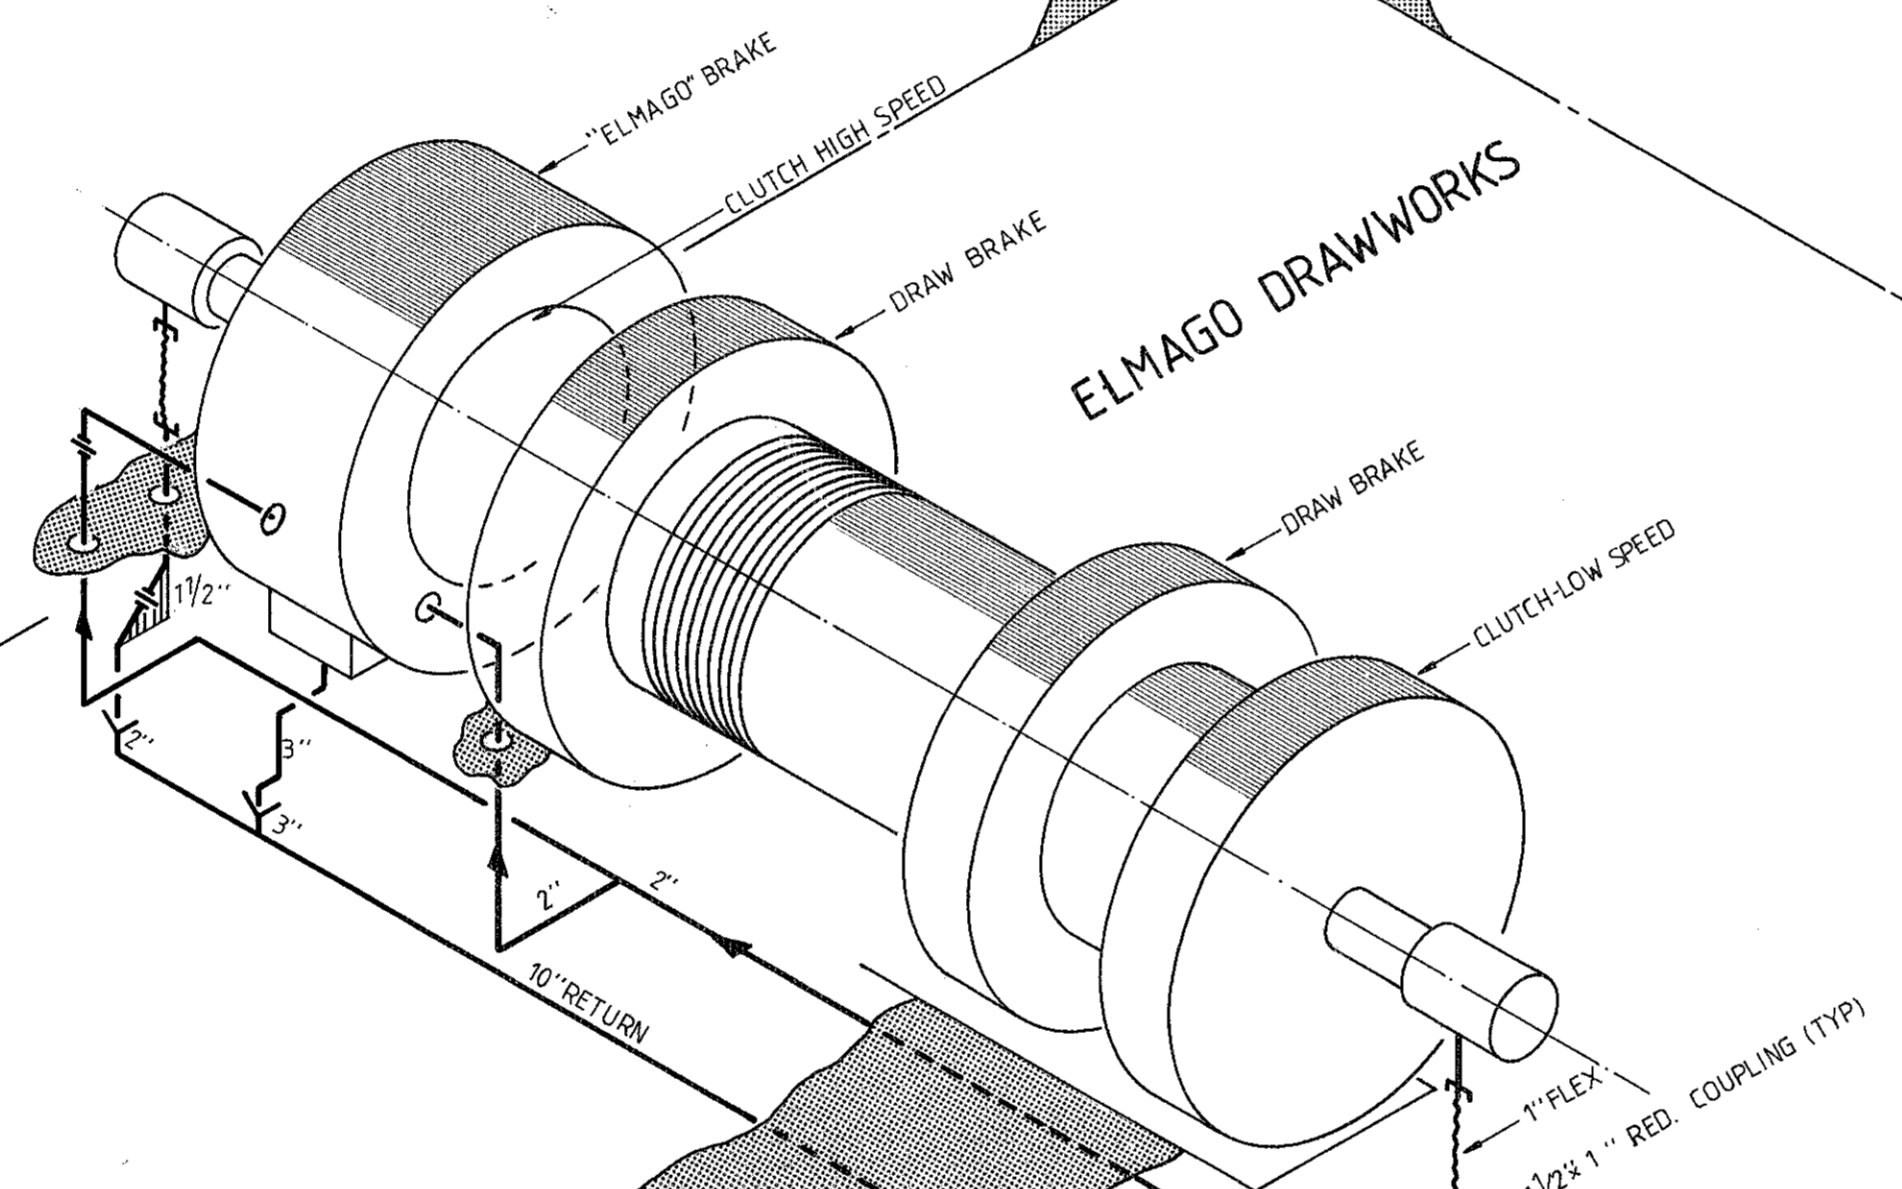


ELMAGO DRAWWORKS

1/2" INST. LINE TO
DRILLERS HUT

2" VENTS

INDUSTRIAL WATER TANK

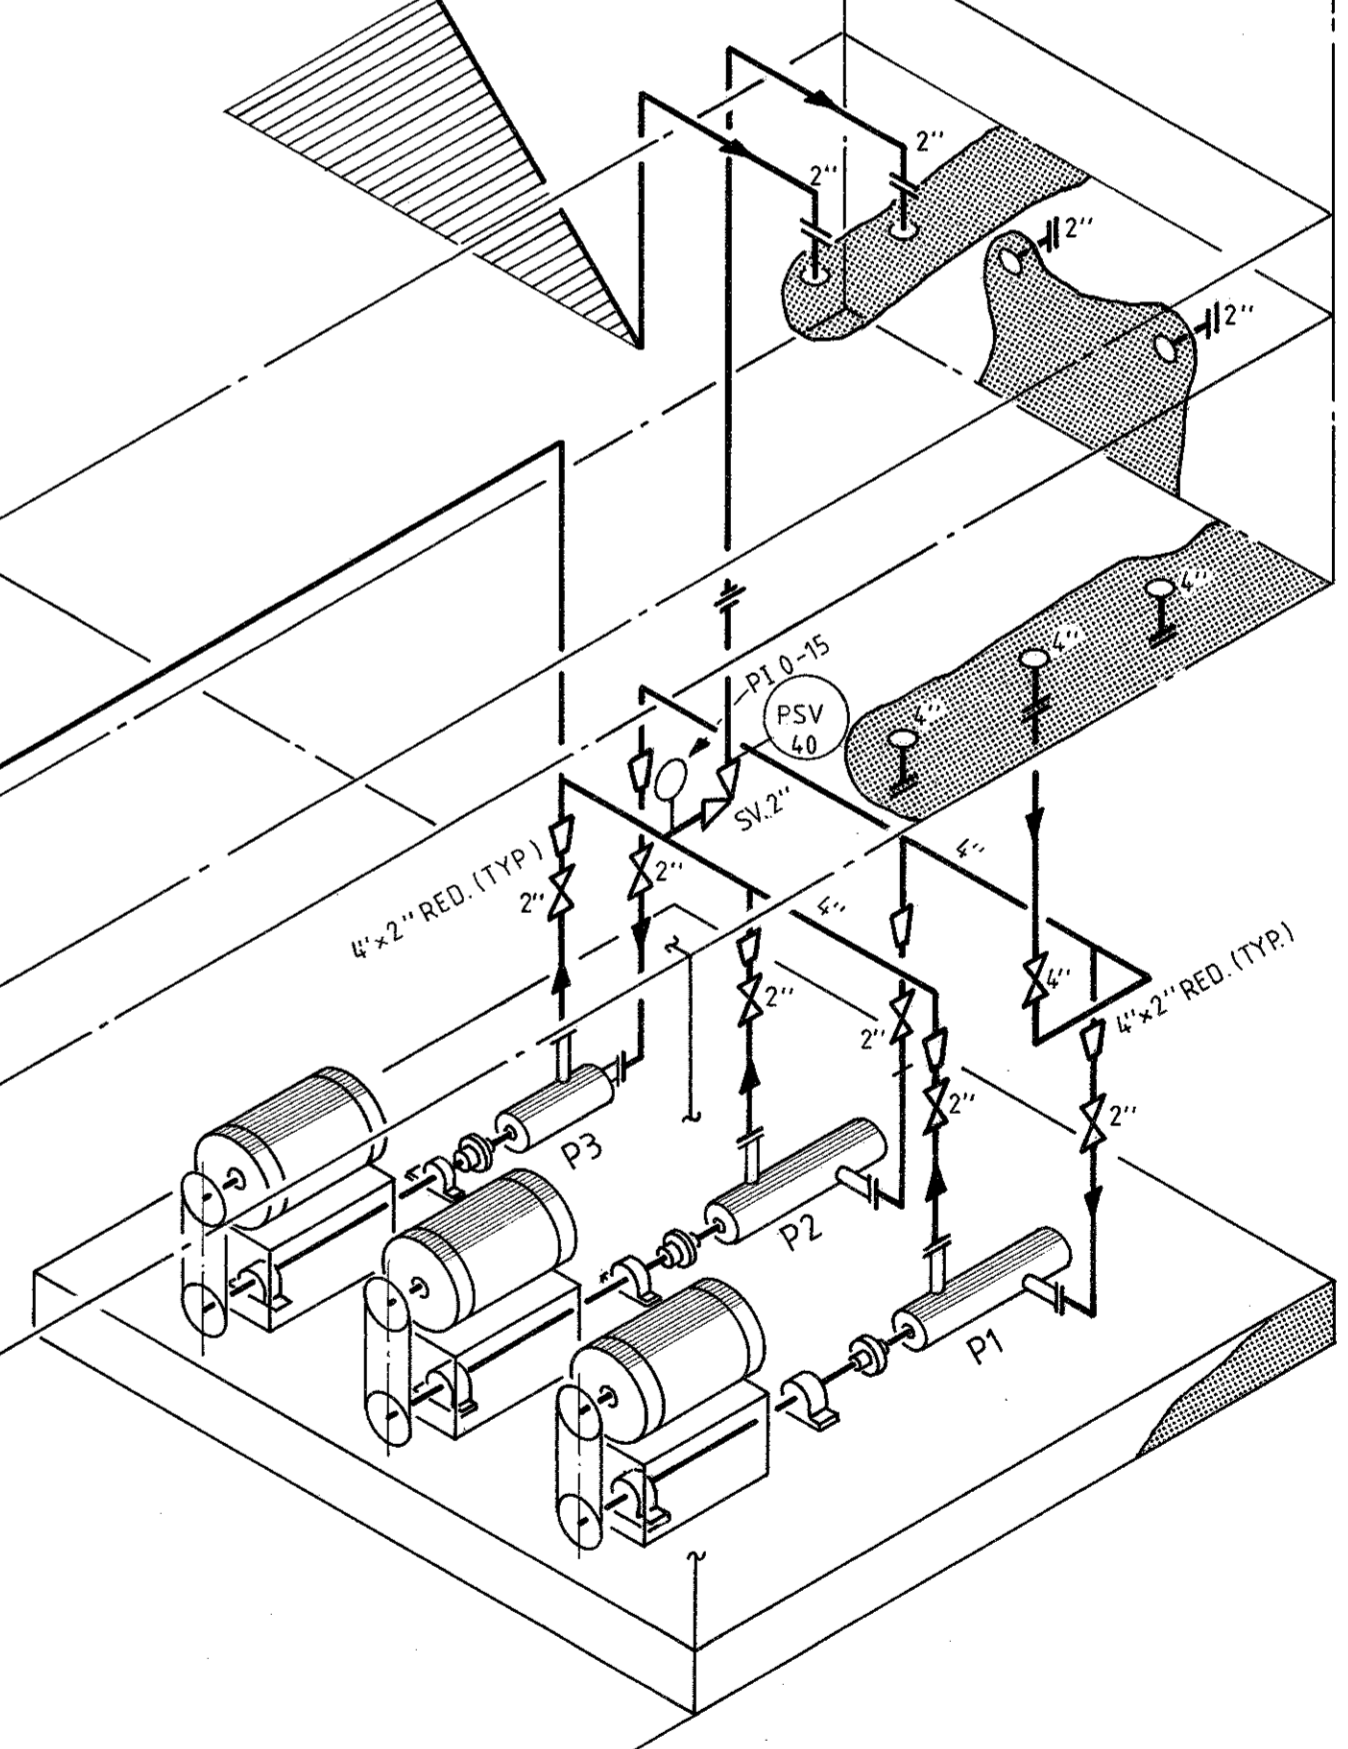

MANHOLE

LEVEL GAUGE

AS BUILT

| | | | |
|----------------|---------|---------------------------------------------|--------------------|
| B | 23.2.83 | UPDATED PSV TAG NO. | T.D |
| A | 27.4.82 | REDRAW-FINAL DWG INCLUDING CLIENTS COMMENTS | GG |
| 0 | 21.1.82 | FIRST ISSUE PRELIM FOR CLIENTS COMMENTS | MJJ |
| rev. | date | DESCRIPTION | by app. |
| | | Date: APRIL-82 | Project N°: 81-287 |
| | | Approved: D.Lawley | |
| | | | |
| G.Gibson | | Installation System | INDUSTRIAL WATER |
| FEB-82 | | AXONOMETRIC OF | |
| Job no. 81-287 | | INDUSTRIAL WATER SYSTEM | |
| Scale NONE | | ON RIG- AS BUILT | |
| Drwg. no. | FF | 83 20 10 2572 | Rev. B Sheet 1/1 |

Scale A1 From 100:10 to 1:100