



EQUIP. NO.	DESCRIPTION	DRY W TONS	TOP. W.T. TONS	SUPPORT EL.
BD-005	FAN	0.125	N/A	36500
BD-008	FAN	0.175	N/A	35400
BO-003	SHUT OF DAMP	0.03	N/A	36000
BO-004	SHUT OF DAMP	0.04	N/A	37000
BO-005	SHUT OF DAMP	0.04	N/A	37000
BO-008	SHUT OF DAMP	0.04	N/A	36200
GA 100A	COOLING PUMP	0.25	N/A	32712
GA 100B	COOLING PUMP	0.25	N/A	32712
FS 003	FOAM MONITOR	0.125	N/A	35600
FS 004	FOAM MONITOR	0.125	N/A	35900
FS 006 A	DELUGE VALVE	1.7	2.5	32600
FS 006 B	DELUGE VALVE			32600

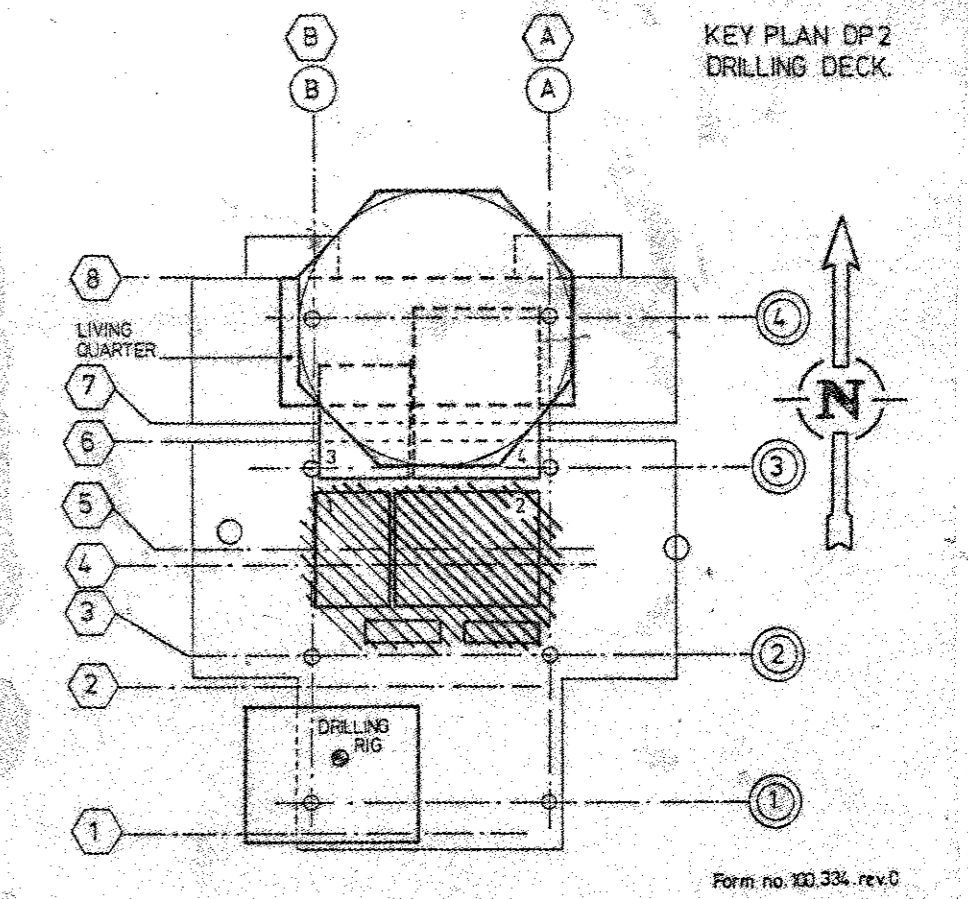

EQUIP. NO.	DESCRIPTION	DRY W TONS	TOP. W.T. TONS	SUPPORT EL.
IA-100	HYDR. AGITATOR	0.20	N/A	35042
IA-101	HYDR. AGITATOR	0.20	N/A	35042
IA-102	HYDR. AGITATOR	0.12	N/A	35042
IA-103	HYDR. AGITATOR	0.12	N/A	35042
IA-104	HYDR. AGITATOR	0.04	N/A	35042
IA-105	HYDR. AGITATOR	0.04	N/A	35042
IA-106	HYDR. AGITATOR	0.26	N/A	35042
IA-107	HOPPER	0.13	N/A	35250
	MUD CONTAINER			35400
IA-108	JET MIXER	REF. IA107		
BK-004	LOUVRE	0.07	N/A	35600
NF-100	CONT.PANEL H.AGI.	0.15	N/A	36200
HP-100	HYDR.POWERUN.	2.35	N/A	32600
FS-002	FOAM TANK	INCL. IN FS006A&B		32600
WL 100	OFFICE CONTAIN.		N/A	44820
BD-003	FAN	0.15	N/A	37000
BD-004	FAN	0.13	N/A	36500

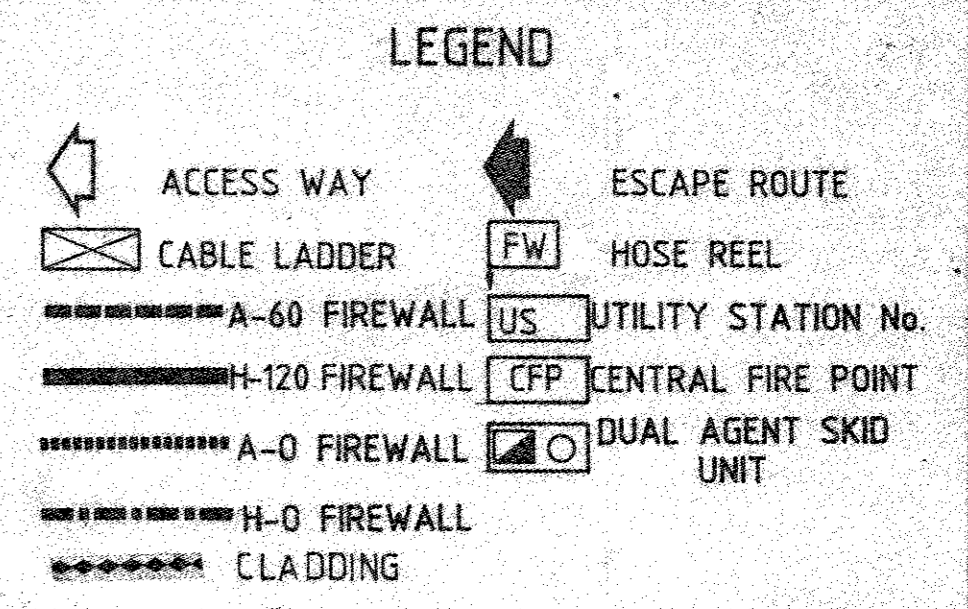

NOTE \* INDICATES NEW EQUIPMENT OR NEW INSTALLATIONS

REF DRG. NO.	TITLE
N 161S 1616	PLAN DU PLAFOND
FF-83-21-32-5103	DOOR'S
FF-83-21-32-5102	HANGER FOR HOSE
FF-83-21-32-5100	PRODUCT STORAGE PLATFORM
FF-83-21-32-5096	T. BOTTOM MOD. EXTER. TANKS
FF-83-21-32-5101	CONTAINER PLATFORM
FF-83-21-32-5097	TANK TOP EXTERNAL TANKS
FF-83-21-32-5099	ROOF ABOVE MUD HOPPER
FF-83-21-32-5092	TANK BOTTOM MODIA
FF-83-21-32-5125	AGITATOR SUPPORTS
FF-83-21-32-5093	TANK TOP ARR.
FF-83-20-00-1506	PIPING GEN. ARR.
FF-83-20-00-1507	PIPING GEN. ARR.
N 161 ST 0013	LOADS LOCATIONS

REV.	DATE	DESCRIPTION	BY	CHK	EM	PM	3.P	COMP
2	07.08.87	AS BUILT						
1	18.03.89	REISSUED FOR CONSTRUCTION						
0	16.12.88	FOR CONSTRUCTION						
D	02.12.88	RE-ISSUED FOR APPROVAL						
C	04.11.88	FOR APPROVAL						
B	13.10.88	FOR COMMENTS						
A	04.08.88	FOR I.D.E.						

**Dolphin as**

elf aquitaine norge as p.o. box 168 - 4001 Stavanger

Installation System  
DP 2 EQUIPMENT LAYOUT

**FRIGG FIELD**

Job no. 858  
Scale 1:50

**PLOT PLAN FOREX NEPTUN MUD/CEMENT MODULE**

Draw no. FF 83 00 00 1504

**nrc** norwegian rig consultants as  
BARSTØLVEIEN 26 N-4600 KRISTIANSDAL S. NORWAY  
PHONE 042 7 44 211 TELEK 21 789 nro n