


REFERENCES DRAWINGS

U/E DRAWINGS	PLAN VIEW	SECOND LEVEL
LIVING QUARTERS	LAYOUT	FRONTING, EL+131587
"	"	"
"	"	STAIR

ELF AQUITAINE NORSE DRAWINGS	LEVEL
VILLAGE LAYOUT	EL + 131570
LIVING QUARTER	EL + 131582
"	EL + 141330

FF 91 00 00 00 00 00	FF 91 00 00 00 00 00
FF 91 00 00 00 00 00	FF 91 00 00 00 00 00
FF 91 00 00 00 00 00	FF 91 00 00 00 00 00
FF 91 00 00 00 00 00	FF 91 00 00 00 00 00

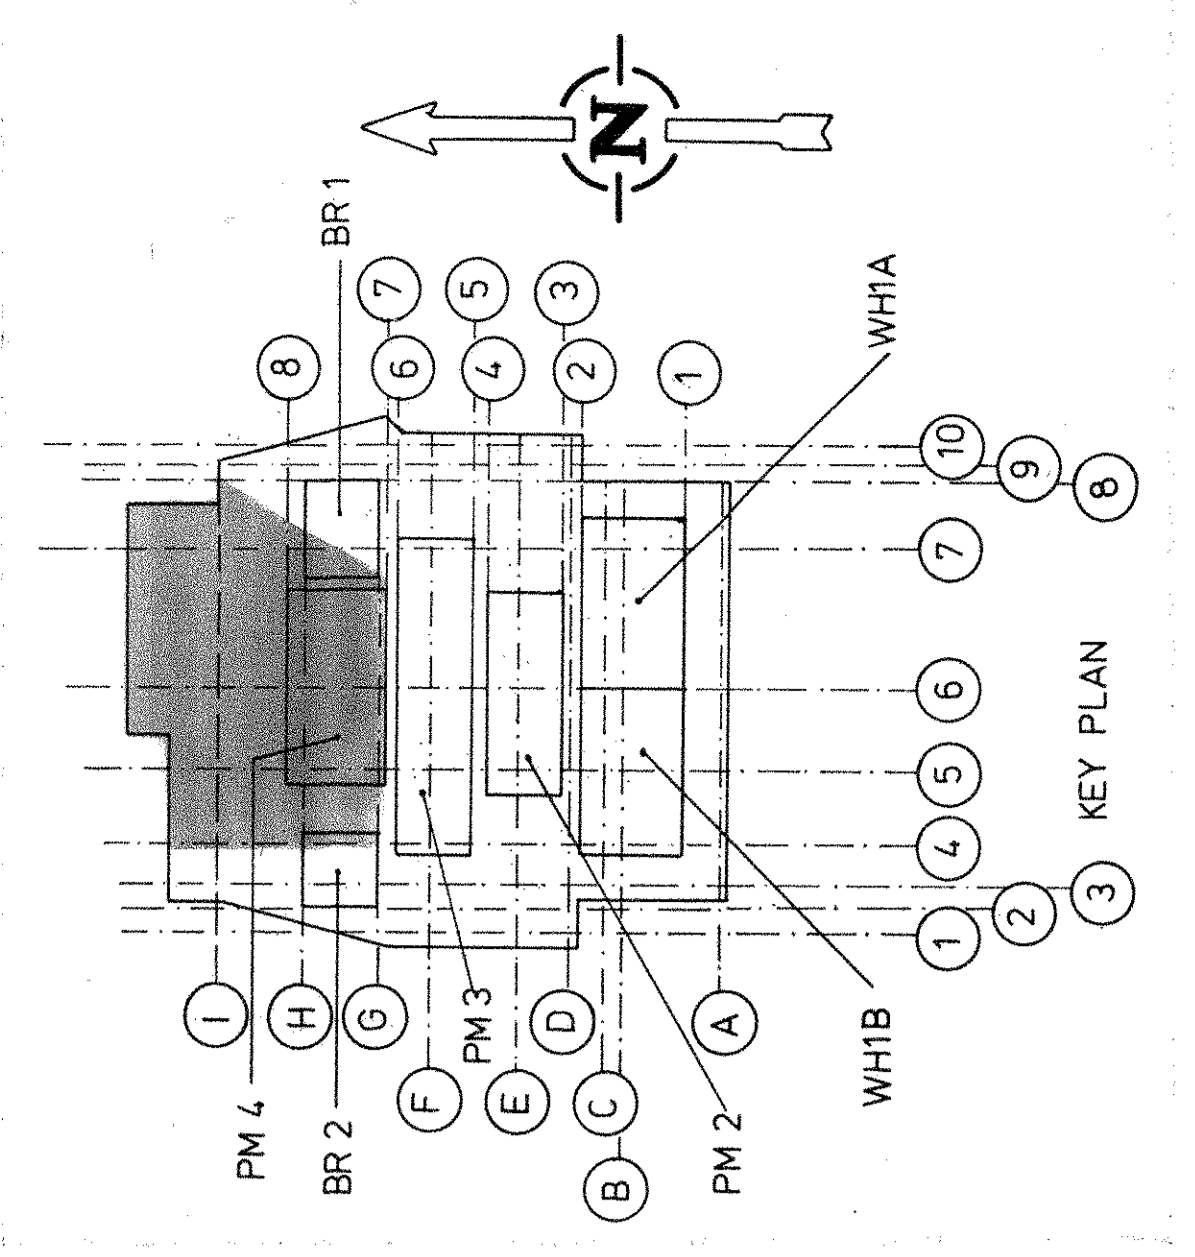

AS PLOTTED
UP TO 20:4.80

elf aquitaine norge a/s p.o. box 168 - 4001 Stavanger

DATE: 8/20/79
 DRAWN BY: CDP1 FRIGG FIELD
 CHECKED BY: LIVING QUARTERS
 APP'D BY: [Signature]
 SCALE: 1/50

PROJECT NO.: FF 91 00 00 00 21
 LAYOUT EL + 131587

Rev: 1, 29.1.86 - UP TO "As BUILT"