


REFERENCES DRAWINGS

- BROWN & ROOT DRAWINGS
- GEN. PLAN OF PLATFORM HX JPH COMBINATION BLEN.AA. 204B
- PLAN OF FIRE ESCAPE FROM BR1 TO PACKS & MAIN DECK CDP1 SS 33P
- DETAILS
- MR. BERHOTT HUBSON DRAWINGS
- DPT "UNIT D" DRILLING DECK FRAMING EM 1820. 246
- USE DRAWINGS
- LIVING QUARTERS ELEVATION
- TYPICAL SECTION
- SUPPLY DRAWINGS
- PACKAGE 6
- STRUCTURAL PLAN & SECTIONS J211 B-26
- LOADING QUARTER MAIN DECK J211 B-78S
- SMOKES CASES, GUNWAYS AND OPERATIONS SERVICE PLAN J211 B-132
- PACKAGE 5A
- STAIRS
- ELEVATIONS
- PLAN VIEW
- GENERATOR ROOM WALKWAYS
- OUTSIDE WALKWAY
- ELF AQUITAINE APOISE DRAWINGS
- VILLAGE LAYOUT UPPER LEVEL
- LIVING QUARTERS EL. 137527
- " " " " EL. 141330

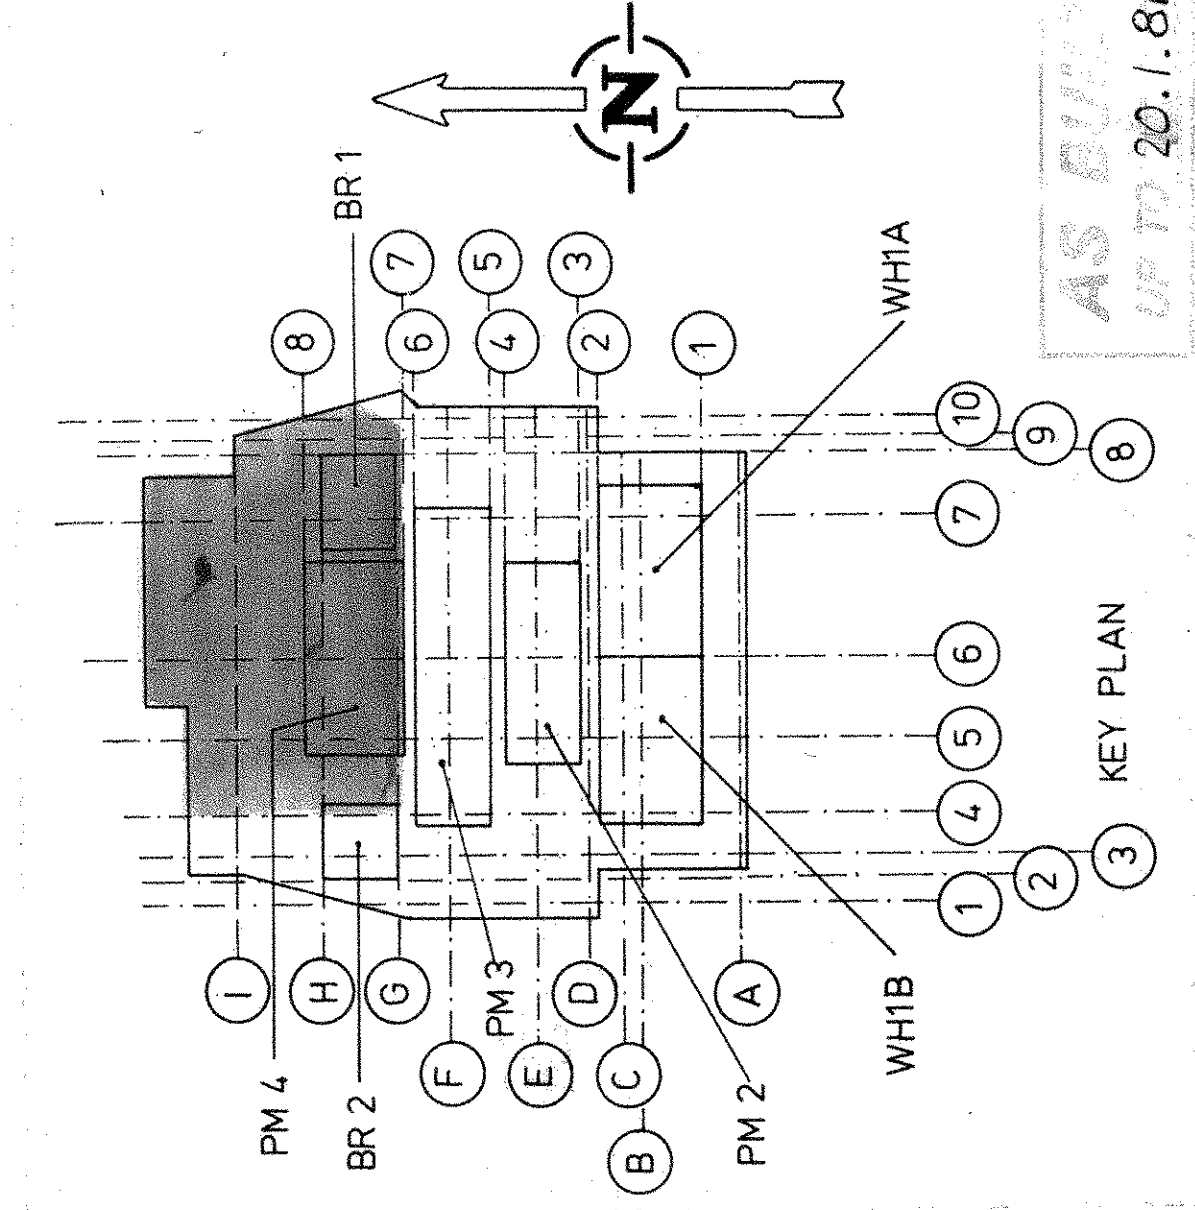

elf aquitaine norge a/s P.O. Box 188 - 4001 Skarvanger

DATE: 15/01/79
 DRAWN BY: [Signature]
 CHECKED BY: [Signature]
 APPR. BY: [Signature]
 SIZE: [Blank]

CDP1 FRIGG FIELD
LIVING QUARTERS

LAYOUT EL. + 135382

PROJECT NO.: FF 9100000022

REV. 1. 29.1.81. UP TO 'AS BUILT'