


RIG SIDE

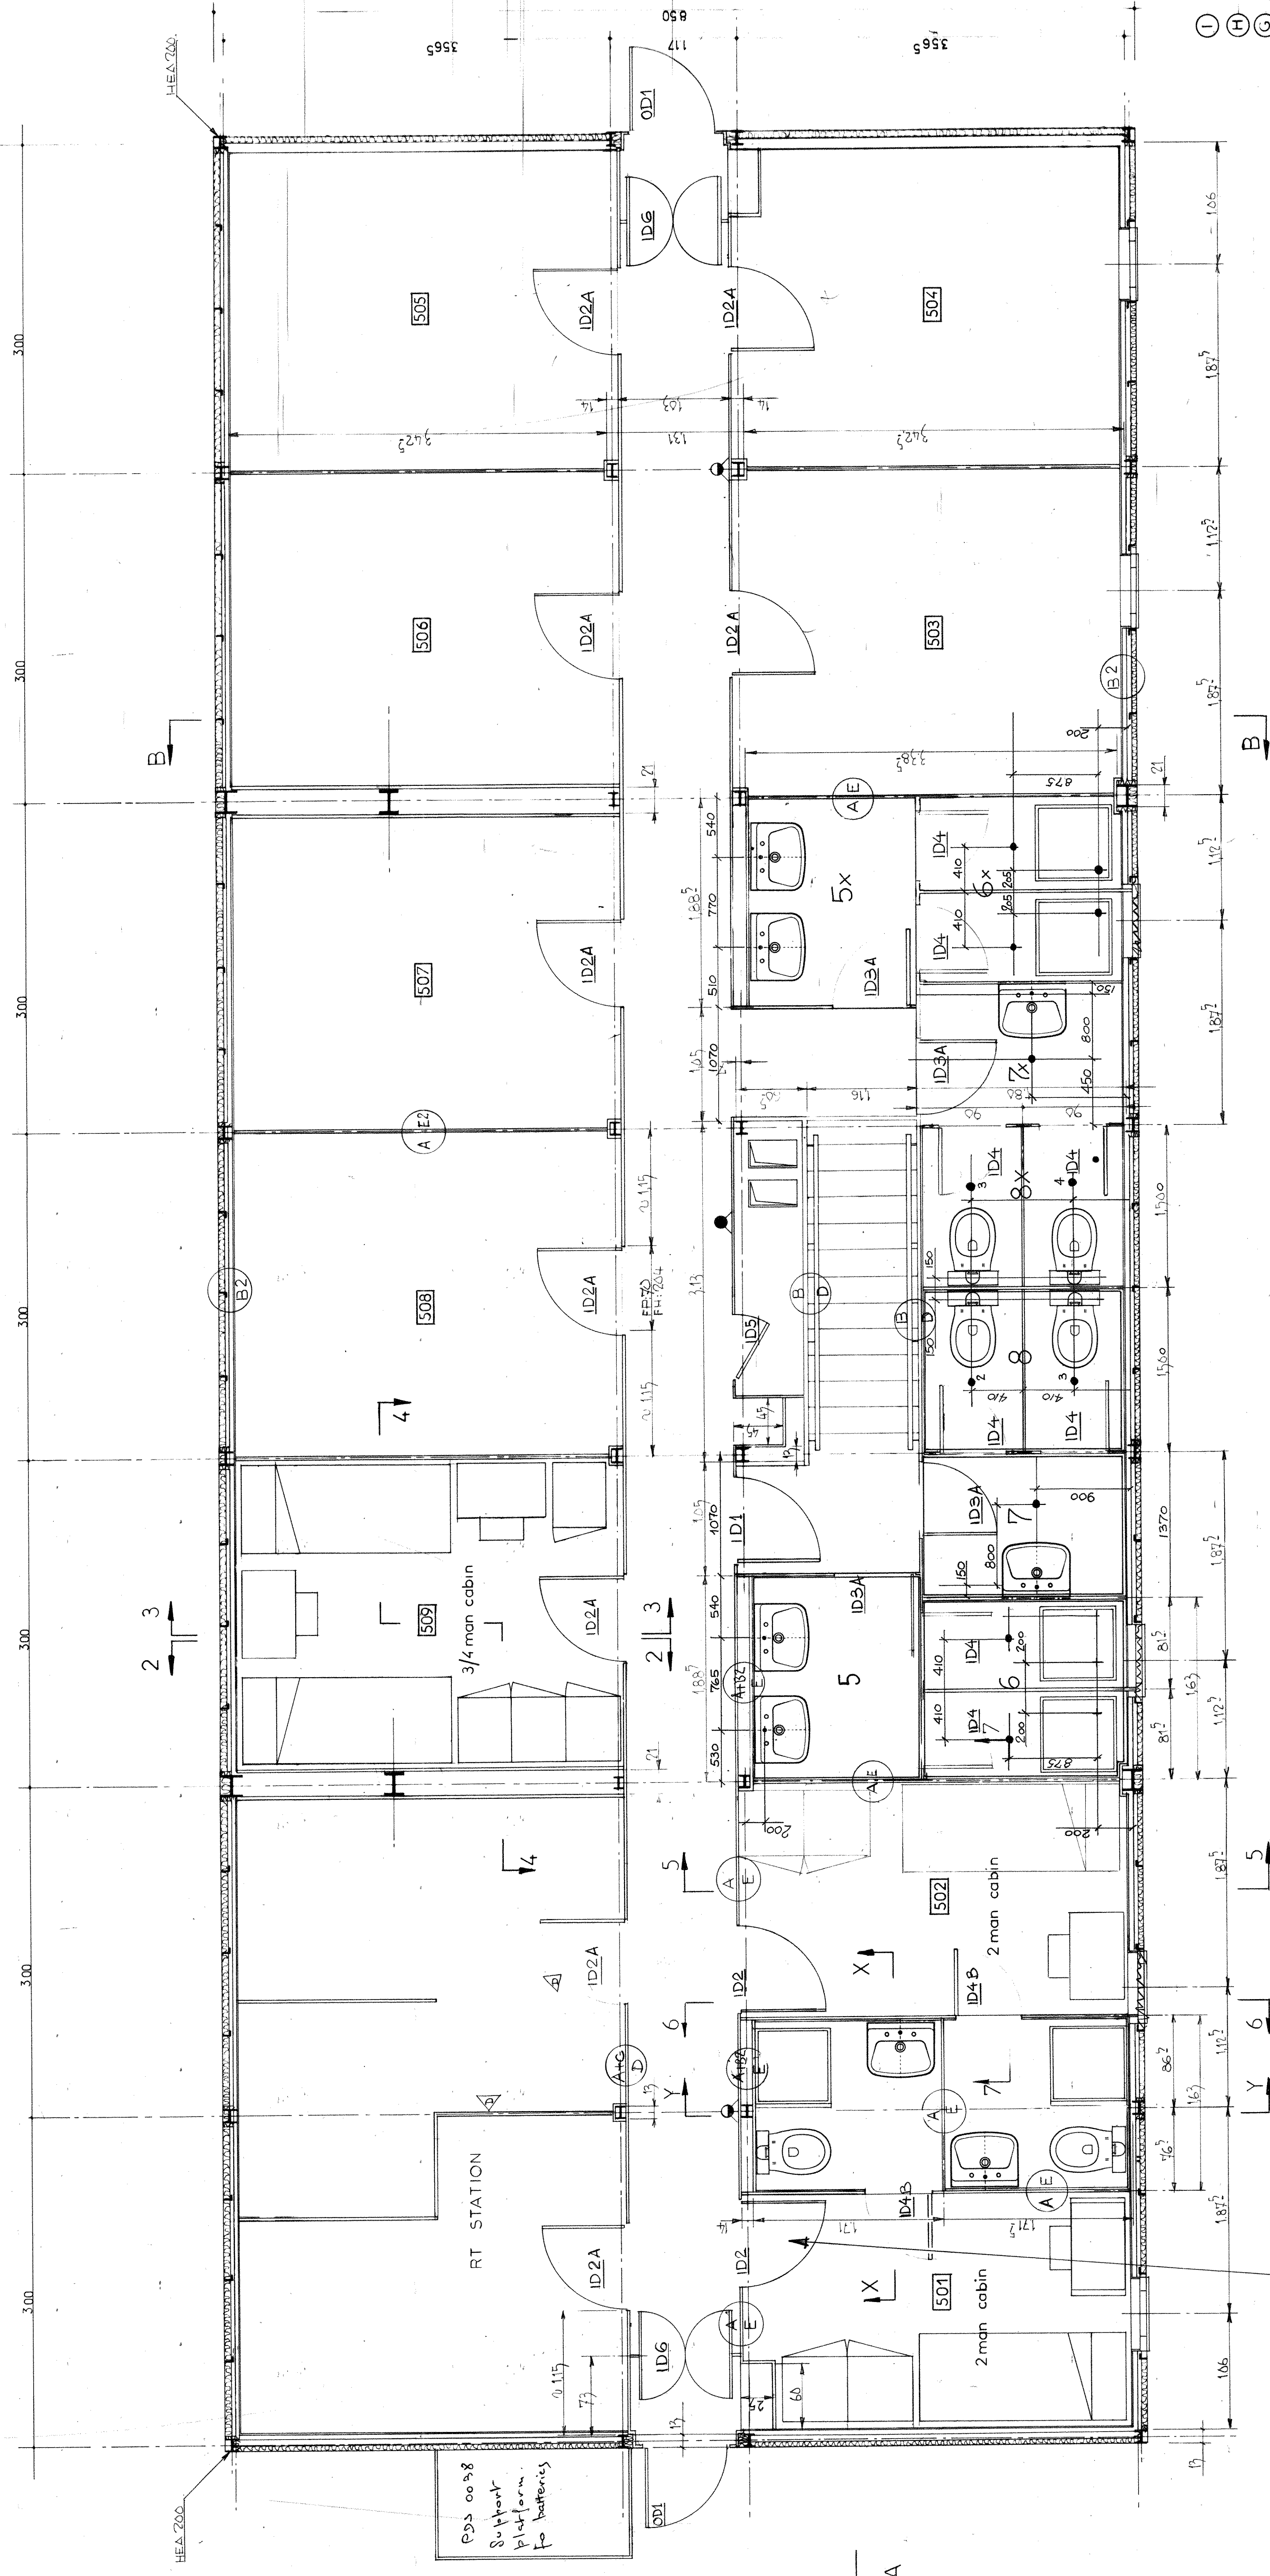


SEE DRAWINGS  
 PDS 00002 Details of window sealing  
 PDS 00020 Longitudinal view AA  
 PDS 00021 Transverse view BB  
 PDS 00023 Details 2 man room  
 PDS 00024 Details 3/4 man room  
 PDS 00057 Details of principle for bulkheads for all levels  
 PDS 00059 2 man room - 3/4 man room

NOTE: ALL DIMENSIONS ARE THEORETICAL AND REFER TO AXIS OF THE POSTS  
 - EXTERIOR EDGES OF STRUCTURES  
 - AXIS OF THE BULKHEADS  
 THEY HAVE TO BE CHECKED ON THE SPOT BEFORE STARTING THE PREFABRICATION AND INSTALLATION WORKS  
 FRANKFURT FOR ROOMS 503 TO 504 ARE IDENTICAL  
 DEF " " " " TO HIGH " "  
 SEE DWG PDS 00162 - 50-60

OD = OUTSIDE DOORS  
 OD1 FP 80 x FH (to be checked on site)  
 ID = INTERNAL DOORS (included in callouts)  
 ID1 FP 80 x FH 204  
 ID2 FP 70 x FH 204  
 ID3 FP 70 x FH 489+step 45  
 ID4 FP 60 x FH 489+step 45  
 ID5 FP 60 x FH 204  
 ID6 FP (2x4) x FH 204  
 A - DOORS WITH 500 CM<sup>2</sup> VENTILATION GRALE  
 B - " " 350 CM<sup>2</sup>

FP: FREE PASSAGE  
 FH: FREE HEIGHT

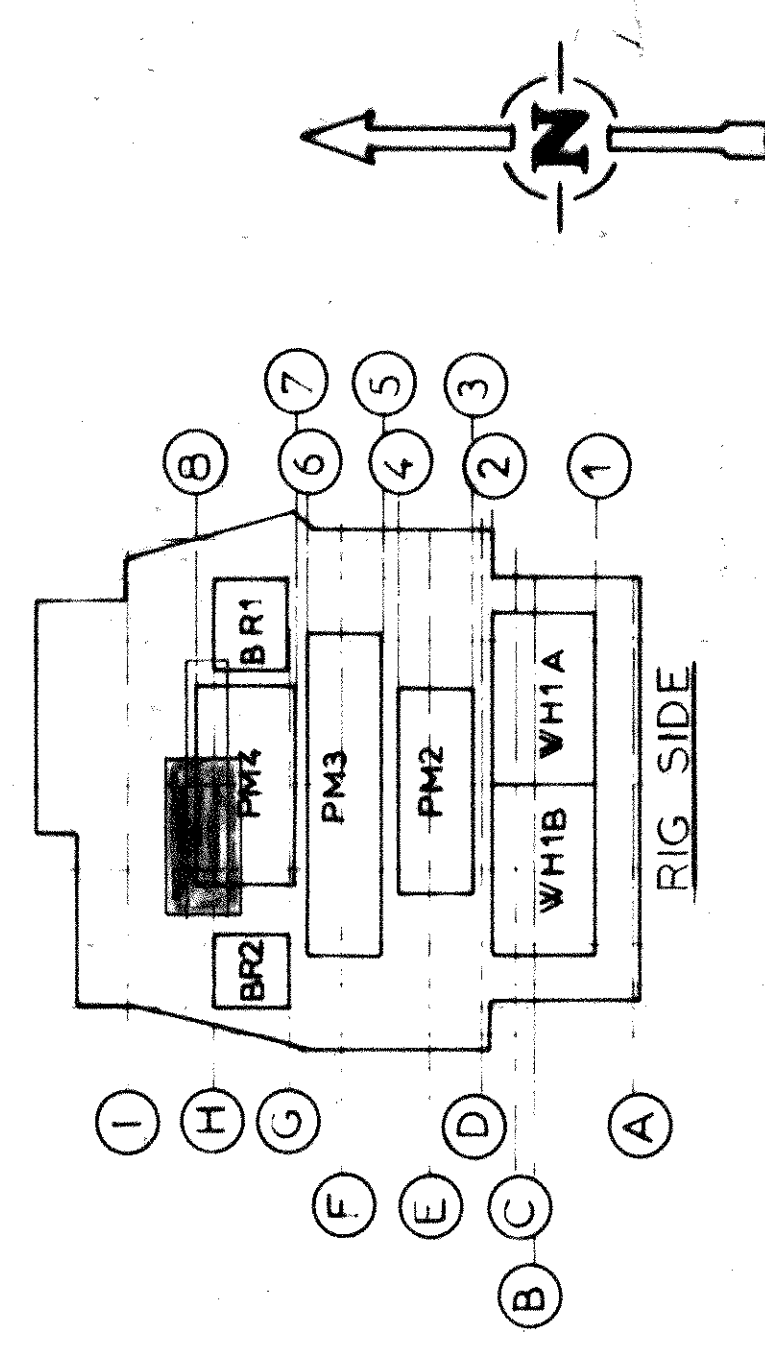

IFC  
 Refer to drawings for details of fittings C.D.P.1  
 AS BUILT  
 UP TO 20.3.80

elf aquitaine norge a/s  
 CDP1 FRIGG FIELD  
 SAIPEM INTEGRATION  
 ARCHITECTURE  
 SAIPEM L.Q. - 3<sup>rd</sup> LEVEL  
 PLAN VIEW

Drawn by: [ ]  
 Checked by: [ ]  
 Appr. by: [ ]  
 Date: [ ]

FF 91.00.34.2019  
 PDS 00011  
 G.4.12

APPROVED FOR CONSTRUCTION

Name: [ ]  
 Signature: [ ]

Rev.	Description	Date
1	Issue for construction	12/03/80
2	Change of door type	12/03/80
3	Change of door type	12/03/80
4	Change of door type	12/03/80
5	Change of door type	12/03/80
6	Change of door type	12/03/80
7	Change of door type	12/03/80
8	Change of door type	12/03/80
9	Change of door type	12/03/80
10	Change of door type	12/03/80

SCALE 1/25