

- NOTES**
- FOR DETAILS OF CABLE RACK SUPPORTS SEE DRG 2111-057
 - FINAL POSITIONS OF CABLE RACK SUPPORTS SHALL BE DETERMINED BY SITE CONDITIONS & BE AT THE DISCRETION OF THE ENGINEER
 - CABLE RACK SUPPORTS ON BEAMS INDICATED THIS * TO BE SPACED AT A MAX. OF 2M.
 - MAX. SPACING FOR ALL OTHER RACK SUPPORTS TO BE 5M.
 - CABLE RACK ELEVATIONS ARE TO UNDERSIDE OF CABLE RACK
 - ALL CABLE RACK TO BE INSTALLED OFF-SHORE UNLESS OTHERWISE SHOWN.
 - CHANGES IN RACK ELEVATION ARE TO BE ACHIEVED BY INSIDE & OUTSIDE VERTICAL RISERS UNLESS OTHERWISE SHOWN.

REFERENCE DRAWINGS

DRG. NO.	TITLE
E.C.N. 2111-057	MOUNTING DETAILS - CABLE RACK
E.C.N. 2111-058	LIGHTING & CABLE RACK LAYOUT - HELIDECK
E.C.N. 2111-059	SERVICE DUCT LAYOUT - CABLE RACK
E.C.N. 2111-060	CABLE RACK LAYOUT - MICROWAVE TOWER
E.C.N. 2111-061	POWER INSTALLATION DETAILS FOR CABLING TO STATIC INVERTER SYSTEM (SHAR & BATTERY ROOM)

REVISIONS

NO.	DATE	DESCRIPTION
1	1997.11.15	ISSUED FOR CONSTRUCTION
2	1998.01.17	ISSUED AS BUILT
3	1998.01.17	ISSUED AS BUILT
FRIGO FIELD: FF 96.23.17.0052

QUARTERS PLATFORM
ELF - NORGE
FRIGG FIELD

McDERMOTT - HUDSON

DATE: 1997.11.15
SCALE: 1:50

PROJECT: ELF - NORGE
JOB NO.: 96-0-032




LOCATION: LONDON - ENGLAND

DESIGNED BY: J. S. B. JENSEN
CHECKED BY: J. S. B. JENSEN
DATE: 1997.11.15

SCALE: 1:50

DATE: 1997.11.15

SCALE: 1:50

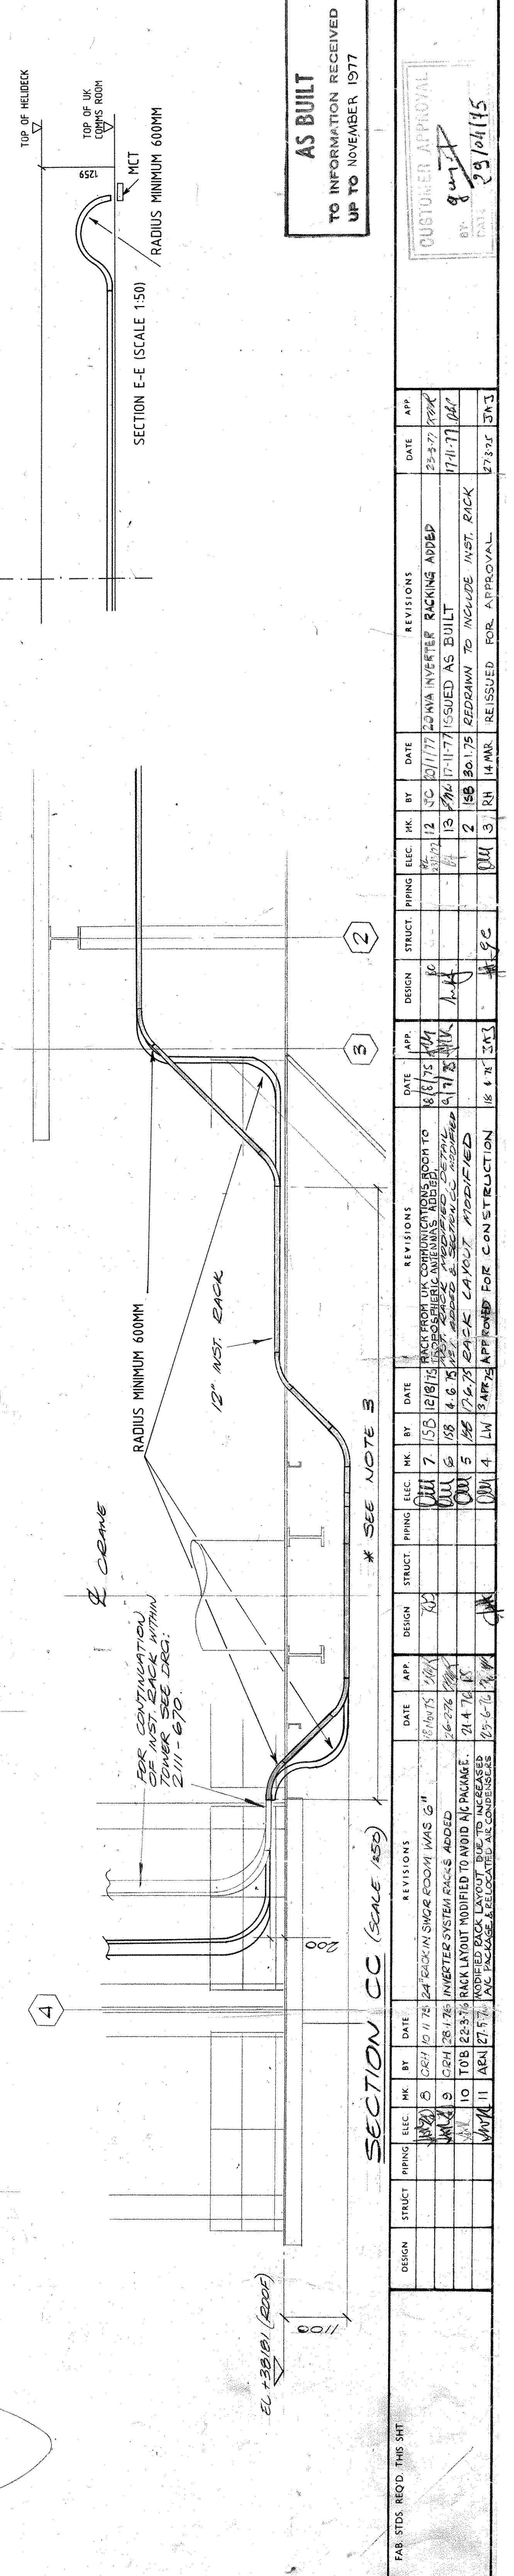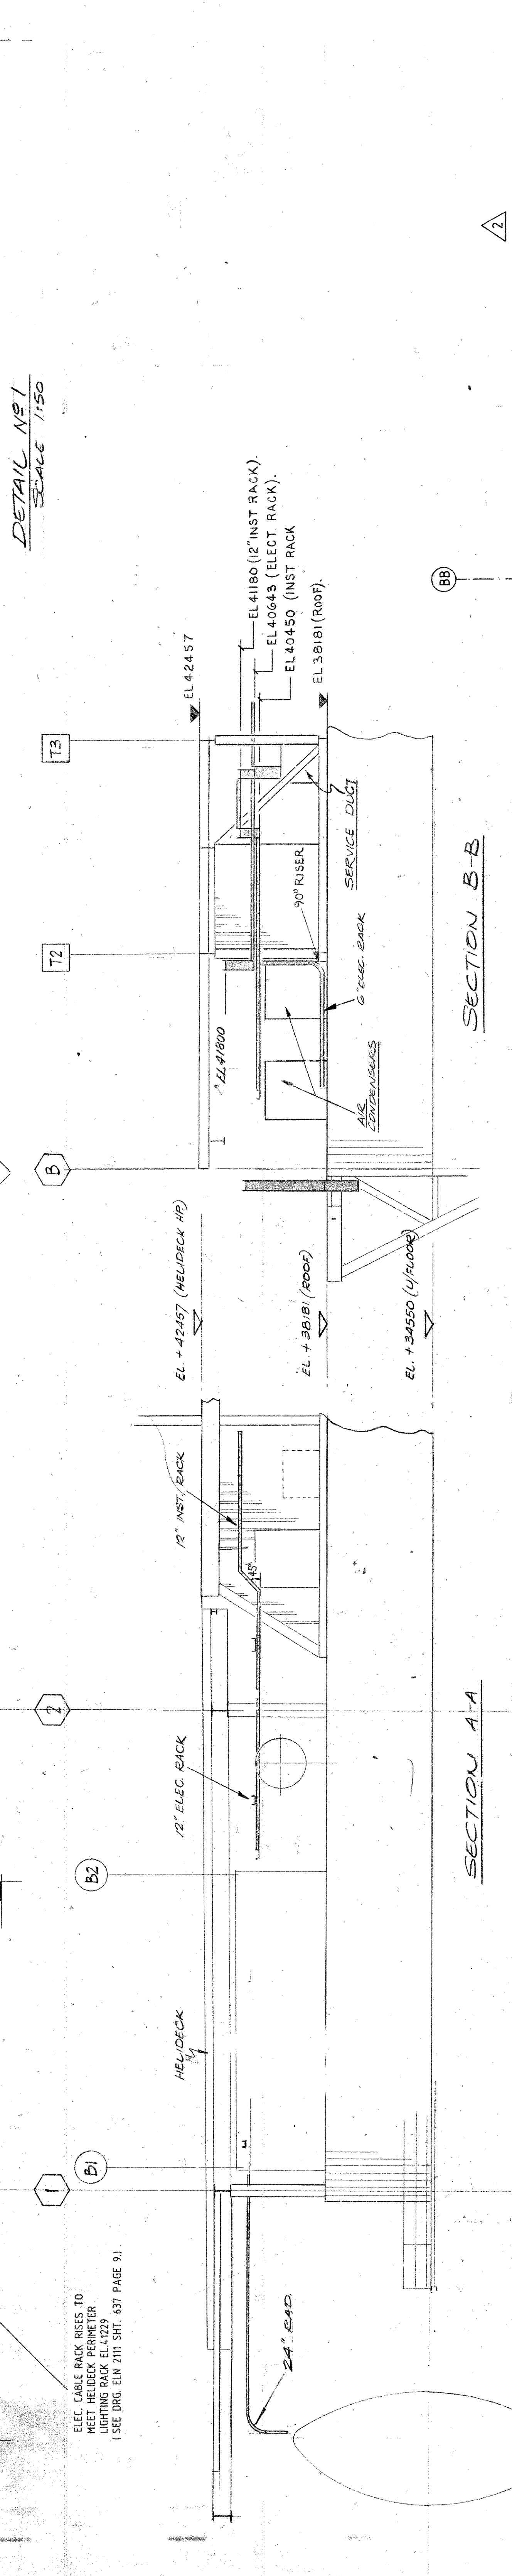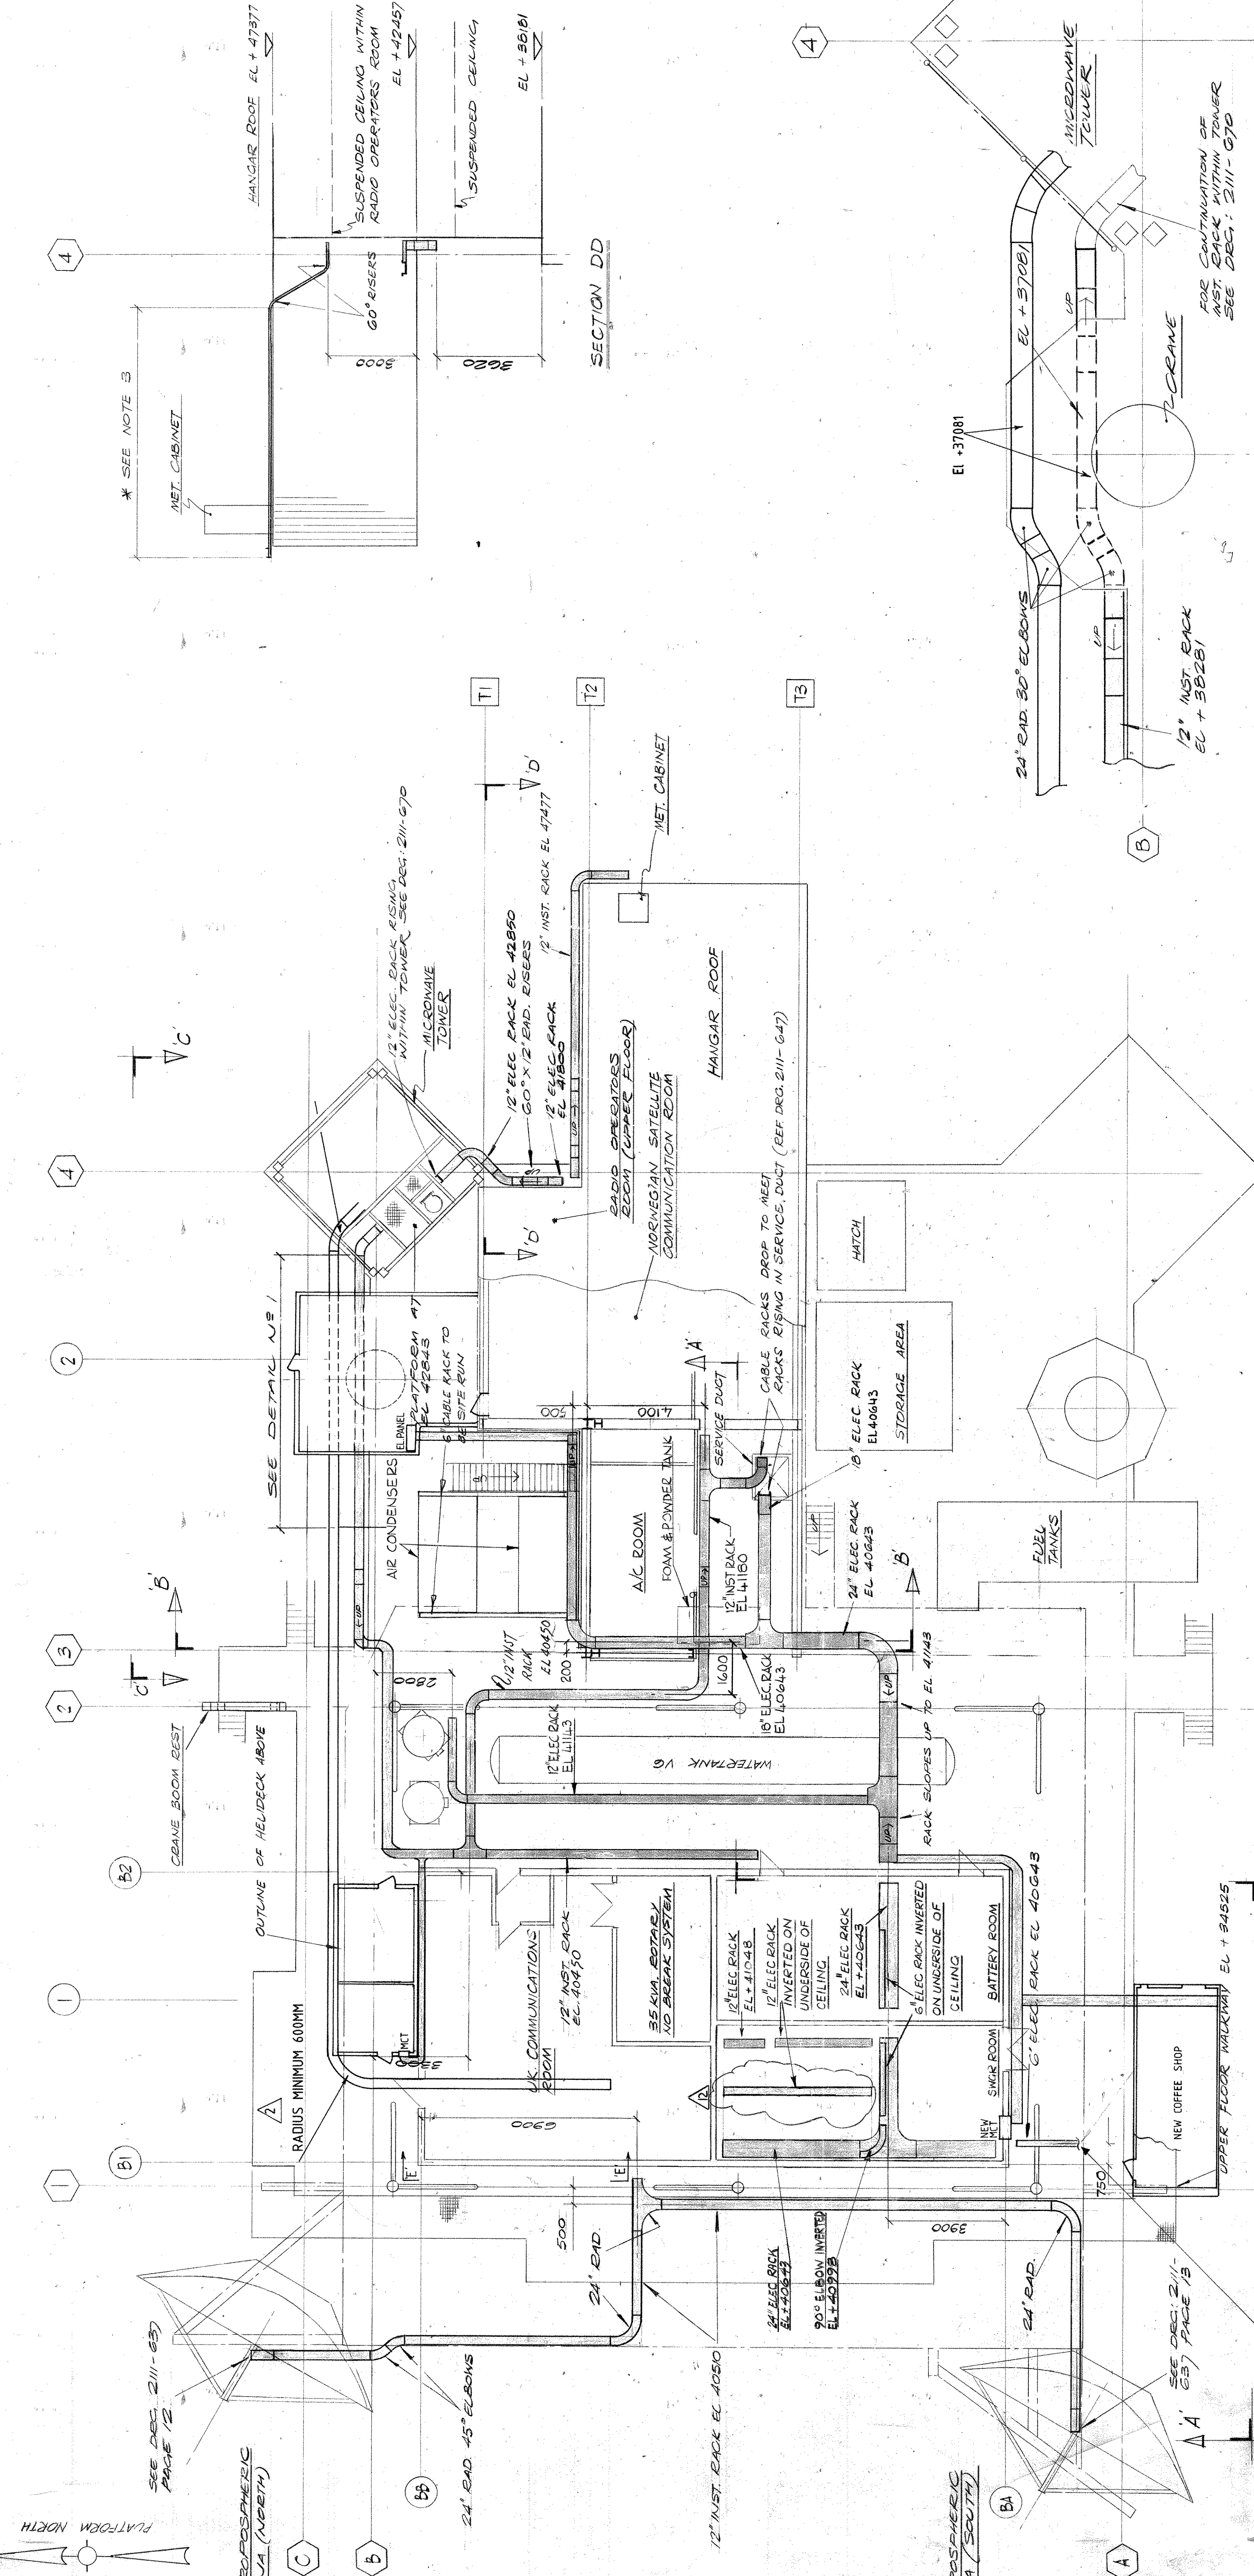

AS BUILT
TO INFORMATION RECEIVED
UP TO NOVEMBER 1977

SECTION CC (SCALE ASB)

NO.	DATE	DESCRIPTION
1	1997.11.15	ISSUED FOR CONSTRUCTION
2	1998.01.17	ISSUED AS BUILT
3	1998.01.17	ISSUED AS BUILT
REVISIONS

NO.	DATE	DESCRIPTION
1	1997.11.15	ISSUED FOR CONSTRUCTION
2	1998.01.17	ISSUED AS BUILT
3	1998.01.17	ISSUED AS BUILT
