
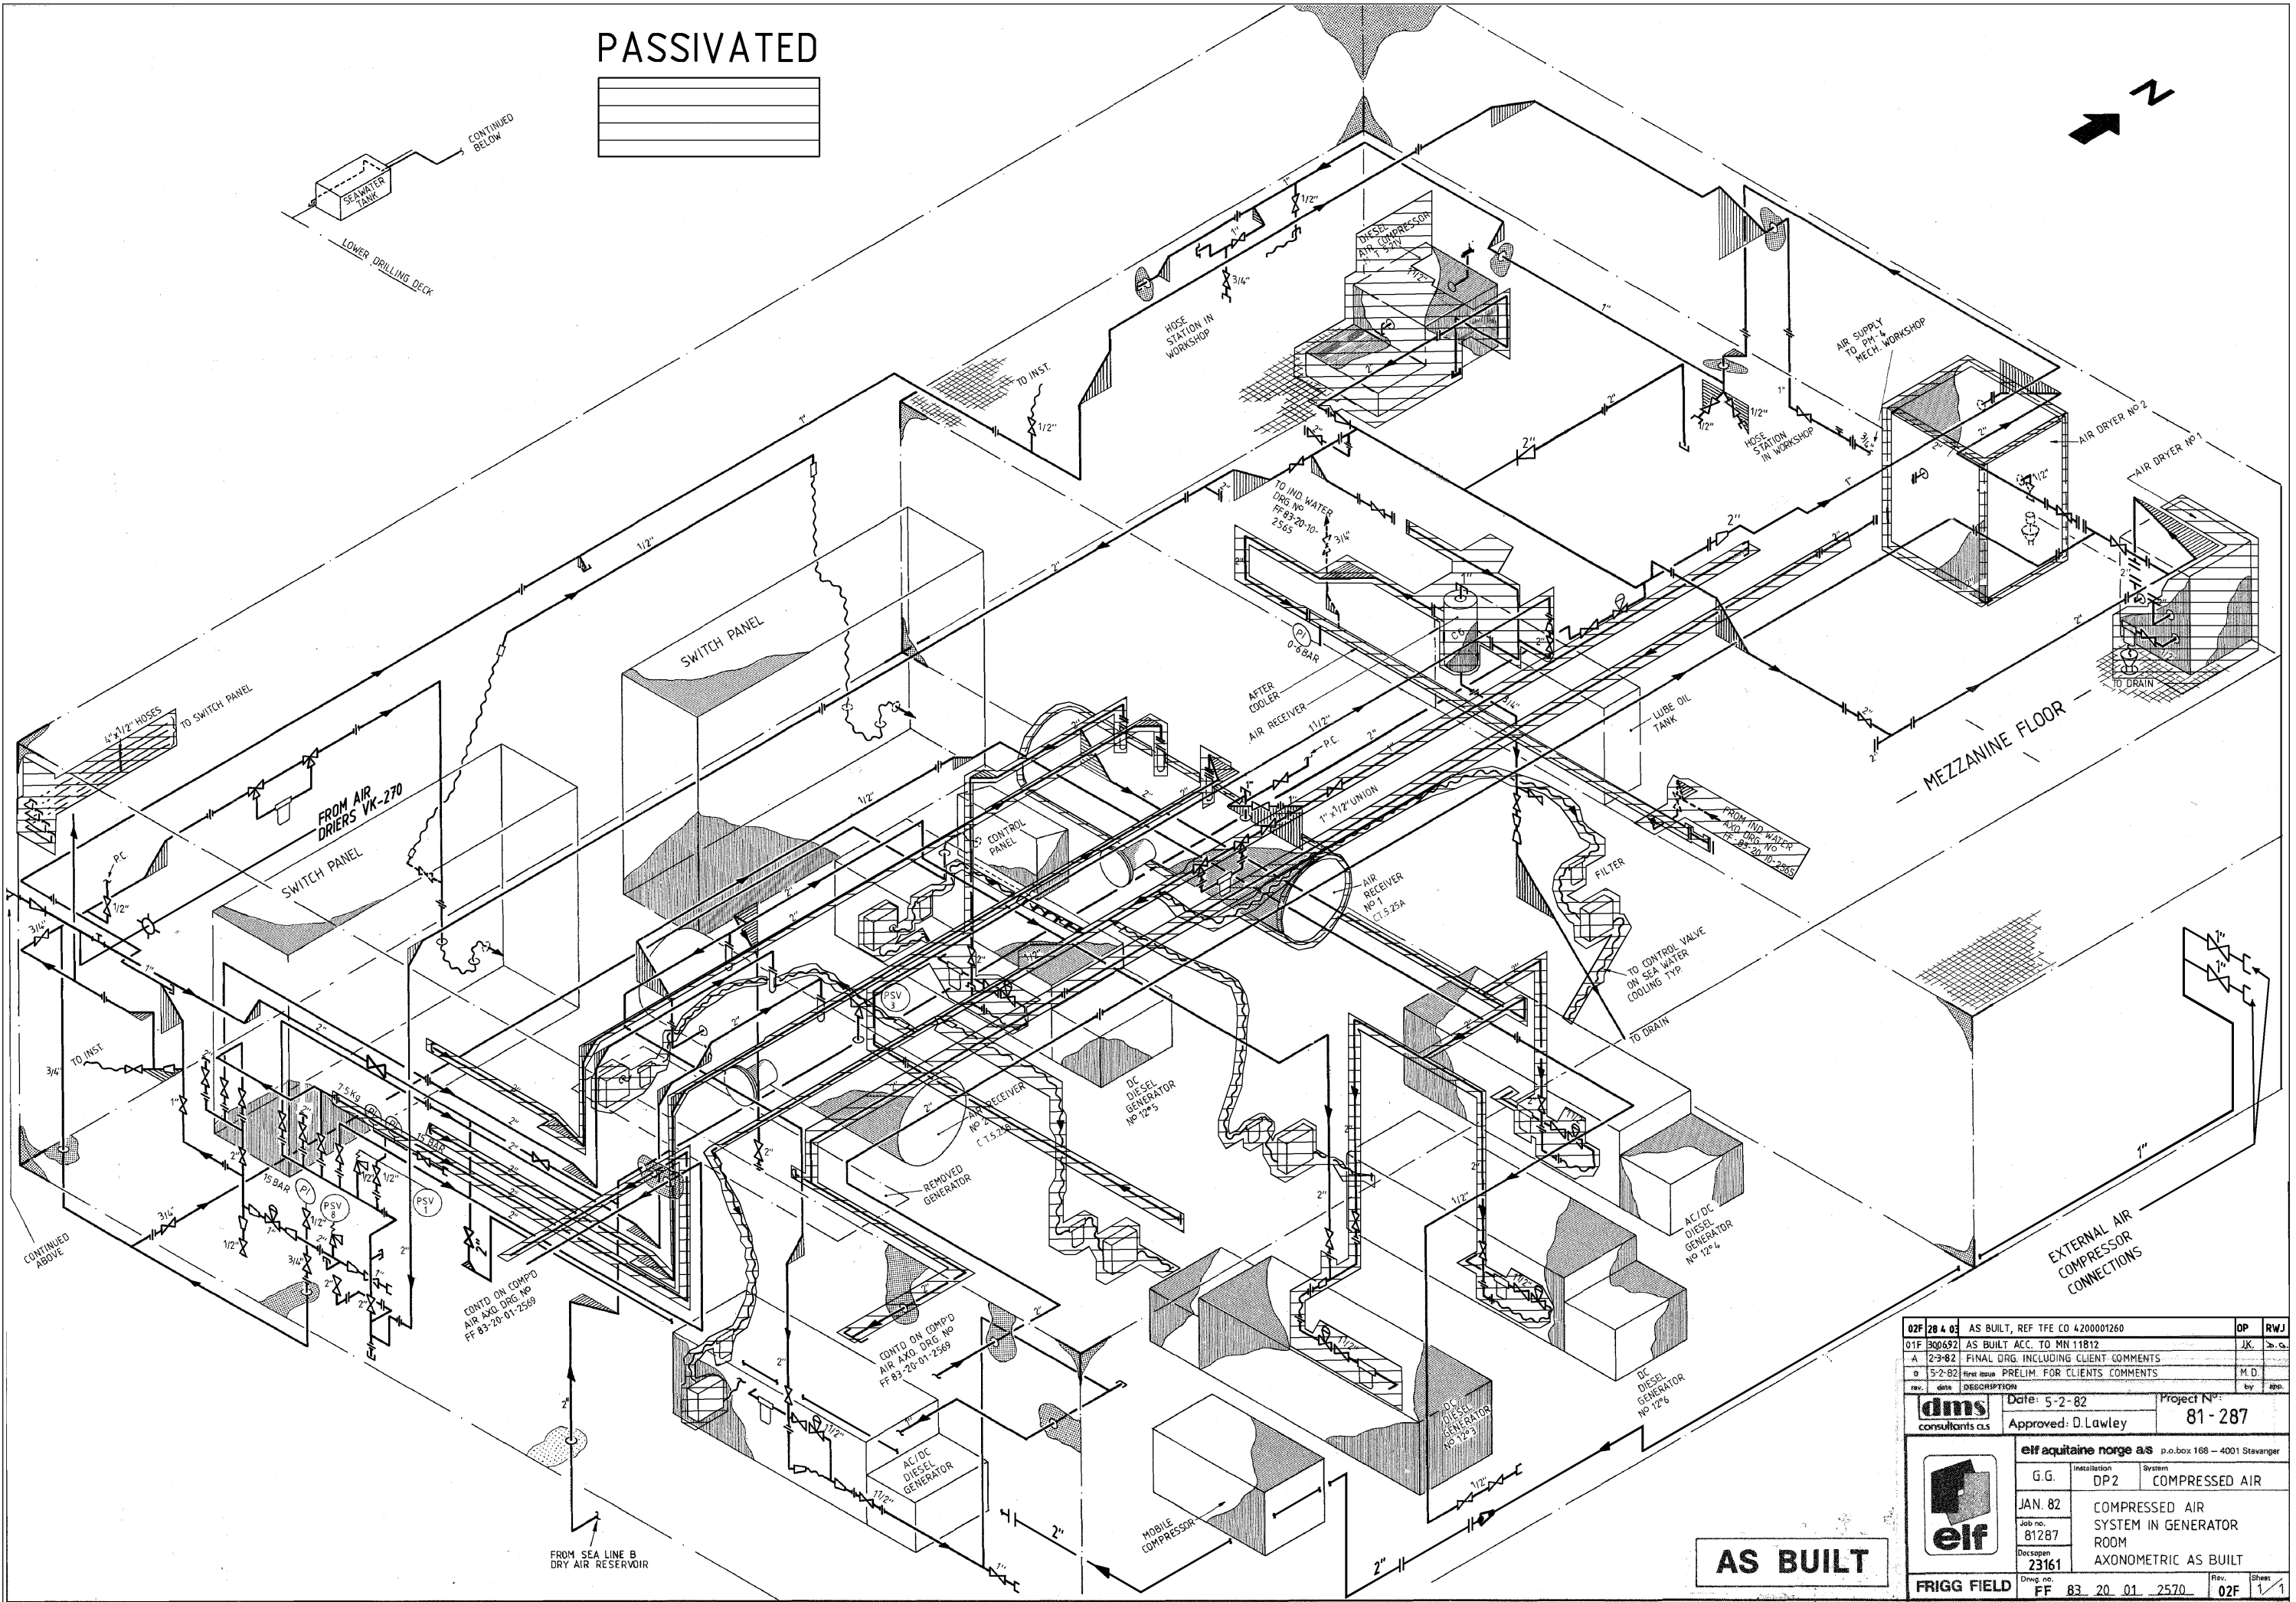


PASSIVATED

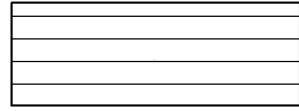

AS BUILT

02F 28 4 03	AS BUILT, REF TFE CO 4200001260	DP	RWJ
01F 300692	AS BUILT ACC. TO MN 11812	JK	S. G.
A	2-9-82 FINAL DRG. INCLUDING CLIENT COMMENTS		
D	5-2-82 first issue PRELIM. FOR CLIENTS COMMENTS	M. D.	
rev.	date	DESCRIPTION	by
dms	Date: 5-2-82	Project N°:	
consultants a/s	Approved: D. Lawley	81-287	
elf aquitaine norge a/s p.o.box 168 - 4001 Stavanger			
G.G.	Installation	System	COMPRESSED AIR
JAN. 82	COMPRESSED AIR SYSTEM IN GENERATOR ROOM		
Job no. 81287	AXONOMETRIC AS BUILT		
Docno. 23161			
Drwg. no. FF 83 20 01 2570	02F	Rev.	1