



EAST SIDE VIEW

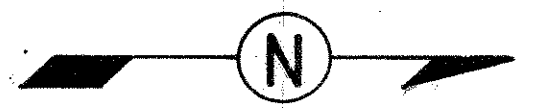

AS BUILT

| | | | | |
|-------------------------|--------|-------------------------------|------|------|
| 0 | 8/1/84 | first issue | A.H. | AK |
| rev. | date | DESCRIPTION | by | app. |
| elf aquitaine norge a/s | | p.o. box 168 - 4001 Stavanger | | |
| Installation | | System | | |
| C.D.P. 1 | | | | |
| Job no. | | ELEVATION LAYOUT | | |
| | | EAST SIDE | | |
| Scale | | 1:100 | | |
| Drwg. no. | | FF 91 00 00 00 41 | | |
| Rev. | | 0 | | |
| Sheet | | 1/1 | | |
| FRIGG FIELD | | | | |

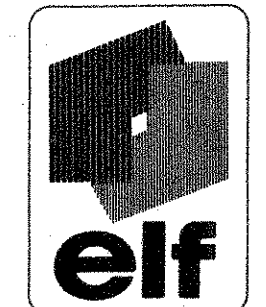

FOR 100 245 REV 0 DATE 270178

SIZE A8 Form 100312