


WEST SIDE VIEW

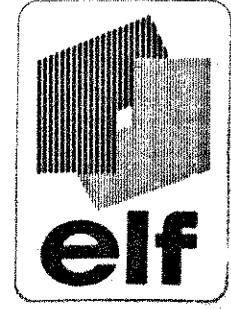

AS BUILT

0	8-1-84	First issue	A.H.
rev.	date	DESCRIPTION	by app.
 elf aquitaine norge as p.o. box 168 - 4001 Stavanger			
Installation	System		
C.D.P. 1	ELEVATION LAYOUT		
Job no.	WEST SIDE		
Scale	1: 100		
Drwg. no.	FF 91 00 00 00 40	Rev	0
Sheet	1/1		

Scale 1:100