



A B C D E F G H I

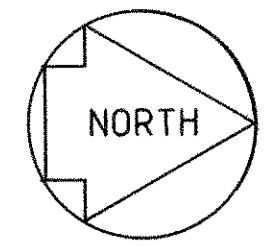

1
2
3
4
5
6
7
8
9
10

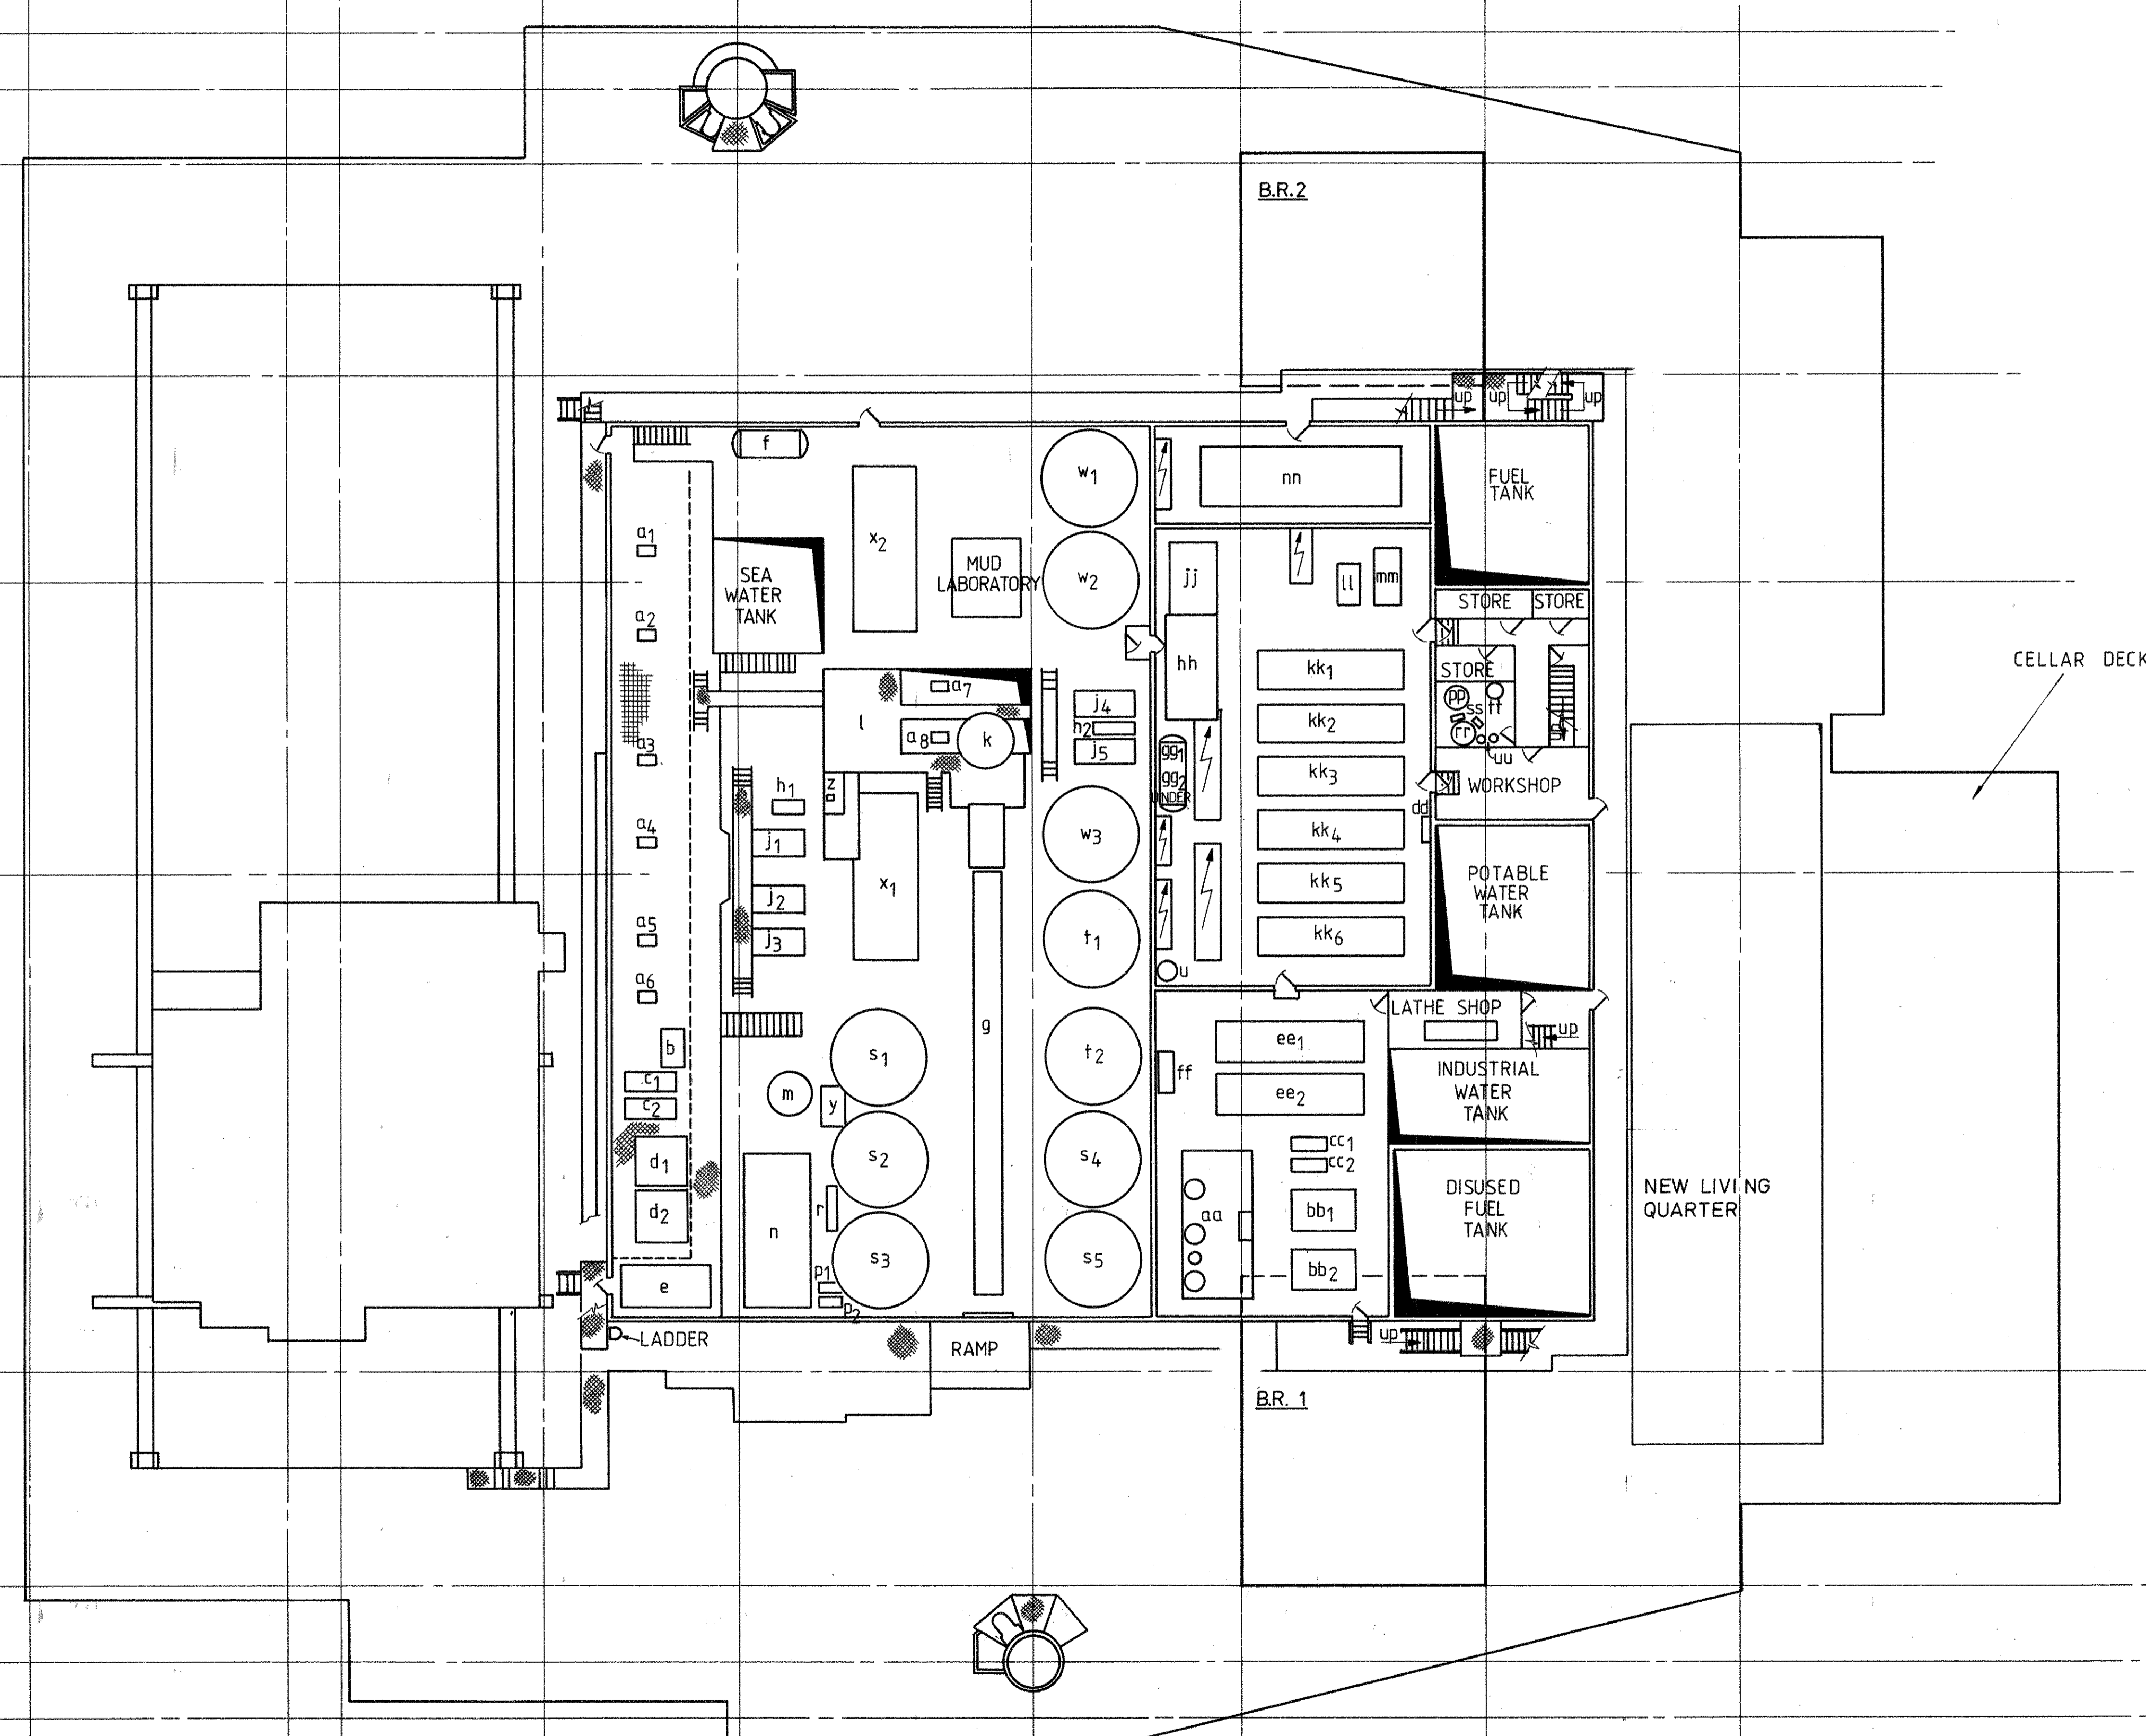

- KEY**
- a₁-a₈ MIXERS
 - b DE-SANDER
 - c₁-c₂ DE-SILTER
 - d₁-d₂ SHALE SHAKER
 - e DE-GASSER
 - f AIR TANK
 - g CONVEYOR
 - h₁-h₂ CELLAR PUMP
 - j₁-j₅ MUD MIXER PUMP
 - k MUD SURGE TANK
 - l BARITE STORAGE
 - m CEMENT SURGE TANK
 - n CEMENT UNIT
 - p₁-2 CEMENT UNIT DIESEL DAY TANK
 - r OIL SPRAY TANK
 - s₁-s₅ CEMENT BULK STORAGE
 - t₁-t₂ BENTONITE STORAGE
 - u AIR FILTER
 - w₁-3 BARITE STORAGE
 - x₁-x₂ MUD PUMP
 - y MUD MIXER PUMP FOR CEMENT UNIT
 - z TANK & MIXER
 - aa STEAM & CONDENSATE UNIT
 - bb₁-bb₂ MECO DISTILLATION UNIT
 - cc₁-cc₂ INDUSTRIAL WATER PUMP
 - dd CATERPILLAR LUBE OIL EXTRACTION PUMP
 - ee₁ MOTOR 50 HZ / GENERATOR 60 HZ
 - ff FIRE PUMP
 - gg₁-gg₂ COMPRESSED AIR TANK
 - hh GAS OIL TANK
 - jj CEMENT AIR COMPRESSOR
 - kk₁-kk₆ DC GENERATOR
 - ll DIESEL AIR COMPRESSOR
 - mm ELECTRIC AIR COMPRESSOR
 - nn AC / DC GENERATOR
 - pp PRESSURE TANK
 - rr HYDRO TANK
 - ss HYDRO PUMPS
 - tt HOT WATER TANK
 - uu DOSER (CHEMICAL)
 - ee₂ AC GENERATOR

AS BUILT

1	18/1/84	AS BUILT	A.H.
0	17/6/82	AS BUILT	M.D.
rev.	date	DESCRIPTION	by app.
		Date: 17th JUNE 1982	Project N°: 82-320
		Approved: D. LAWLEY	
eir aquitaine norge as p.o. box 168 - 4001 Stavanger			
drn.	Installation	System	
M.D.	CDP 1		
chkd.	M.D.	CDP 1 EQUIPMENT & PLATFORM LAYOUT	
Job no.	82-320	DRILLING DECK	
Scale	1:150		
Drwg. no.	FF 91-00-00-00-36	Rev.	1
		Sheet	1/1

SMA 41 Form 103/86 11-1989