



elf aquitaine norge a/s

CDP 1

**SUBSEA
AS BUILT FILE**

VOLUME 5

4. CONDUCTOR GUIDE FRAME

DRAWING TITLE	E.A.N DRAWING No
REFERENCE LEVELS OF GUIDE FRAME	FF 91 36 35 - 1330
GENERAL PLAN VIEW WITH CONDUCTOR NUMBER	FF 91 36 35 - 1331
4.1. <u>CONDUCTOR GUIDE FRAMES LEVEL "G"</u>	
4.1.1. <u>CELL "C"</u>	
GENERAL VIEW OF GUIDE FRAME	FF 91 36 35 - 1332
GENERAL VIEW OF SECONDARY FRAME SUPPORTS	FF 91 36 35 - 1333
SECONDARY FRAME FOR CONDUCTOR N° 13	FF 91 36 35 - 1334
SECONDARY FRAME FOR CONDUCTOR N° 14	FF 91 36 35 - 1335
SECONDARY FRAME FOR CONDUCTOR N° 15	FF 91 36 35 - 1336
SECONDARY FRAME FOR CONDUCTOR N° 16	FF 91 36 35 - 1337
SECONDARY FRAME FOR CONDUCTOR N° 17	FF 91 36 35 - 1338
SECONDARY FRAME FOR CONDUCTOR N° 18	FF 91 36 35 - 1339
SECONDARY FRAME FOR CONDUCTOR N° 19	FF 91 36 35 - 1340
SECONDARY FRAME FOR CONDUCTOR N° 20	FF 91 36 35 - 1341
SECONDARY FRAME FOR CONDUCTOR N° 21	FF 91 36 35 - 1342
SECONDARY FRAME FOR CONDUCTOR N° 22	FF 91 36 35 - 1343
SECONDARY FRAME FOR CONDUCTOR N° 23	FF 91 36 35 - 1344
SECONDARY FRAME FOR CONDUCTOR N° 24	FF 91 36 35 - 1345
FREE LOCK PIPE END GC1	FF 91 36 35 - 1346
FREE LOCK PIPE END GC4	FF 91 36 35 - 1347
BOX FOR FREE LOCK GC1	FF 91 36 35 - 1348
BOX FOR FREE LOCK GC4	FF 91 36 35 - 1349
RESERVED	FF 91 36 35 - 1350
	TO 1354

4. CONDUCTOR GUIDE FRAME

DRAWING TITLE

E.A.N DRAWING No

4.1.2.

CELL "D"

GENERAL VIEW OF GUIDE FRAME

FF 91 36 35 - 1355

GENERAL VIEW OF SECONDARY FRAME SUPPORTS

FF 91 36 35 - 1356

SECONDARY FRAME FOR CONDUCTOR N° 1

FF 91 36 35 - 1357

SECONDARY FRAME FOR CONDUCTOR N° 2

FF 91 36 35 - 1358

SECONDARY FRAME FOR CONDUCTOR N° 3

FF 91 36 35 - 1359

SECONDARY FRAME FOR CONDUCTOR N° 4

FF 91 36 35 - 1360

SECONDARY FRAME FOR CONDUCTOR N° 5

FF 91 36 35 - 1361

SECONDARY FRAME FOR CONDUCTOR N° 6

FF 91 36 35 - 1362

SECONDARY FRAME FOR CONDUCTOR N° 7

FF 91 36 35 - 1363

SECONDARY FRAME FOR CONDUCTOR N° 8

FF 91 36 35 - 1364

SECONDARY FRAME FOR CONDUCTOR N° 9

FF 91 36 35 - 1365

SECONDARY FRAME FOR CONDUCTOR N° 10

FF 91 36 35 - 1366

SECONDARY FRAME FOR CONDUCTOR N° 11

FF 91 36 35 - 1367

SECONDARY FRAME FOR CONDUCTOR N° 12

FF 91 36 35 - 1368

• FREE LOCK PIPE END GD1

FF 91 36 35 - 1369

FREE LOCK PIPE END GD4

FF 91 36 35 - 1370

BOX FOR FREE LOCK GD1

FF 91 36 35 - 1371

BOX FOR FREE LOCK GD4

FF 91 36 35 - 1372

RESERVED

FF 91 36 35 - 1373

RESERVED

FF 91 36 35 - 1374

RESERVED

FF 91 36 35 - 1375

RESERVED

FF 91 36 35 - 1376

RESERVED

FF 91 36 35 - 1377

4. CONDUCTOR GUIDE FRAME

DRAWING TITLE

E.A.N DRAWING No

4.2. CONDUCTOR GUIDE FRAMES LEVEL "E"

4.2.1. CELL "C"

GENERAL VIEW OF GUIDE FRAME	FF 91 36 35 - 1378
GENERAL VIEW OF SECONDARY FRAME SUPPORTS	FF 91 36 35 - 1379
SECONDARY FRAME FOR CONDUCTOR N° 13	FF 91 36 35 - 1380
SECONDARY FRAME FOR CONDUCTOR N° 14	FF 91 36 35 - 1381
SECONDARY FRAME FOR CONDUCTOR N° 15	FF 91 36 35 - 1382
SECONDARY FRAME FOR CONDUCTOR N° 16	FF 91 36 35 - 1383
SECONDARY FRAME FOR CONDUCTOR N° 17	FF 91 36 35 - 1384
SECONDARY FRAME FOR CONDUCTOR N° 18	FF 91 36 35 - 1385
SECONDARY FRAME FOR CONDUCTOR N° 19	FF 91 36 35 - 1386
SECONDARY FRAME FOR CONDUCTOR N° 20	FF 91 36 35 - 1387
SECONDARY FRAME FOR CONDUCTOR N° 21	FF 91 36 35 - 1388
SECONDARY FRAME FOR CONDUCTOR N° 22	FF 91 36 35 - 1389
SECONDARY FRAME FOR CONDUCTOR N° 23	FF 91 36 35 - 1390
SECONDARY FRAME FOR CONDUCTOR N° 24	FF 91 36 35 - 1391
FREE LOCK PIPE END EC1	FF 91 36 35 - 1392
FREE LOCK PIPE END EC4	FF 91 36 35 - 1393
BOX FOR FREE LOCK EC1	FF 91 36 35 - 1394
BOX FOR FREE LOCK EC4	FF 91 36 35 - 1395
RESERVED	FF 91 36 35 - 1396
RESERVED	FF 91 36 35 - 1397
RESERVED	FF 91 36 35 - 1398
RESERVED	FF 91 36 35 - 1399

4. CONDUCTOR GUIDE FRAME

DRAWING TITLE

E.A.N DRAWING No

4.2.2.

CELL "D"

GENERAL VIEW OF GUIDE FRAME

FF 91 36 35 - 1400

GENERAL VIEW OF SECONDARY FRAME SUPPORTS

FF 91 36 35 - 1401

SECONDARY FRAME FOR CONDUCTOR N° 1

FF 91 36 35 - 1402

SECONDARY FRAME FOR CONDUCTOR N° 2

FF 91 36 35 - 1403

SECONDARY FRAME FOR CONDUCTOR N° 3

FF 91 36 35 - 1404

SECONDARY FRAME FOR CONDUCTOR N° 4

FF 91 36 35 - 1405

SECONDARY FRAME FOR CONDUCTOR N° 5

FF 91 36 35 - 1406

SECONDARY FRAME FOR CONDUCTOR N° 6

FF 91 36 35 - 1407

SECONDARY FRAME FOR CONDUCTOR N° 7

FF 91 36 35 - 1408

SECONDARY FRAME FOR CONDUCTOR N° 8

FF 91 36 35 - 1409

SECONDARY FRAME FOR CONDUCTOR N° 9

FF 91 36 35 - 1410

SECONDARY FRAME FOR CONDUCTOR N° 10

FF 91 36 35 - 1411

SECONDARY FRAME FOR CONDUCTOR N° 11

FF 91 36 35 - 1412

SECONDARY FRAME FOR CONDUCTOR N° 12

FF 91 36 35 - 1413

FREE LOCK PIPE END ED1

FF 91 36 35 - 1414

FREE LOCK PIPE END ED4

FF 91 36 35 - 1415

BOX FOR FREE LOCK ED1

FF 91 36 35 - 1416

BOX FOR FREE LOCK ED4

FF 91 36 35 - 1417

RESERVED

FF 91 36 35 - 1418

RESERVED

FF 91 36 35 - 1419

RESERVED

FF 91 36 35 - 1420

RESERVED

FF 91 36 35 - 1421

4. CONDUCTOR GUIDE FRAME

DRAWING TITLE

E.A.N DRAWING No

4.3. CONDUCTOR GUIDE FRAMES LEVEL "D"

4.3.1. CELL "C"

GENERAL VIEW OF GUIDE FRAME	FF 91 36 35 - 1422
GENERAL VIEW OF SECONDARY FRAME SUPPORTS	FF 91 36 35 - 1423
SECONDARY FRAME FOR CONDUCTOR N° 13	FF 91 36 35 - 1424
SECONDARY FRAME FOR CONDUCTOR N° 14	FF 91 36 35 - 1425
SECONDARY FRAME FOR CONDUCTOR N° 15	FF 91 36 35 - 1426
SECONDARY FRAME FOR CONDUCTOR N° 16	FF 91 36 35 - 1427
SECONDARY FRAME FOR CONDUCTOR N° 17	FF 91 36 35 - 1428
SECONDARY FRAME FOR CONDUCTOR N° 18	FF 91 36 35 - 1429
SECONDARY FRAME FOR CONDUCTOR N° 19	FF 91 36 35 - 1430
SECONDARY FRAME FOR CONDUCTOR N° 20	FF 91 36 35 - 1431
SECONDARY FRAME FOR CONDUCTOR N° 21	FF 91 36 35 - 1432
SECONDARY FRAME FOR CONDUCTOR N° 22	FF 91 36 35 - 1433
SECONDARY FRAME FOR CONDUCTOR N° 23	FF 91 36 35 - 1434
SECONDARY FRAME FOR CONDUCTOR N° 24	FF 91 36 35 - 1435
FREE LOCK PIPE END DC1	FF 91 36 35 - 1436
FREE LOCK PIPE END DC4	FF 91 36 35 - 1437
BOX FOR FREE LOCK DC1	FF 91 36 35 - 1438
BOX FOR FREE LOCK DC4	FF 91 36 35 - 1439
RESERVED	FF 91 36 35 - 1440
RESERVED	FF 91 36 35 - 1441
RESERVED	FF 91 36 35 - 1442
RESERVED	FF 91 36 35 - 1443

4. CONDUCTOR GUIDE FRAME

DRAWING TITLE

E.A.N DRAWING No

4.3.2.

CELL "D"

GENERAL VIEW OF GUIDE FRAME

FF 91 36 35 - 1444

GENERAL VIEW OF SECONDARY FRAME SUPPORTS

FF 91 36 35 - 1445

SECONDARY FRAME FOR CONDUCTOR N° 1

FF 91 36 35 - 1446

SECONDARY FRAME FOR CONDUCTOR N° 2

FF 91 36 35 - 1447

SECONDARY FRAME FOR CONDUCTOR N° 3

FF 91 36 35 - 1448

SECONDARY FRAME FOR CONDUCTOR N° 4

FF 91 36 35 - 1449

SECONDARY FRAME FOR CONDUCTOR N° 5

FF 91 36 35 - 1450

SECONDARY FRAME FOR CONDUCTOR N° 6

FF 91 36 35 - 1451

SECONDARY FRAME FOR CONDUCTOR N° 7

FF 91 36 35 - 1452

SECONDARY FRAME FOR CONDUCTOR N° 8

FF 91 36 35 - 1453

SECONDARY FRAME FOR CONDUCTOR N° 9

FF 91 36 35 - 1454

SECONDARY FRAME FOR CONDUCTOR N° 10

FF 91 36 35 - 1455

SECONDARY FRAME FOR CONDUCTOR N° 11

FF 91 36 35 - 1456

SECONDARY FRAME FOR CONDUCTOR N° 12

FF 91 36 35 - 1457

FREE LOCK PIPE END DD1

FF 91 36 35 - 1458

FREE LOCK PIPE END DD4

FF 91 36 35 - 1459

BOX FOR FREE LOCK DD1

FF 91 36 35 - 1460

BOX FOR FREE LOCK DD4

FF 91 36 35 - 1461

RESERVED

FF 91 36 35 - 1462

RESERVED

FF 91 36 35 - 1463

RESERVED

FF 91 36 35 - 1464

RESERVED

FF 91 36 35 - 1465

4. CONDUCTOR GUIDE FRAME

DRAWING TITLE

E.A.N DRAWING No

4.4.

CONDUCTOR GUIDE FRAMES LEVEL "C"

REMAINING PART OF FIXED LOCK C2 IN CELL C	FF 91 36 35 - 1466
REMAINING PART OF FIXED LOCK C3 IN CELL C	FF 91 36 35 - 1467
REMAINING PART OF FIXED LOCK D2 IN CELL D	FF 91 36 35 - 1468
REMAINING PART OF FIXED LOCK D3 IN CELL D	FF 91 36 35 - 1469
BOX FOR FREE LOCK CC1	FF 91 36 35 - 1470
BOX FOR FREE LOCK CC4	FF 91 36 35 - 1471
BOX FOR FREE LOCK CD1	FF 91 36 35 - 1472
BOX FOR FREE LOCK CD4	FF 91 36 35 - 1473
RESERVED	FF 91 36 35 - 1474
RESERVED	FF 91 36 35 - 1475
RESERVED	FF 91 36 35 - 1476
RESERVED	FF 91 36 35 - 1477

4.5.

CONDUCTOR GUIDE FRAME LEVEL "B"

GENERAL VIEW OF GUIDE FRAME CELL "C"	FF 91 36 35 - 1478
GENERAL VIEW OF GUIDE FRAME CELL "D"	FF 91 36 35 - 1479
SECONDARY FRAME TYPE 1	FF 91 36 35 - 1480
SECONDARY FRAME TYPE 2	FF 91 36 35 - 1481
SECONDARY FRAME TYPE 3	FF 91 36 35 - 1482
BOX FOR FREE LOCK BC1	FF 91 36 35 - 1483
BOX FOR FREE LOCK BC4	FF 91 36 35 - 1484
BOX FOR FREE LOCK BD1	FF 91 36 35 - 1485
BOX FOR FREE LOCK BD4	FF 91 36 35 - 1486
RESERVED	FF 91 36 35 - 1487
RESERVED	FF 91 36 35 - 1488

4. CONDUCTOR GUIDE FRAME

DRAWING TITLE

E.A.N DRAWING No

4.6. CONDUCTOR GUIDE FRAME LEVEL "A"

GENERAL VIEW OF GUIDE FRAME CELL "C"

FF 91 36 35 - 1489

GENERAL VIEW OF GUIDE FRAME CELL "D"

FF 91 36 35 - 1490

4.7. MISCELLANEOUS

CONDUCTOR SLEEVE TYPICAL DETAIL

FF 91 36 35 - 1491

CONDUCTOR PIPE CASING LOCKING DEVICE

FF 91 36 35 - 1492

RESERVED

FF 91 36 35 - 1493

RESERVED

FF 91 36 35 - 1494

RESERVED

FF 91 36 35 - 1495

RESERVED

FF 91 36 35 - 1496

4.8. CONDUCTOR SLEEVES

GENERAL PLAN VIEW CELLS "C" and "D"
AT SLAB LEVEL

FF 91 36 35 - 1497

CONDUCTOR SLEEVE TYPE 1

FF 91 36 35 - 1498

CONDUCTOR SLEEVE TYPE 2

FF 91 36 35 - 1599

CONDUCTOR SLEEVE TYPE 3

FF 91 36 35 - 1500

CONDUCTOR SLEEVE - FUNNEL

FF 91 36 35 - 1501

RESERVED


FF 91 36 35 - 1502

RESERVED


FF 91 36 35 - 1503

RESERVED

FF 91 36 35 - 1504

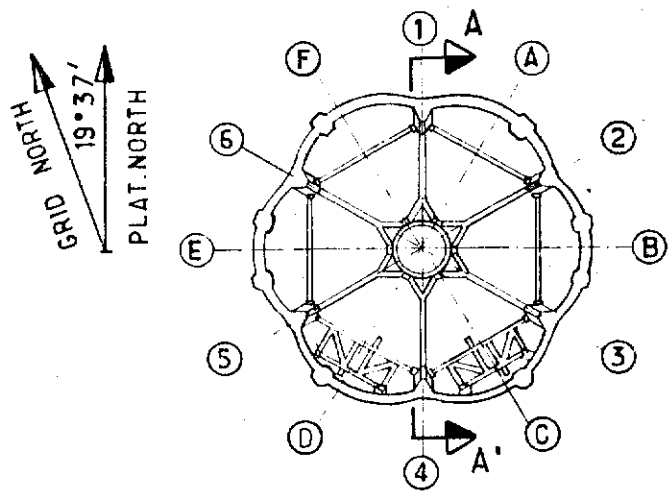

KEY PLAN

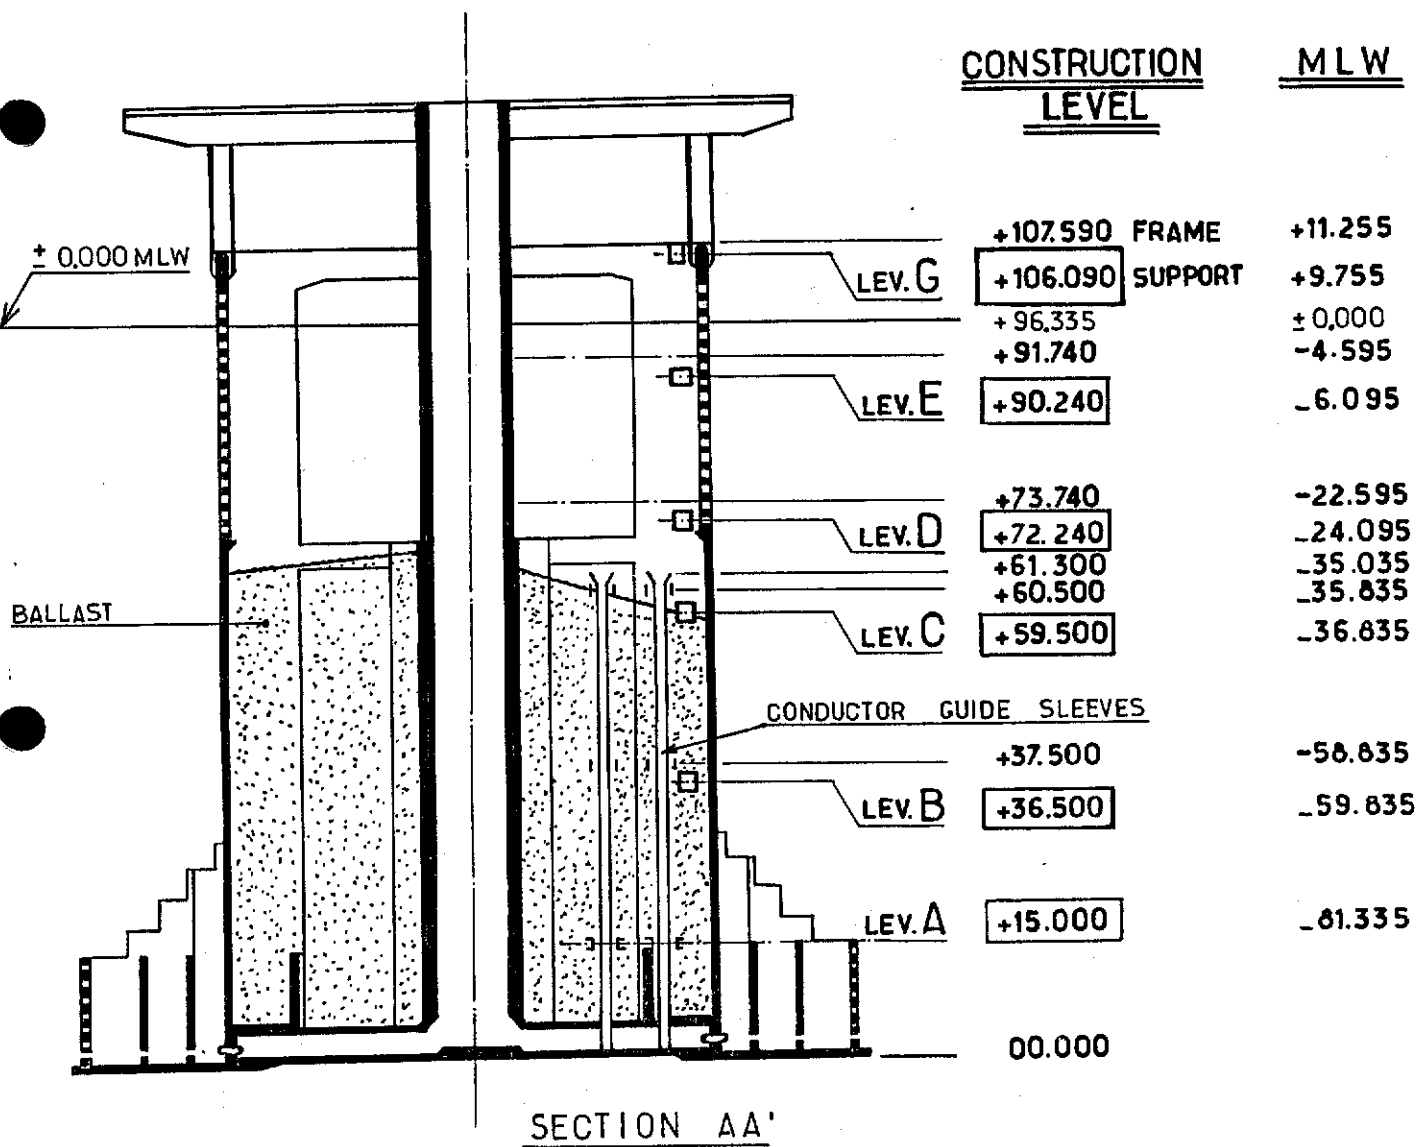

SECTION AA'

elf aquitaine norge a/s		Job no.		Installation CDP 1		System UNDERWATER	
p.o.box 168		Scale		REFERENCE LEVELS OF GUIDE FRAME			
4001 Stavanger		Dwgr. no.		FF. 91.36.35.1330.		Rev. 1	
Contractor JVD 1029_40.00.		FRIGG FIELD				Sheet	

1	12.83	UP DATED	BY H. J. C.
Rev.	Date	DESCRIPTION	by app.


Form 100 218

CDP 1 AS BUILT DRAWINGS

● REFERENCE DRAWING LIST FOR: CONDUCTOR GUIDE FRAME



[illegible][illegible]

					elf aquitaine norge a/s p.o.box 168 4001 Stavanger	 elf	Job no.	Installation CDP 1	System UNDERWATER		
							Scale				
Rev.	Date	DESCRIPTION	by	app.	Contractor	FRIGG FIELD	Dwgr. no.	FF — — <u>1330</u>		Rev.	Sheet /

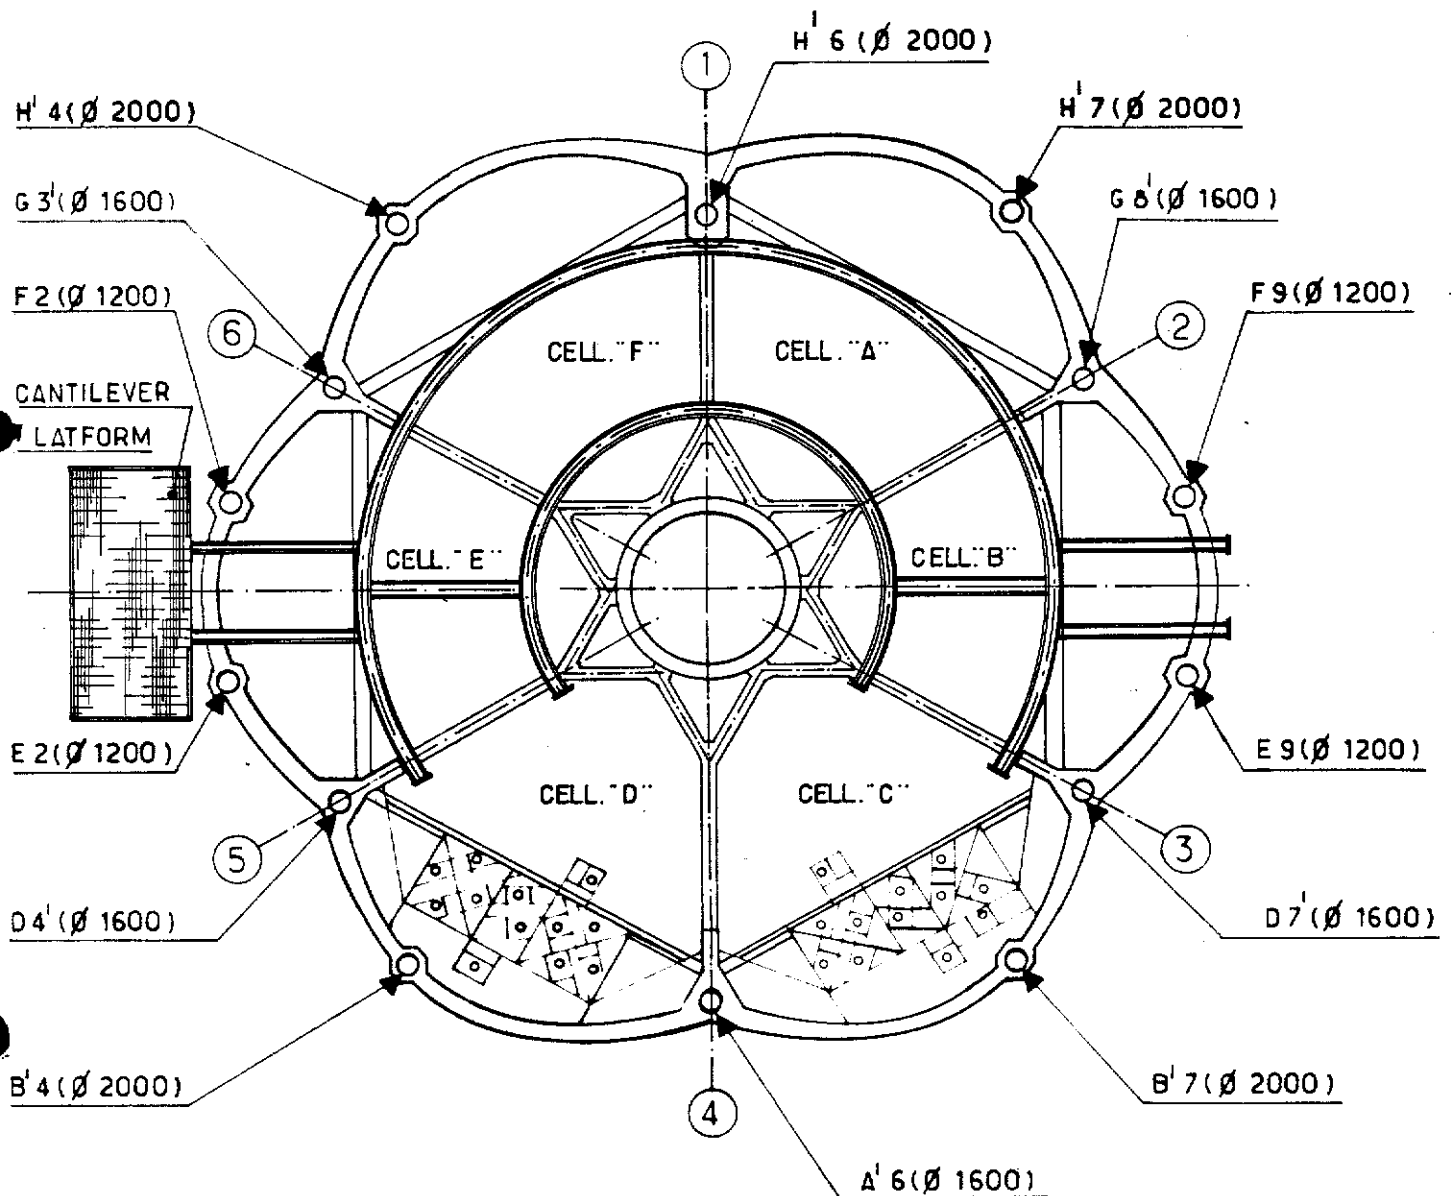

— SECTION AT LEVEL +107.00 M. —
TOP OF BREAKWATER WALL

				elf aquitaine norge a/s		Job no.	Installation CDP 1	System UNDERWATER
1	12/83	UPDATED	mins	JLC		Scale	STEEL COLUMNS LAYOUT	
Rev.	Date	DESCRIPTION	by	app.	p.o.box 168	Dwgr. no.	FF 91_36_35_1041	Rev. 1
Contractor JVD 1029 10_06				4001 Stavanger	FRIGG FIELD			Sheet

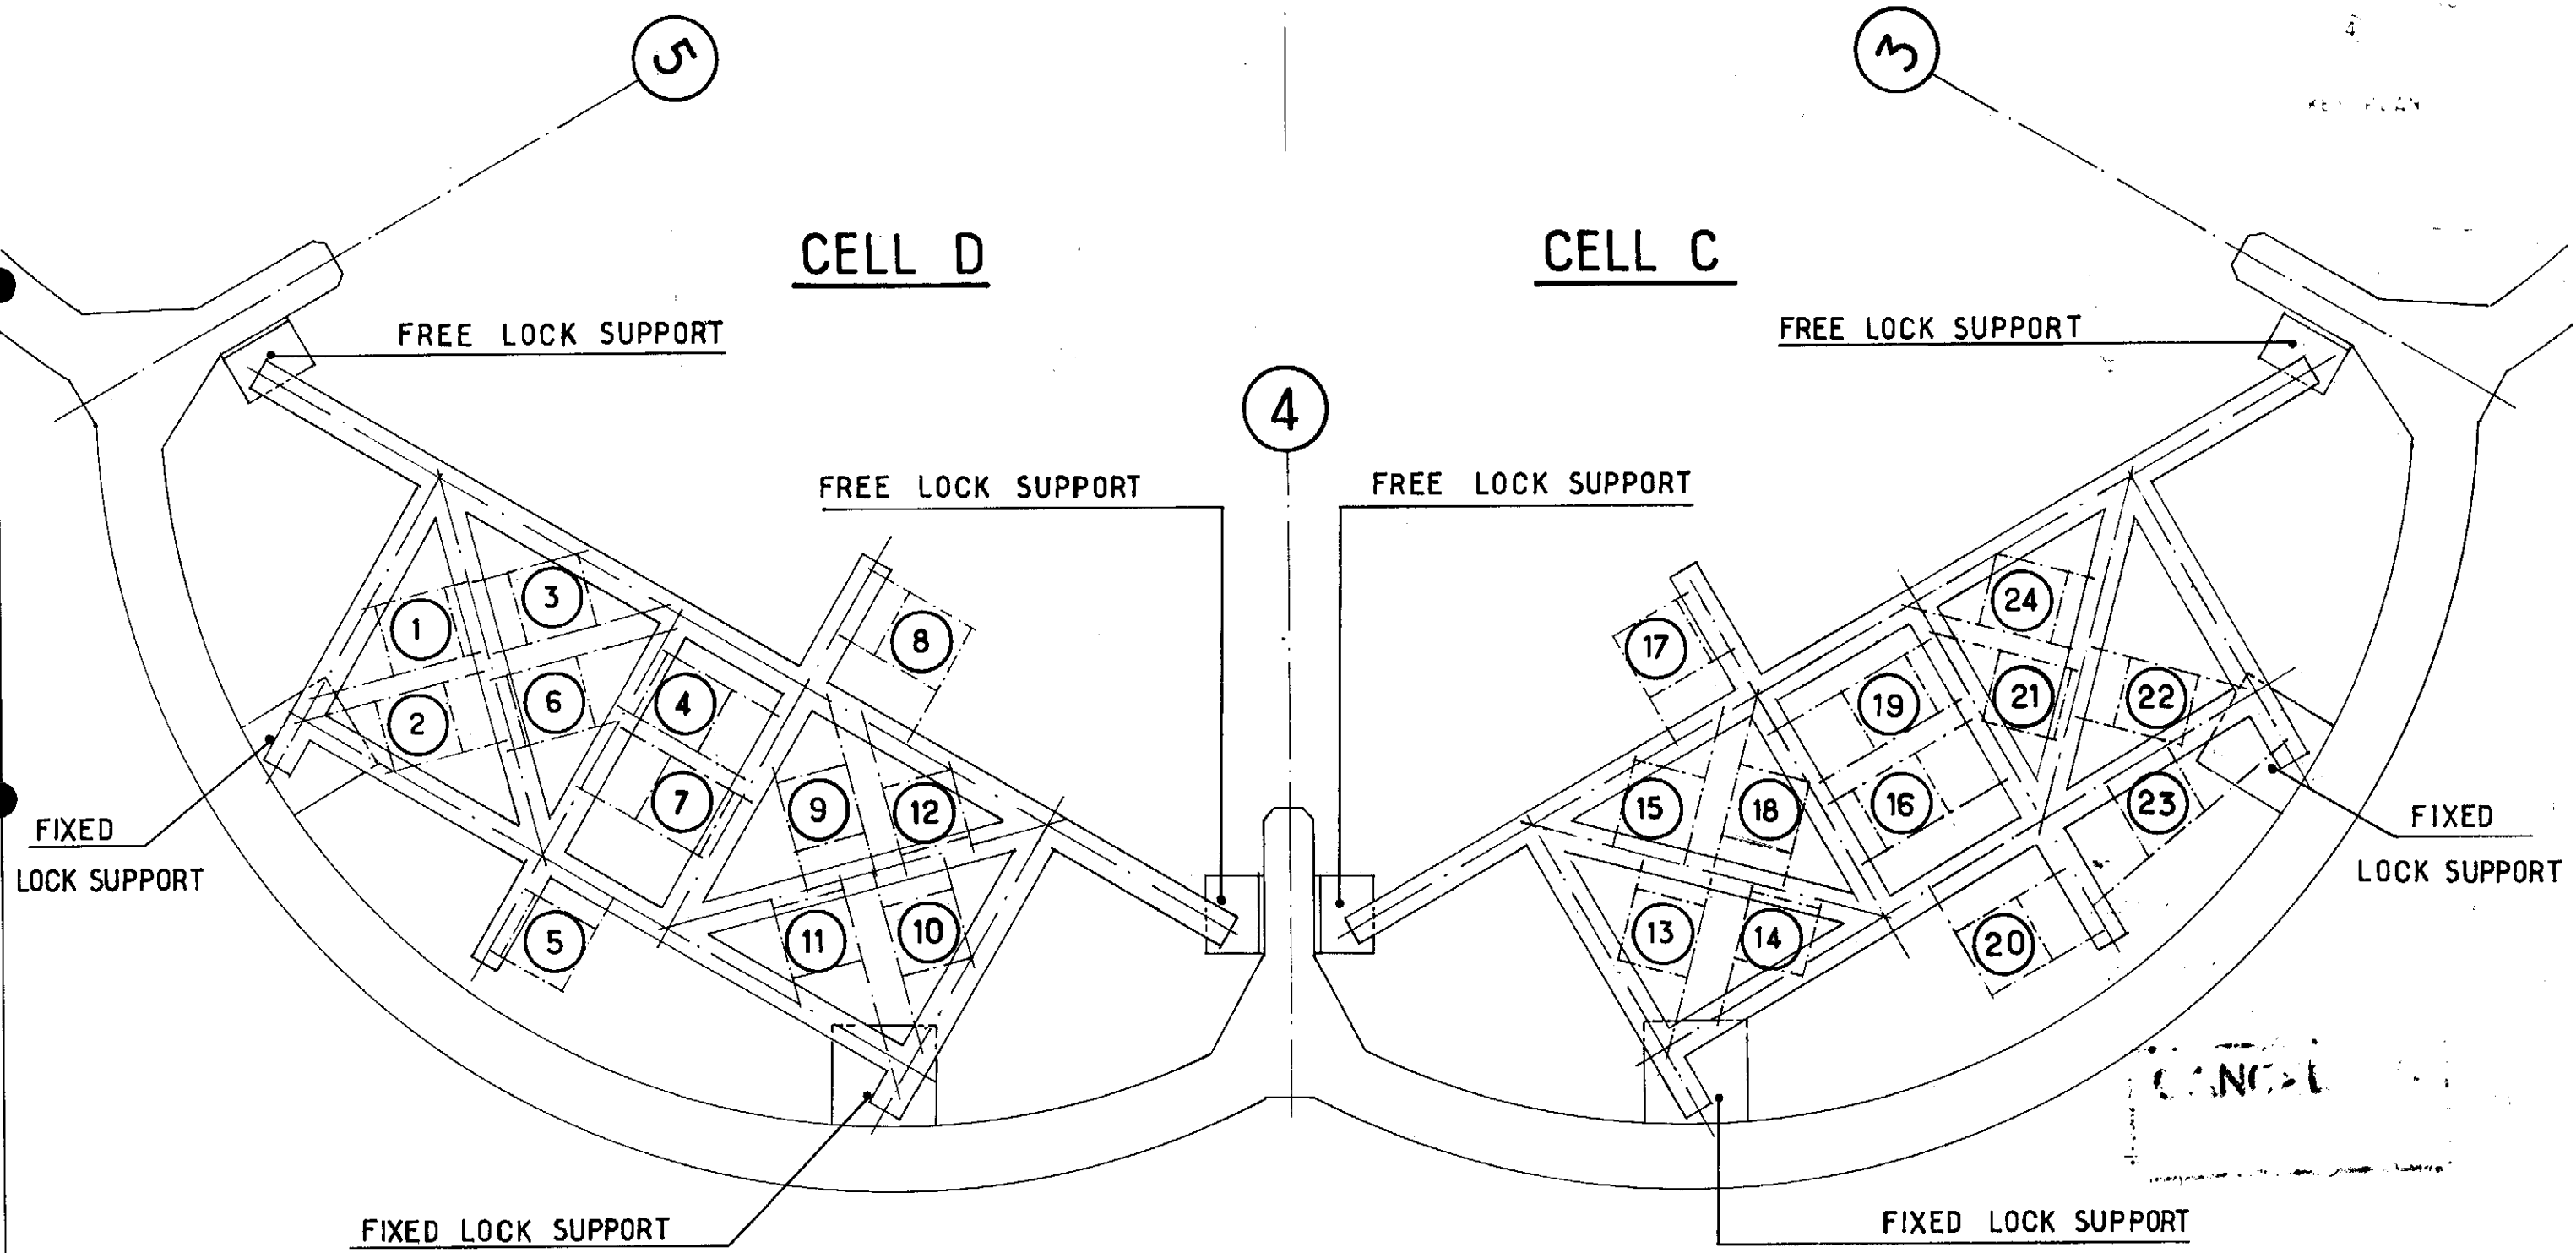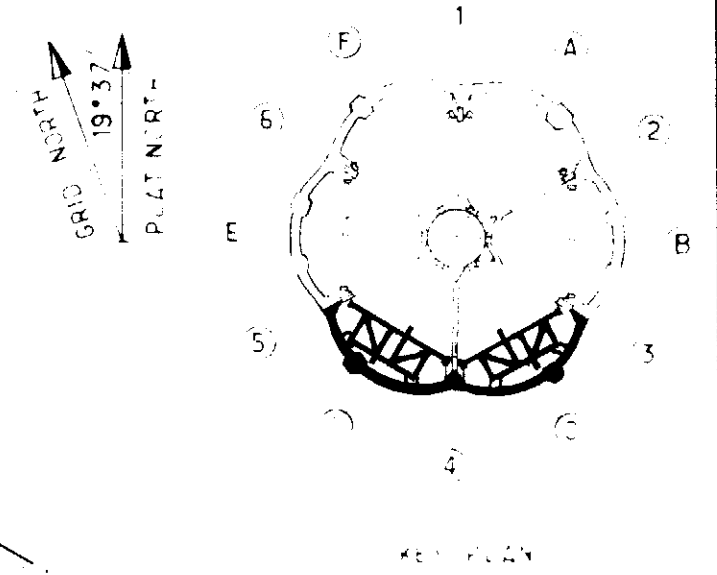

NOTES

1. SEE ALSO SK FF 91-36-35-1043

2. CONDUCTOR GUIDE FRAMES AND SECONDARY FRAME SUPPORTS REMOVED. FOR FURTHER DETAILS REF. MSD TECHNICAL PROCEDURE 5690.



					elf		Job no.	Installation CDP 1	System UNDERWATER		
02	11/90	NOTE ADDED. REF. SST. 90455		T.C.	aquitaine		Scale	GENERAL PLAN VIEW WITH CONDUCTOR NUMBER			
1	12/83	UP DATED	BVH	JLC	norge a s						
Rev.	Date	DESCRIPTION	by	APP	p. box 119		Dwgn no.	FF 91-36-35-1331	02		
Contractor JVD_1029_40.01.					4001501000						

CDP 1 AS BUILT DRAWINGS

REFERENCE DRAWING LIST FOR: CONDUCTOR GUIDE FRAME

[illegible][illegible]

				elf aquitaine norge a/s p.o.box 168 4001 Stavanger	 elf	Job no.	Installation CDP 1	System UNDERWATER		
						Scale				
Rev.	Date	DESCRIPTION	by	app.	FRIGG FIELD	Dwgr. no.			Rev.	Sheet
Contractor						4001 Stavanger	FF	1332		

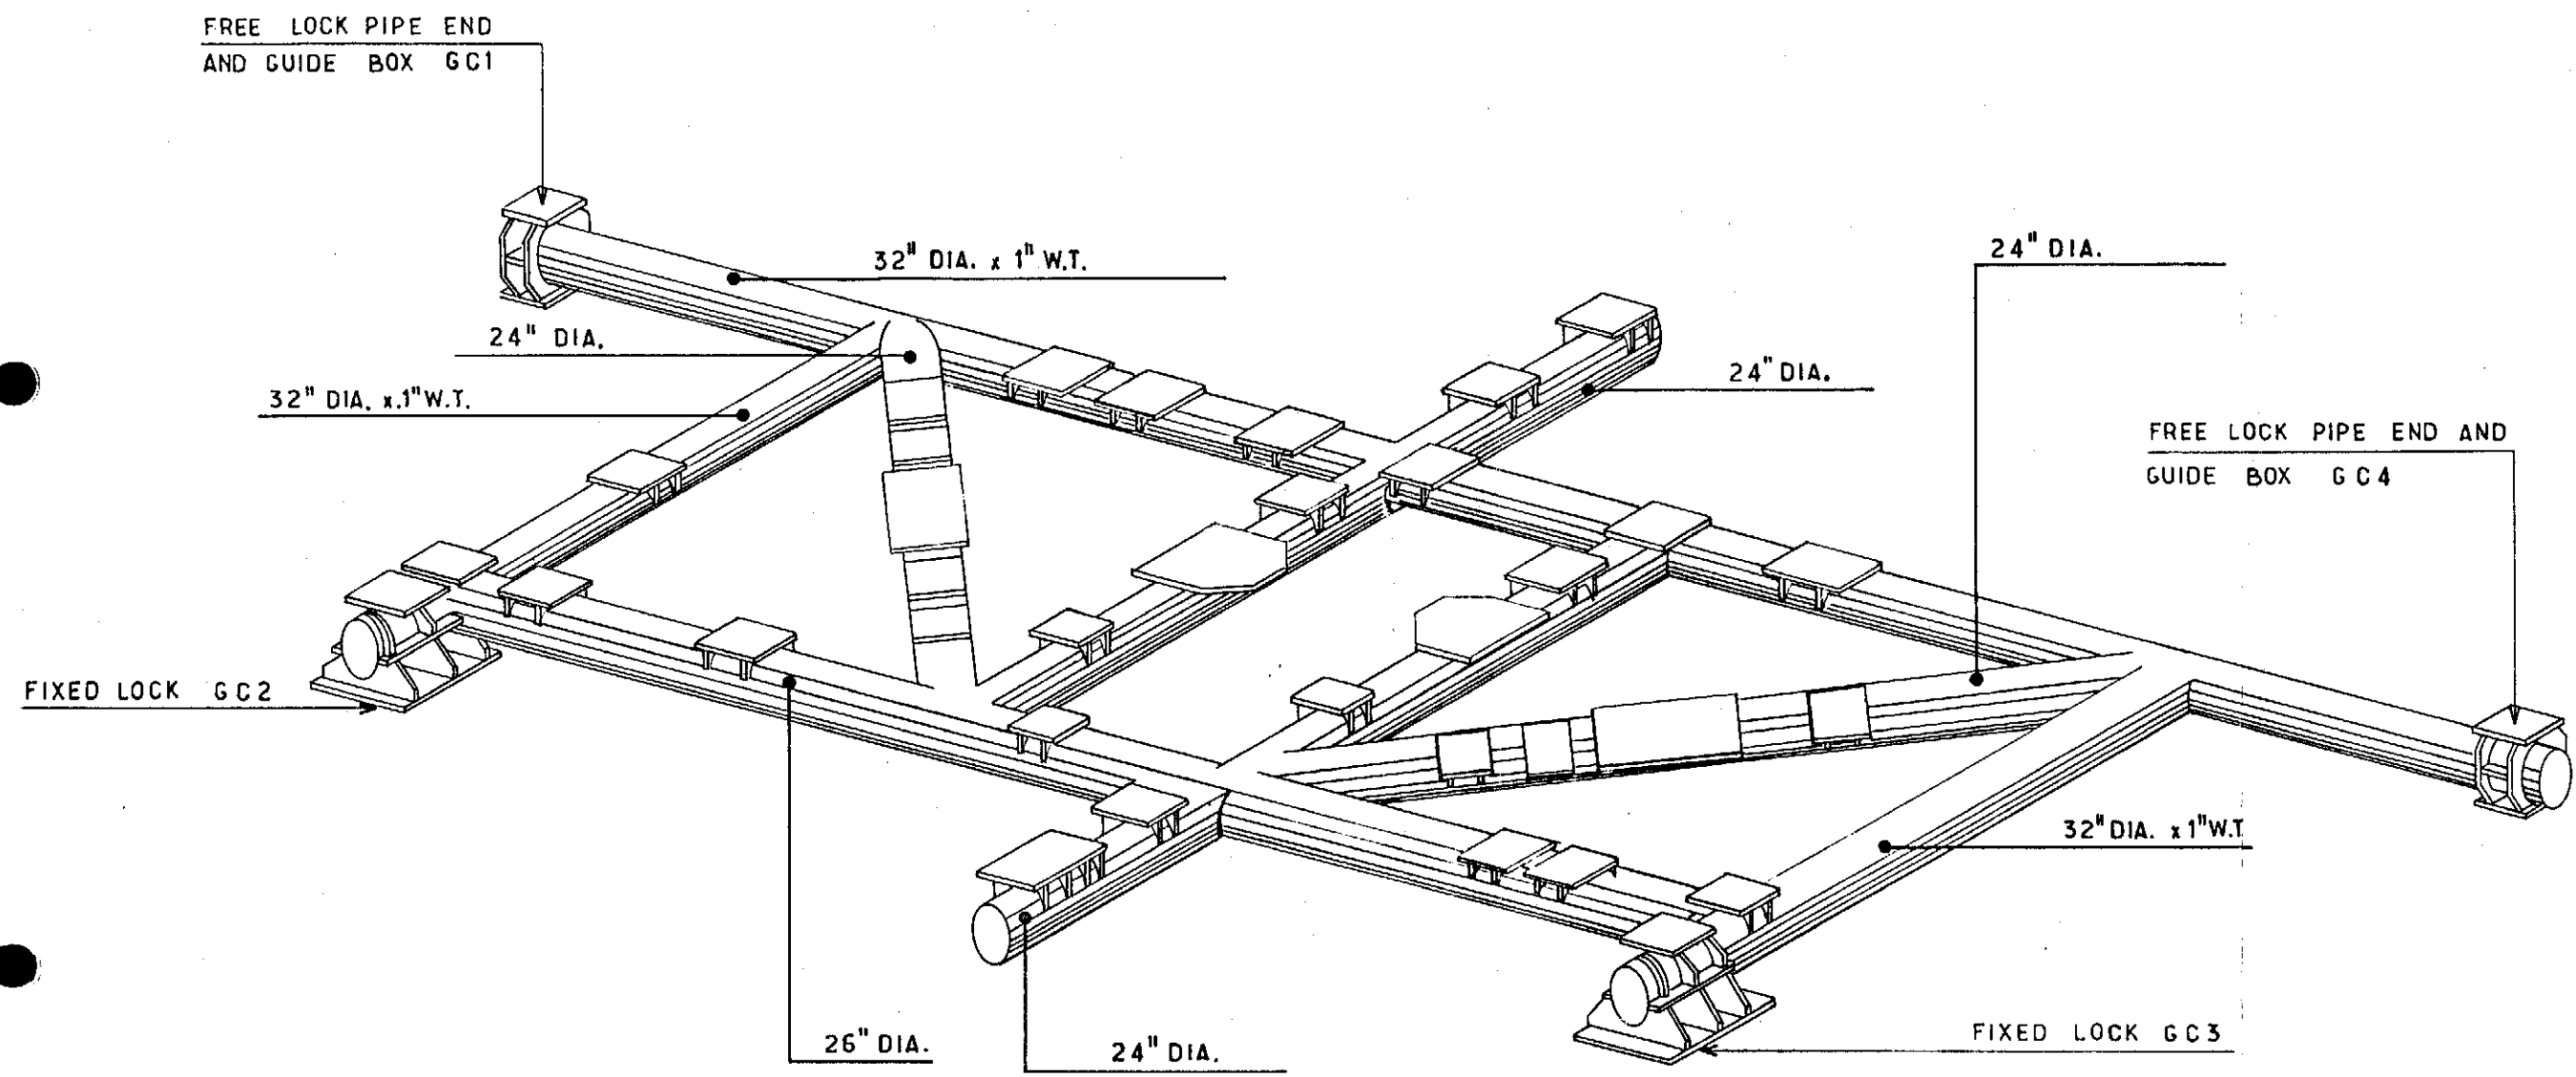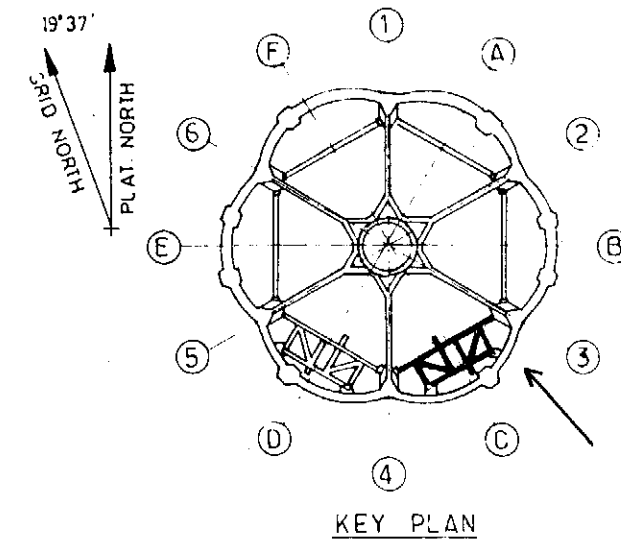

NOTES

SECONDARY FRAME DETAILS SEE SK FF 91-36-35-1334 TO FF 91.36.35.1345
 FOR FREE LOCK PIPE ENDS AND GUIDE BOXES SEE SK FF. 91.36.35.1346 / 1347 / 1348 / 1349

				elf aquitaine norge a/s		elf	Job no.	Installation CDP 1	System UNDERWATER
1	12.83	UP DATED	B.VH/lc				Scale	GENERAL VIEW OF FRAME SUPPORT	SECONDARY CELL C LEVEL G
Rev.	Date	DESCRIPTION	by	app.	p.o.box 168		Dwgr. no	FF 91-36-35-1333	1
Contractor JVD 1029-40-03					4001 Stavanger	FRIGG FIELD			

CDP 1 AS BUILT DRAWINGS

REFERENCE DRAWING LIST FOR:


[illegible][illegible]

				elf aquitaine norge a/s		 elf		Job no.		Installation CDP 1		System UNDERWATER	
				p.o.box 168				Scale					
Rev.		Date		DESCRIPTION		by app.		Dwgr. no.				Rev.	
Contractor				4001 Stavanger		FRIGG FIELD		FF — — 1333				Sheet /	


WELDED ON
SUPPORT

—CONDUCTOR GUIDE N°13—


GRID NORTH
19°37'
PLAT. NORTH

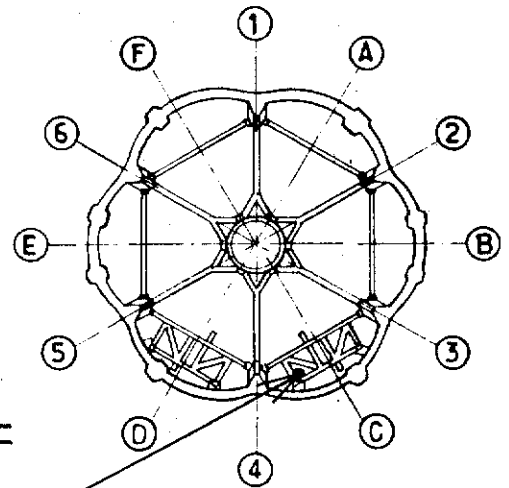


KEY PLAN

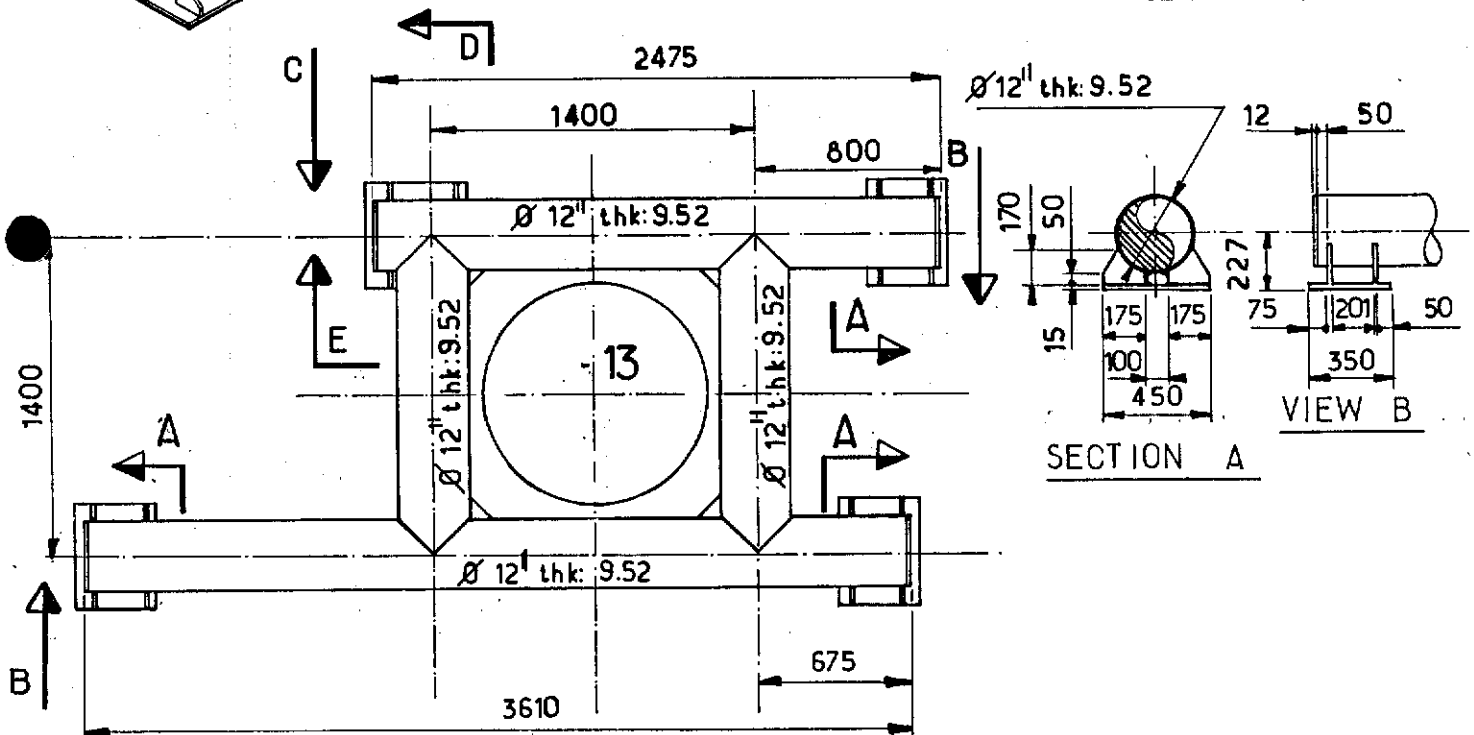


—PLAN VIEW—

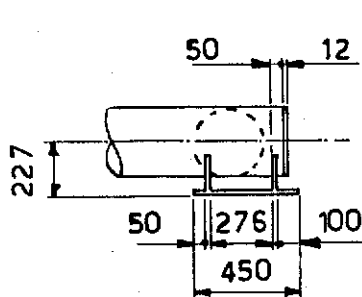

VIEW C

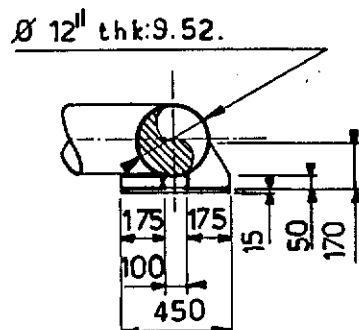

SECTION D

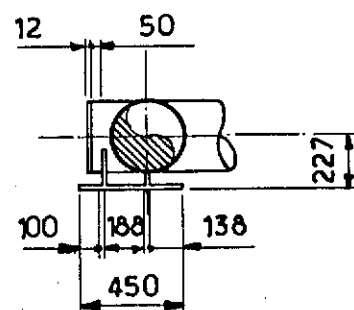

SECTION E

NOTES

FOR LOCATION SEE SK FF 91-36-35-1332.
FOR CONDUCTOR SLEEVE SEE SK FF-91-36-35-1491


				elf aquitaine norge a/s			Job no.	Installation CDP 1	System UNDERWATER
1	12 83	UP DATED	BVH	by app.	p.o.box 168		Scale 1:33	CONDUCTOR GUIDE N°13 CELL C SECONDARY FRAME LEVEL G	
Contractor JVD 1029_40_04				4001 Stavanger		FRIGG FIELD	Dwgr. no. FF 91.36.35.1334.	Rev 1	Sheet

CDP 1 AS BUILT DRAWINGS



REFERENCE DRAWING LIST FOR:

[illegible][illegible]


				elf aquitaine norge a/s p.o.box 168 4001 Stavanger	 elf	Job no.	Installation CDP 1	System UNDERWATER		
						Scale				
Rev.	Date	DESCRIPTION	by	app.	FRIGG FIELD	Dwgr. no.	FF ——— 1334		Fig.	Sheet
Contractor										

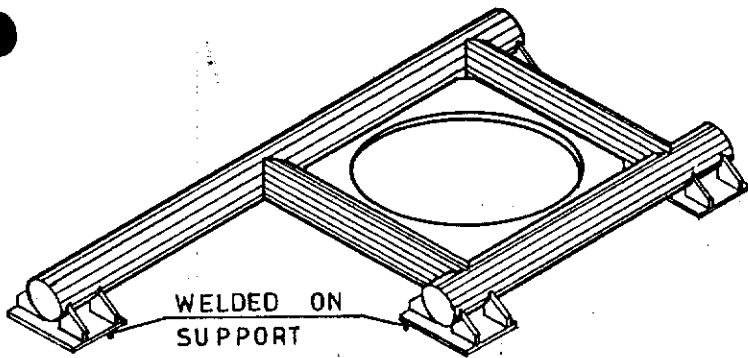


— CONDUCTOR GUIDE N°14 —

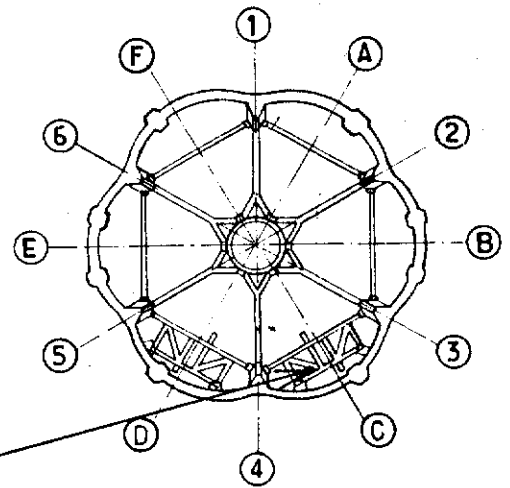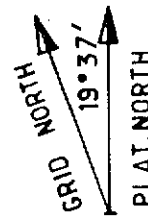

KEY PLAN

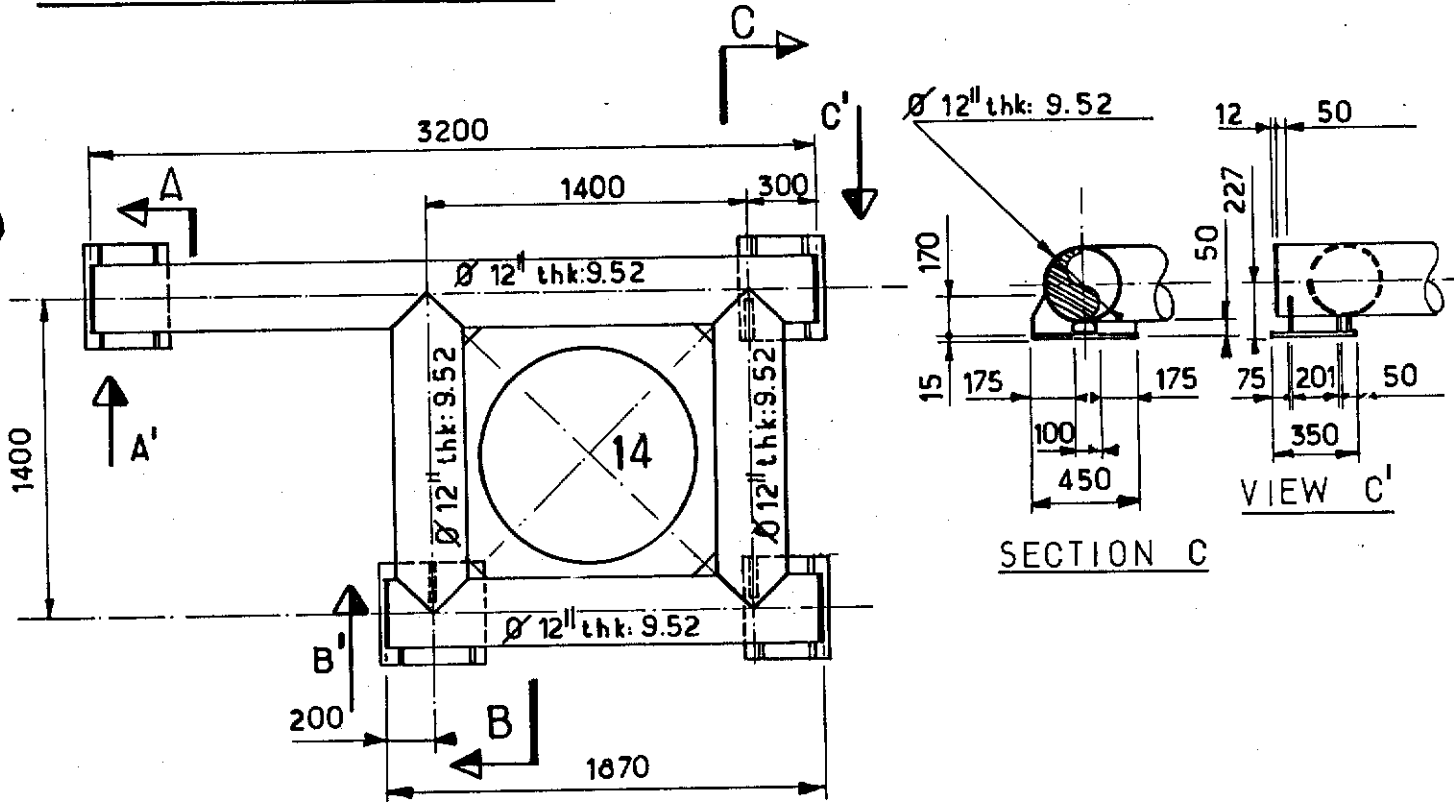


— PLAN VIEW —

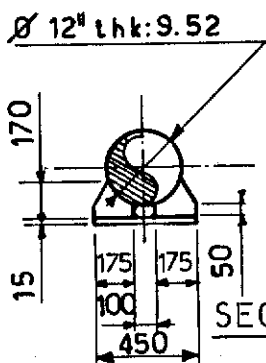


SECTION A

VIEW A'

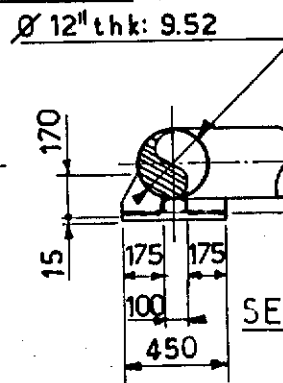

SECTION B

VIEW B'

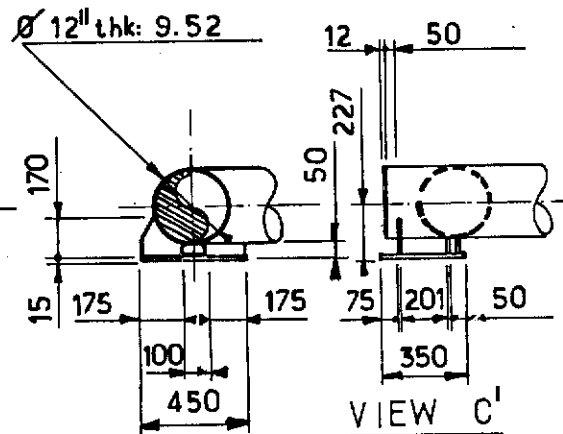

SECTION C

VIEW C'

NOTES

FOR LOCATION SEE SK FF. 91.36.35.1332.

FOR CONDUCTOR SLEEVE SK FF. 91.36.35.1491.


					elf aquitaine norge a/s p.o.box 168 4001 Stavanger	 elf	Job no.	Installation CDP 1	System UNDERWATER	
1	1283	UP DATED	BVH	J-LC			Scale 1:33	CONDUCTOR GUIDE N°14 CELL C SECONDARY FRAME LEVEL G		
Rev.	Date	DESCRIPTION	by	app.			Dwgr. no.		Rev.	Sheet
Contractor JVD 1029_40.05							FF-91-36.35-1335.		1	/
						FRIGG FIELD				

CDP 1 AS BUILT DRAWINGS


REFERENCE DRAWING LIST FOR:

[illegible][illegible]

					elf aquitaine norge a/s p.o.box 168 4001 Stavanger	 elf	Job no.	Installation CDP 1	System UNDERWATER	
							Scale			
Rev.	Date	DESCRIPTION	by	app.						
Contractor					FRIGG FIELD	Dwgr. no.	FF — — 1335		Rev.	Drawn

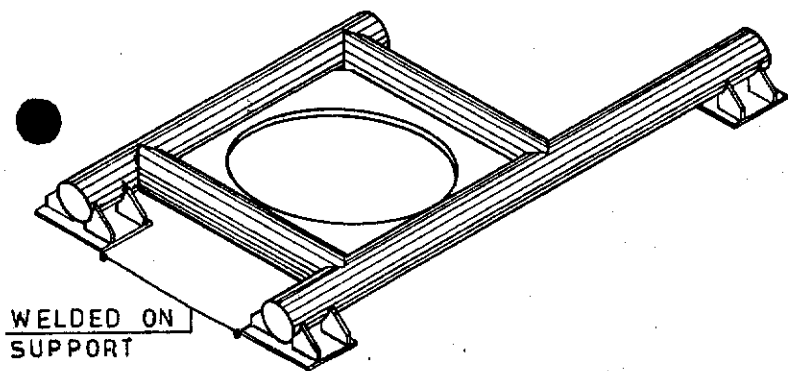


H. NORTH
19° 37'
PLAT. NORTH

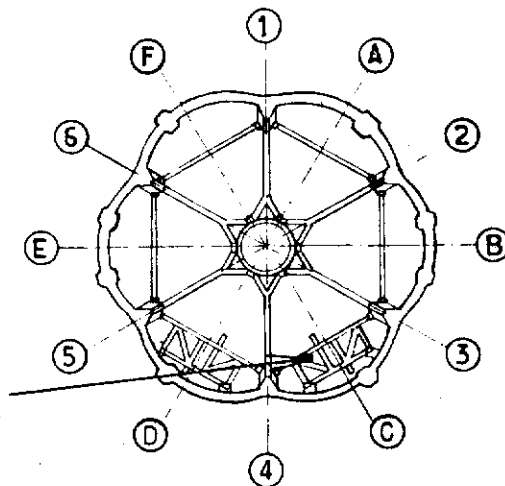


KEY PLAN

—CONDUCTOR GUIDE N°15—

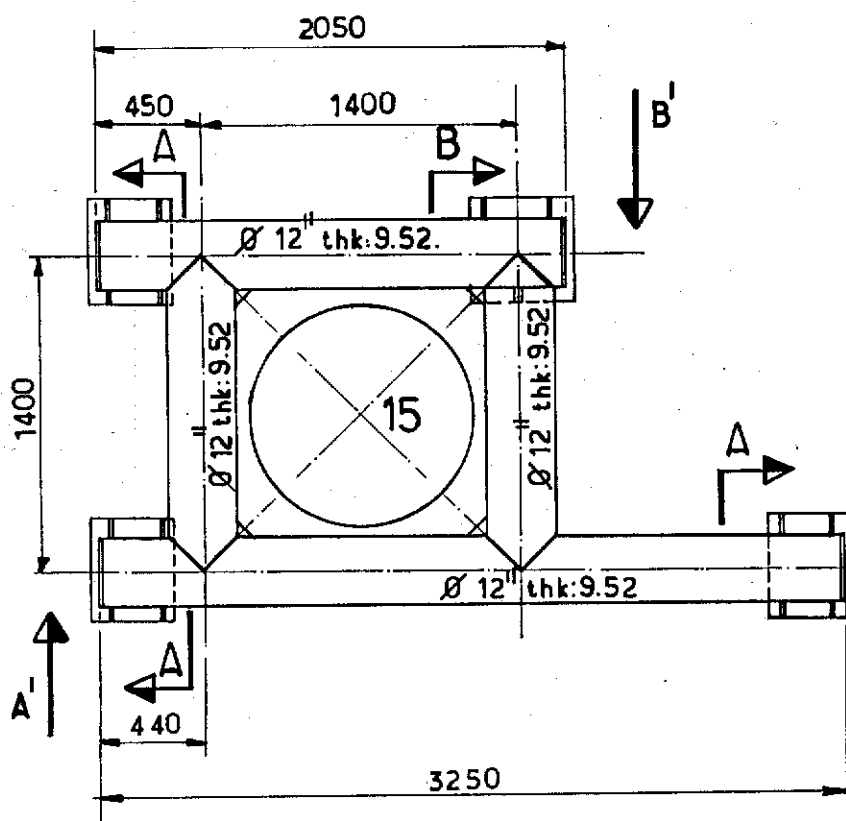

—PLAN VIEW—

—SECTION A—

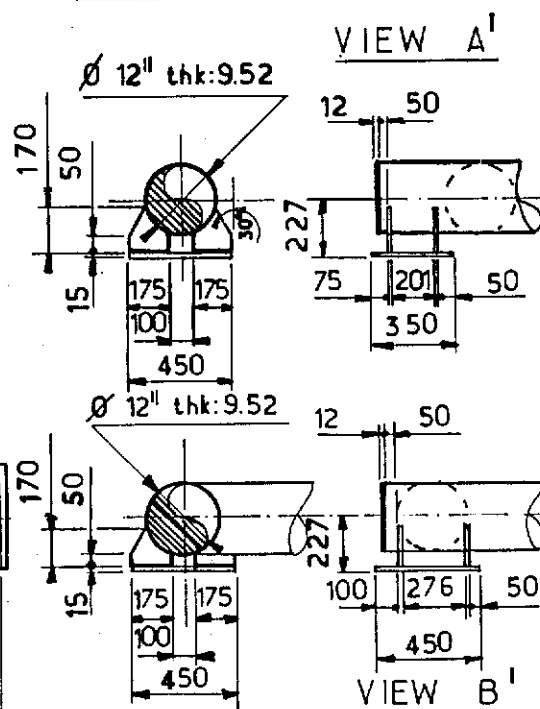

—SECTION B—

NOTES

FOR LOCATION SEE SK FF 91.36.35.1332.
FOR CONDUCTOR SLEEVE SEE SK FF.91.36.35.1491

					elf aquitaine norge a/s p.o.box 168 4001 Stavanger	 elf	Job no.	Installation CDP 1	System UNDERWATER		
1	1283	UP DATED	BVH	JLC			Scale 1:33	CONDUCTOR GUIDE N°15 CELL C SECONDARY FRAME LEVEL G			
Rev.	Date	DESCRIPTION	by	app.			Dwgr.no.	FF 91.36.35.1336.		Rev 1	Sheet /
Contractor JVD 1029_40.06					FRIGG FIELD						


CDP 1 AS BUILT DRAWINGS

● REFERENCE DRAWING LIST FOR:

[illegible][illegible]


							Job no.	Installation CDP 1	System UNDERWATER
							Scale		
Rev.	Date	DESCRIPTION	by	app.			Dwgr. no.	FF — — 1336	
Contractor						4001 Stavanger	FRIGG FIELD		

WELDED ON
SUPPORT

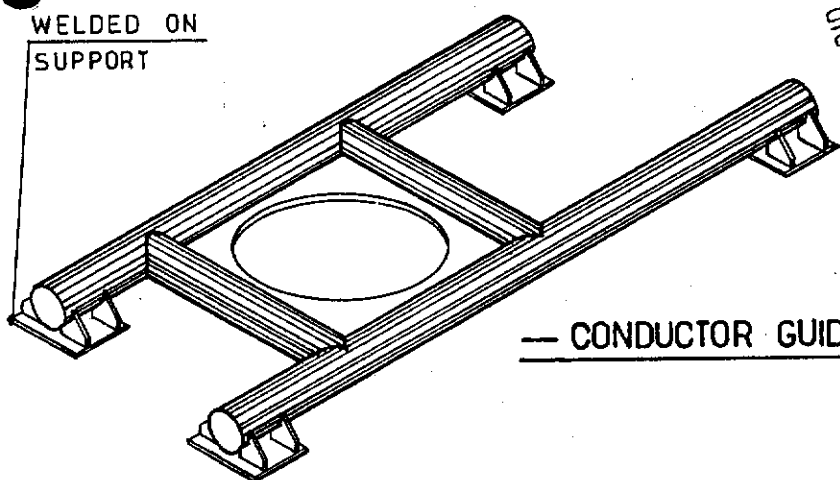


— CONDUCTOR GUIDE N°16 —

GRD NORTH
19°37'
PLAT. NORTH

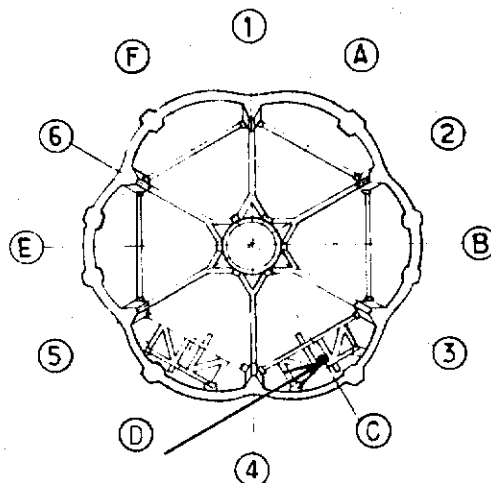

KEY PLAN

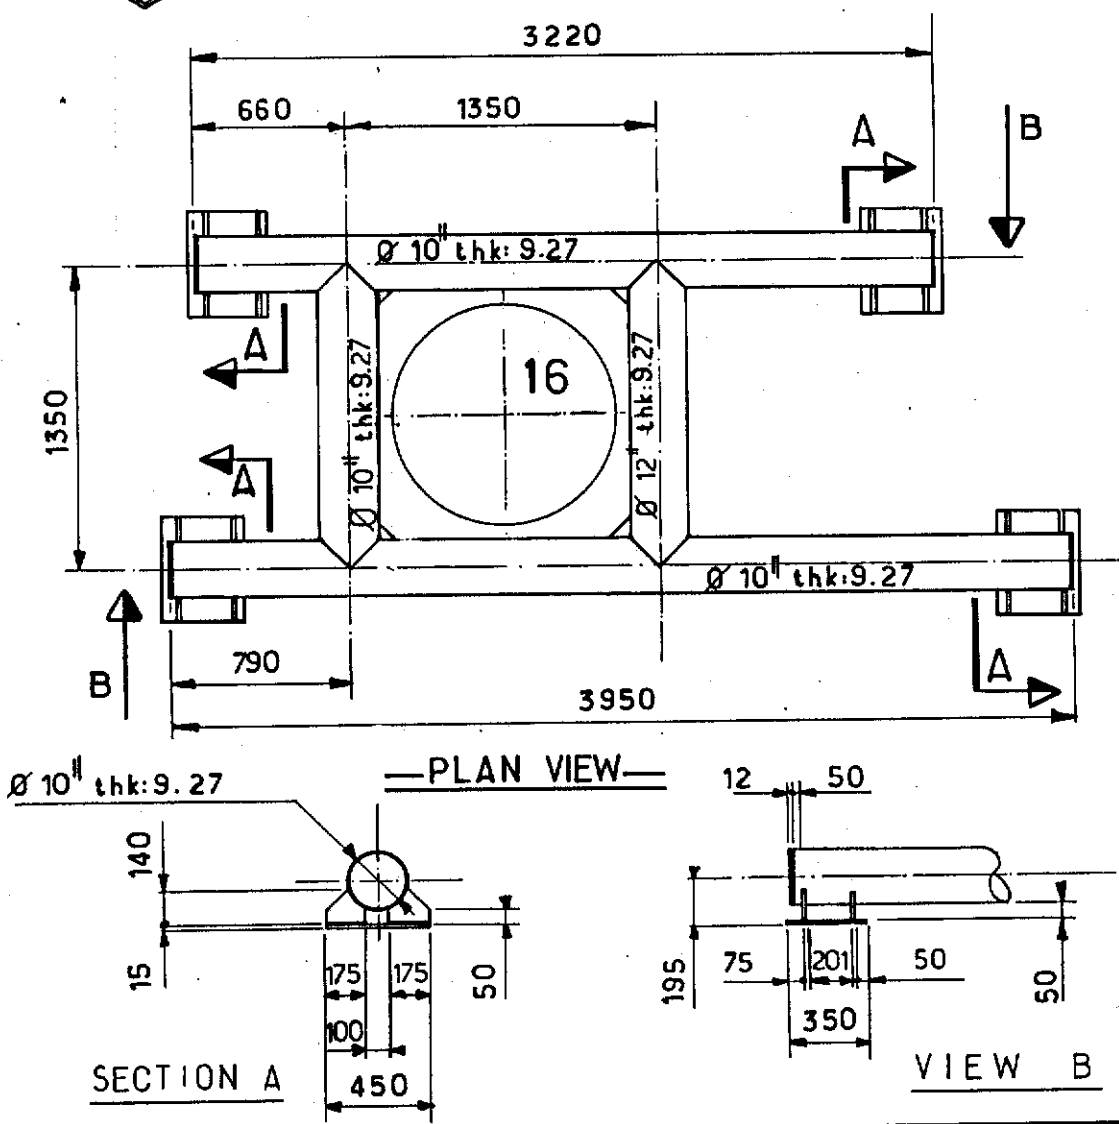

NOTES

FOR LOCATION SEE SK FF 91.36.35.1332.
FOR CONDUCTOR SLEEVE SEE SK FF.91.36.35.1491.

					 elf	Job no.	Installation CDP 1	System UNDERWATER			
1	1283	UP DATED	BVH	JLL		Scale 1:33	CONDUCTOR GUIDE N°16 CELL C SECONDARY FRAME LEVEL 6				
Rev.	Date	DESCRIPTION	by	app.				Dwgr. no.	FF 91_36_35_1337.	Rev. 1	Sheet /
Contractor JVD 1029_40 07						FRIGG FIELD					


CDP 1 AS BUILT DRAWINGS

REFERENCE DRAWING LIST FOR:


[illegible][illegible]

				elf aquitaine norge a/s p.o.box 168 4001 Slanger		 elf		Job no.		Installation CDP 1		System UNDERWATER	
								Scale					
Rev.		Date		DESCRIPTION		by		app.		Dwgr. no.		FF — — 1337	
Contractor						FRIGG FIELD							

WELDED ON
SUPPORT

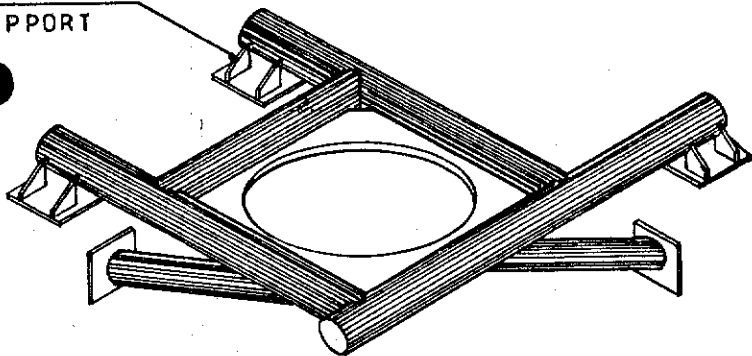


GRID NORTH
19° 37'
PLAT. NORTH

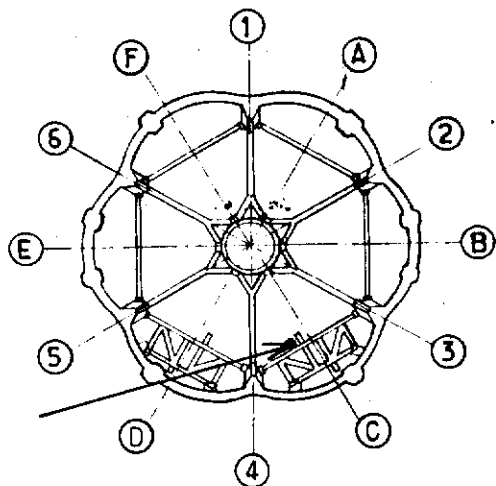


— CONDUCTOR GUIDE N°17 —

KEY PLAN

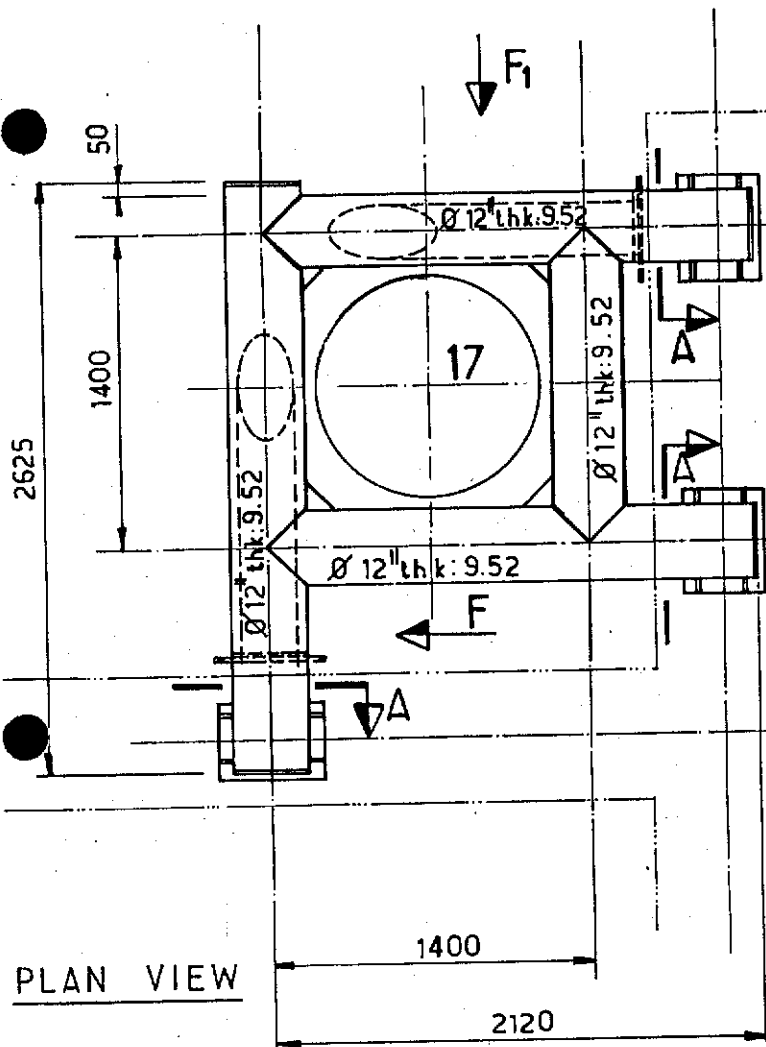


PLAN VIEW


SECTION A

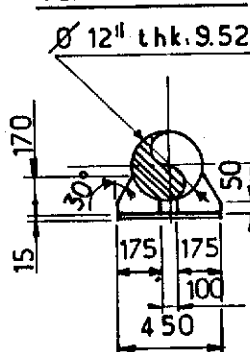

VIEW B

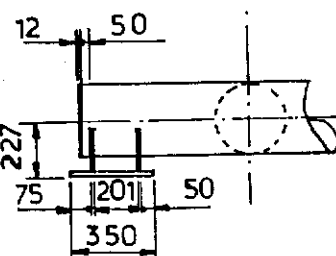

1725 FOR F
1600 FOR F1

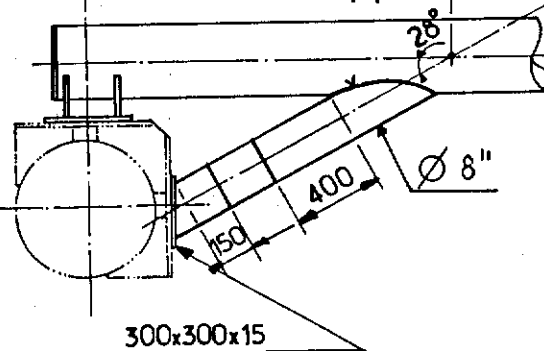

— VIEW F AND F1 —

NOTES

FOR LOCATION SEE SK FF.91.36.35.1332
FOR CONDUCTOR SLEEVE SEE SK FF 91.36.35.1491


					 elf	Job no.	Installation CDP 1	System UNDERWATER
1	12.83	UP DATED	BVH	JLC		Scale 1:33	CONDUCTOR GUIDE N°17 CELL C SECONDARY FRAME	LEVEL G
Rev.	Date	DESCRIPTION	by	app.		Dwgr. no.	FF 91_36.35.1338.	Rev 1
Contractor JVD 1029_40_08					4001 Stavanger	FRIGG FIELD		

CDP 1 AS BUILT DRAWINGS



REFERENCE DRAWING LIST FOR:

[illegible][illegible]


						elf aquitaine norge a/s p.o.box 168 4001 Stavanger	 elf	Job no.	Installation CDP 1	System UNDERWATER
								Scale		
Rev.	Date	DESCRIPTION	by	app.				Dwgr. no.		
Contractor						4001 Stavanger	FRIGG FIELD	FF	1338	

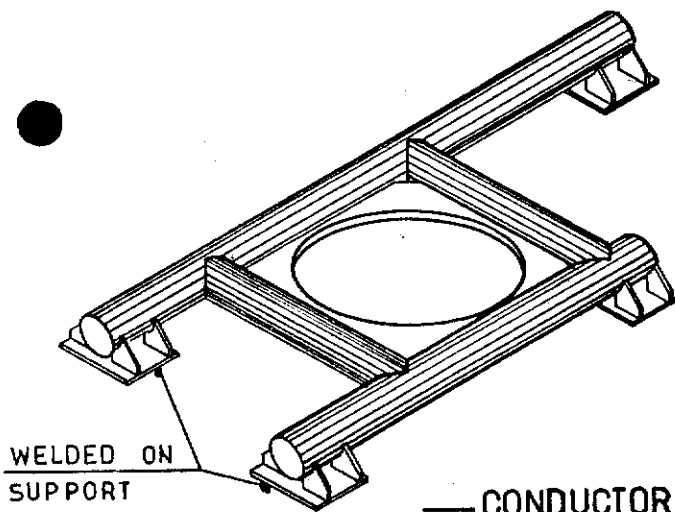


— CONDUCTOR GUIDE N°18 —

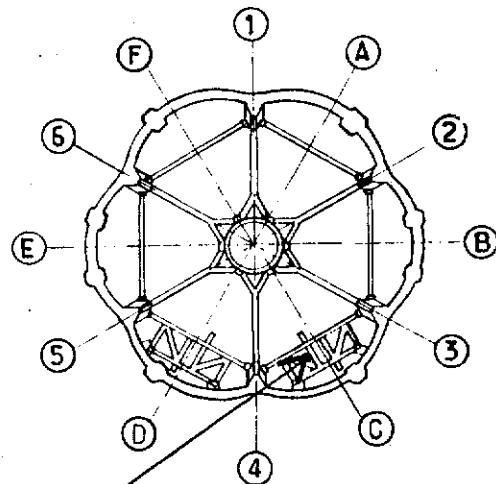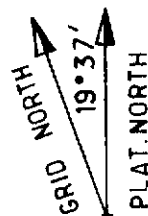

KEY PLAN

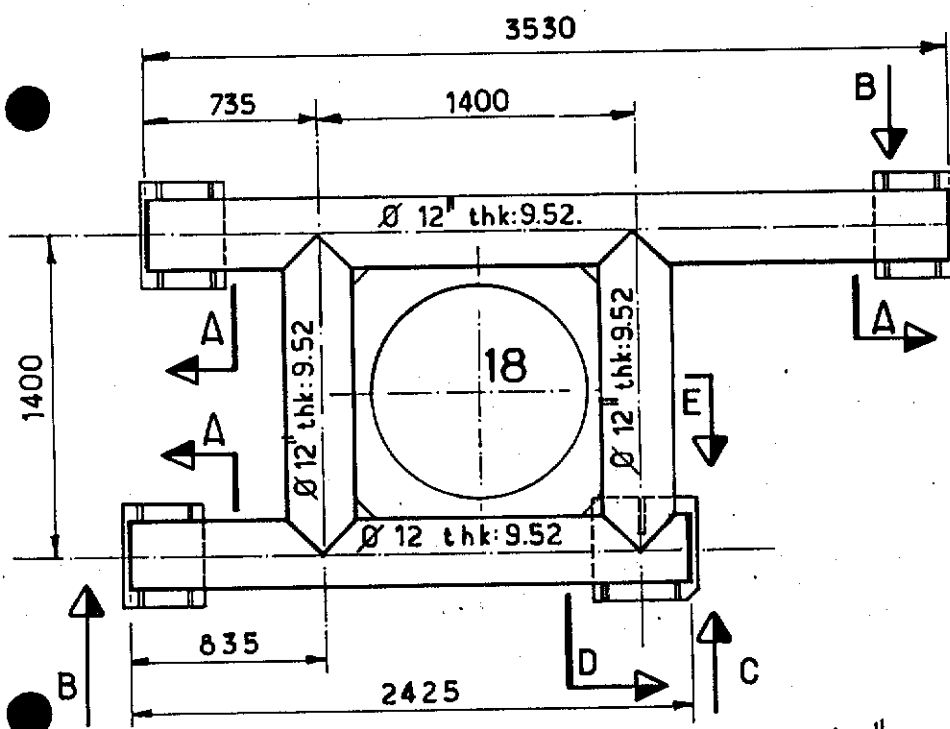


— PLAN VIEW —

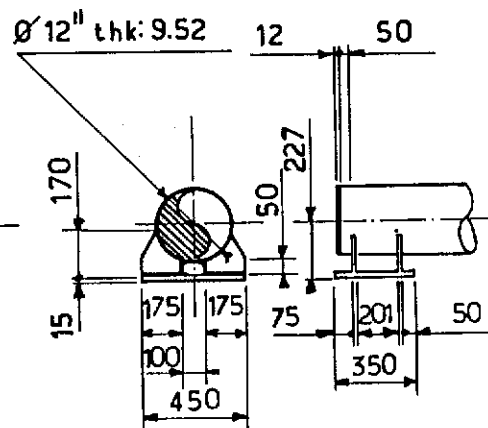


SECTION A


VIEW B

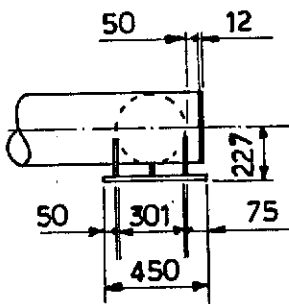

VIEW C

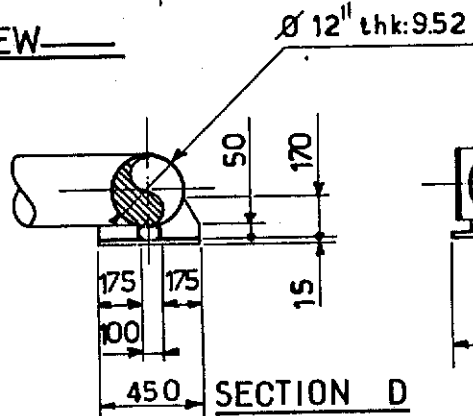

SECTION D

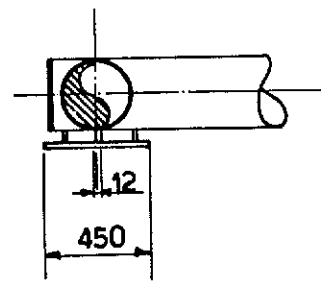

SECTION E

NOTES

FOR LOCATION SEE SK FF 91.36.35.1332.
FOR CONDUCTOR SLEEVE SEE SK FF 91.36.35.1491


FOR CONDUCTOR SLEEVE SEE SK FF 91.36.35.1339						 elf	Job no.	Installation CDP 1	System UNDERWATER			
1	12.83	UP DATED	BVH	J-LC	p.o.box 168		Scale 1:33	CONDUCTOR GUIDE N°18 CELL C SECONDARY FRAME LEVEL G				
Rev.	Date	DESCRIPTION	by	app.			Dwgr. no.		Rev.	Sheet		
Contractor JYD 1029_40.09						4001 Stavanger	FRIGG FIELD		FF 91.36.35.1339		1	/

CDP 1 AS BUILT DRAWINGS

REFERENCE DRAWING LIST FOR:

[illegible][illegible]

				elf aquitaine norge a/s p.o.box 168 4001 Stavanger	 elf	Job no.	Installation CDP 1	System UNDERWATER	
						Scale			
Date	DESCRIPTION	by	app.			Dwgr. no.	FF — — 1339	Rev.	1
tractor				FRIGG FIELD					

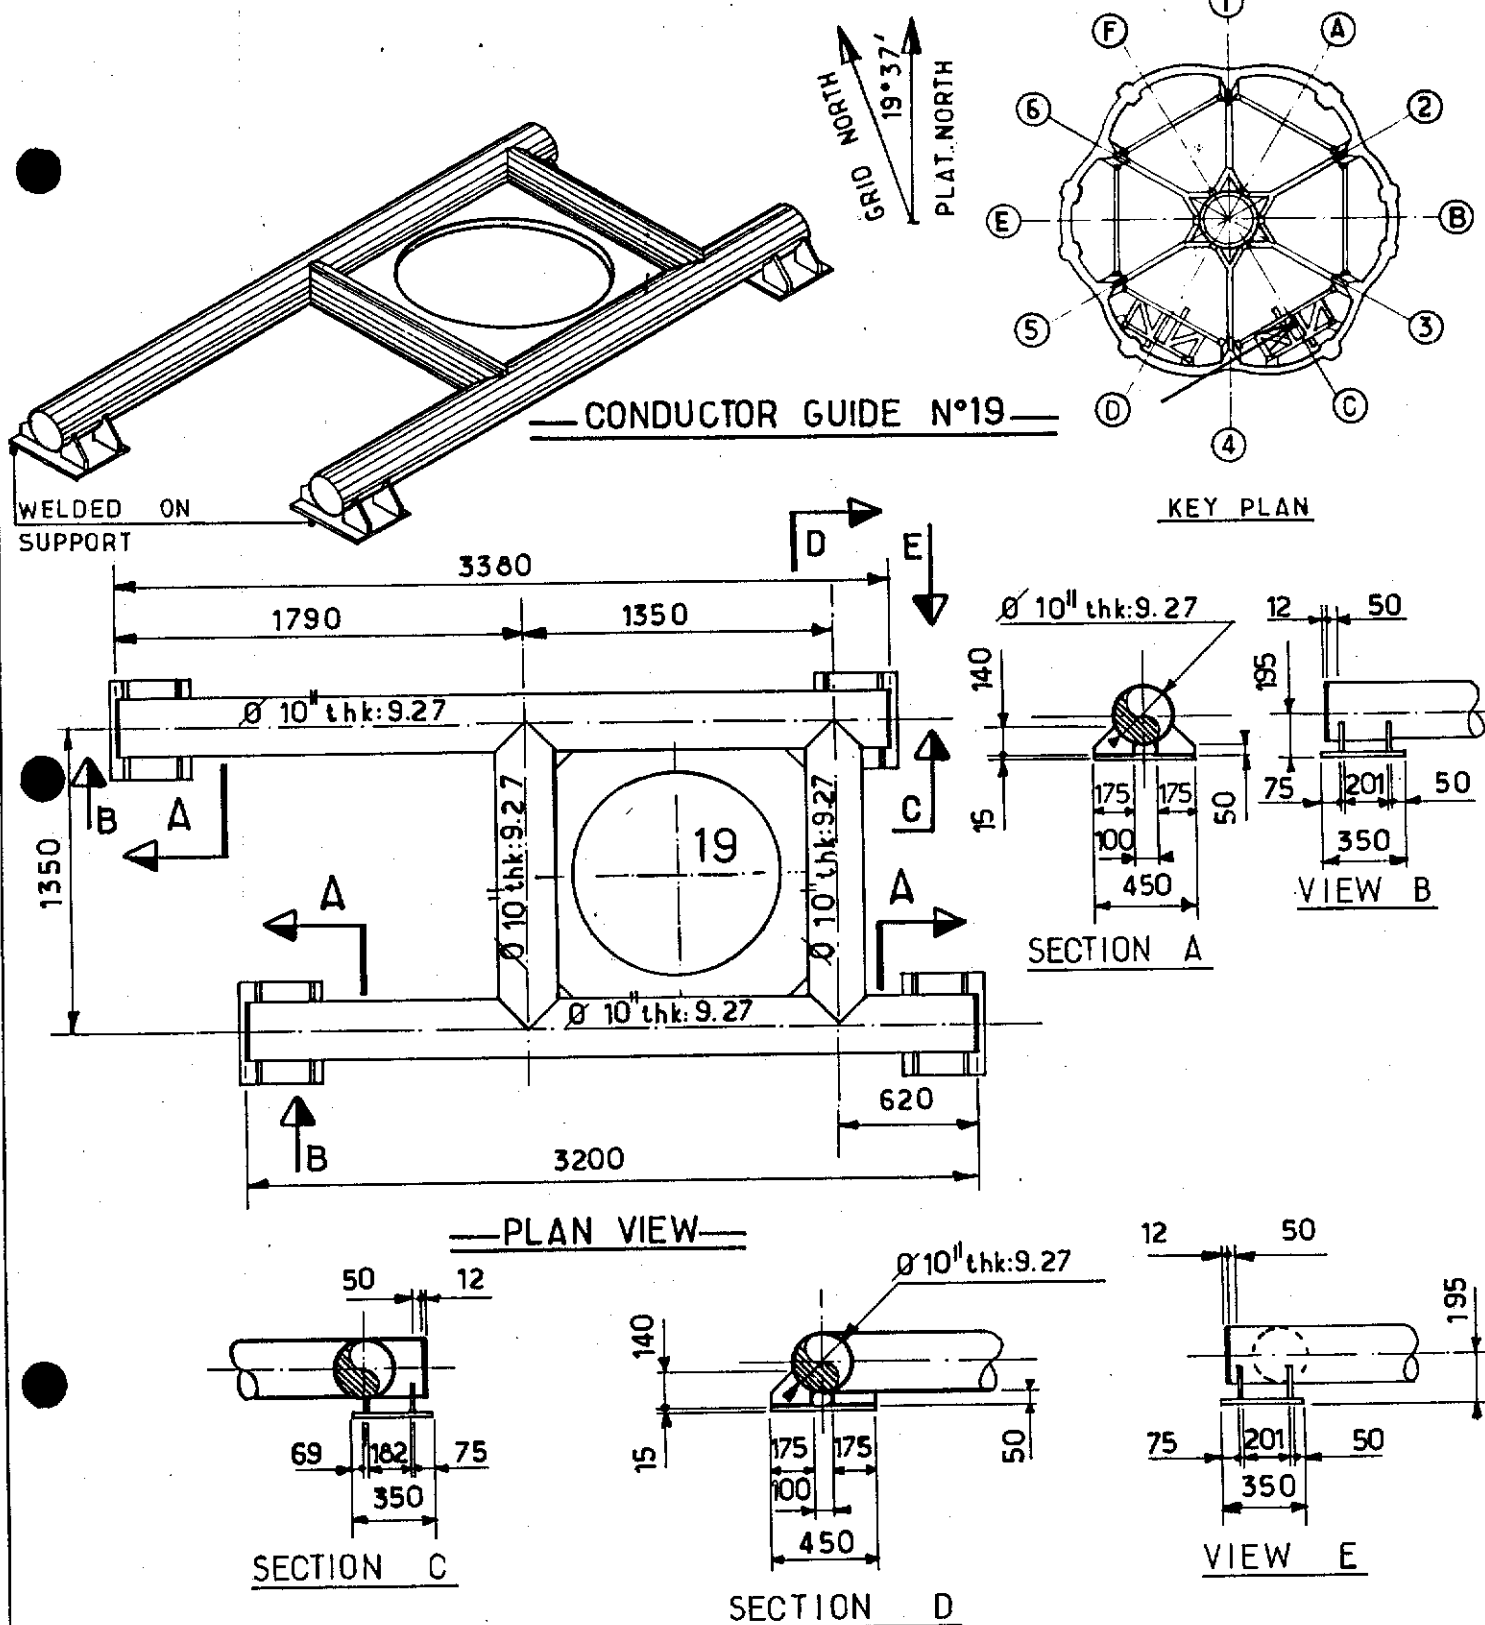

NOTES

FOR LOCATION SEE SK FF 91.36.35.1332.
FOR CONDUCTOR SLEEVE SEE SK FF.91.36.35.1491.


					elf aquitaine norge a/s p.q.box 168 4001 Stavanger	 elf	Job no.	Installation CDP 1	System UNDERWATER	
1	12.83	UP DATED	B.V.H	JLC			Scale 1:33	CONDUCTOR GUIDE N°19 CELL C SECONDARY FRAME LEVEL G		
Rev.	Date	DESCRIPTION	by	app.			Dwgr. no.		Rev.	Sheet
Contractor JVD 1029_40.10							FRIGG FIELD	FF 91_36_35_1340	1	/

CDP 1 AS BUILT DRAWINGS

REFERENCE DRAWING LIST FOR:

[illegible][illegible]


				elf			Job no.	Installation CDP 1		System UNDERWATER		
				aquitaine			Scale					
				norge a/s		elf						
				p.o.box 168			Dwgr. no.	FF		1340		
Rev.		Date		DESCRIPTION		4001 Stavanger		FRIGG FIELD				
				by								
				app.								
Contractor												

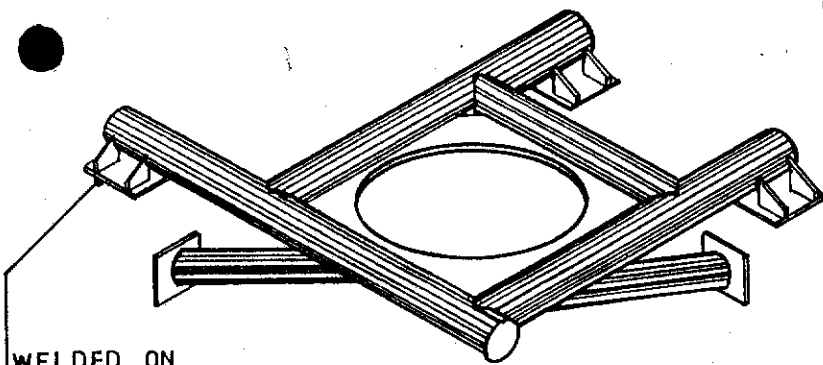


WELDED ON
SUPPORT

— CONDUCTOR GUIDE N°20 —

GRID NORTH
19°37'
PLAT. NORTH

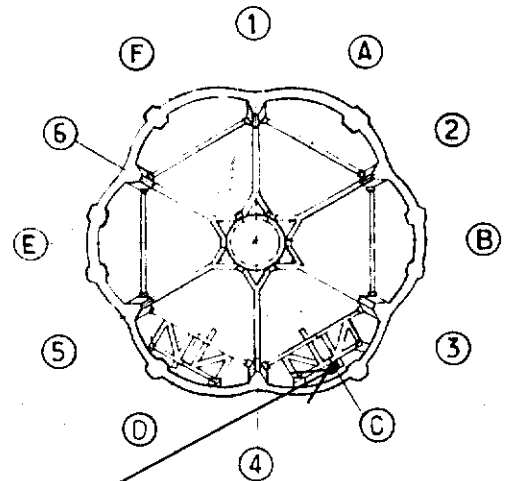


KEY PLAN


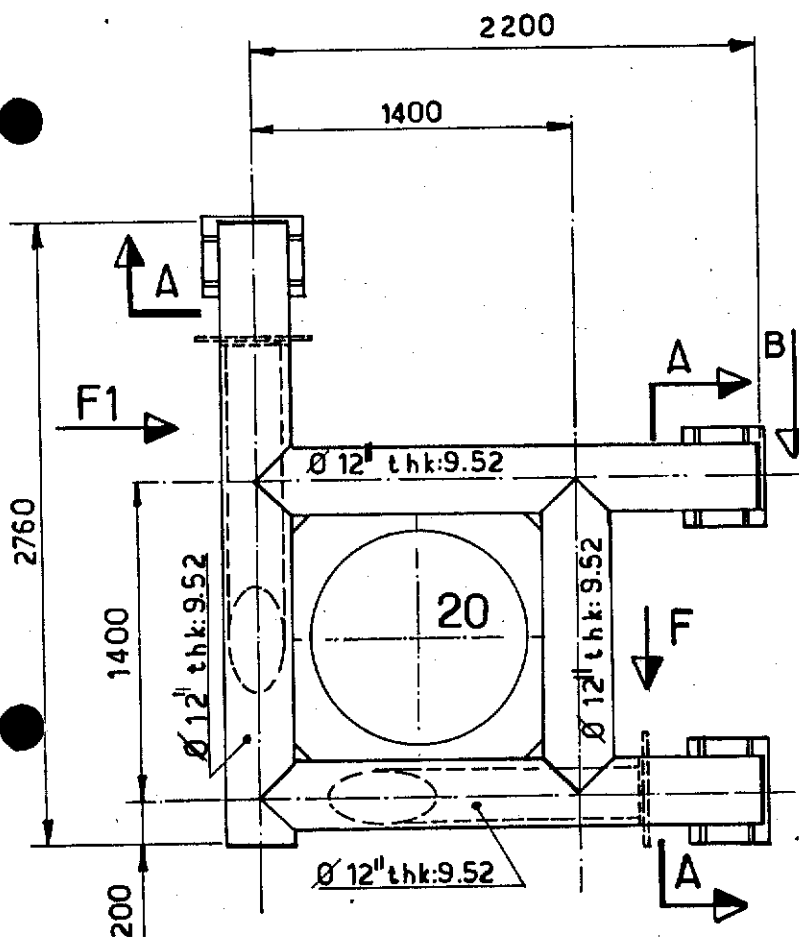


— PLAN VIEW —

SECTION A

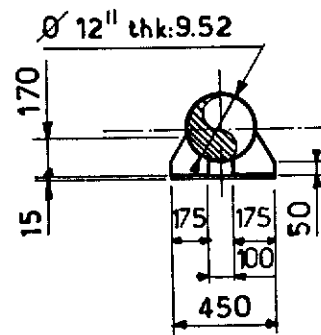

VIEW B

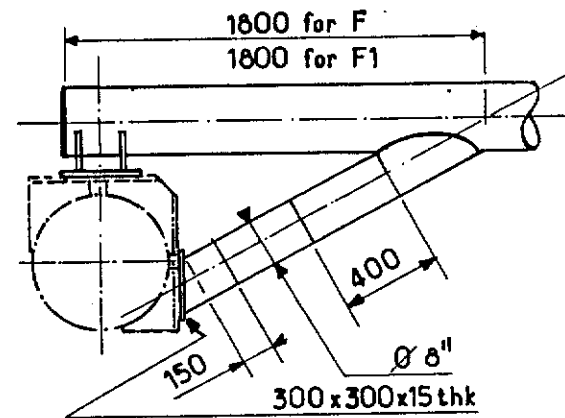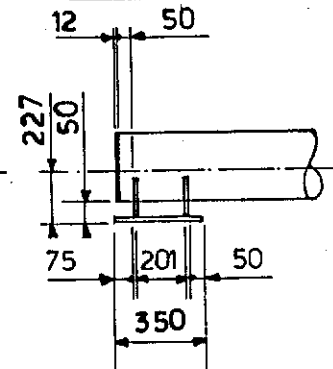

— VIEW F AND F1 —

NOTES

FOR LOCATION SEE SK FF 91-36-35-1332
FOR CONDUCTOR SLEEVE SEE SK FF-91-36-35-1491.

1	1283	UP DATED	BVH	1-10
Rev.	Date	DESCRIPTION	by	app.
Contractor JVD 1029-4011				

elf
aquitaine
norge a/s
p.o.box 168
4001 Stavanger

elf
FRIGG FIELD

Job no.	Installation CDP 1	System UNDERWATER
Scale 1:33	CONDUCTOR GUIDE N° 20 CELL C SECONDARY FRAME LEVEL C	
Dwgr. no.	FF 91-36-35-1341	Rev. 1


CDP 1 AS BUILT DRAWINGS

●REFERENCE DRAWING LIST FOR:


[illegible][illegible]

elf aquitaine norge a/s p.o.box 168 4001 Slangerup  elf Job no. Scale Dwgr. no. Installation CDP 1 FF System UNDERWATER 1341				
Rev.	Date	DESCRIPTION	by	app.
Contractor				


CONDUCTOR GUIDE N°21

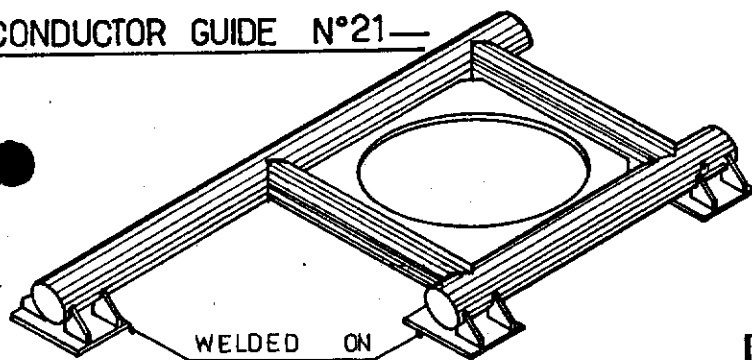


GRID NORTH
19°37'
PLAT. NORTH

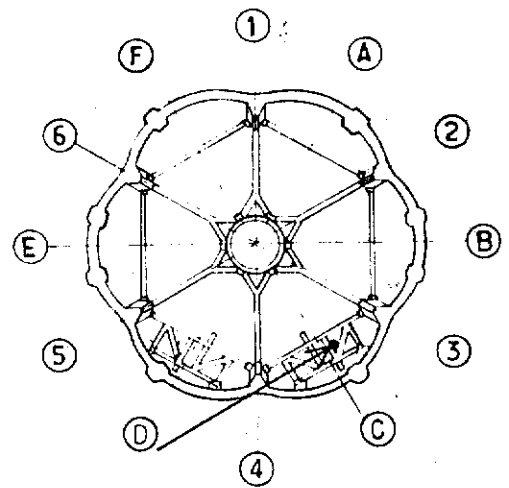

KEY PLAN

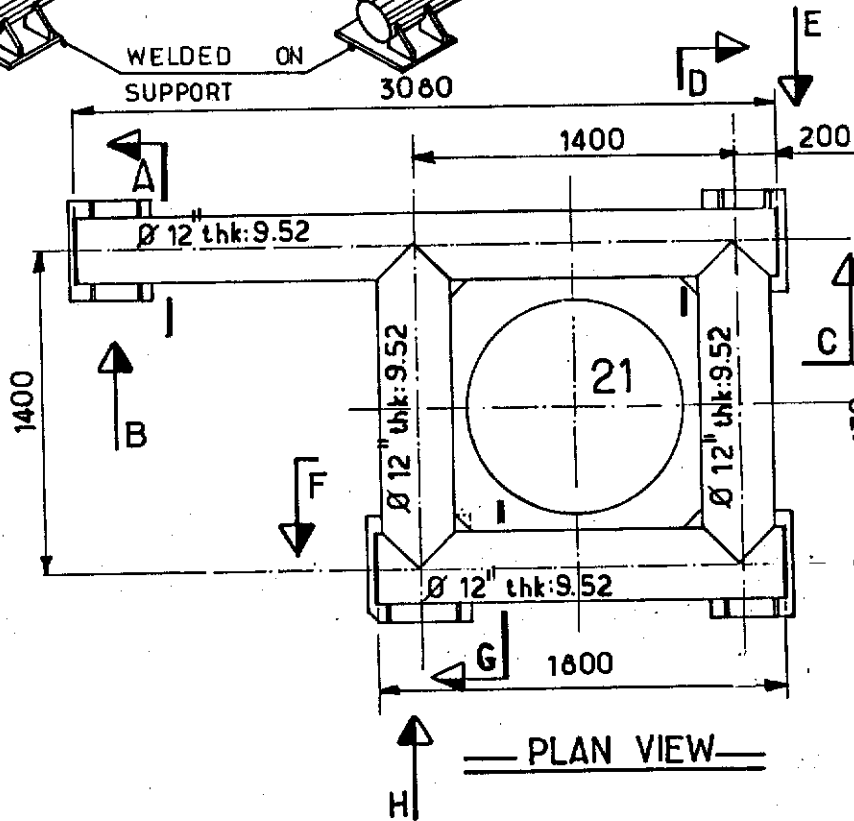


PLAN VIEW

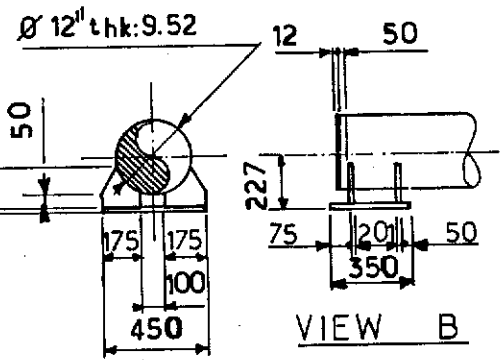


SECTION A


VIEW B

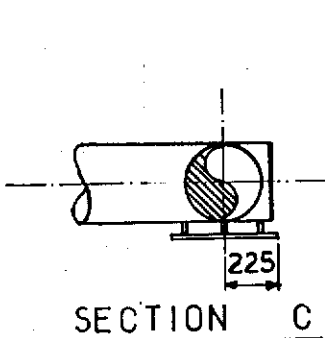


SECTION C

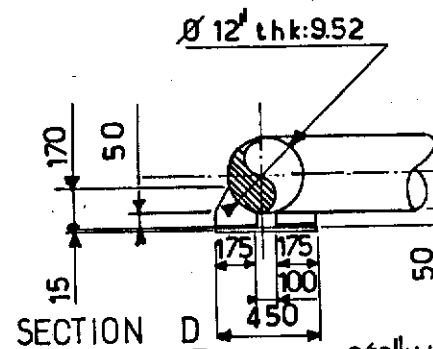


SECTION D

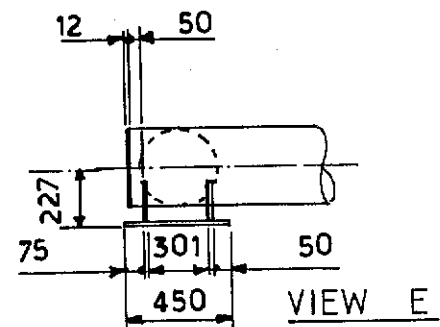


VIEW E

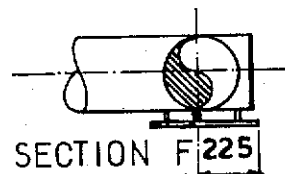

SECTION F

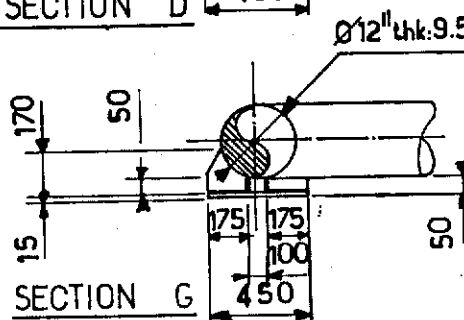

SECTION G

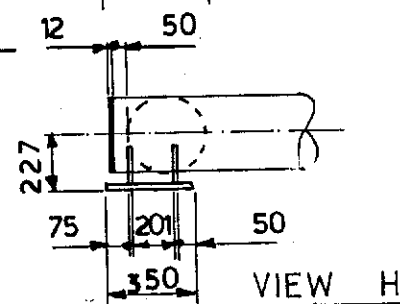

VIEW H

NOTES

FOR LOCATION SEE SK FF.91.36.35.1332.
FOR CONDUCTOR SLEEVE SEE SK FF.91.36.35.1491.

				elf aquitaine norge a/s		Job no.	Installation CDP 1	System UNDERWATER
1	12.83	UP DATED	BVH JLC	p.o.box 168		Scale 1:33	CONDUCTOR GUIDE N°21 CELL C SECONDARY FRAME LEVEL C	
Rev.	Date	DESCRIPTION	by	app.		Dwgr. no.	Rev.	Sheet
Contractor JVD 1029.40.12.				4001 Stavanger		FF 91.36.35.1342.	1	
				FRIGG FIELD				


CDP 1 AS BUILT DRAWINGS

REFERENCE DRAWING LIST FOR:

[illegible][illegible]


					elf aquitaine norge a/s p.o.box 168 4001 Stavanger	 elf	Job no.	Installation CDP 1	System UNDERWATER
							Scale		
Rev.	Date	DESCRIPTION	by	app.	FRIGG FIELD	Dwgr. no. FF — — 1342	Hg.	Chg.	
Contractor								/	

WELDED ON
SUPPORT

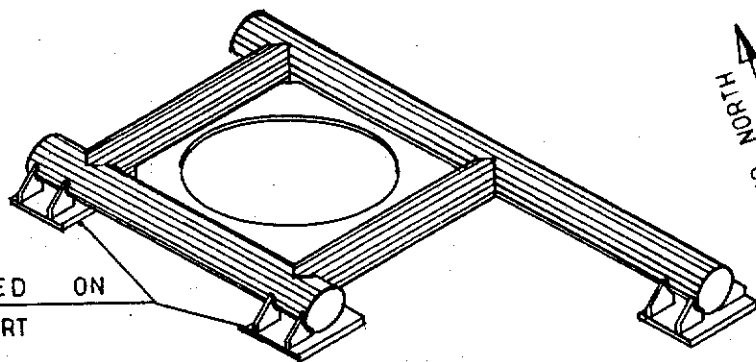


CONDUCTOR GUIDE N°22

GRID NORTH
19°37'
PLAT. NORTH

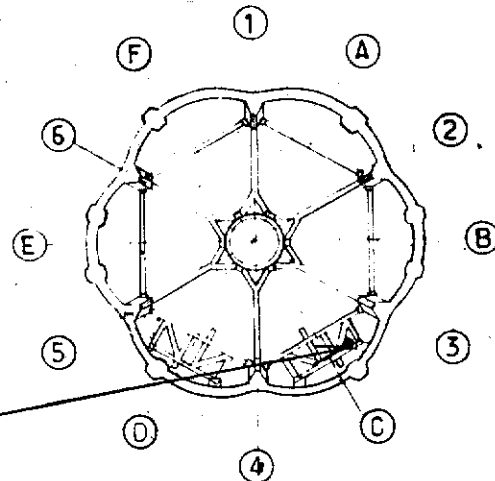


KEY PLAN

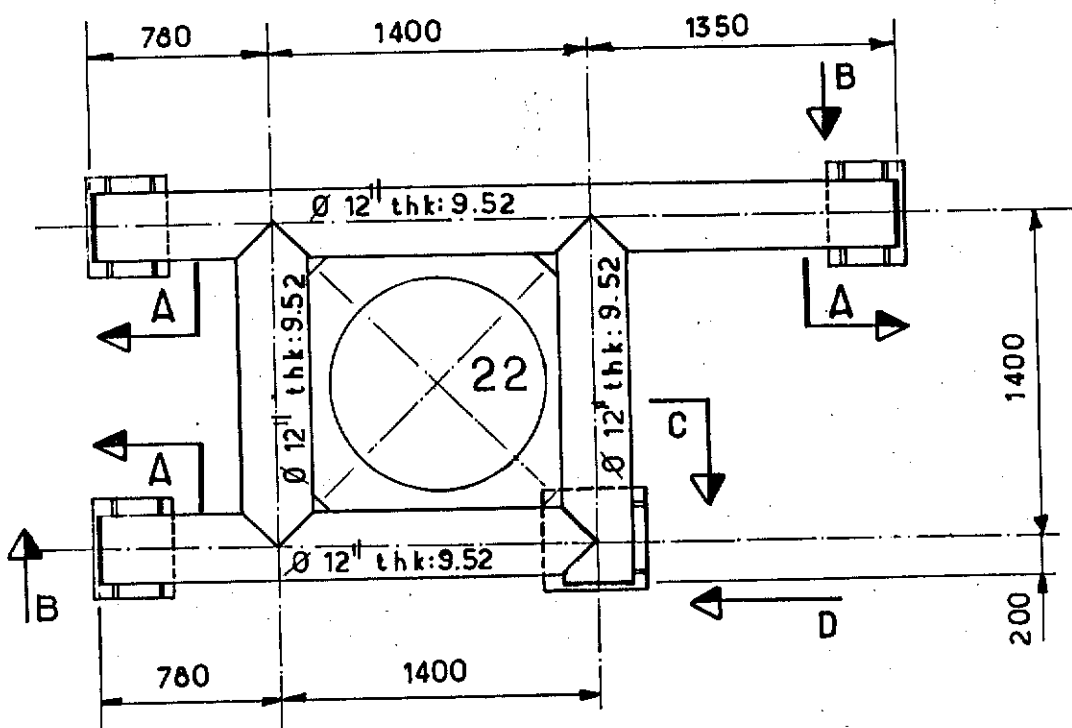


PLAN VIEW

SECTION C
Ø 12" thk 9.52

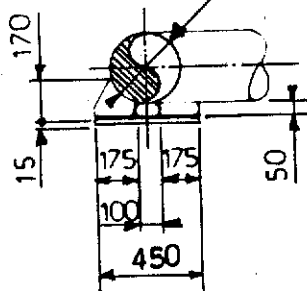


VIEW D

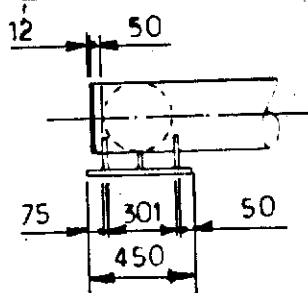

SECTION A

VIEW B

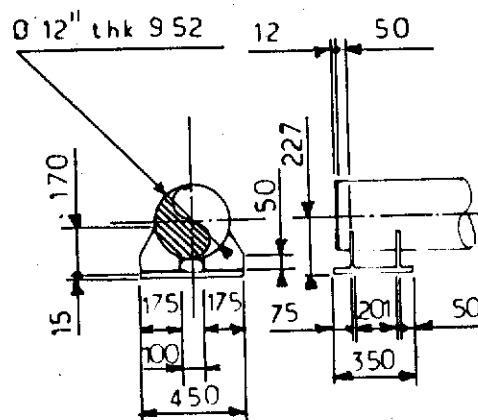

NOTES

FOR LOCATION SEE SK FF 91-36-35-1332.
FOR CONDUCTOR SLEEVE SEE SK FF-91-36-35-1491.

Rev.	Date	DESCRIPTION	by	app.
1	12.83	UP DATED	BVH	JLC

Contractor JVD 1029_40.13

elf
aquitaine
norge a/s
p.o. box 168
4001 Stavanger

elf
FRIGG FIELD

Job no.	Installation CDP 1	System UNDERWATER
Scale 1:33	CONDUCTOR GUIDE N°22 CELL C SECONDARY FRAME LEVEL G	
Dwgr. no. FF 91.36.35-1343	No. 1	Sheet


CDP 1 AS BUILT DRAWINGS

REFERENCE DRAWING LIST FOR:



[illegible]

						 elf	Job no.	Installation CDP 1	System UNDERWATER
							Scale		
Rev.	Date	DESCRIPTION	by	app.			Dwgr. no.		
Contractor					elf aquitaine norge a/s p.o.box 168 4001 Stavanger	FRIGG FIELD	FF — — 1343	1343	/

CONDUCTOR GUIDE N°23

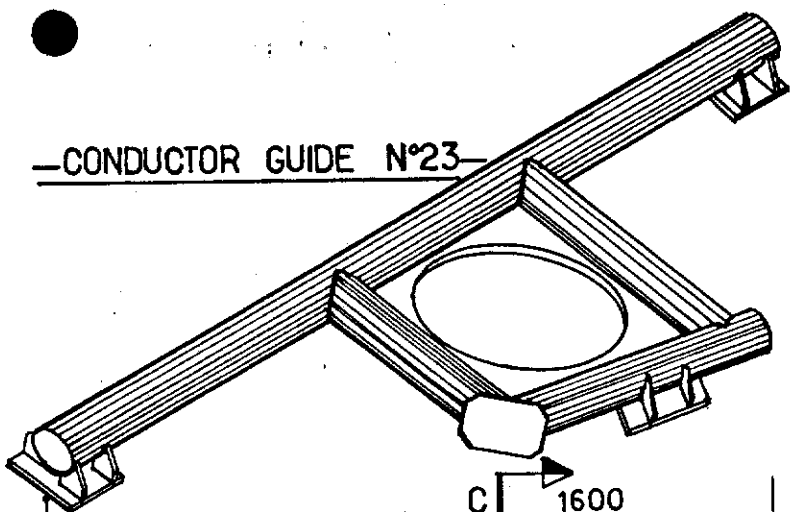

WELDED ON
SUPPORT

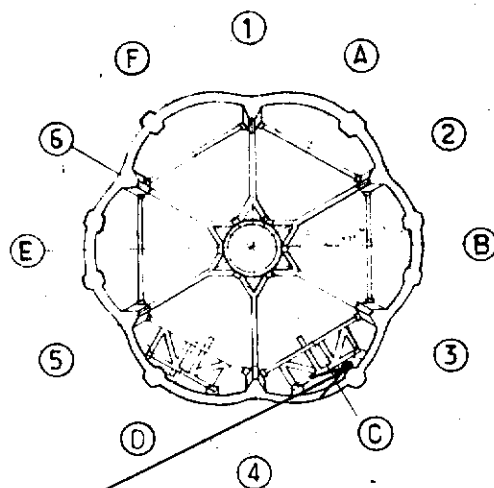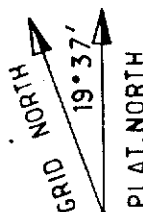


KEY PLAN


NOTES

FOR LOCATION SEE SK FF.91.36.35.1332
FOR CONDUCTOR SLEEVE SEE SK FF.91.36.35.1491


PLAN VIEW

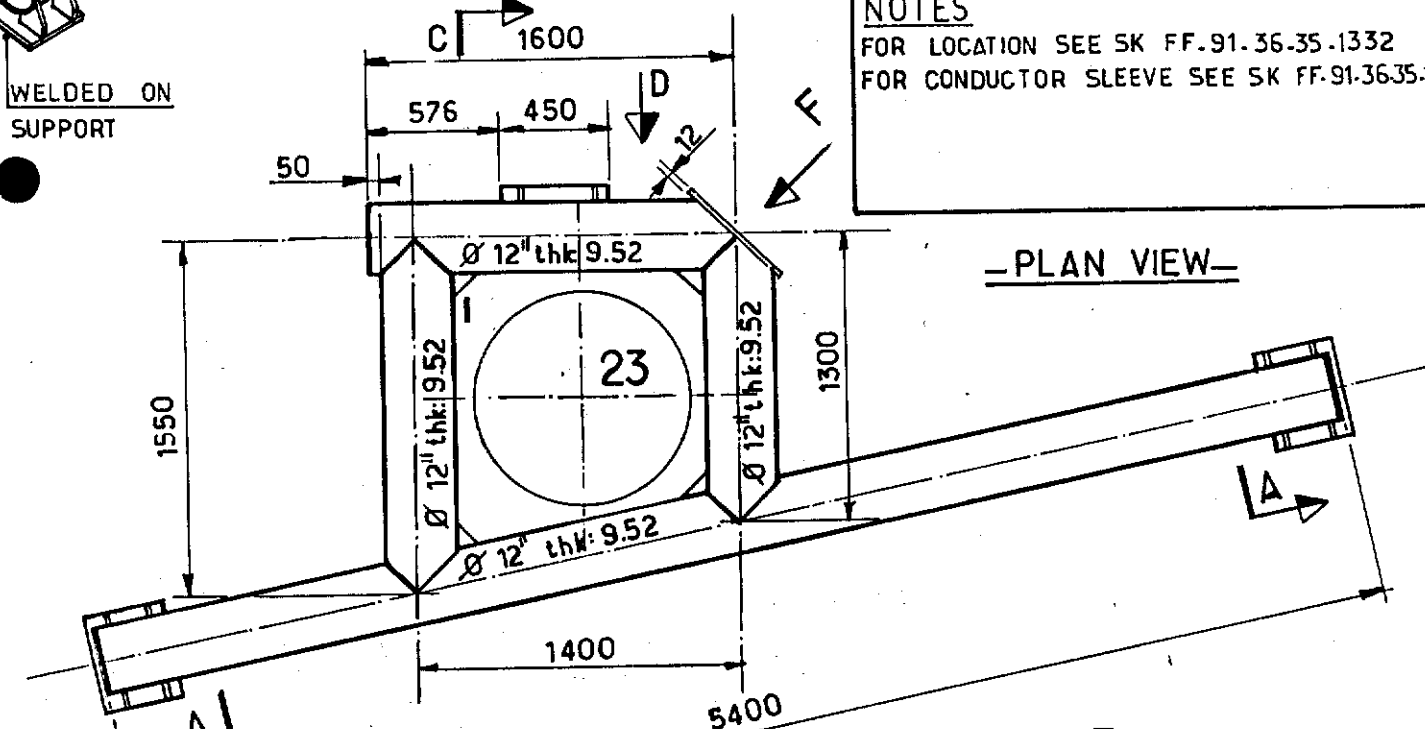


VIEW F

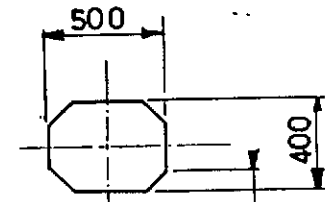


VIEW B

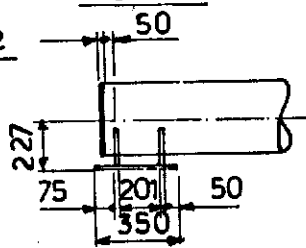


VIEW D

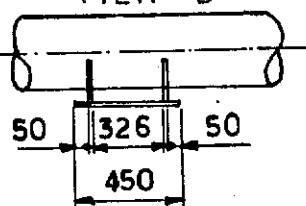


VIEW E

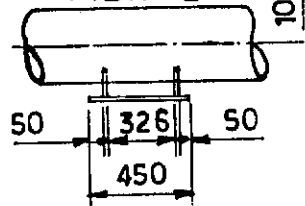

SECTION A

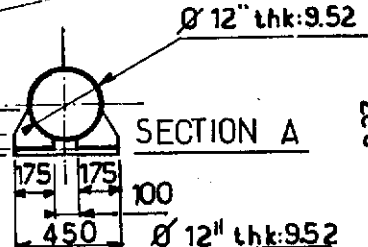

SECTION C

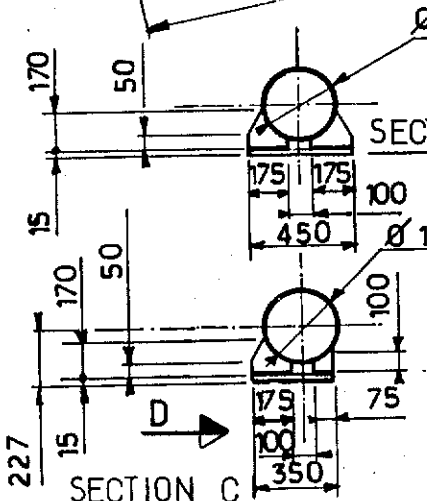


				elf aquitaine norge a/s		 elf	Job no.	Installation CDP 1	System UNDERWATER
1	1283	UP DATED	BVH	J.L.C.	p.o.box 168		Scale 1:33	CONDUCTOR GUIDE N°23 CELL C SECONDARY FRAME LEVEL C	
Rev.	Date	DESCRIPTION	by	app.			Dwgr. no.	FF 91_36_35.1344.	
Contractor JVD 1029_40.14					4001 Stavanger	FRIGG FIELD	1		

CDP 1 AS BUILT DRAWINGS



REFERENCE DRAWING LIST FOR:

				elf aquitaine norge a/s p.o.box 168 4001 Slanger		 elf		Job no.		Installation CDP 1		System UNDERWATER	
Rev.		Date		DESCRIPTION		by		app.		Scale			
Contractor						4001 Slanger		Dwgr. no. FF		1344		Hes	


WELDED ON
SUPPORT

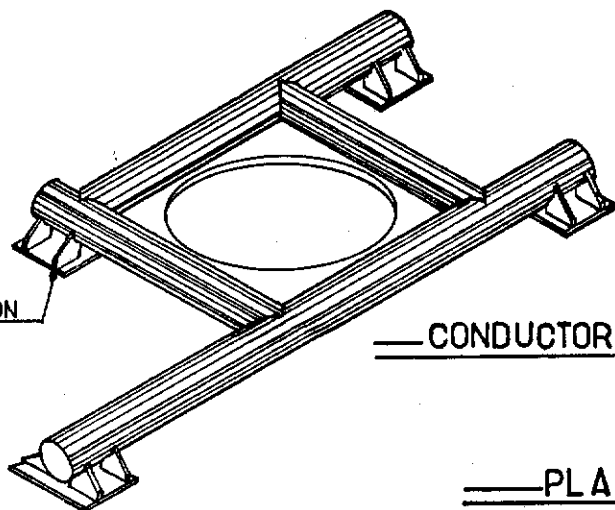

CONDUCTOR GUIDE N°24

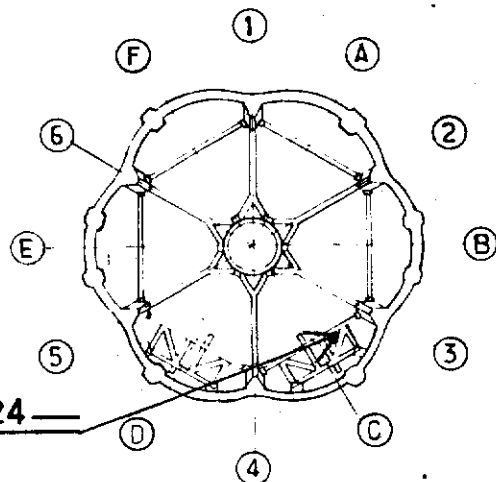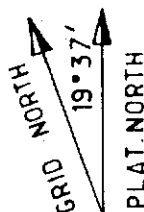


KEY PLAN

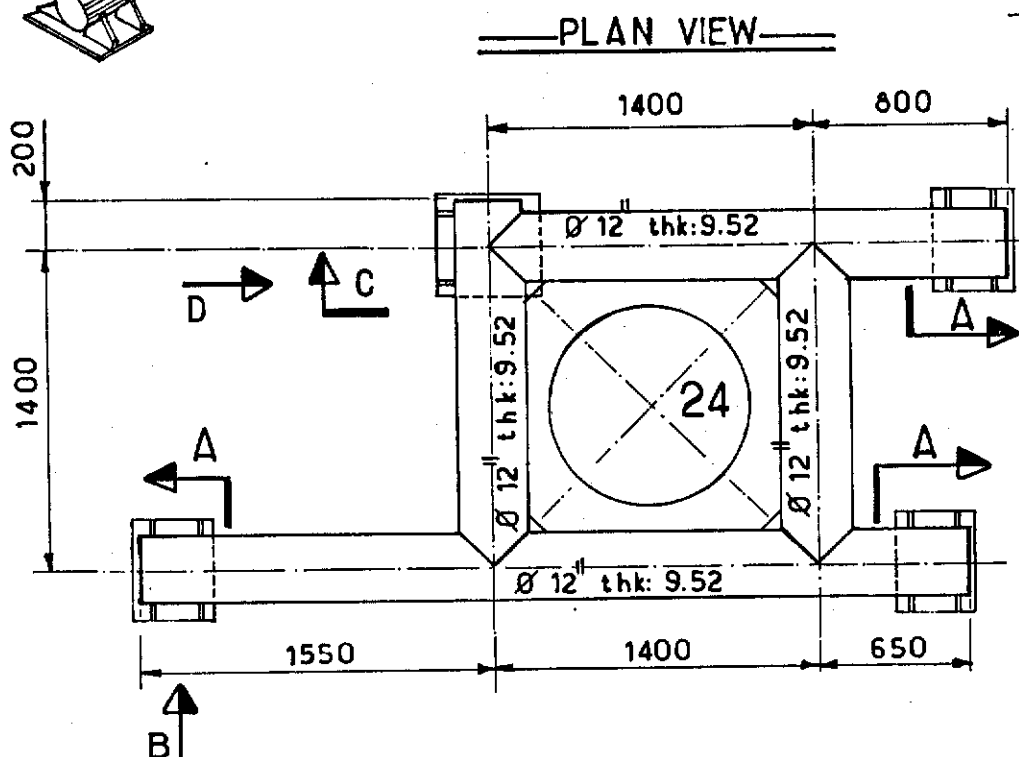


SECTION A

Ø 12" thk: 9.52

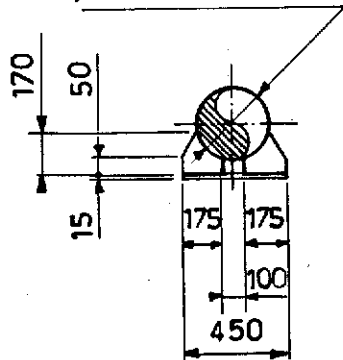


VIEW B

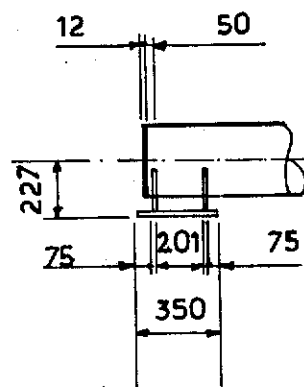


SECTION C

Ø 12" thk: 9.52

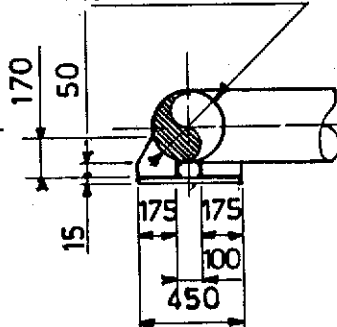

VIEW D

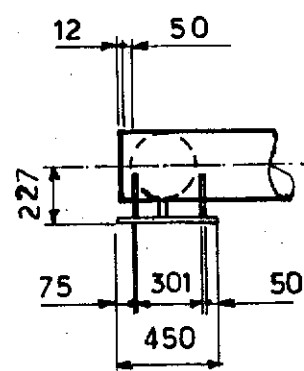

NOTES

FOR LOCATION SEE SK FF 91_36_35_1332.


FOR CONDUCTOR SLEEVE SEE SK FF 91_36_35_1491.

				elf aquitaine norge a/s p.o.box 168 4001 Stavanger	 elf	Job no.	Installation CDP 1	System UNDERWATER		
1	12.83	UP DATED	BV.H J/c			Scale 1:33	CONDUCTOR GUIDE N°24 CELL C SECONDARY FRAME LEVEL G			
Rev.	Date	DESCRIPTION	by	app.		Dwgr. no.	FF 91_36_35_1345.		Rev. 1	Sheet /
Contractor JVD 1029_40.15					FRIGG FIELD					


CDP 1 AS BUILT DRAWINGS

REFERENCE DRAWING LIST FOR:

[illegible]

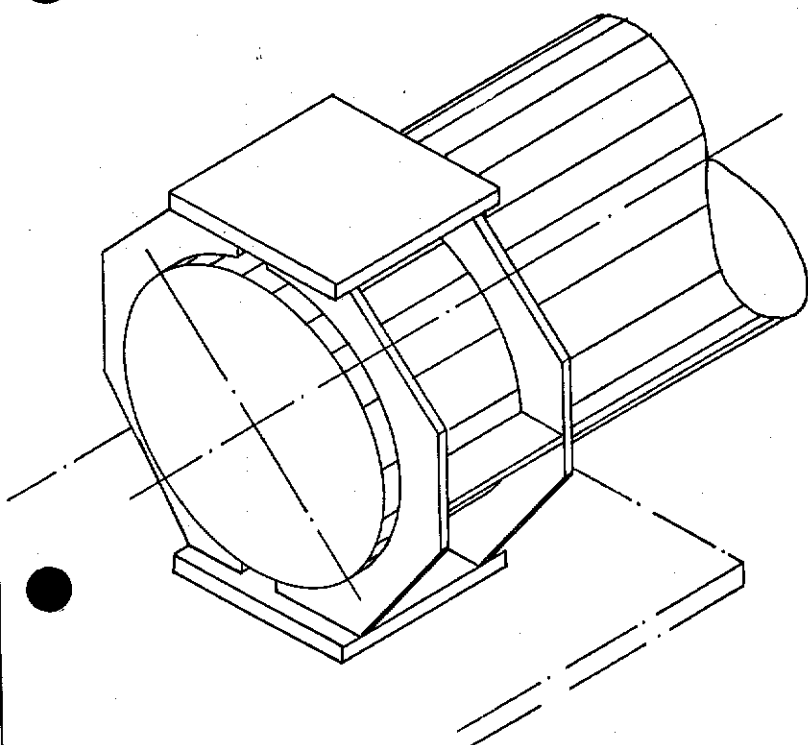


GRID NORTH
19°37'
PLAT. NORTH

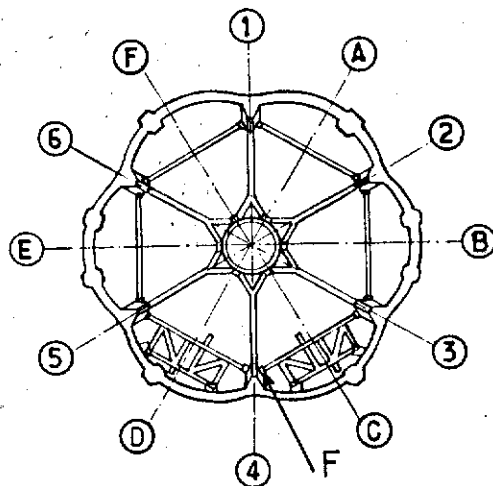


KEY PLAN

VIEW F

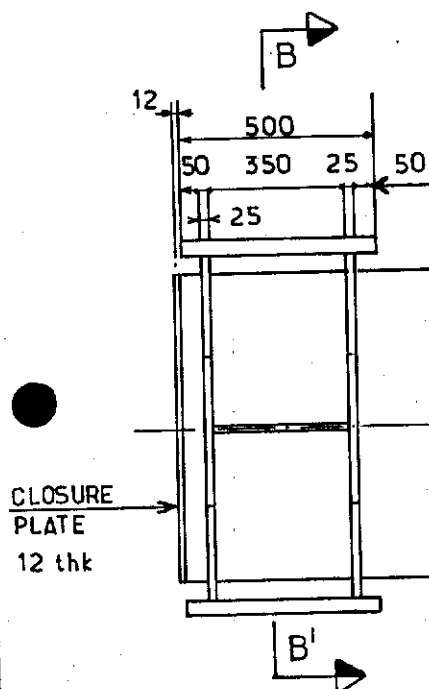

SECTION B B'

Ø 32" DIA. x 1" W.T.

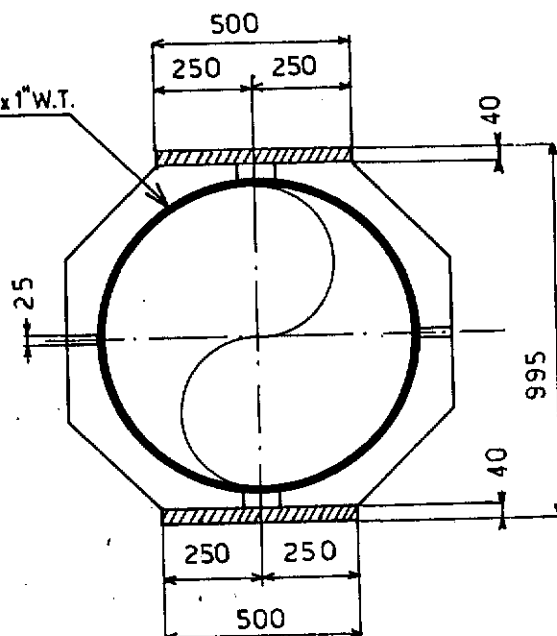

NOTES

FOR LOCATION SEE SK FF. 91.36.35.1332.
FOR BOX FOR FREE LOCK SEE SK FF. 91.36.35.1348.


				elf aquitaine norge a/s		elf		Job no.	Installation CDP 1	System UNDERWATER
1	12.83	UP DATED	BVH	1/12	p.o.box 168			Scale 1:20	FREE LOCK PIPE END CELL C	GC1 LEVEL G
Rev.	Date	DESCRIPTION	by	app.	Contractor	JVD 1029-40-16	4001 Stavanger	Dwgr. no.	FF 91.36.35.1346	Rev 1
				FRIGG FIELD						Sheet 1

CDP 1 AS BUILT DRAWINGS


REFERENCE DRAWING LIST FOR:

[illegible]

							Job no.	Installation CDP 1	System UNDERWATER			
							Scale					
Rev.	Date	DESCRIPTION	by	app.			Dwgr. no.				Rev.	Sheet
Contractor						elf aquitaine norge a/s p.o.box 168 4001 Stavanger	FRIGG FIELD FF — — 1346					/

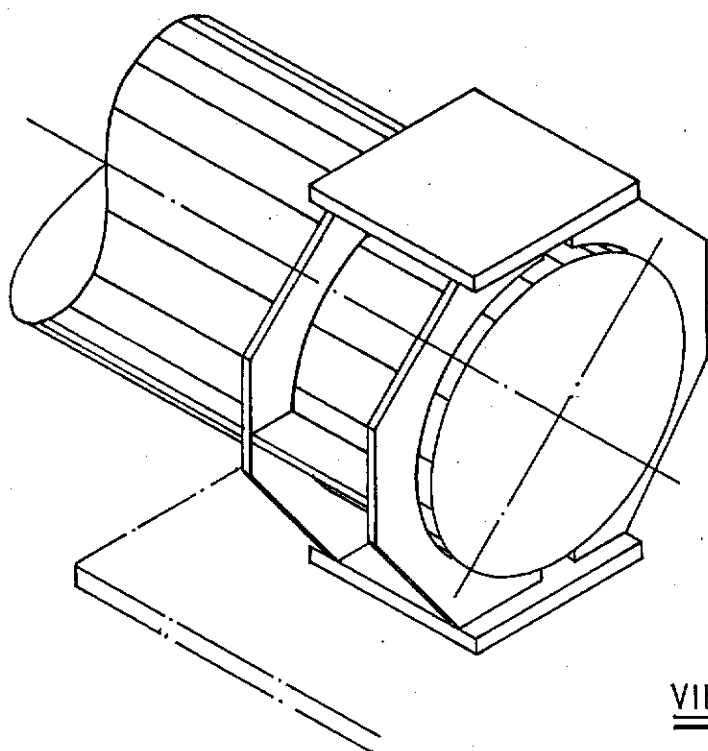



HILTON
GRID
19° 37'
PLAT. NORTH

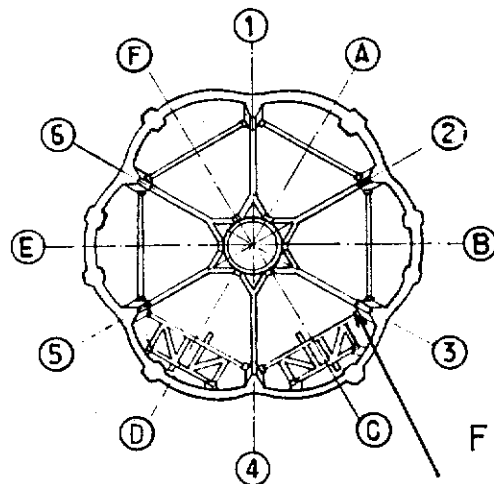

KEY PLAN

VIEW F

SECTION AA'

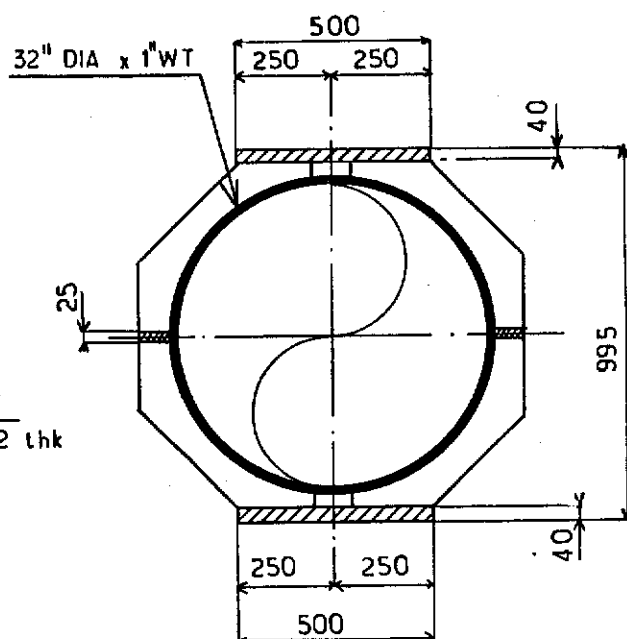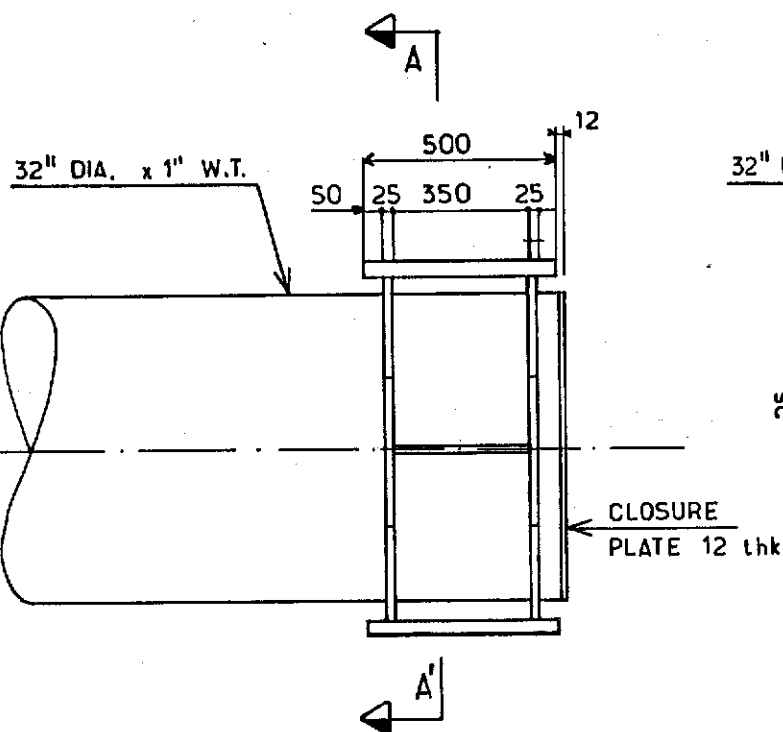

NOTES

FOR LOCATION SEE SK FF. 91.36.35.1332

FOR BOX FOR FREE LOCK SEE SK FF. 91.36.35.1349

						 elf	Job no.	Installation CDP 1	System UNDERWATER	
1.	12.83	UP DATED	BVH	JLC			Scale 1:20	FREE LOCK PIPE END CELL C	GC4 LEVEL G	
Rev.	Date	DESCRIPTION	by	app.	p.o.box 168		Dwgr.no.		Rev	Sheet
Contractor JVD 1029.40.17.					4001 Stavanger		FRIGG FIELD	FF 91.36.35.1347	1	/


CDP 1 AS BUILT DRAWINGS

REFERENCE DRAWING LIST FOR:


[illegible][illegible]

				elf aquitaine norge a/s		 elf	Job no.	Installation CDP 1	System UNDERWATER		
				p.o.box 188			Scale				
Rev.	Date	DESCRIPTION	by	app.	4001 Stavanger		Dwgr. no.	FF 1347		Rev	Sheet
Contractor					FRIGG FIELD						


GRID NORTH
19°37'
PLAT. NORTH

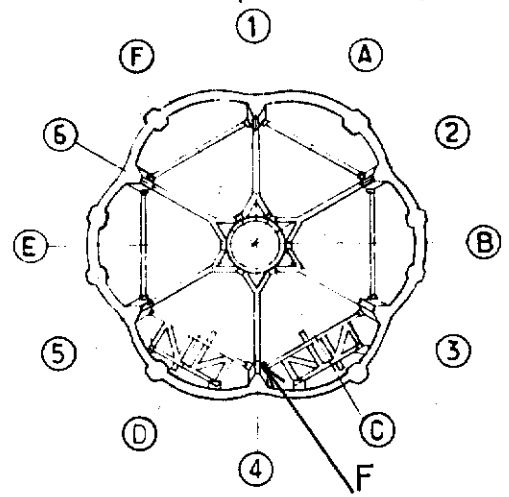


KEY PLAN

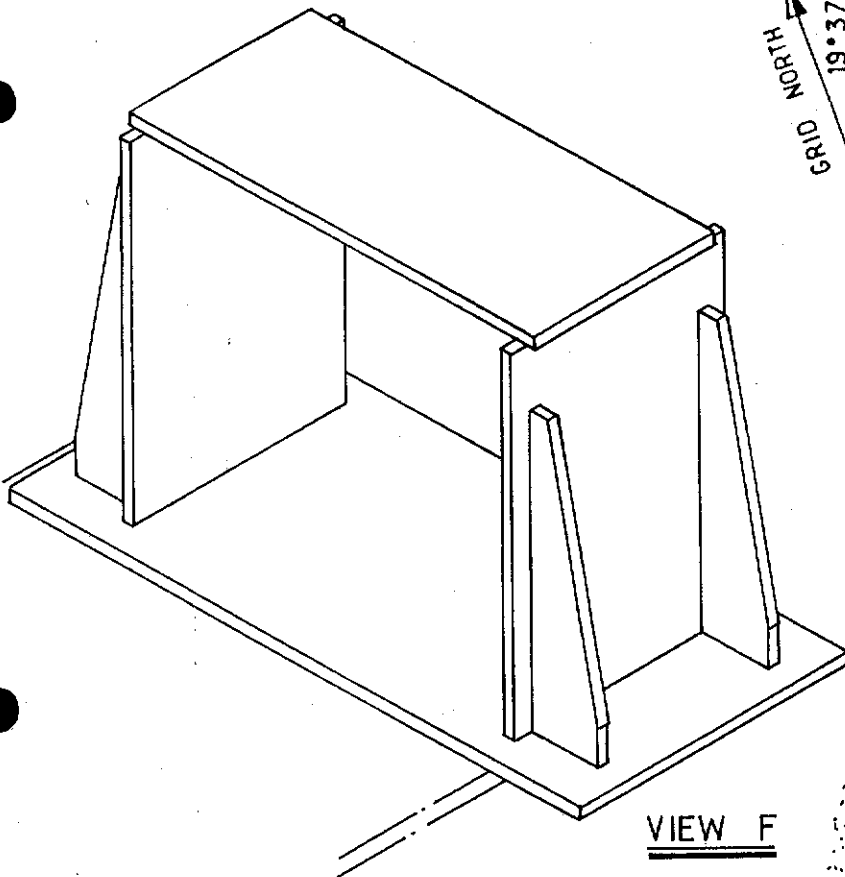

VIEW F

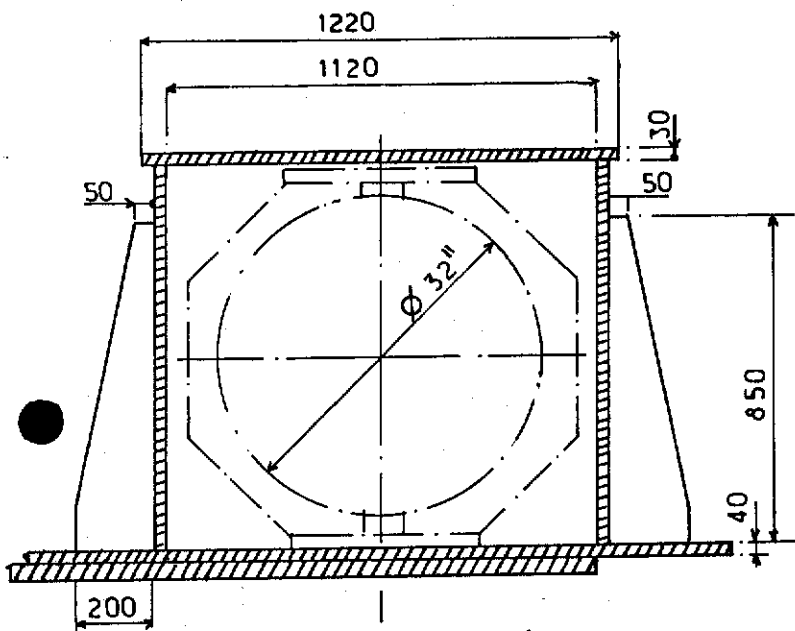

SECTION AA'

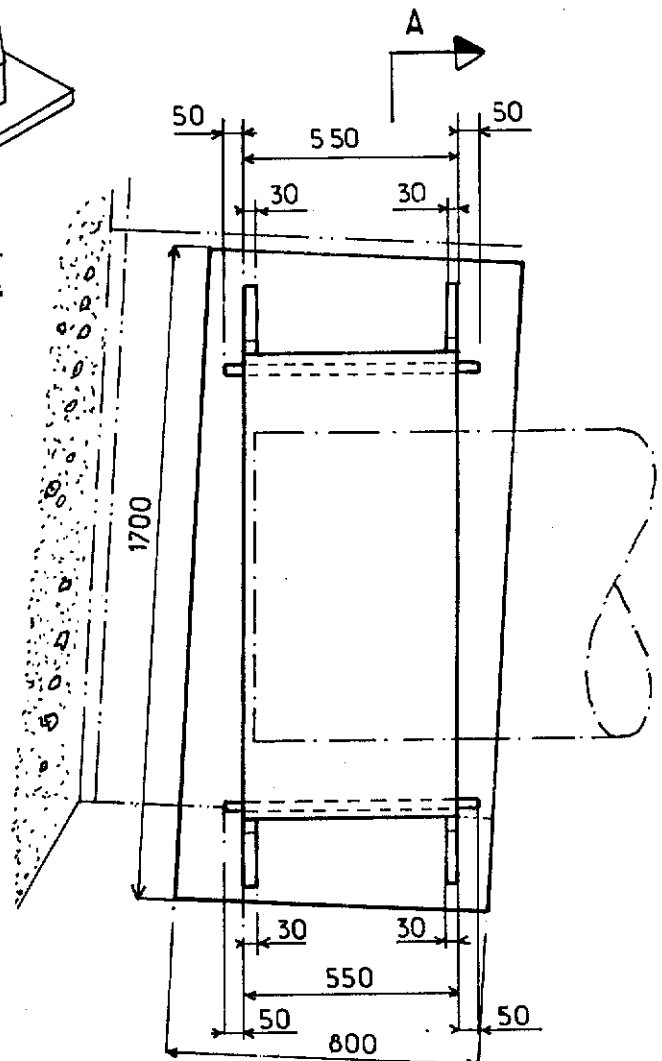

NOTES

FOR LOCATION SEE SK FF_91_36_35_1332.

FOR DETAIL OF FREE LOCK PIPE END SEE SK FF_91_36_35_1346.


				elf aquitaine norge a/s		Job no.		Installation CDP 1		System UNDERWATER	
1	12.83	UP DATED	BYH JLC	p.o. box 168		Scale 1:20		BOX FOR FREE LOCK		GC1	
Rev.	Date	DESCRIPTION	by	app.		Dwgr. no.		CELL C		LEVEL G	
Contractor JVD 1029.40.18.				4001 Stavanger		FRIGG FIELD		FF 91-36-35-1348.		1	

CDP 1 AS BUILT DRAWINGS


REFERENCE DRAWING LIST FOR:

[illegible]

						elf aquitaine norge a/s p.o.box 168 4001 Stavanger	 elf	Job no.	Installation CDP 1	System UNDERWATER
								Scale	BOXE FOR FREE LOCK GC1	
Rev.	Date	DESCRIPTION	by	app.				Dwgr. no.	FF ——— 1348	Rev.
Contractor						FRIGG FIELD				

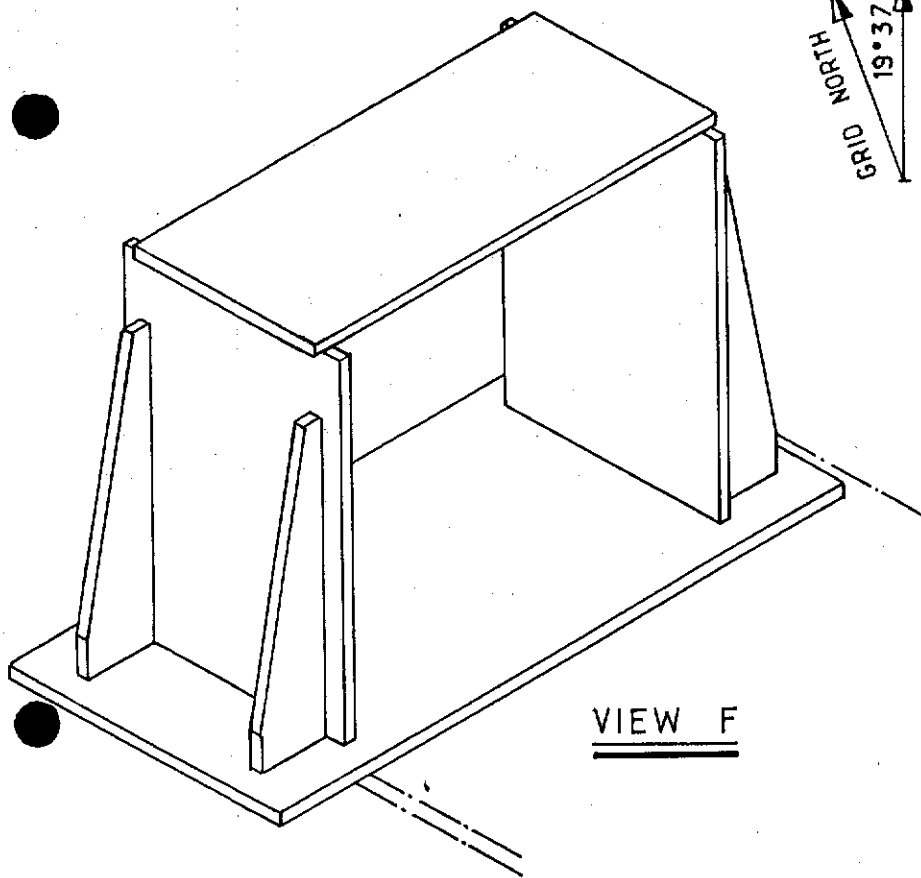


GRID NORTH
19° 37'
PLAT. NORTH

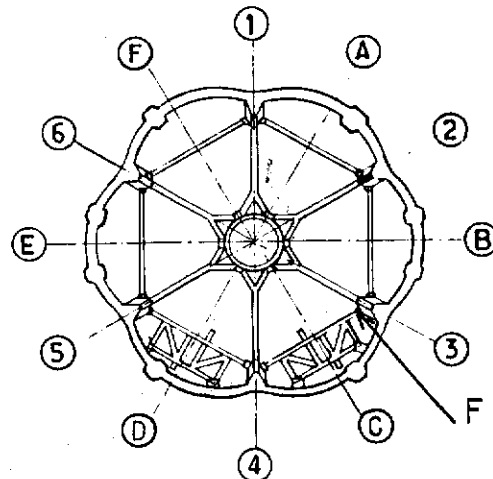


KEY PLAN

VIEW F

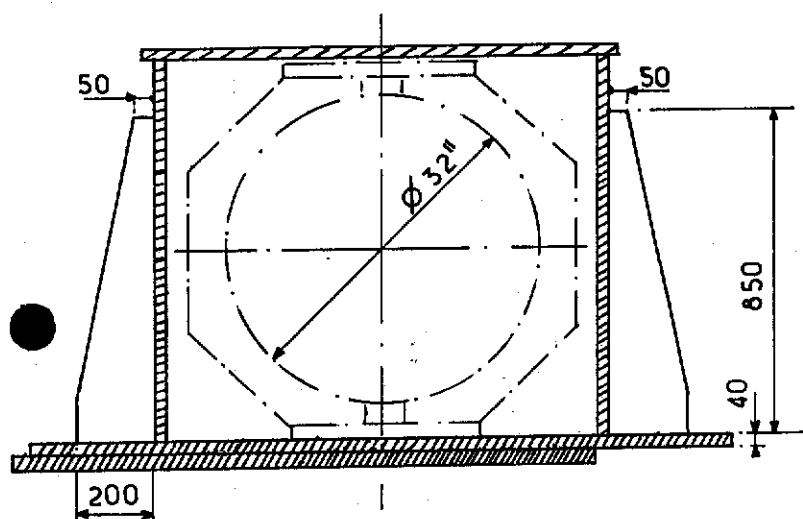

SECTION AA'

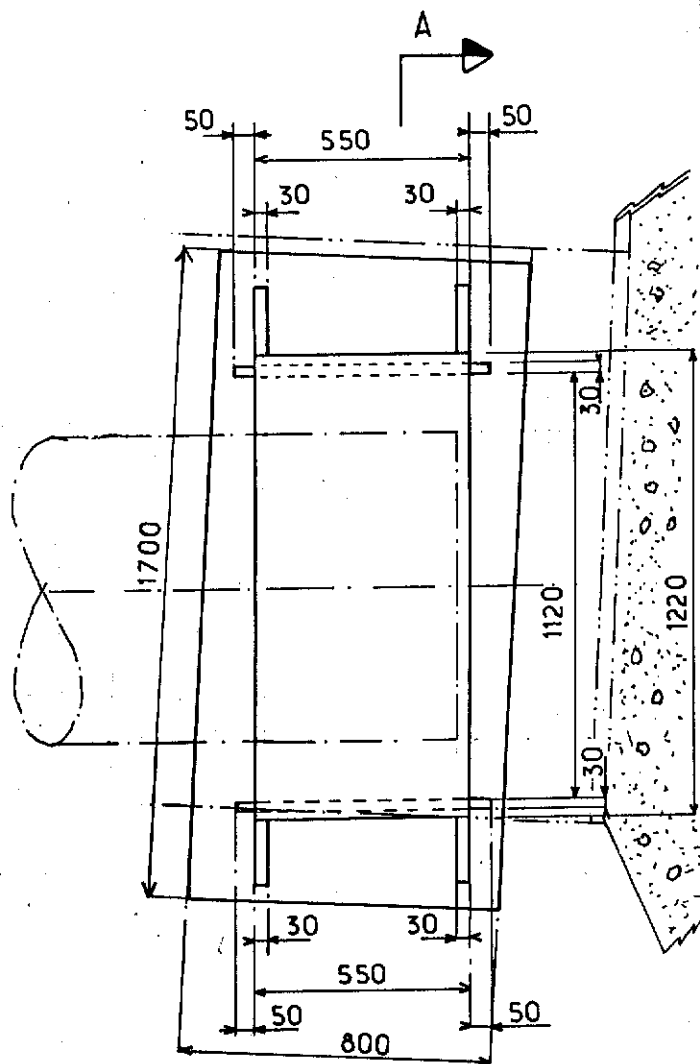

NOTES

FOR LOCATION SEE SK FF_91.36.35.1332.

FOR DETAIL OF FREE LOCK PIPE END SEE SK FF_91.36.35.1347.

Rev.	Date	DESCRIPTION	by	app.
1	12.83	UP DATED	BVH	JLC
Contractor JVD 1029_40_19.				

elf
aquitaine
norge a/s
p.o.box 168
4001 Stavanger



FRIGG FIELD



Job no.	Installation	System
	CDP 1	UNDERWATER
Scale	BOX FOR FREE LOCK G C4 CELL C LEVEL G	
1:20		
Dwgr. no.	Rev	Sheet
FF 91.36.35.1349	1	

CDP 1 AS BUILT DRAWINGS

REFERENCE DRAWING LIST FOR:

[illegible]

					elf aquitaine norge a/s p.o.box 168 4001 Stavanger	 elf	Job no.	Installation CDP 1	System UNDERWATER		
							Scale	BOXE FOR FREE Lock GC4			
Rev.	Date	DESCRIPTION	by	app.			Dwgr. no.	FF — — 1349		Rev.	Sheet /
Contractor					FRIGG FIELD						

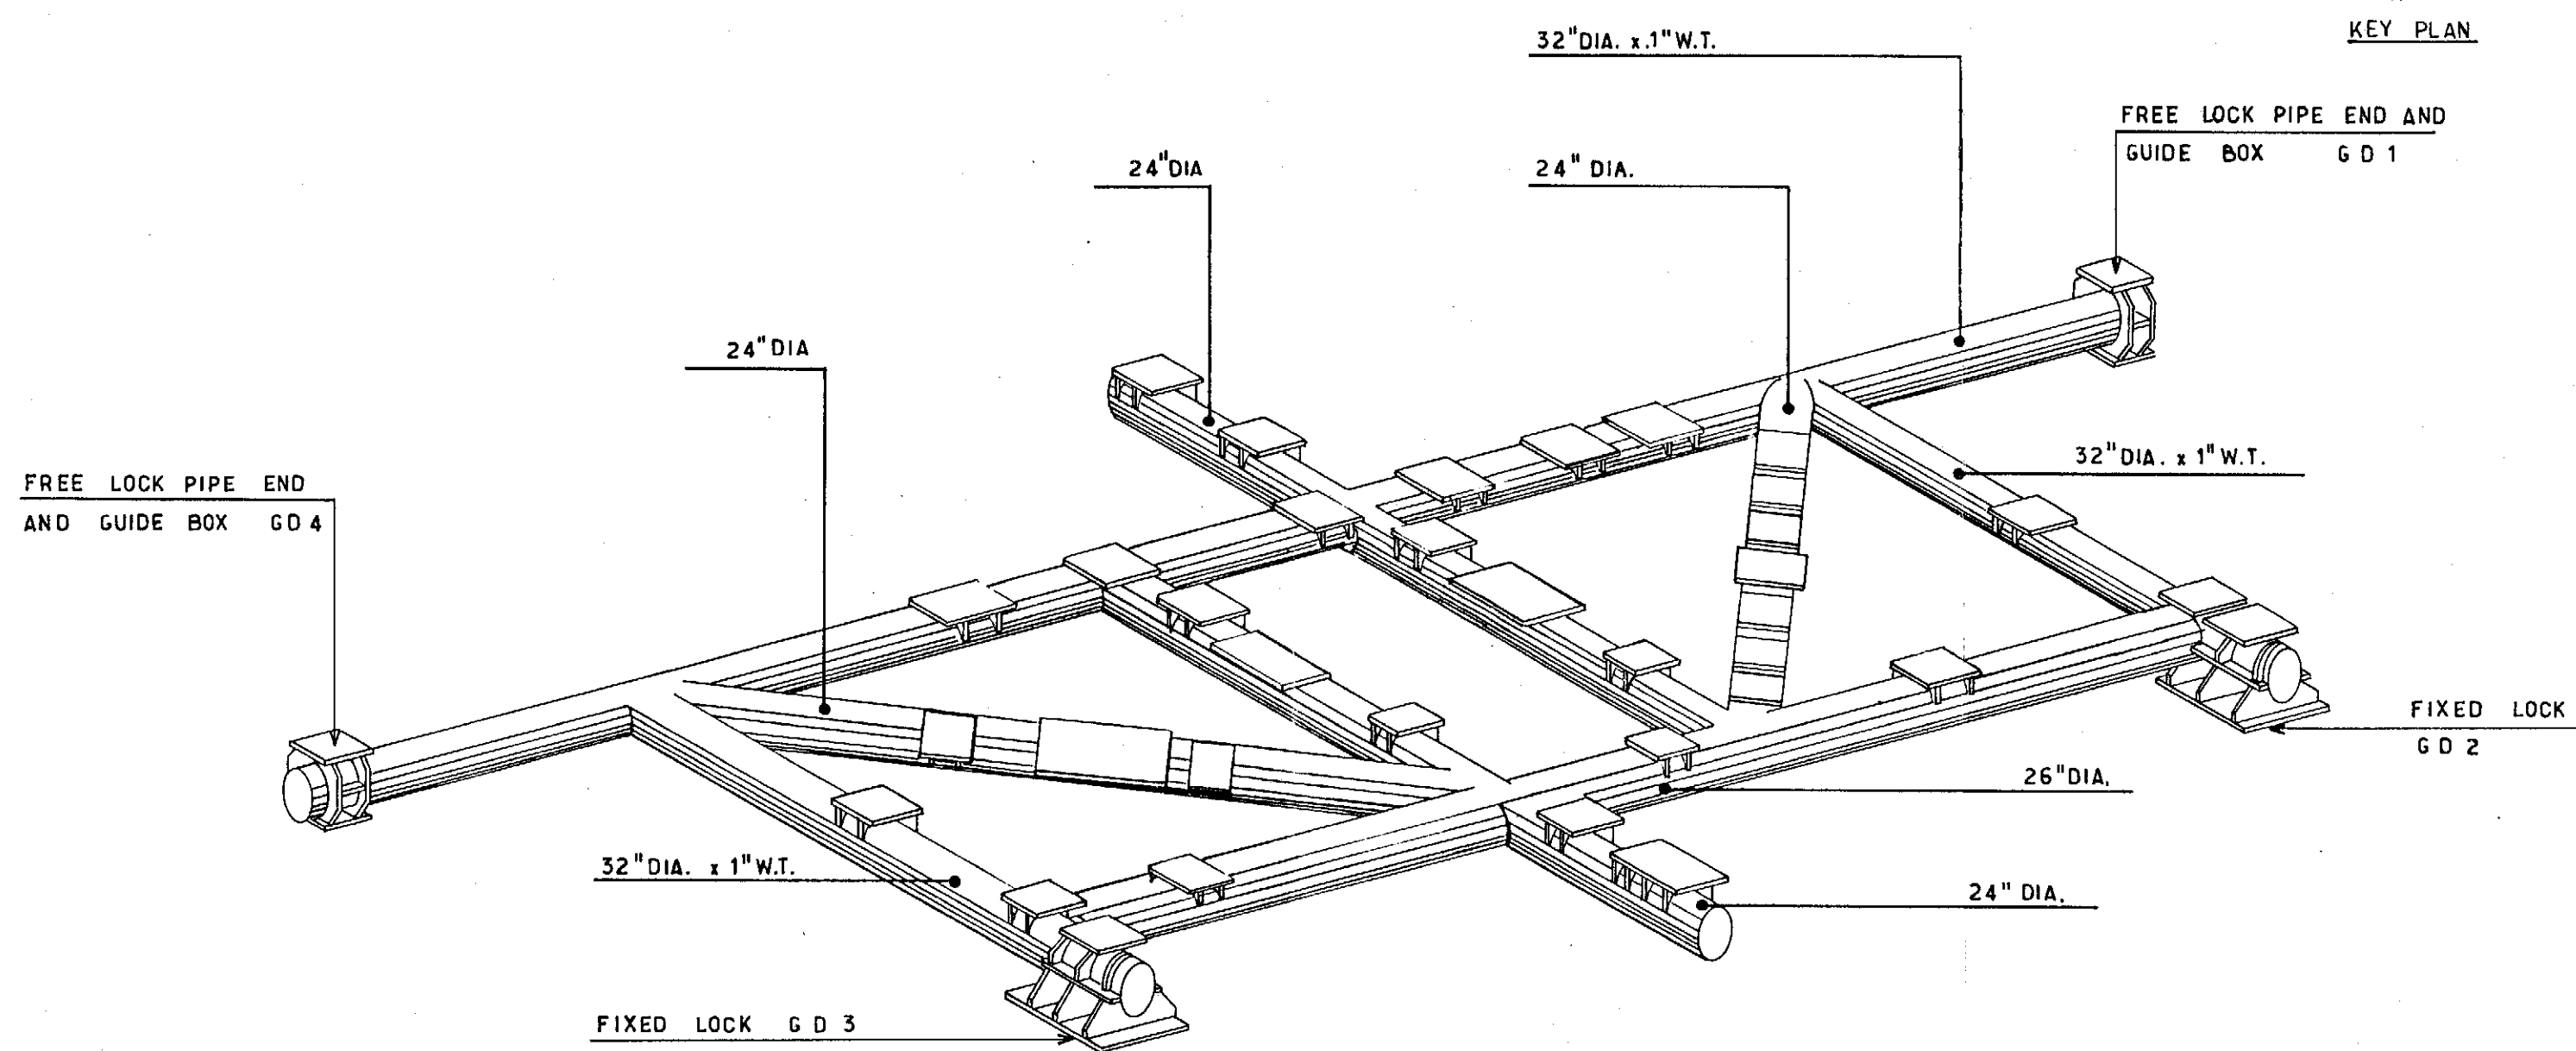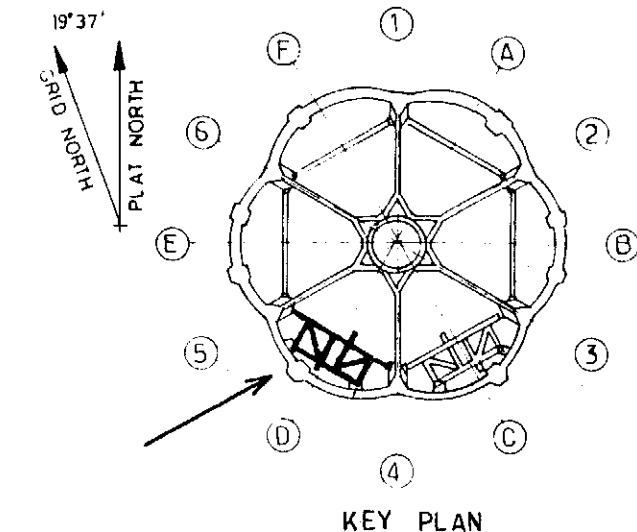

NOTES

FOR SECONDARY FRAME DETAILS SEE SK FF 91-36-35-1357 TO FF 91-36-35-1368.
 FOR FREE LOCK PIPE ENDS AND GUIDE BOXES SEE SK FF 91 36 35 1369 / 1370 / 1371 / 1372.

elf aquitaine norge a/s p.o. box 168 4001 Stavanger				Job no. Installation CDP 1		System UNDERWATER	
1 12.83 UP DATED BY H/LC				Scale GENERAL VIEW OF SECONDARY FRAME SUPPORT CELL D LEVEL G		Dwgr. no. FF 91-36-35-1356	
Rev. Date DESCRIPTION by app.				Contractor JVD 1029 40 26		FRIGG FIELD 1	



CDP 1 AS BUILT DRAWINGS

REFERENCE DRAWING LIST FOR: CONDUCTOR GUIDE FRAME

[illegible]

					 elf	Job no.	Installation CDP 1		System UNDERWATER	
						Scale				
Rev.	Date	DESCRIPTION	by	app.	p.o.box 168	Dwgr. no. FF — — <u>1355</u>	Rev.	Sheet /		
Contractor					4001 Stavanger					

GRID NORTH
19° 37'
PLAT. NORTH

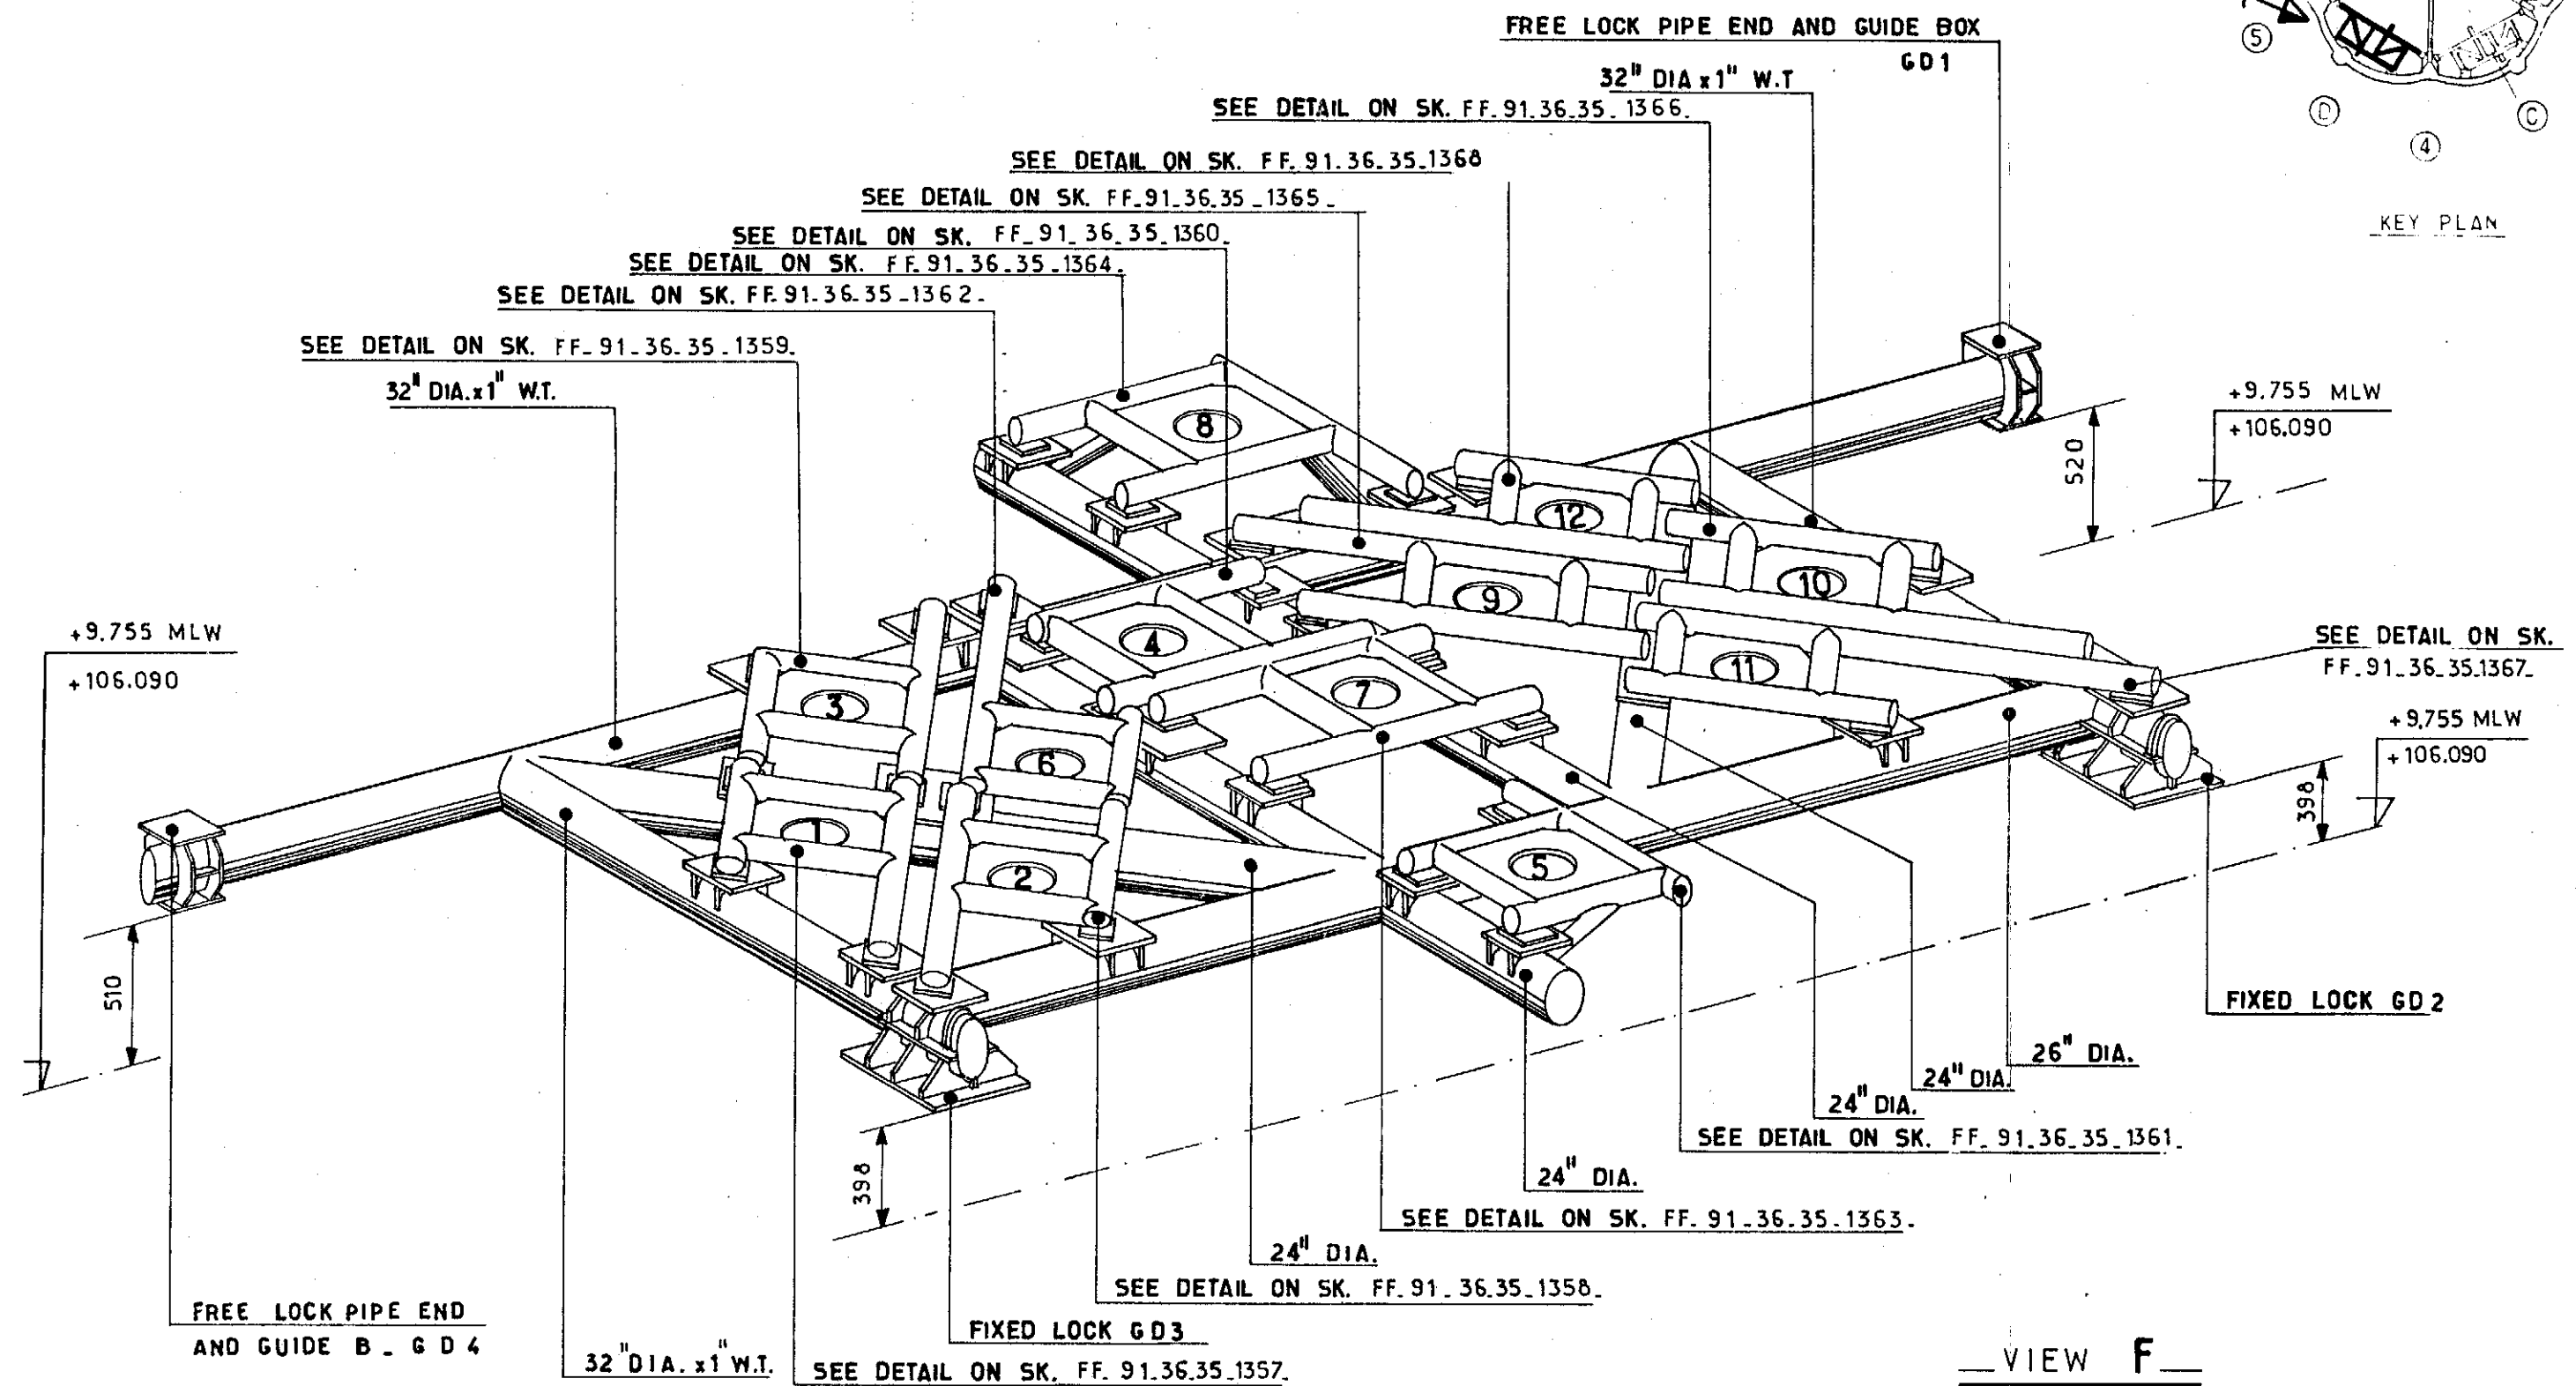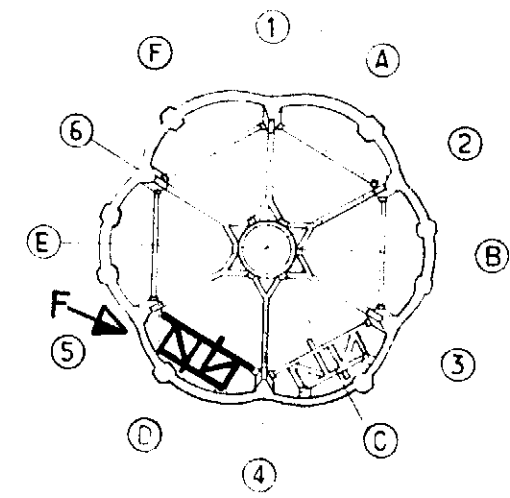

NOTES

FOR FREE LOCK PIPE ENDS AND GUIDE BOXES SEE SK FF 91-36-35-1369/1370 / 1371 / 1372.






					elf aquitaine norge a/s p.o.box 168 4001 Stavanger	 elf	Job no.	Installation CDP 1	System UNDERWATER
1	12.83	UP DATED	BYH	/LC			Scale 	GENERAL VIEW OF CONDUCTOR GUIDE FRAME CELL D LEVEL C	
Rev.		Date	DESCRIPTION	by	app.		Dwgr. no	FF 91.36.35.1355.	1
Contractor JVD_1029_40.25.						FRIGG FIELD			

CDP 1 AS BUILT DRAWINGS

REFERENCE DRAWING LIST FOR:

[illegible]

							Job no.	Installation	System
								CDP 1	UNDERWATER
							Scale		
Rev.	Date	DESCRIPTION	by	app.			Dwgr. no.		Rev.
Contractor							FF	1356	Sheet

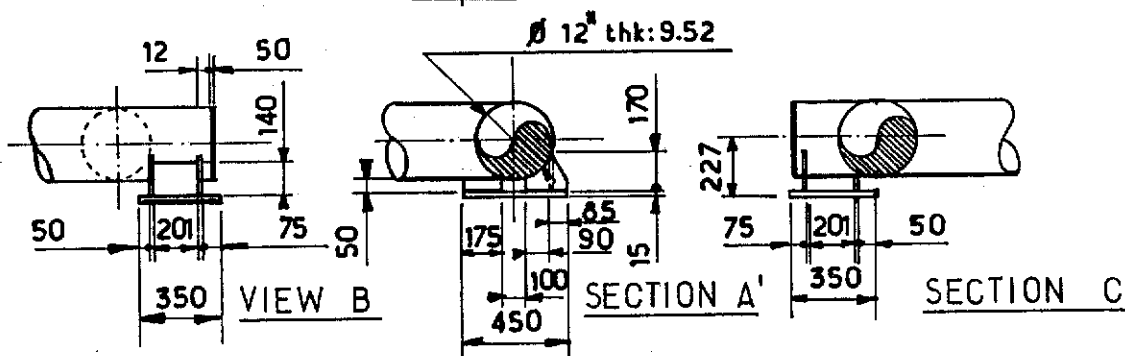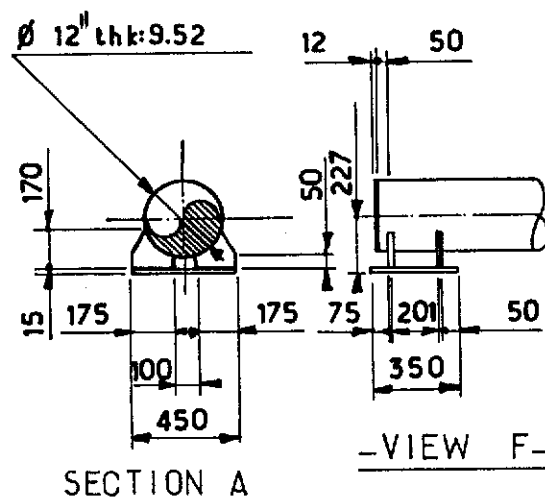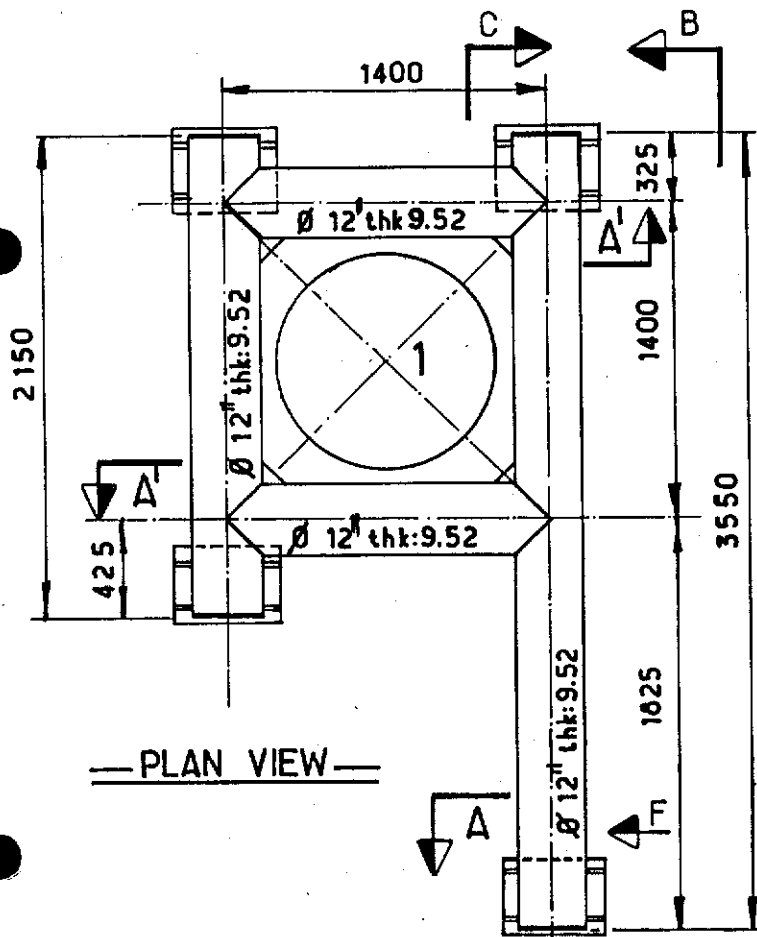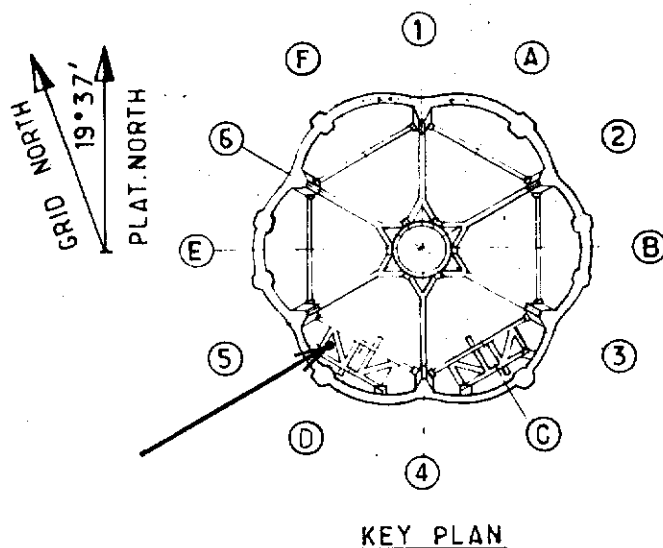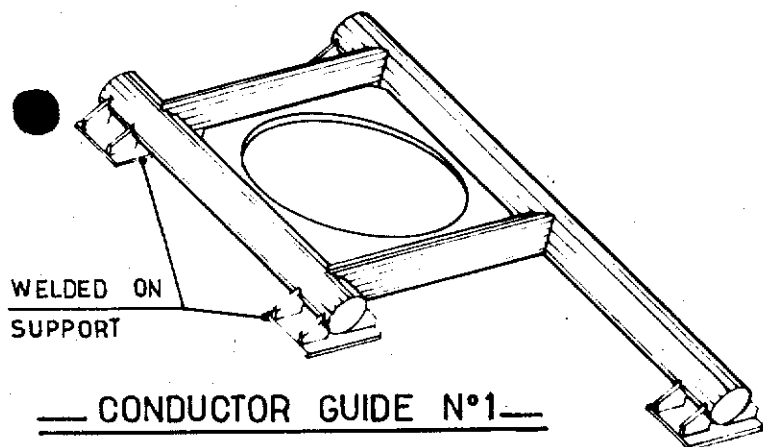

NOTES:

FOR LOCATION SEE SK FF. 91.36.35.1355.
FOR CONDUCTOR SLEEVE SEE SK FF. 91.36.35.1491.


					elf aquitaine norge a/s p.o.box 168 4001 Stavanger							Job no.		Installation CDP 1		System UNDERWATER	
1	12.83	UP DATED	BY	J.LC						Scale 1:33		CONDUCTOR GUIDE N°1 CELL D SECONDARY FRAME LEVEL G					
Rev.	Date	DESCRIPTION	by	app.						Dwgr. no.		FF 91.36.35.1357.			Rev.	1	Sheet
Contractor JVD 1029_40.27.					4001 Stavanger					FRIGG FIELD							

CDP 1 AS BUILT DRAWINGS

REFERENCE DRAWING LIST FOR:



[illegible]

						elf aquitaine norge a/s p.o.box 168 4001 Stavanger	 elf	Job no.	Installation CDP 1	System UNDERWATER	
								Scale			
Rev.	Date	DESCRIPTION	by	app.			Dwgr. no.	FF ——— 1357		Rev.	Sheet /
Contractor											

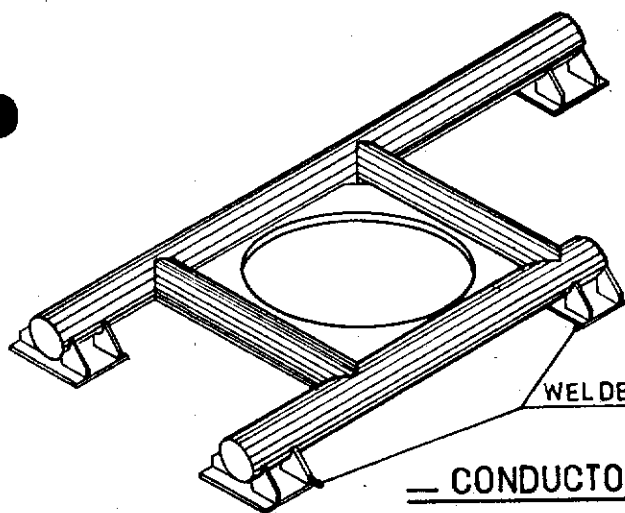


WELDED ON SUPPORT


— CONDUCTOR GUIDE N°2 —

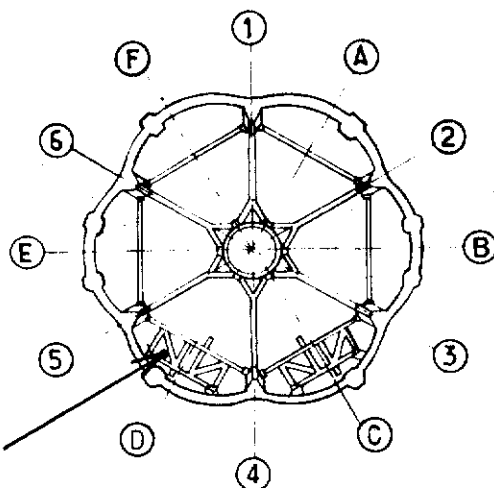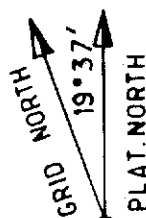


KEY PLAN

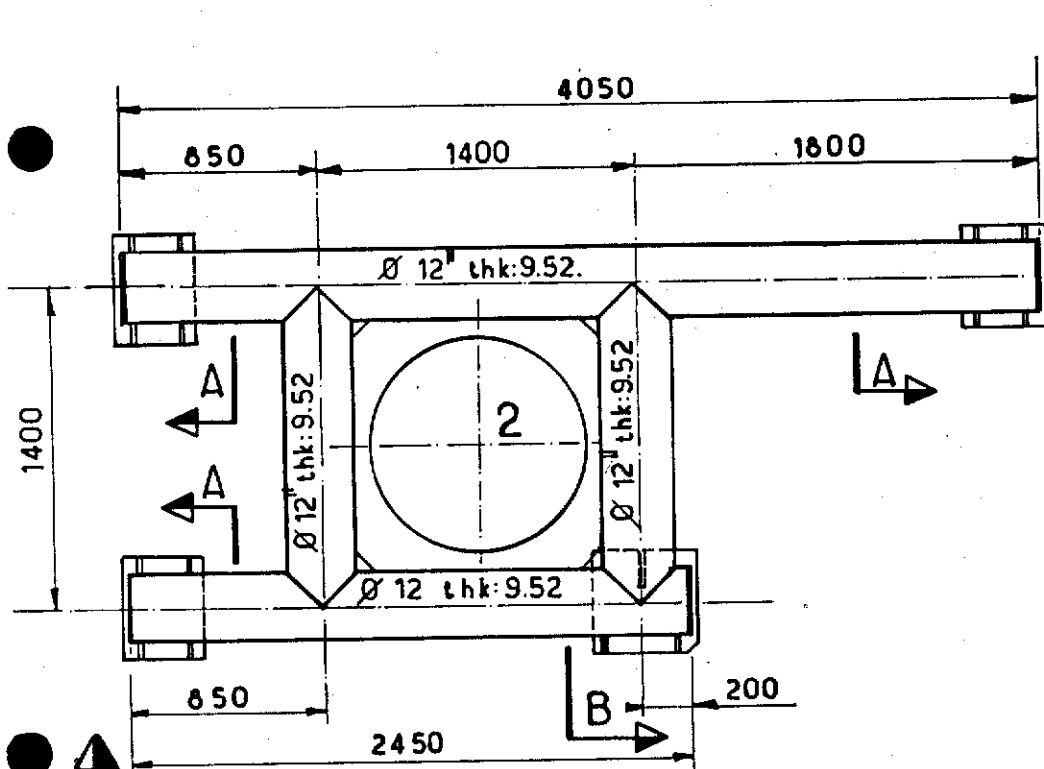

— PLAN VIEW —

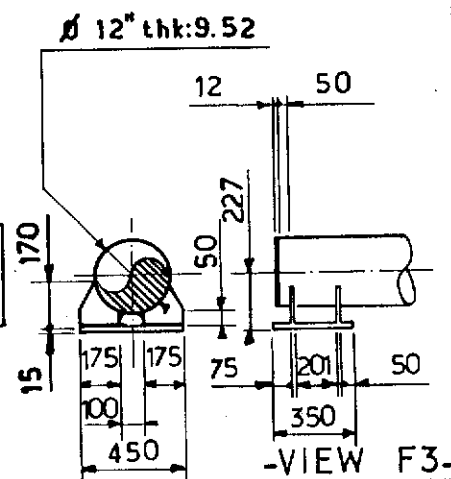

— SECTION A —

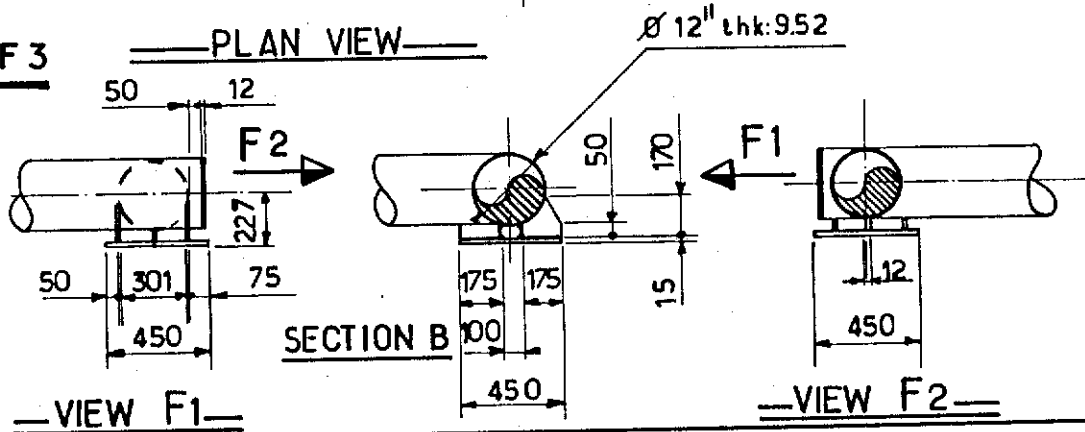

— VIEW F1 —

— VIEW F2 —

NOTES

FOR LOCATION SEE SK FF.91.36.35.1355.
FOR CONDUCTOR SLEEVE SEE SK FF.91.36.35.1491.




				elf aquitaine norge a/s		Job no.	Installation CDP 1	System UNDERWATER
1	12.83	UP DATED	BVH	JLC		Scale 1:33	CONDUCTOR GUIDE N°2 CELL D	
Rev.	Date	DESCRIPTION	by	app.		Dwgr. no.	SECONDARY FRAME	LEVEL 6
Contractor JVD 1029_40.28				4001 Stavanger		FF 91.36.35.1358.		
				FRIGG FIELD			Rev 1	Sheet 1

CDP 1 AS BUILT DRAWINGS


●REFERENCE DRAWING LIST FOR:

[illegible]


					elf aquitaine norge a/s p.o.box 168 4001 Stavanger	 elf	Job no.	Installation CDP 1	System UNDERWATER	
							Scale			
Rev.	Date	DESCRIPTION	by	app.	FRIGG FIELD	Dwgr. no. FF <u> </u> <u> </u> 1358	Rev	Sheet 		
Contractor										

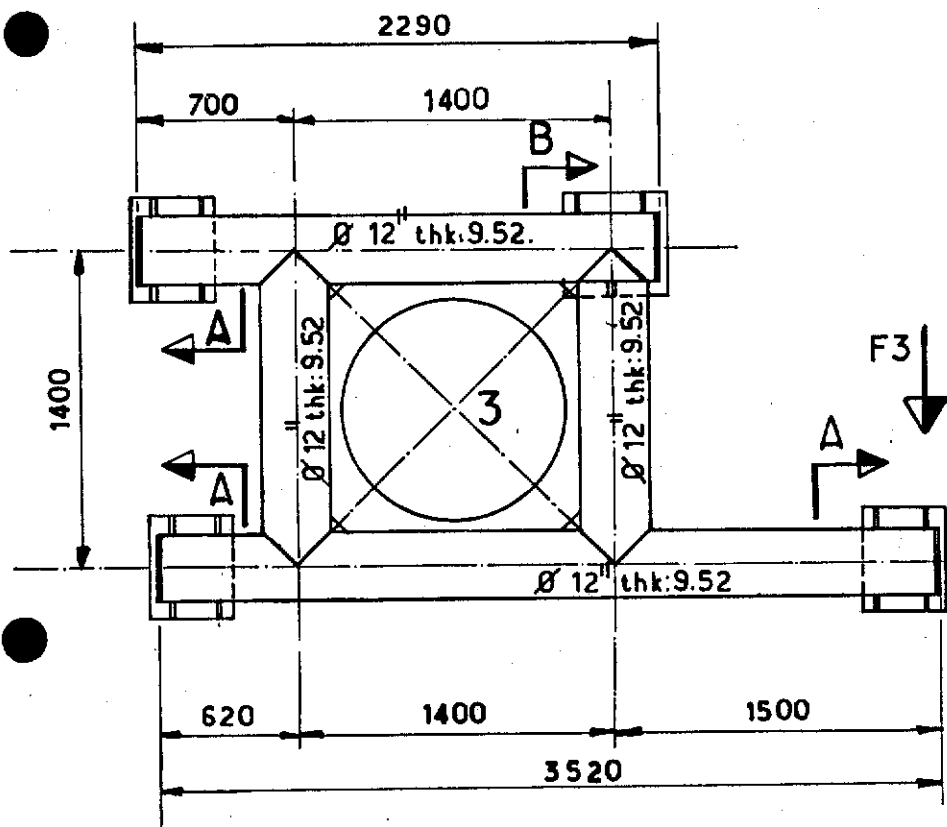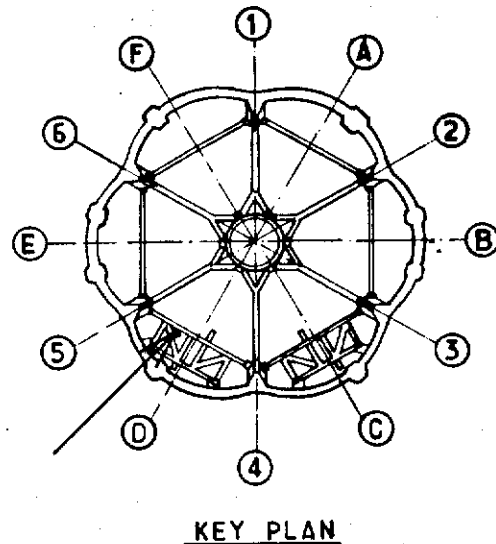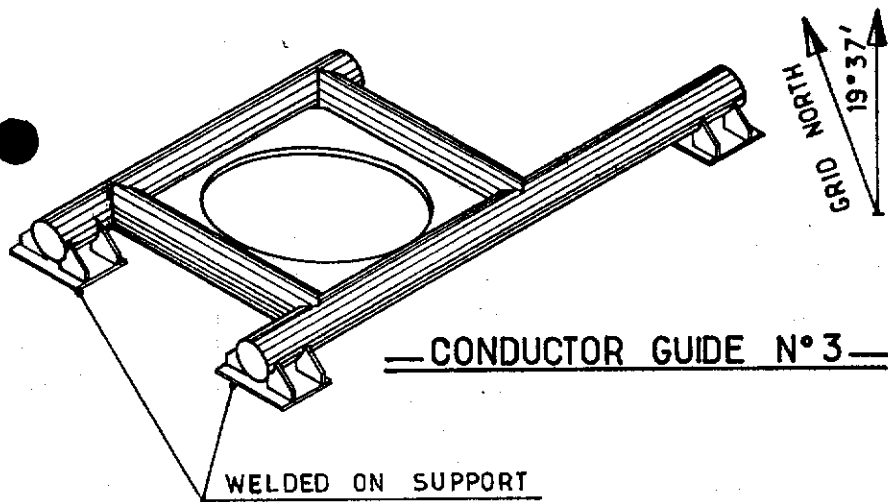

—SECTION A—


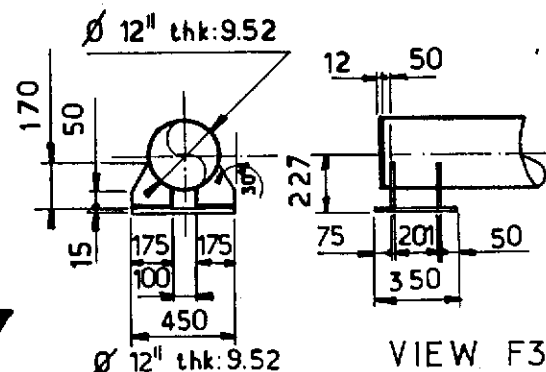


—SECTION B—

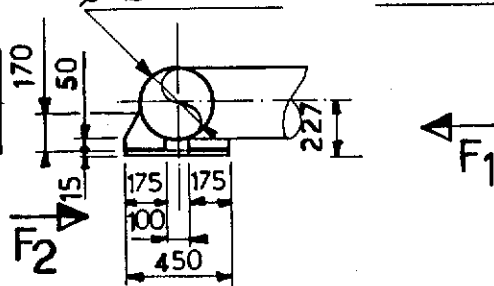

NOTES

FOR LOCATION SEE SK FF. 91.36.35.1355.
FOR CONDUCTOR SLEEVE SEE SK FF. 91.36.35.1491.

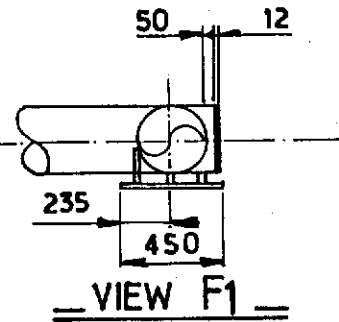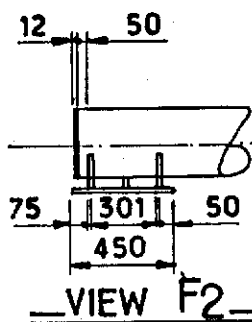

					elf aquitaine norge a/s p.o.box 168 4001 Stavanger	 elf	Job no.	Installation CDP 1	System UNDERWATER	
1	1283	UP DATED	b.v.h	f.l.c.			Scale 1:33	CONDUCTOR GUIDE N°3 CELL D SECONDARY FRAME LEVEL G		
Rev.	Date	DESCRIPTION	by	app.			Dwgr.no.	FF. 91.36.35.1359.		Rev. 1
Contractor JVD 1029_40.29										
					FRIGG FIELD					




CDP 1 AS BUILT DRAWINGS

REFERENCE DRAWING LIST FOR:


[illegible]

						elf aquitaine norge a/s p.o.box 168 4001 Stavanger	 elf	Job no.	Installation CDP 1	System UNDERWATER	
								Scale			
Rev.	Date	DESCRIPTION	by	app.				Dwgr. no.		Rev	Sheet
Contractor					4001 Stavanger	FRIGG FIELD	FF	— — 1359		—	


— CONDUCTOR GUIDE N°4 —

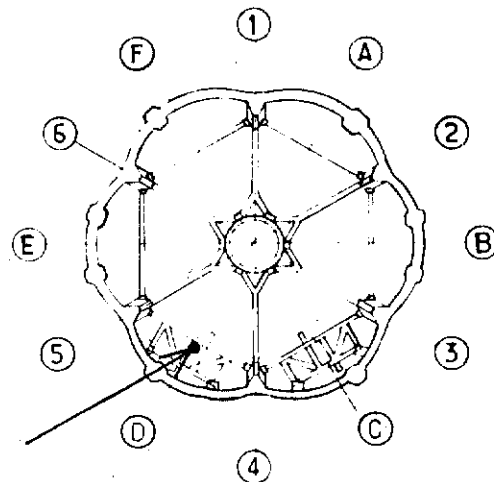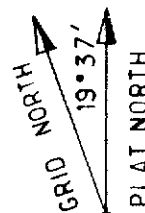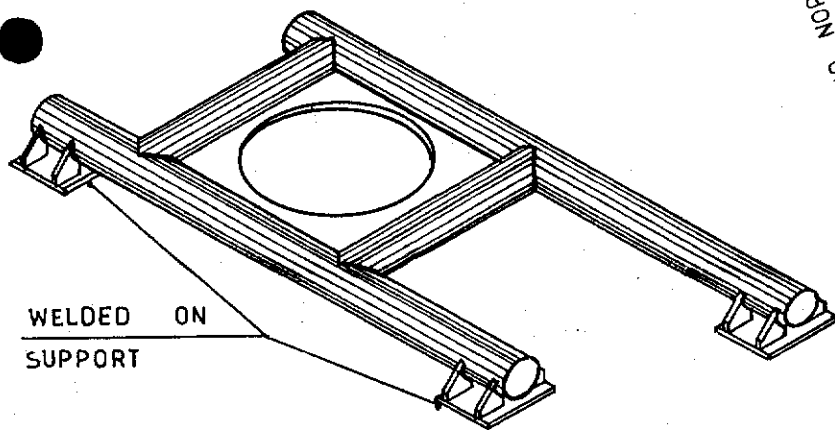


KEY PLAN

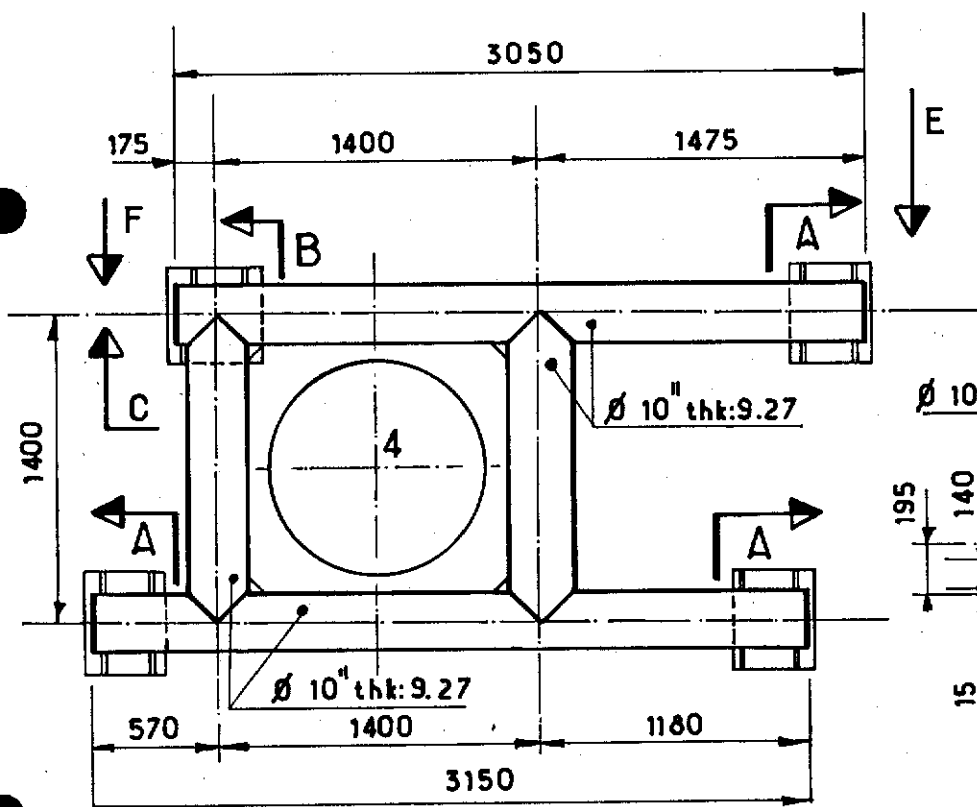


— PLAN VIEW —

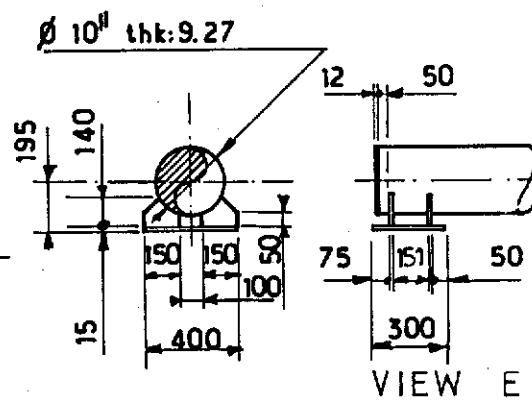


— SECTION A —

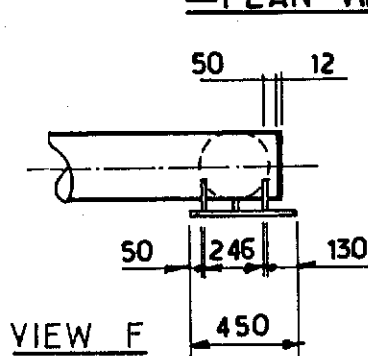

VIEW F

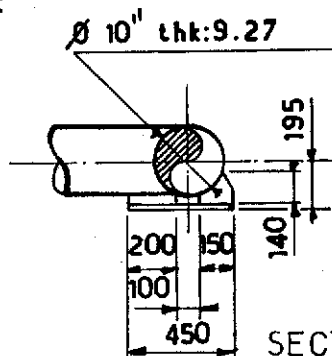

SECTION B

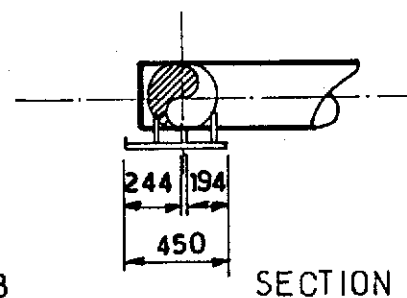

SECTION C

NOTES

FOR LOCATION SEE SK FF.91.36.35.1355
FOR CONDUCTOR SLEEVE SEE SK FF.91.36.35.1491

							Job no.	Installation CDP 1	System UNDERWATER	
1	12.83	UP DATED	BVH	llc			Scale 1:33	CONDUCTOR GUIDE N°4 CELL D SECONDARY FRAME LEVEL G		
Rev.	Date	DESCRIPTION	by	app.			Dwgr. no			
Contractor JVD 1029_40. 30							FF. 91. 36. 35. 1360.			1
elf aquitaine norge a/s p.o.box 168 4001 Stavanger						FRIGG FIELD				


CDP 1 AS BUILT DRAWINGS

●REFERENCE DRAWING LIST FOR:


[illegible]

	Job no.	Installation CDP 1	System UNDERWATER	
	Scale			
Dwgr. no. FF	_____ 1360		Rev	Sheet /


WELDED ON
SUPPORT

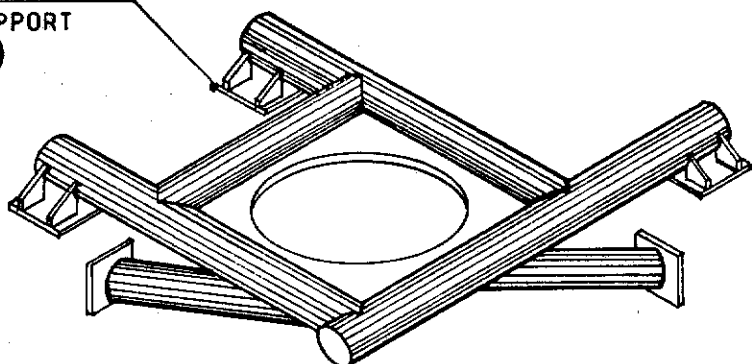


— CONDUCTOR GUIDE N°5 —

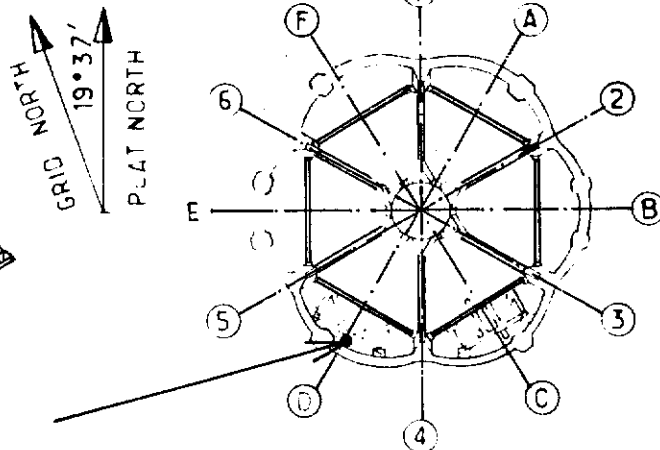

KEY PLAN

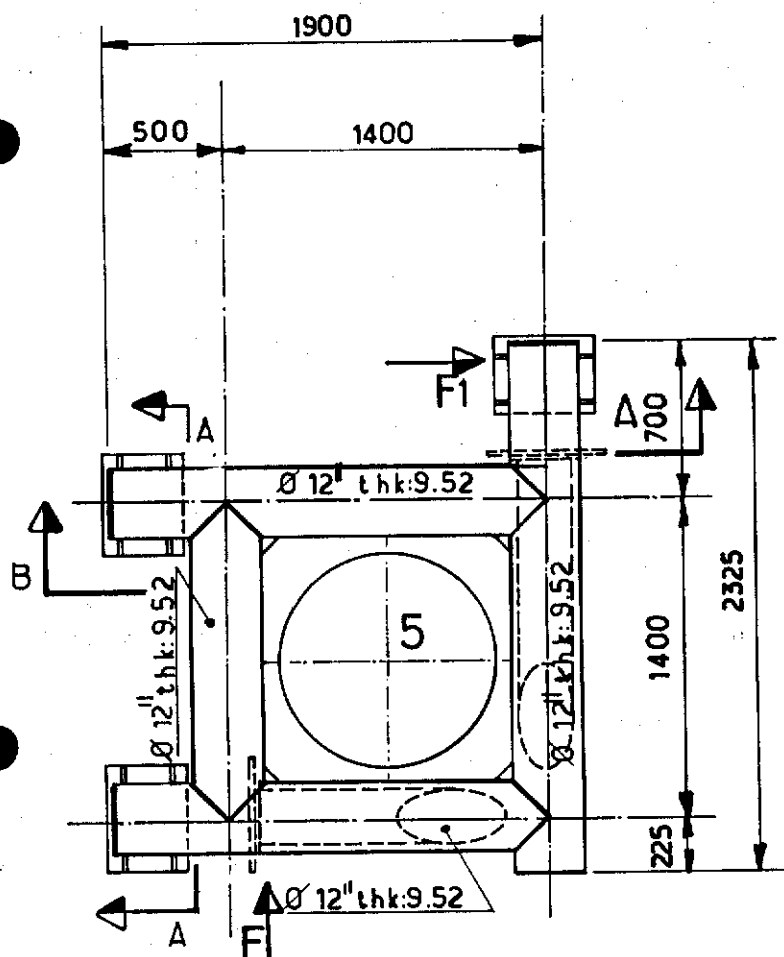

— PLAN VIEW —

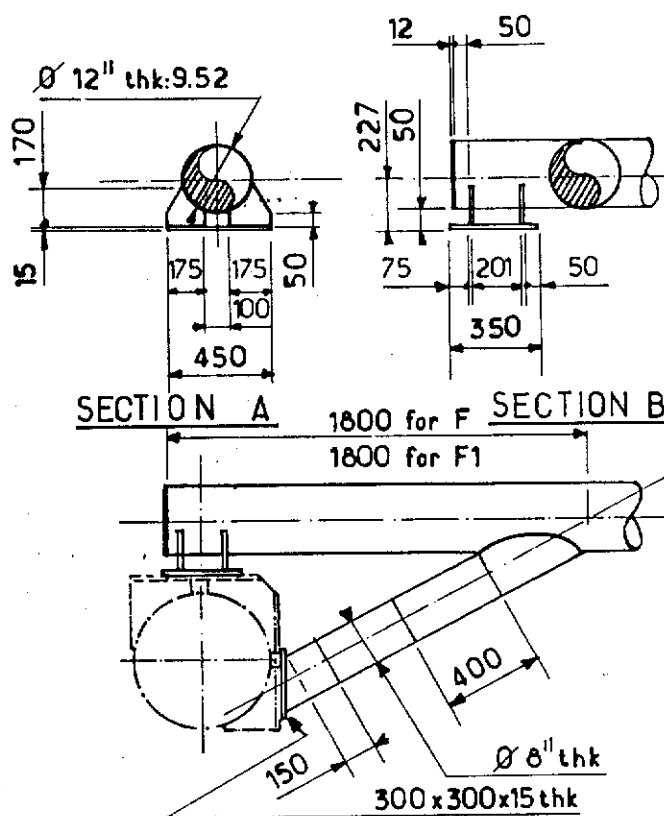

— VIEW F AND F1 —

NOTES

FOR LOCATION SEE SK FF. 91.36.35.1355

FOR CONDUCTOR SLEEVE SEE SK FF. 91.36.35.1491


				elf aquitaine norge a/s		Job no.	Installation CDP 1	System UNDERWATER
1	12.83	UP DATED	BVH	444		Scale 1:33	CONDUCTOR GUIDE N°5 CELL D SECONDARY FRAME LEVEL C	
Rev.	Date	DESCRIPTION	by	app.	p.o.box 168	Dwgr. no	FF_91_36_35_1361.	Rev. 1
Contractor JVD 1029_40.31				4001 Stavanger	FRIGG FIELD			Sheet

CDP 1 AS BUILT DRAWINGS








REFERENCE DRAWING LIST FOR:

[illegible]

					elf aquitaine norge a/s p.o.box 168 4001 Stavanger		 elf		Job no. Installation CDP 1		System UNDERWATER	
Rev. Date DESCRIPTION by app.					Scale							
Contractor					4001 Stavanger		Dwgr. no. FF — — <u>1361</u>		Rev	Sheet /		

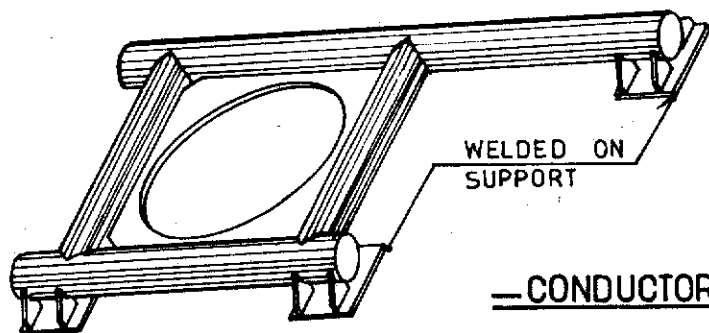

—CONDUCTOR GUIDE N°6—

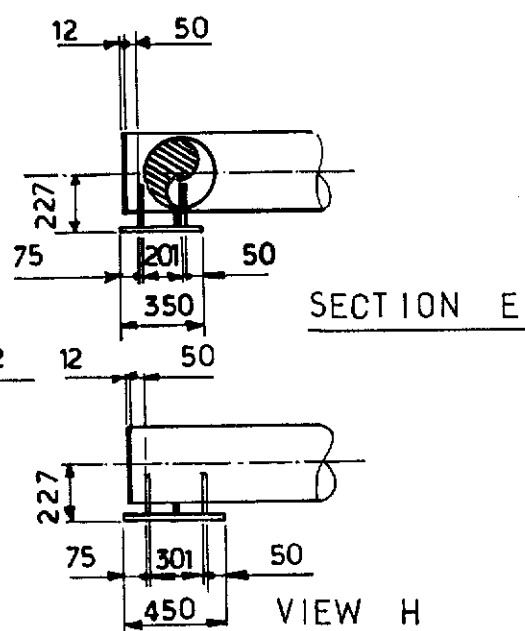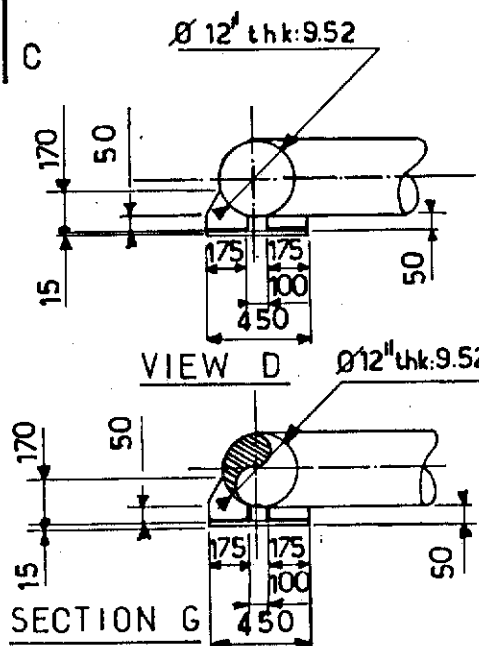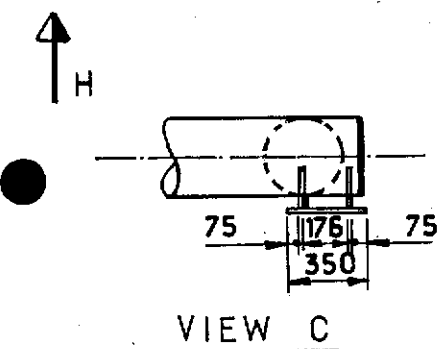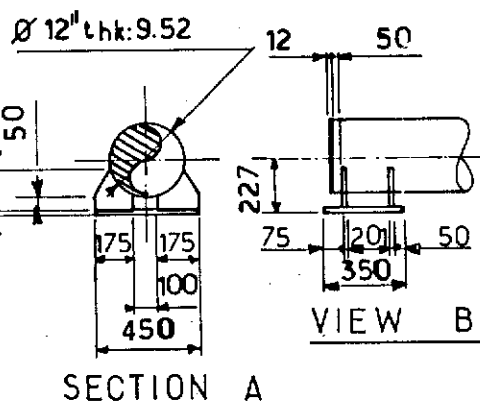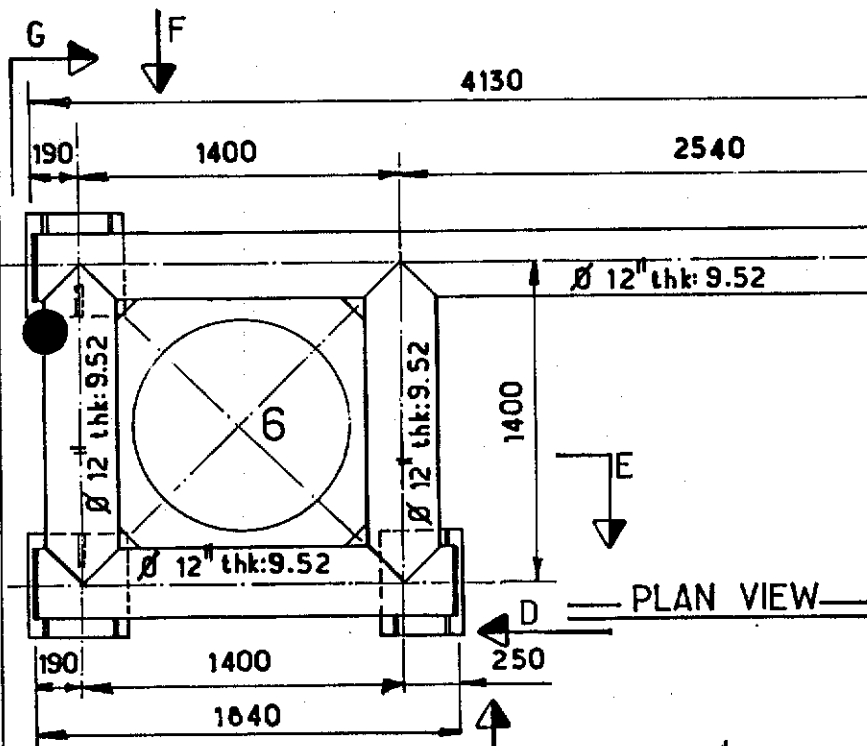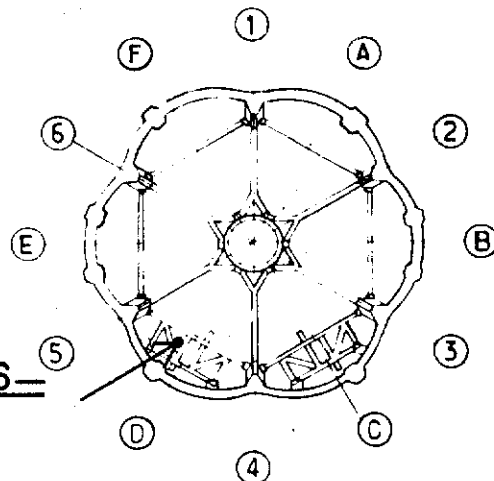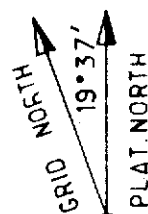

NOTES

FOR LOCATION SEE SK FF.91.36.35.1355

FOR CONDUCTOR SLEEVE SEE SK FF.91.36.35.1491



						 elf	Job no.	Installation CDP 1	System UNDERWATER		
1	12.83	UP DATED	BVH	JLC			Scale 1:33	CONDUCTOR GUIDE N°6 CELL D SECONDARY FRAME LEVEL G			
Rev.	Date	DESCRIPTION	by	app.			Dwgr. no.	FF 91_36_35_1362.		Rev. 1	Sheet /
Contractor JVD 1029_40.32						p.p.box 168 4001 Stavanger	FRIGG FIELD				

CDP 1 AS BUILT DRAWINGS

REFERENCE DRAWING LIST FOR:

[illegible]

					elf aquitaine norge a/s p.o.box 168 4001 Stavanger		elf FRIGG FIELD		Job no. Installation CDP 1		System UNDERWATER	
Rev. Date DESCRIPTION by app.					Scale		Dwgr. no. FF 1362		Rev		Sheet /	
Contractor												

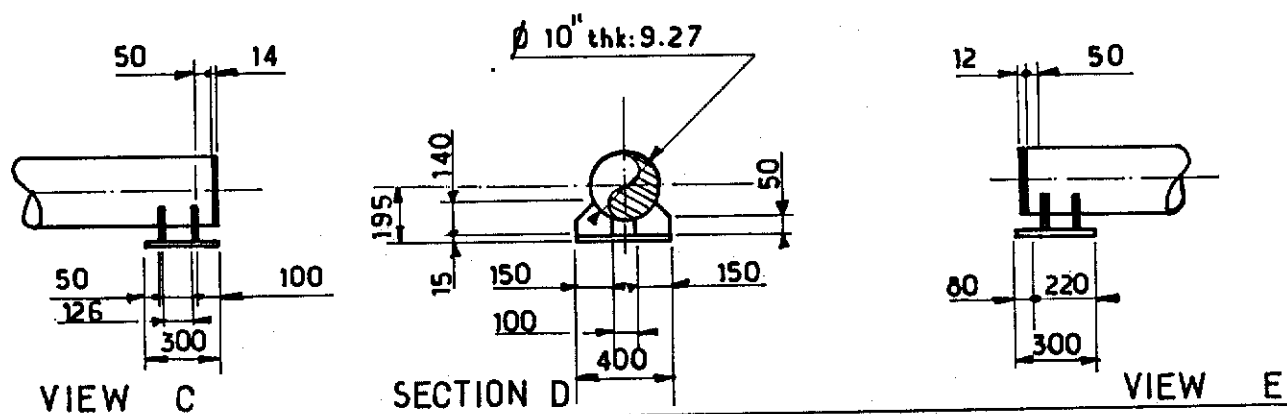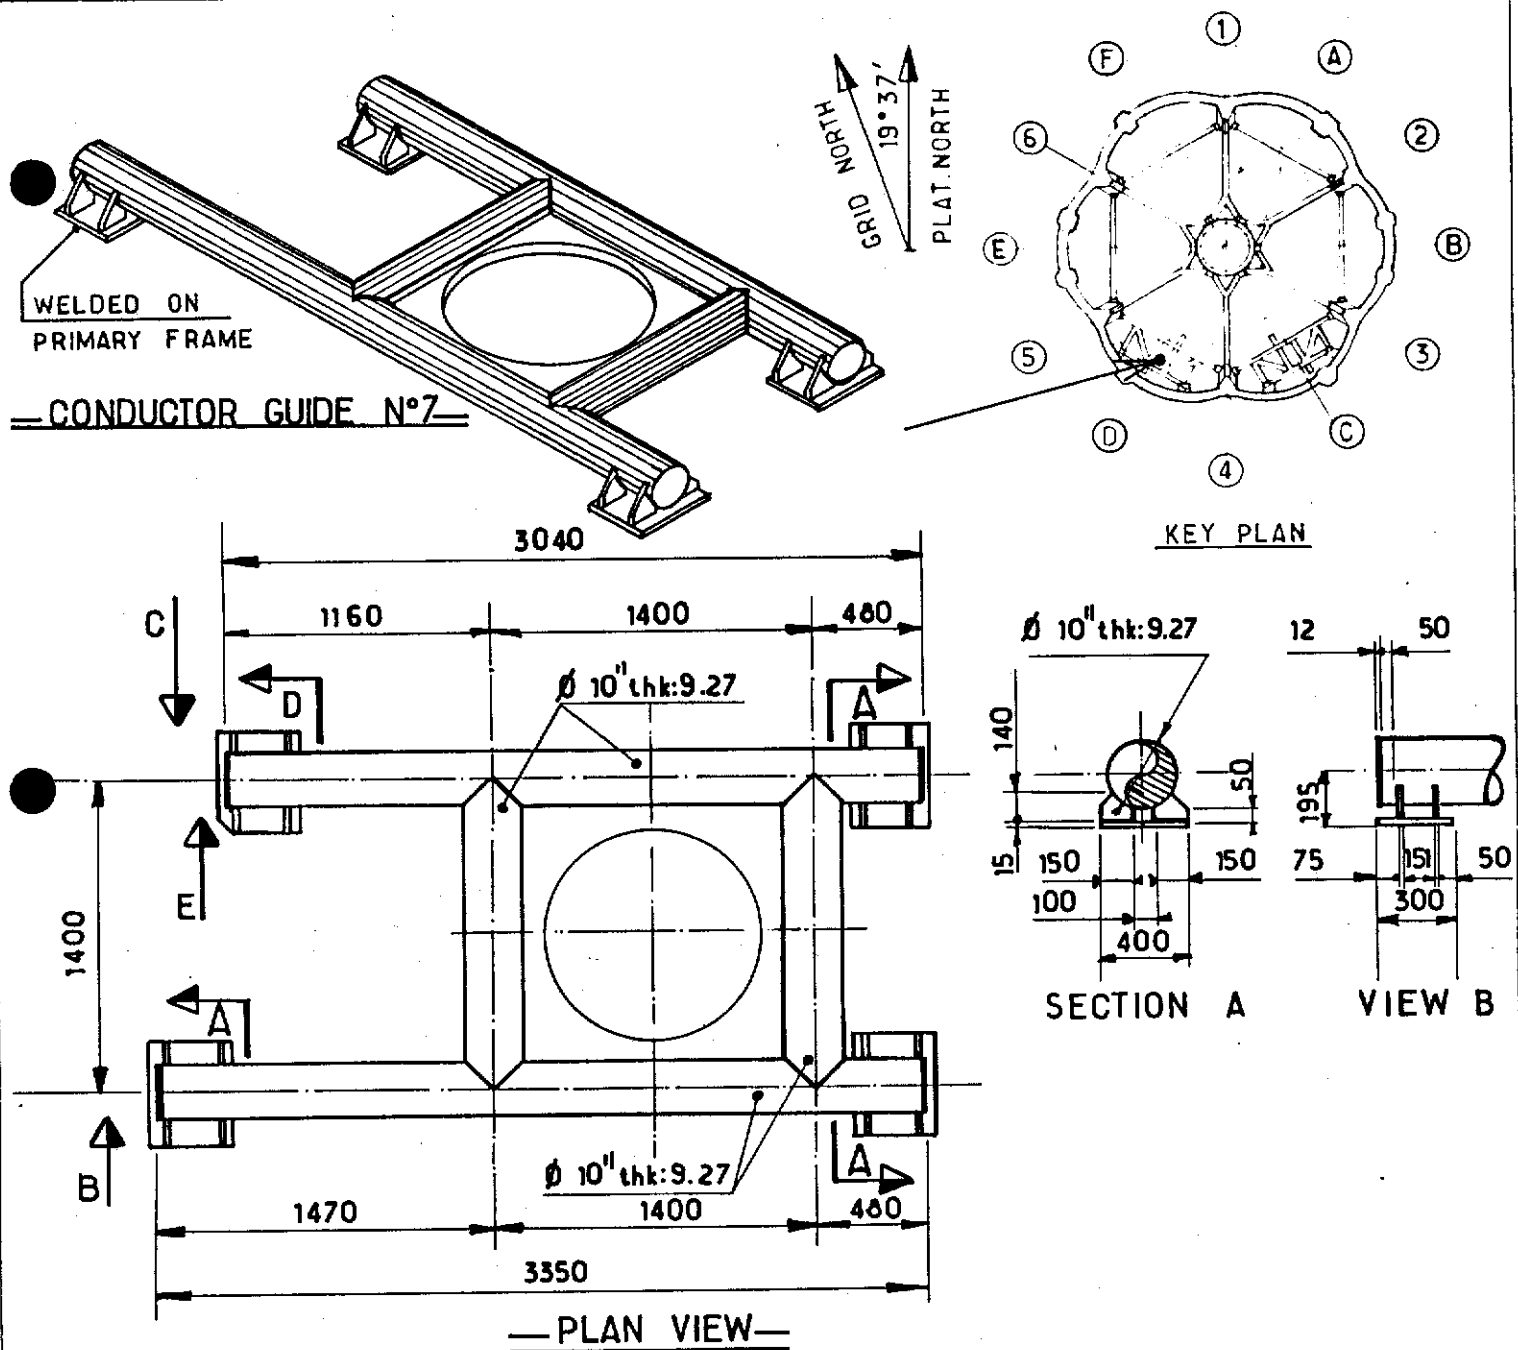

NOTES

FOR LOCATION SEE SK FF.91.36.35 - 1355
FOR CONDUCTOR SLEEVE SEE SK FF - 91.36.35-1491

				elf aquitaine norge a/s p.o.box 168 4001 Stavanger	 elf	Job no.	Installation CDP 1	System UNDERWATER
1	12.83	UP DATED	BVH/LLC			Scale 1:33	CONDUCTOR GUIDE N°7 CELL D SECONDARY FRAME LEVEL C	
Rev.	Date	DESCRIPTION	by	app.		Dwgr. no.	FF. 91.36.35.1363.	1
Contractor JVD 1029_40.33				FRIGG FIELD				


CDP 1 AS BUILT DRAWINGS

REFERENCE DRAWING LIST FOR:


[illegible][illegible]

					elf aquitaine norge a/s p.o.box 168 4001 Stavanger		 elf		Job no.	Installation CDP 1	System UNDERWATER	
Rev. Date DESCRIPTION by app.		Scale										
Contractor					4001 Stavanger		FRIGG FIELD	Dwgr. no. FF — — 1363	Rev.	Sheet /		

WELDED ON SUPPORT

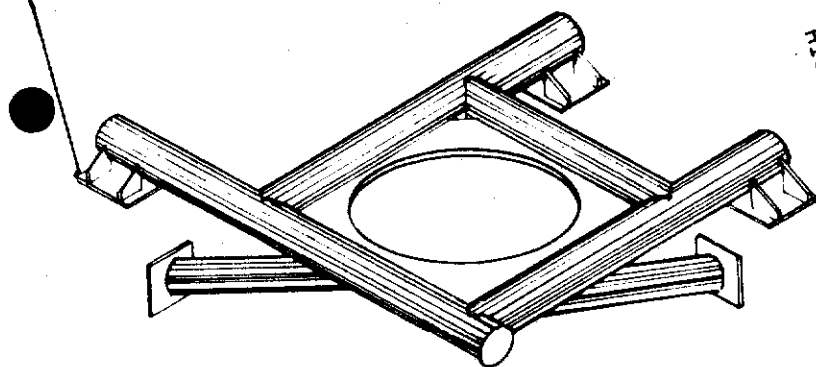


GRD NORTH
19° 37'
PLAT. NORTH

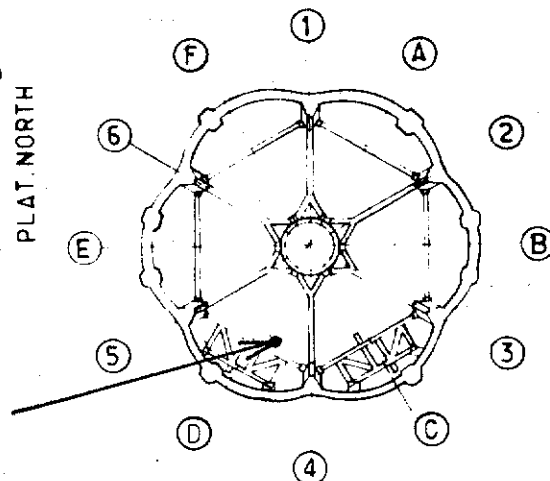

— CONDUCTOR GUIDE N° 8 —


KEY PLAN

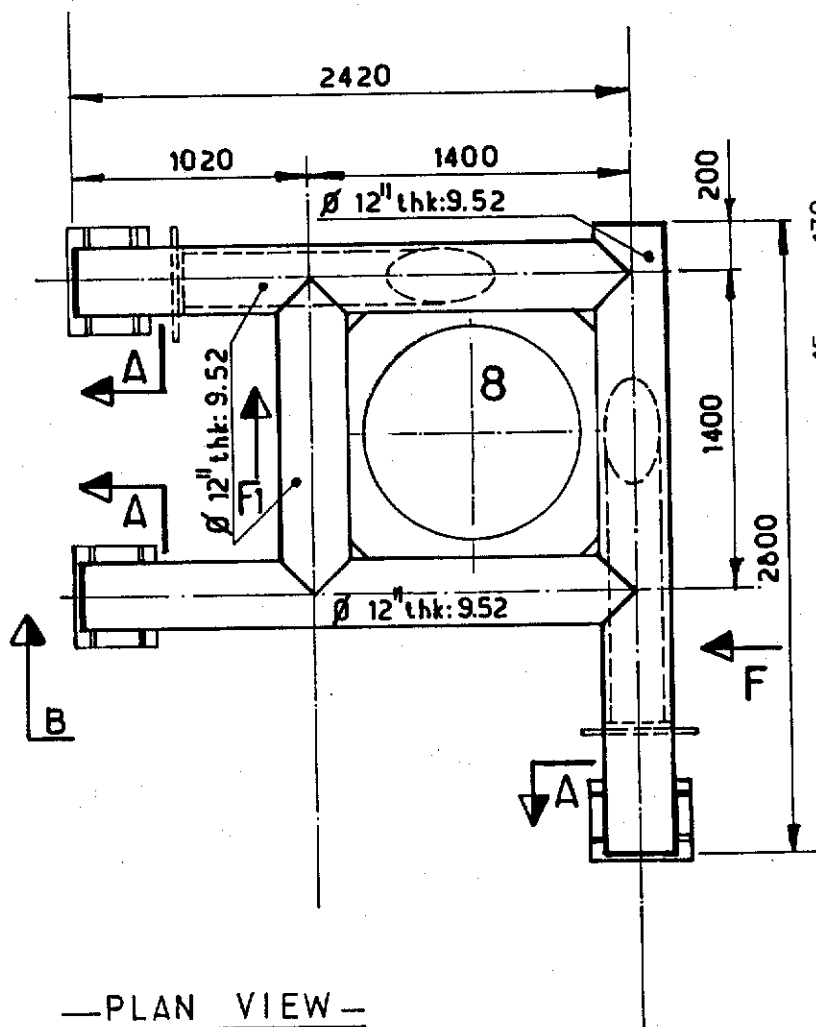

— PLAN VIEW —

SECTION A

VIEW B

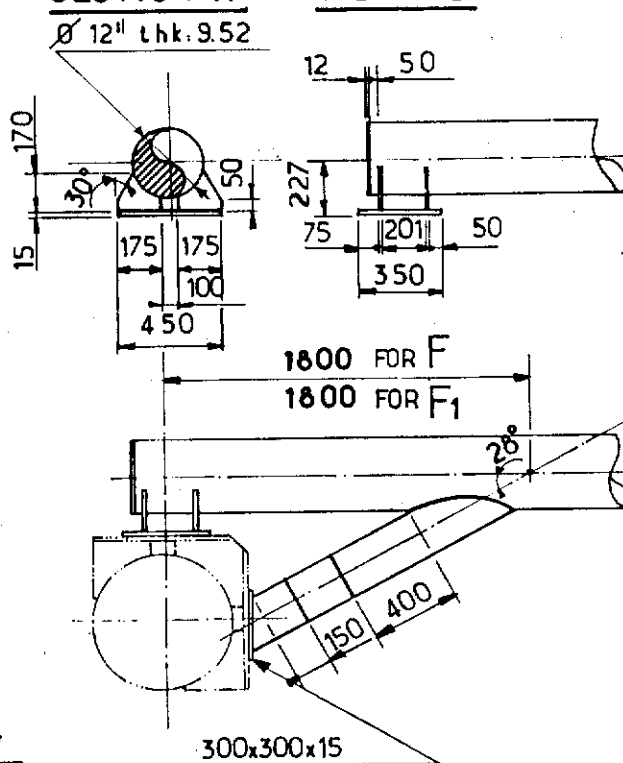

— VIEW F AND F1 —

NOTES

FOR LOCATION SEE SK. FF. 91.36.35.1355.

FOR CONDUCTOR SLEEVE SEE SK. FF. 91.36.35.1491.

					elf aquitaine norge a/s p.o.box 168 4001 Stavanger		elf FRIGG FIELD		Job no. Scale 1:33 Dwgr. no.		Installation CDP 1 CONDUCTOR GUIDE N°8 CELL D SECONDARY FRAME		System UNDERWATER LEVEL G FF. 91.36.35.1364		Fig. 1 Sheet /	
112.83 UP DATED BVH/jlc Rev. Date DESCRIPTION by app. Contractor JVD 1029_40.34																


CDP 1 AS BUILT DRAWINGS

●REFERENCE DRAWING LIST FOR:


[illegible]

					elf aquitaine norge a/s p.o.box 168 4001 Stavanger		elf		Job no. Scale Dwgr. no.		Installation CDP 1 FF — — 1364		System UNDERWATER Rev		Sheet /	
Rev. Date DESCRIPTION by app.					Contractor		FRIGG FIELD		FF		1364		/			

WELDED ON
SUPPORT

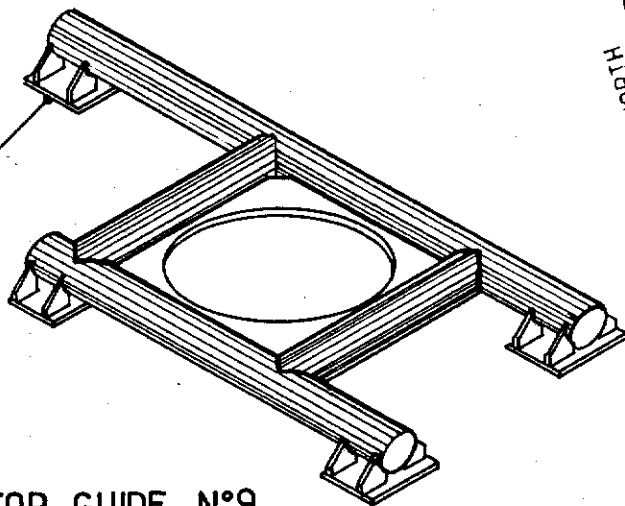


GRID NORTH
19° 37'
PLAT. NORTH

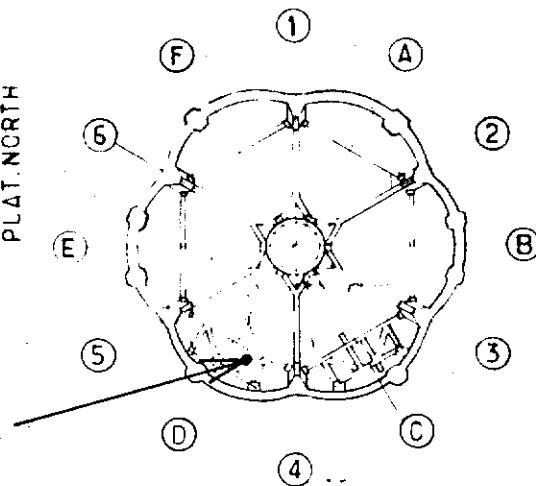


KEY PLAN


—CONDUCTOR GUIDE N°9—

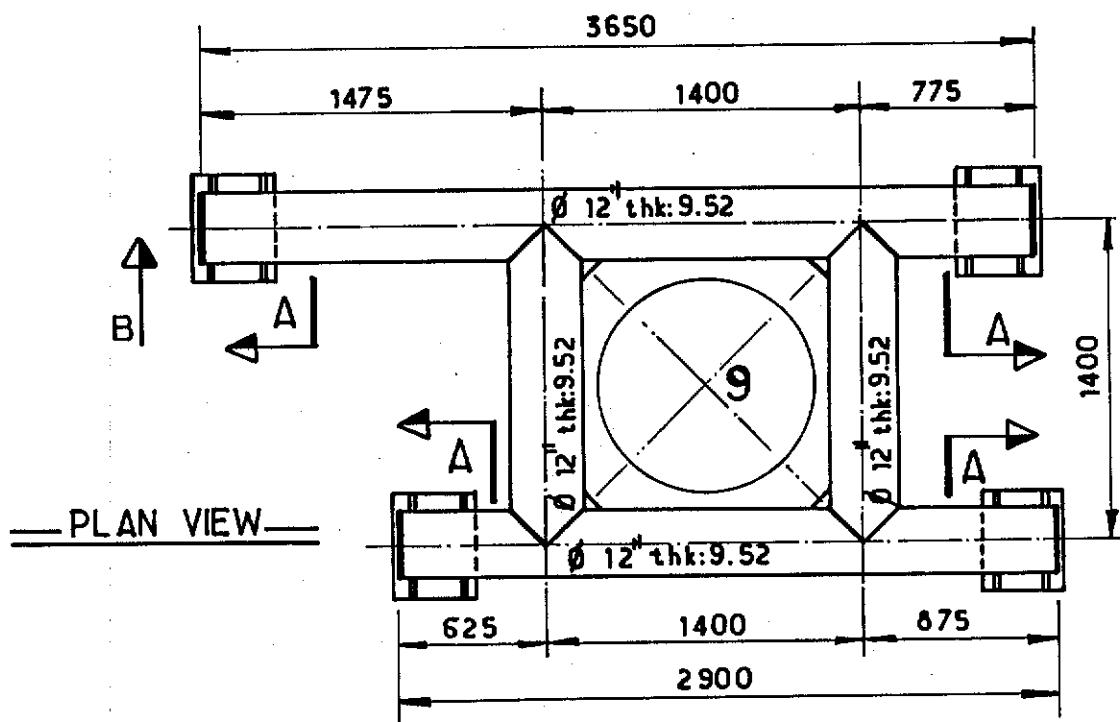

—PLAN VIEW—

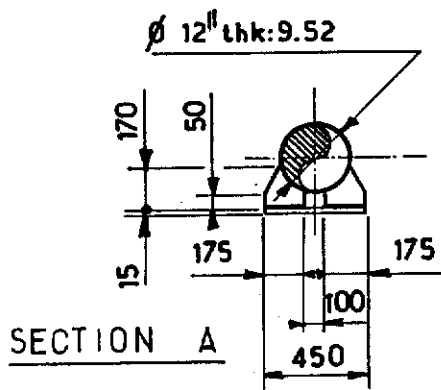

SECTION A

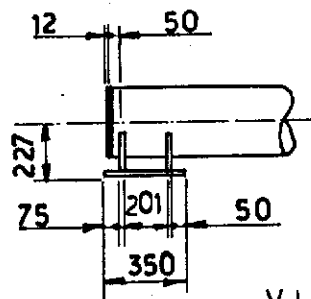

VIEW B

NOTES

FOR LOCATION SEE SK FF. 91. 36. 35. 1355.
FOR CONDUCTOR SLEEVE SEE SK FF. 91. 36. 35. 1491.


					elf aquitaine norge a/s p.o. box 168 4001 Stavanger		elf		Job no.	Installation CDP 1	System UNDERWATER
1	12.83	UP DATED	BVH	J-LC					Scale 1:33	CONDUCTOR GUIDE N°9 CELL D SECONDARY FRAME LEVEL G	
Rev.	Date	DESCRIPTION	by	app.					Dwgr. no.	FF 91 36 35 1365	1
Contractor JVD 1029_40. 35					FRIGG FIELD						

CDP 1 AS BUILT DRAWINGS



●REFERENCE DRAWING LIST FOR:

[illegible]


●					elf aquitaine norge a/s p.o.box 168 4001 Stavanger	 elf	Job no.	Installation CDP 1	System UNDERWATER	
							Scale			
Rev.	Date	DESCRIPTION	by	app.	FRIGG FIELD	Dwgr. no. FF — — <u>1365</u>	Rev	Sheet /		
Contractor										

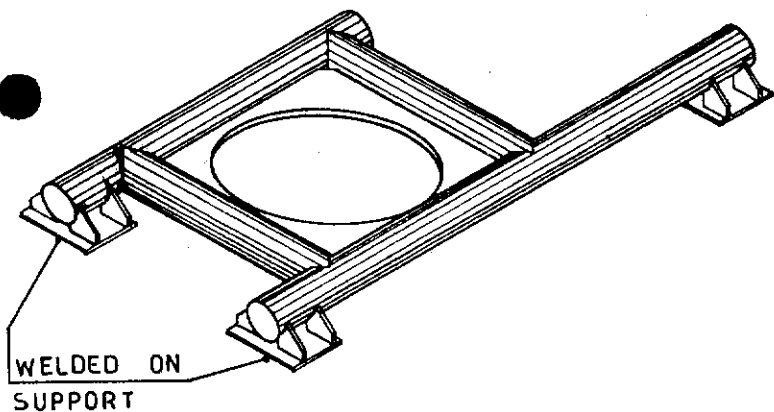

— CONDUCTOR GUIDE N°10 —

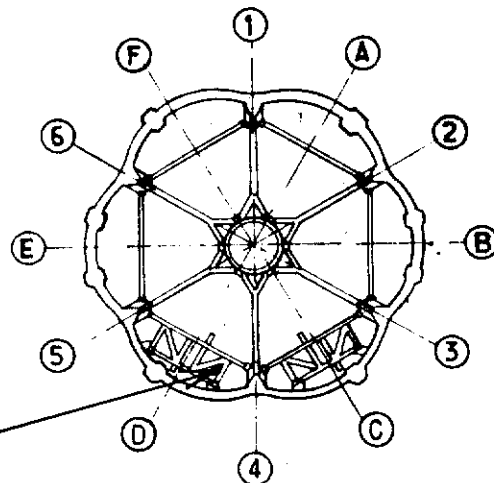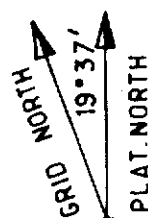


KEY PLAN

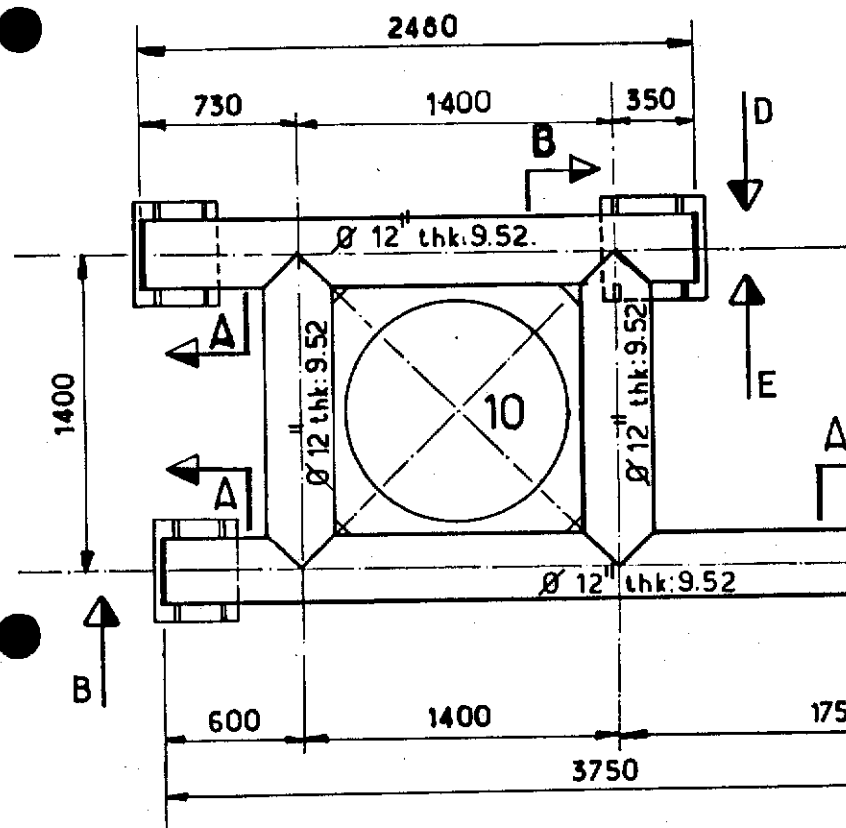


— PLAN VIEW —


SECTION A

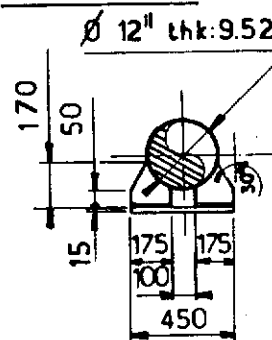


VIEW B

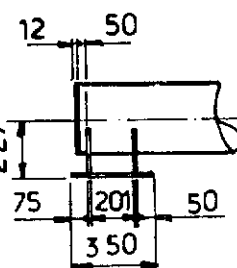


SECTION C

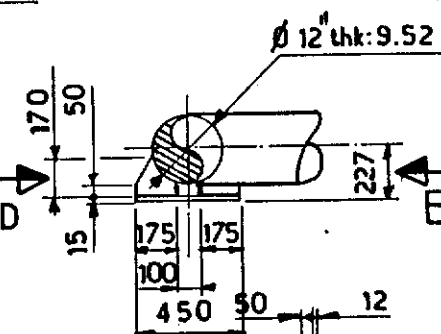

VIEW D

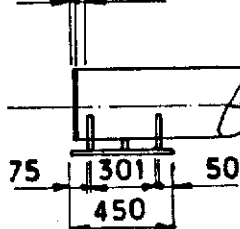

SECTION E

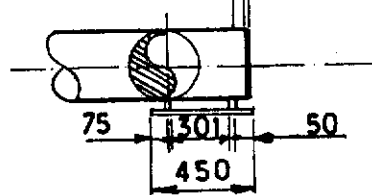

NOTES

FOR LOCATION SEE SK FF. 91.36.35.1355.
FOR CONDUCTOR SLEEVE SEE SK FF.91.36.35.1491.

Rev.	Date	DESCRIPTION	by	app.
1	12.83	UP DATED	BVH	JLC
Contractor JVD 1029_40.36				

elf
aquitaine
norge a/s
p.o. box 168
4001 Stavanger



FRIGG FIELD

Job no.	Installation	System
	CDP 1	UNDERWATER
Scale	CONDUCTOR GUIDE N° 10 CELL D	
1:33	SECONDARY FRAME LEVEL G	
Dwgr. no.	Rev.	Sheet
FF.91.36.35.1366.	1	







CDP 1 AS BUILT DRAWINGS

REFERENCE DRAWING LIST FOR:

[illegible]

				elf aquitaine norge a/s p.o.box 168 4001 Stavanger		 elf		Job no.		Installation CDP 1		System UNDERWATER	
								Scale					
Rev.	Date	DESCRIPTION	by	app.					Dwgr. no.		Rev		Sheet
Contractor					4001 Stavanger		FRIGG FIELD		FF		1366		/

— CONDUCTOR GUIDE N°11 —

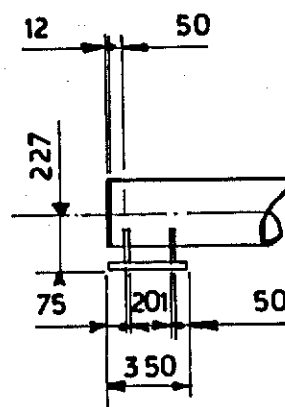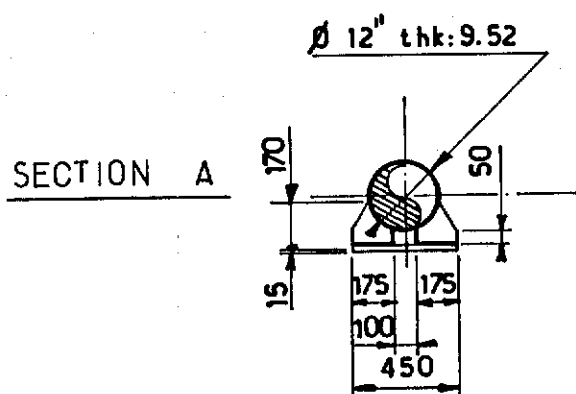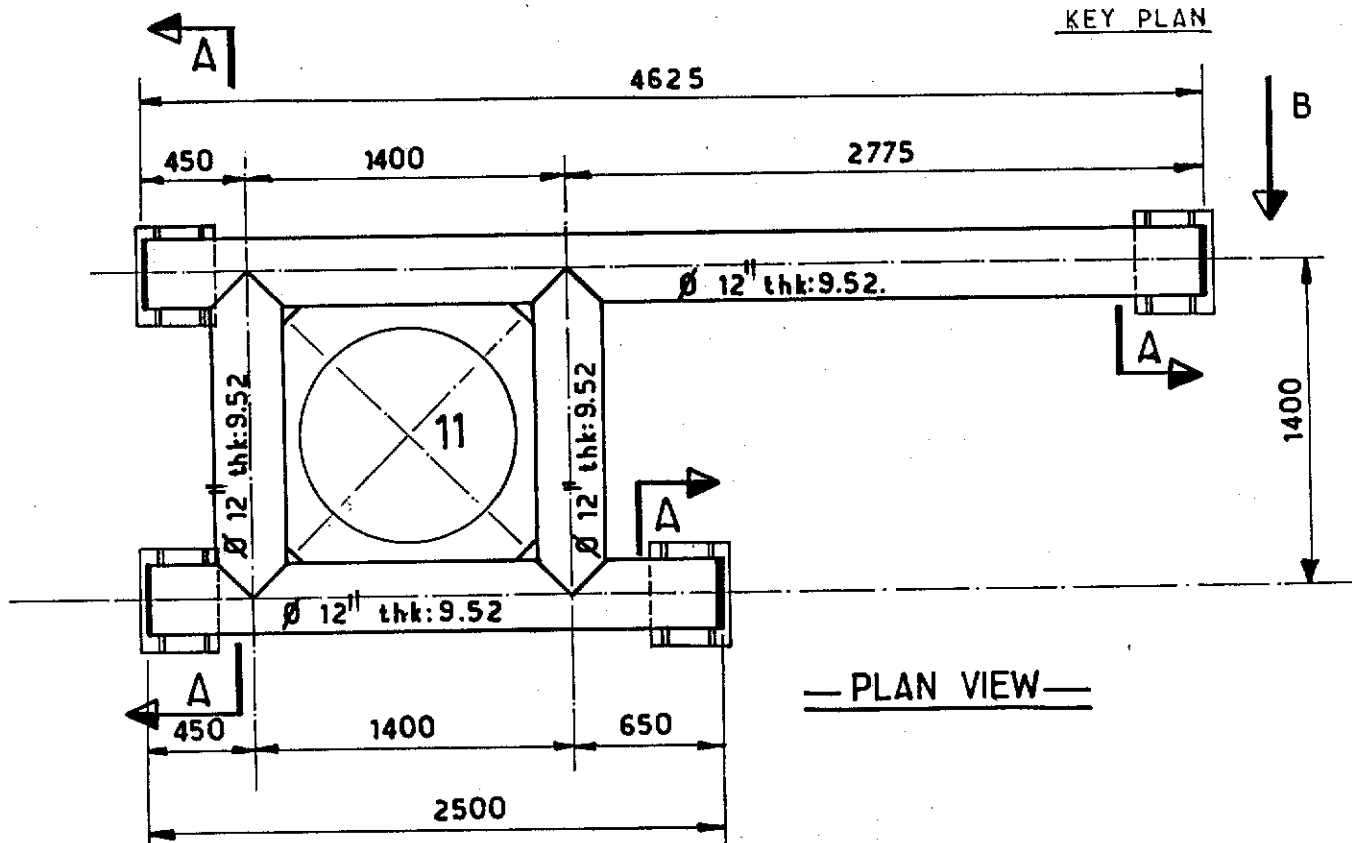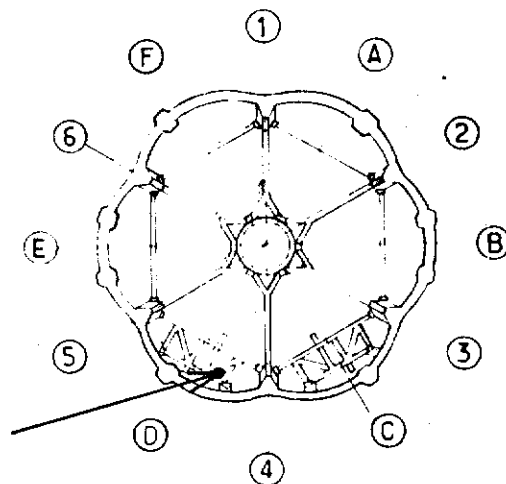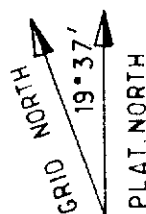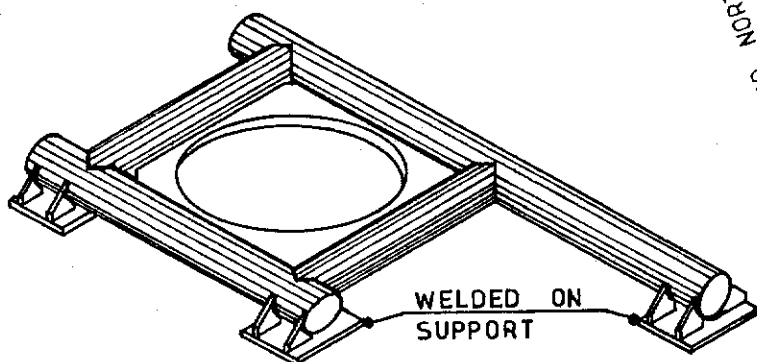

NOTES

FOR LOCATION SEE SK FF. 91.36.35.1355.

FOR CONDUCTOR SLEEVE SEE SK FF. 91.36.35.1491.


FOR CONDUCTOR SECONDARY FRAME					elf aquitaine norge a/s			Job no.	Installation CDP 1	System UNDERWATER
1	12.83	UP DATED	B.VH	JLC	p.o. box 168	Scale 1:33		CONDUCTOR GUIDE N°11 CELL D SECONDARY FRAME LEVEL G		
Rev.	Date	DESCRIPTION	by	app.	4001 Stavanger	Dwgr. no.		FF 91 36 35 1367		
Contractor JVD 1029_40. 37					FRIGG FIELD	1			/	

CDP 1 AS BUILT DRAWINGS


REFERENCE DRAWING LIST FOR:

[illegible]


						Job no.	Installation CDP 1	System UNDERWATER	
						Scale			
Rev.	Date	DESCRIPTION	by	app.	elf aquitaine norge a/s p.o.box 168 4001 Stavanger	Dwgr. no. FF — — 1367		Rev.	Sheet /
Contractor									

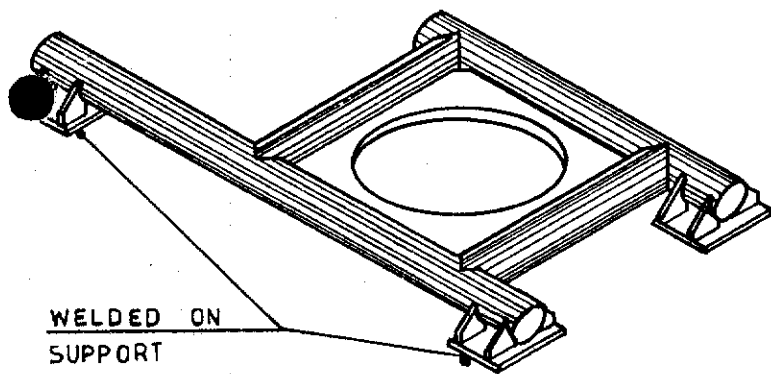





GRD. NORTH
19° 37'
PLAT. NORTH

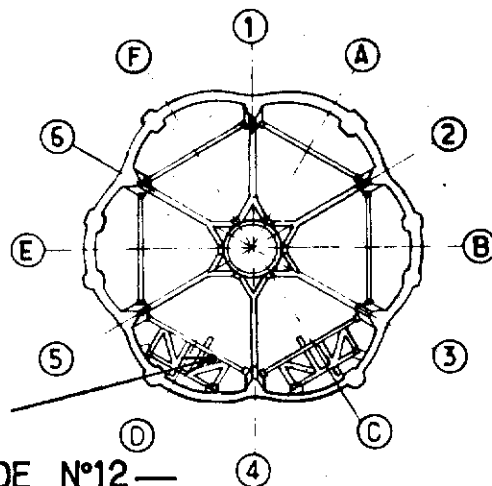

KEY PLAN

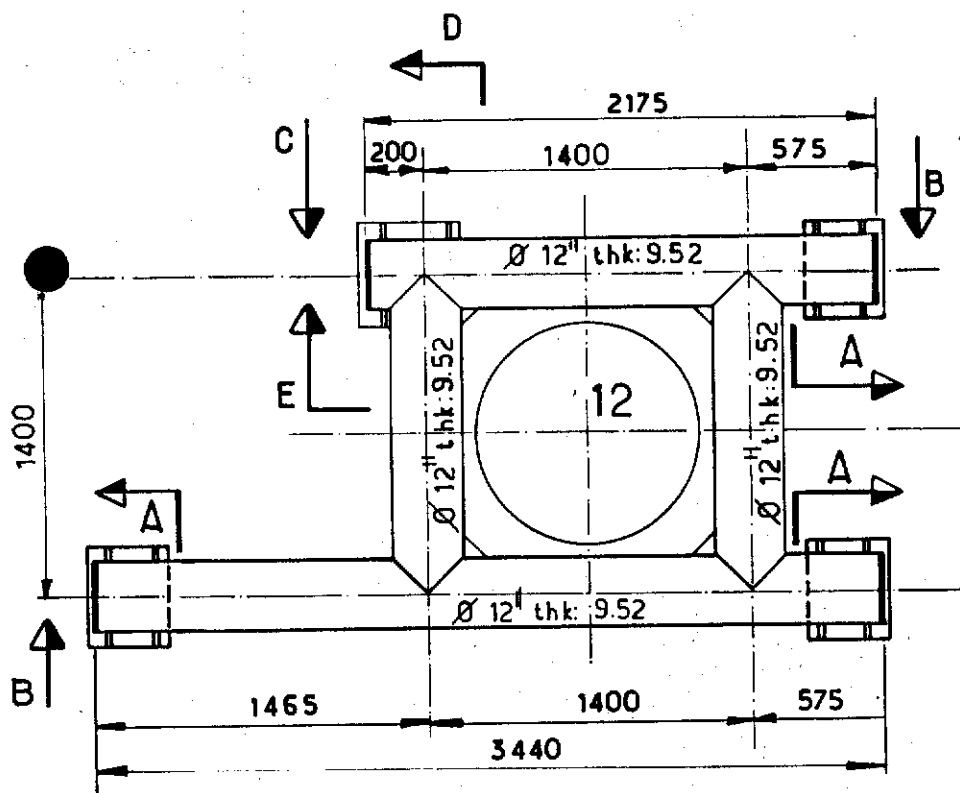

—PLAN VIEW—

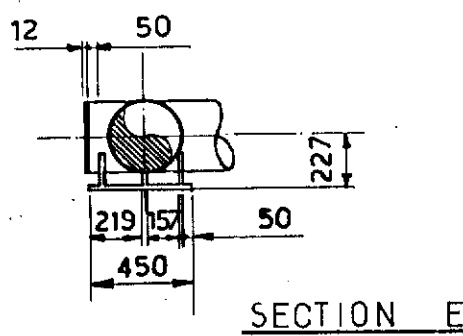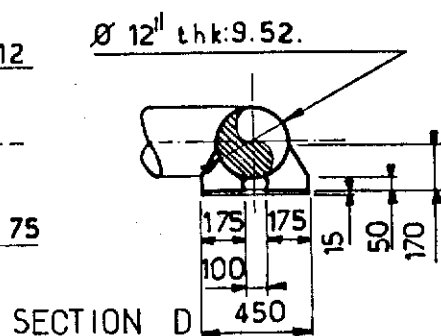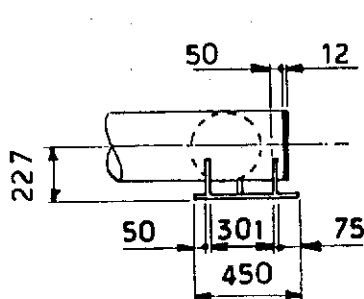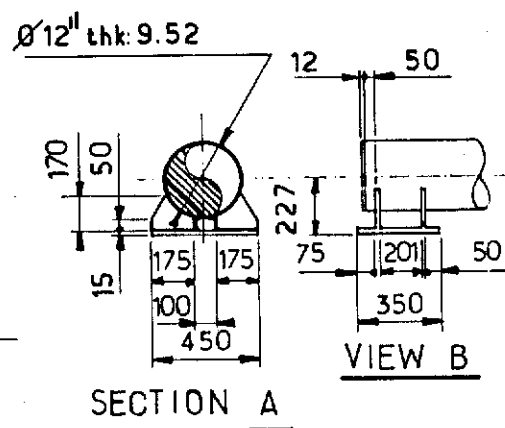

NOTES

FOR LOCATION SEE SK FF. 91.36.35.1355.
FOR CONDUCTOR SLEEVE SEE SK FF. 91.36.35.1491.


					Job no.	Installation CDP 1	System UNDERWATER
1	1283	UP DATED	BVH/JLC		Scale 1:33	CONDUCTOR GUIDE N°12 CELL D	
Rev.	Date	DESCRIPTION	by app.		Dwgr. no.	SECONDARY FRAME	LEVEL G
Contractor JVD 1029_40. 38				elf aquitaine norge a/s p.o. box 168 4001 Stavanger	FRIGG FIELD	FF 91.36.35.1368.	Rev 1 Sheet

CDP 1 AS BUILT DRAWINGS


REFERENCE DRAWING LIST FOR:

[illegible]

				elf aquitaine norge a/s p.o.box 168 4001 Stavanger		 elf		Job no.		Installation CDP 1		System UNDERWATER	
								Scale					
Rev.		Date		DESCRIPTION		by		app.		Dwgr. no.		Rev	
										FF		Sheet	
										1368		/	
Contractor						FRIGG FIELD							


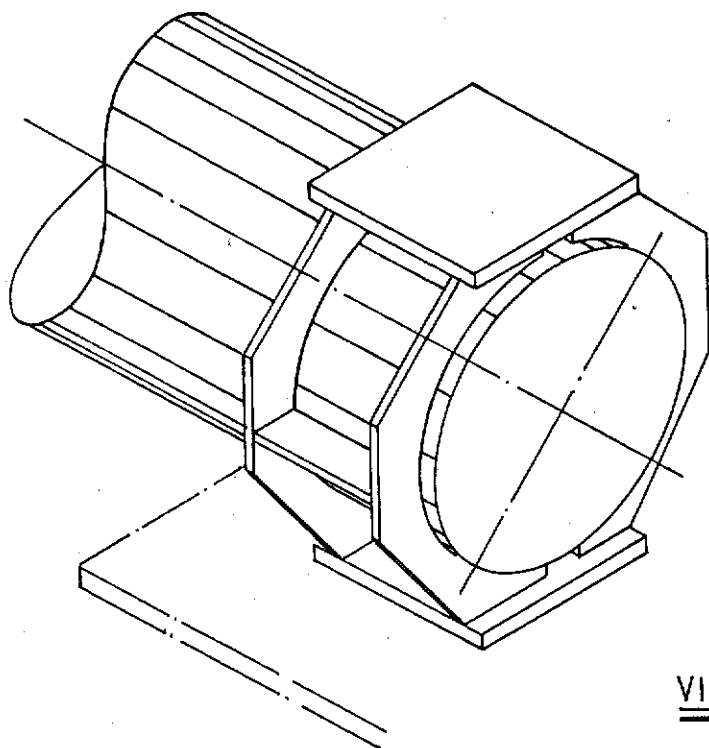


GRID NORTH
19° 37'
PLAT. NORTH

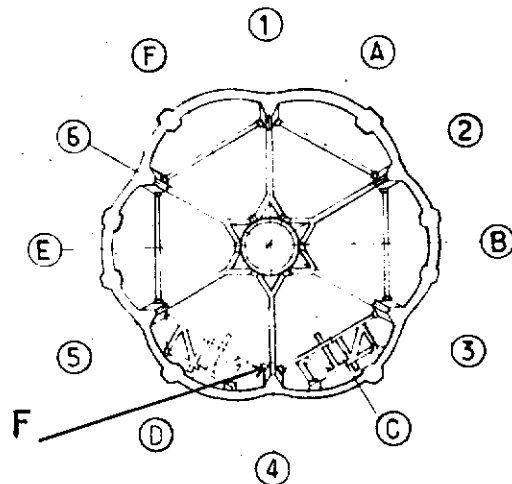

KEY PLAN

VIEW F

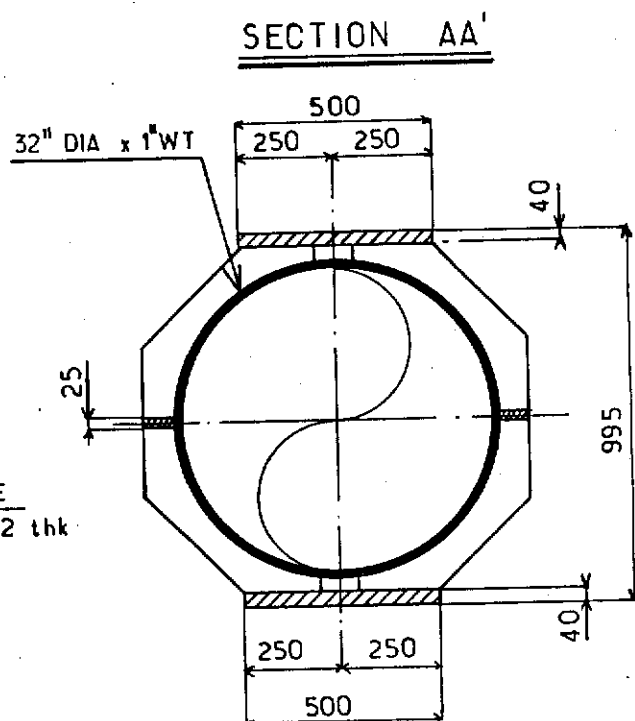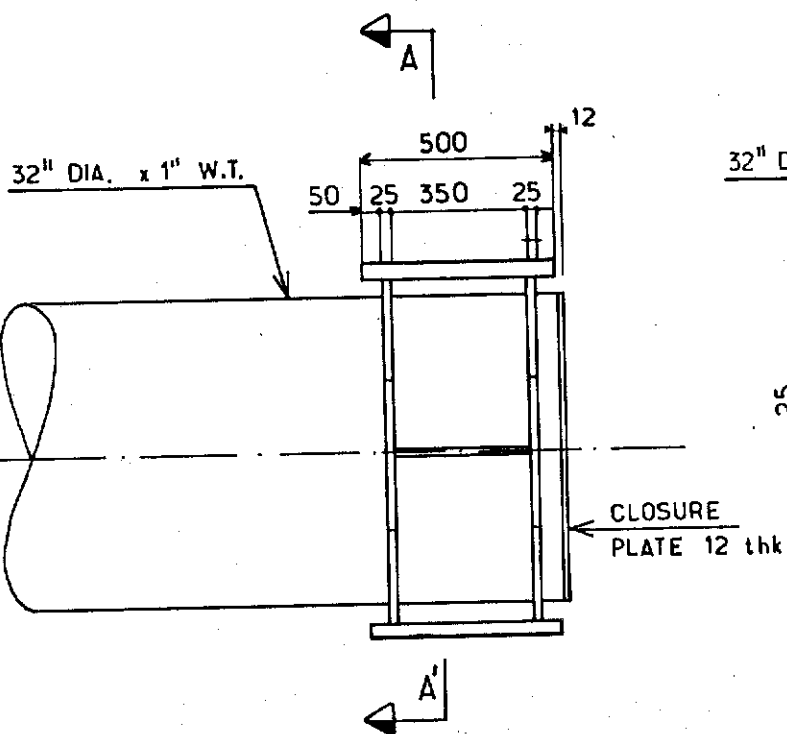

NOTES

FOR LOCATION SEE SK FF. 91. 36.35.1355.
FOR BOX FOR FREE LOCK SEE SK FF. 91.36.35.1371.


				elf aquitaine norge a/s		 elf FRIGG FIELD	Job no.	Installation CDP 1	System UNDERWATER
1.	12.83	UP DATED	BVH	JLC	p.o.box 168		Scale 1:20	FREE LOCK PIPE CELL D	END G01 LEVEL G
Rev.	Date	DESCRIPTION	by	app.	4001 Stavanger		Dwgr. no.	FF 91.36.35.1369	No. 1
Contractor JVD 1029_40_39									

CDP 1 AS BUILT DRAWINGS


REFERENCE DRAWING LIST FOR:

[illegible]

						elf aquitaine norge a/s p.o.box 168 4001 Stavanger	 elf	Job no.	Installation CDP 1	System UNDERWATER	
								Scale			
Rev.	Date	DESCRIPTION	by	app.				Dwgr. no.		Rev.	Sheet
Contractor						4001 Stavanger	FRIGG FIELD	FF	— — 1369		/

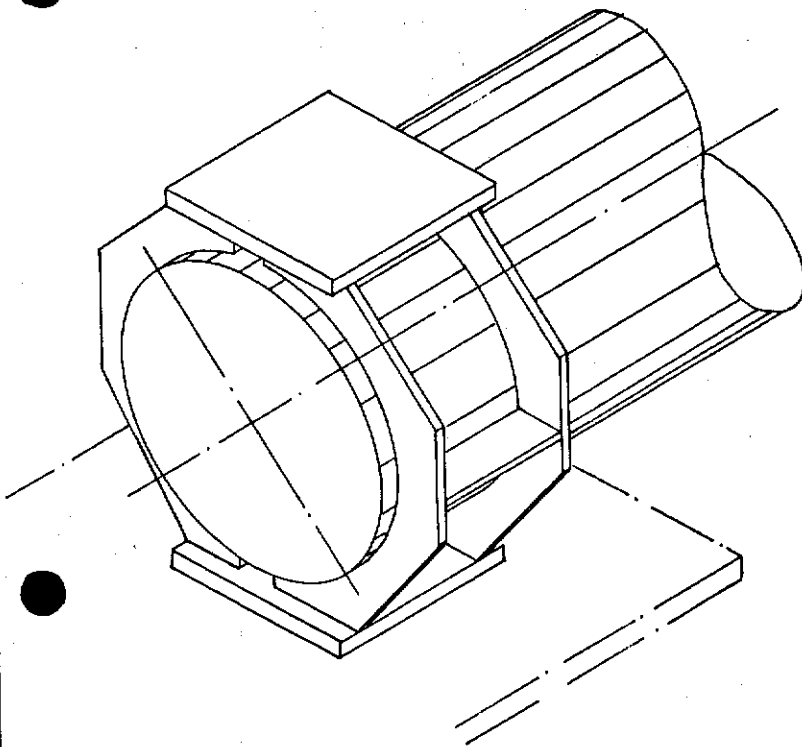


GRID NORTH
19°37'
PLAT. NORTH

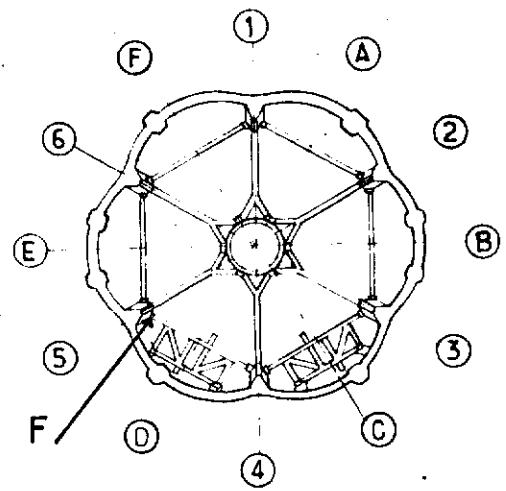


KEY PLAN

VIEW F

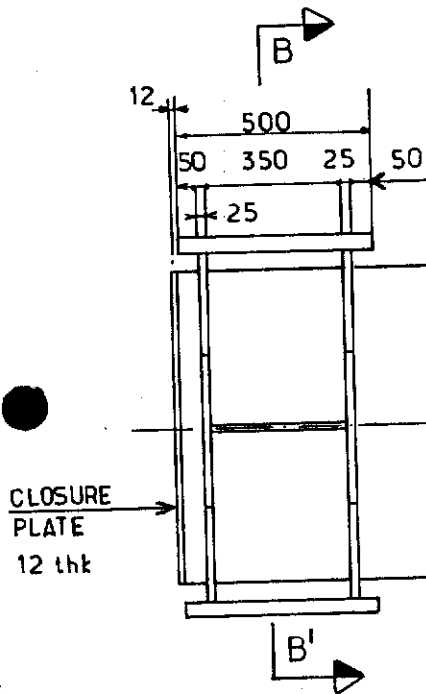

SECTION B B'

Ø 32" DIA. x 1" W.T.

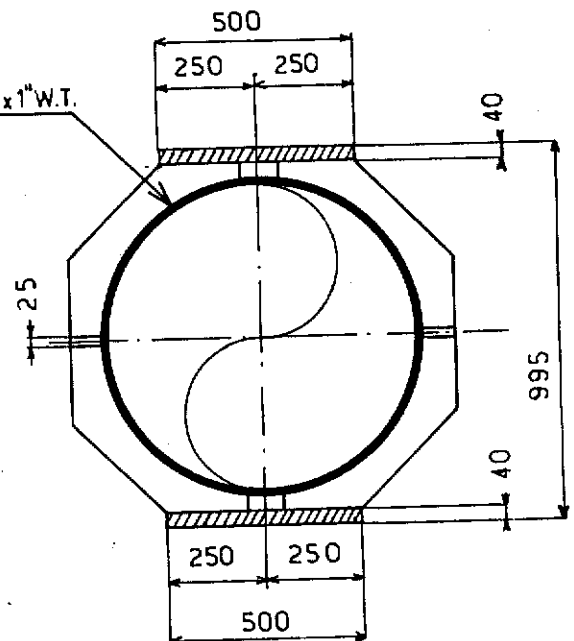

NOTES

FOR LOCATION SEE SK FF. 91.36.35.1355.
FOR BOX FOR FREE LOCK SEE SK FF. 91.36.35.1372.

Rev.	Date	DESCRIPTION	by	app.
1	12.83	UP DATED	BVH	JLC

elf
aquitaine
norge a/s
p.o. box 168
4001 Stavanger



FRIGG FIELD





Job no.	Installation CDP 1	System UNDERWATER
Scale 1:20	FREE LOCK PIPE END CELL D	GD4 LEVEL G
Dwgr. no. FF 91.36.35.1370	1	Sheet

Contractor JVD 1029.40.40.

CDP 1 AS BUILT DRAWINGS

REFERENCE DRAWING LIST FOR:

[illegible]

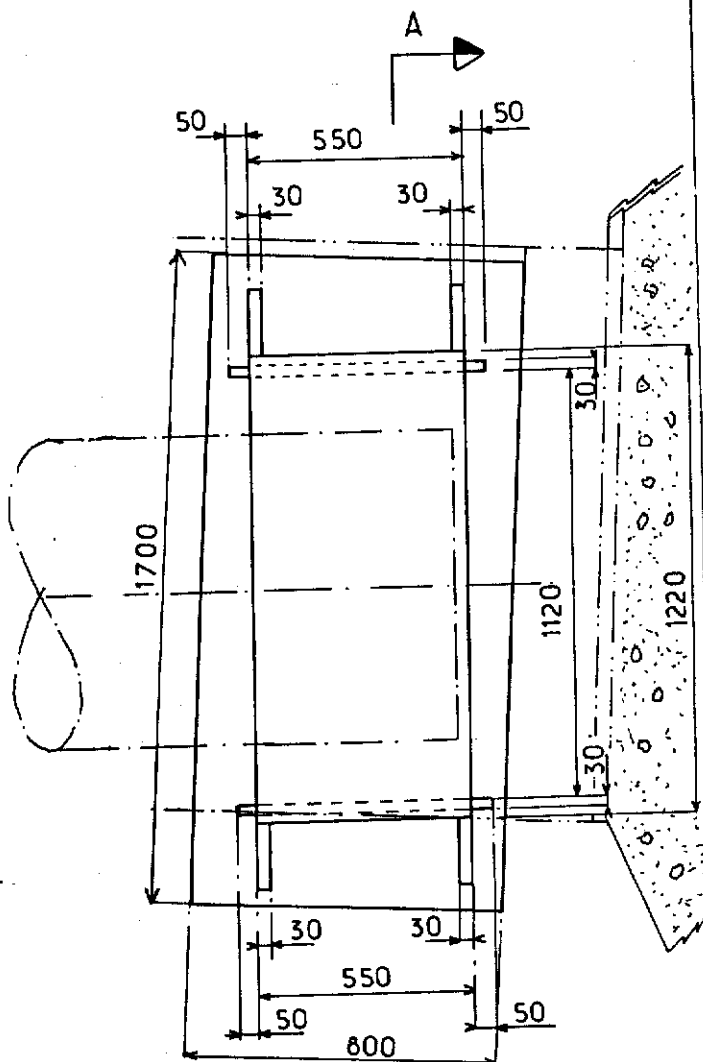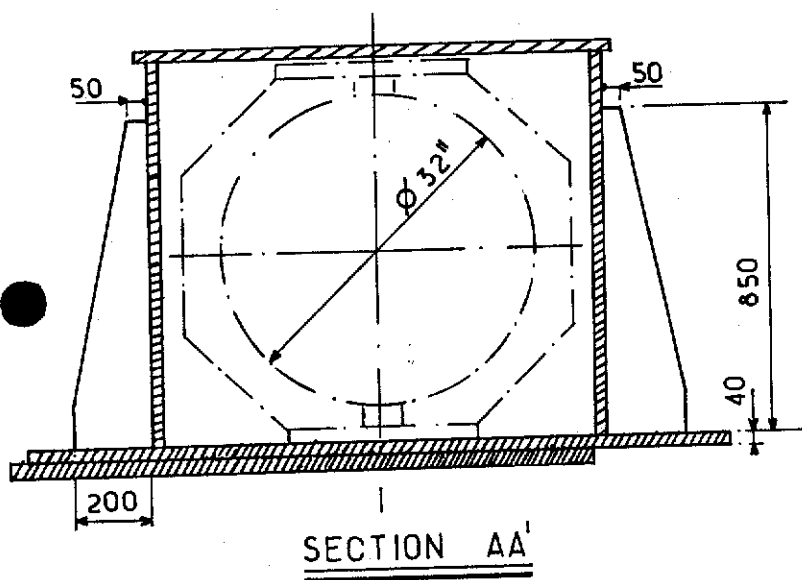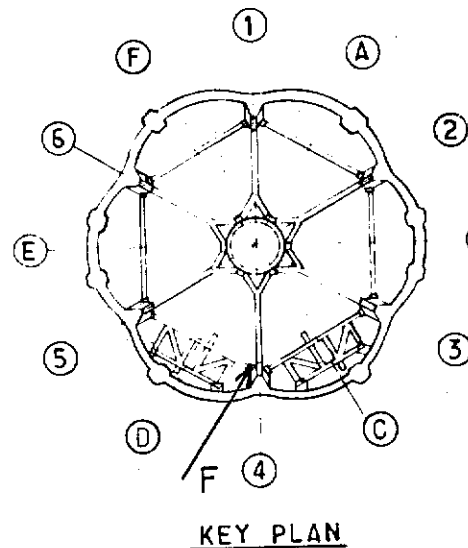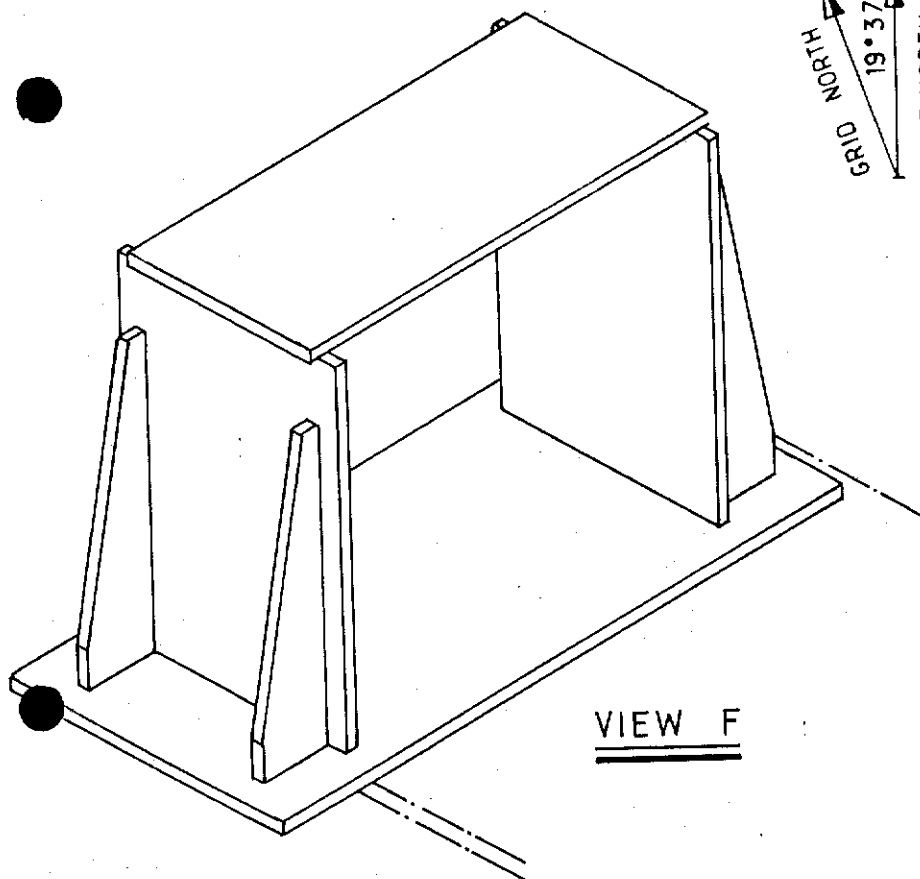

NOTES

FOR LOCATION SEE SK FF. 91.36.35.1355.
FOR DETAIL OF FREE LOCK PIPE END SEE SK FF. 91.36.35.1369.

					elf aquitaine norge a/s p.o.box 168 4001 Stavanger	 elf FRIGG FIELD	Job no.	Installation CDP 1	System UNDERWATER	
1	12.83	UP DATED	BVH	/LC			Scale 1:20	BOX FOR FREE LOCK CELL D LEVEL G	GD1	
Rev.	Date	DESCRIPTION	by	app.			Dwgr.no	FF 91.36.35.1371	1	
Contractor JVD 1029_40.41										


CDP 1 AS BUILT DRAWINGS

REFERENCE DRAWING LIST FOR:


[illegible]

						elf aquitaine norge a/s p.o.box 168 4001 Stavanger	 elf	Job no.	Installation CDP 1	System UNDERWATER	
								Scale	BOXE FOR FREE LOCK GD1		
Rev.	Date	DESCRIPTION	by	app.				Dwgr. no.	FF	1371	Rev.
Contractor						4001 Stavanger	FRIGG FIELD				


HURD NORTH
19° 37'
PLAT. NORTH

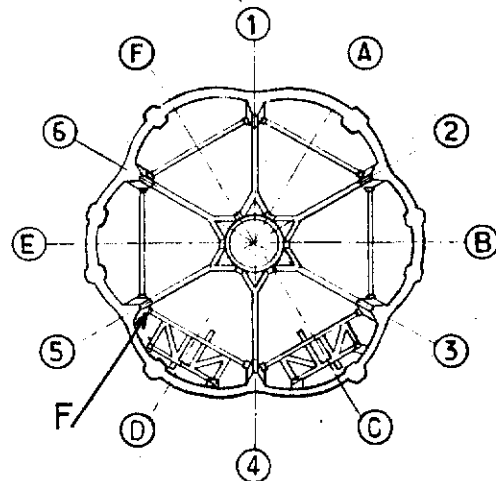


KEY PLAN

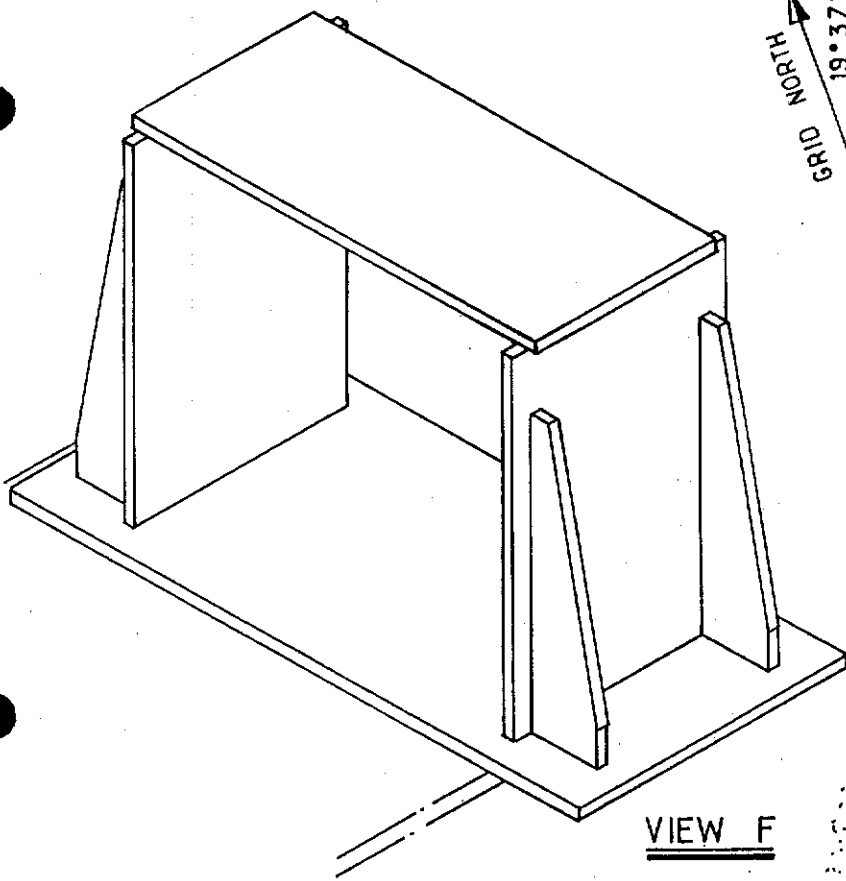

VIEW F

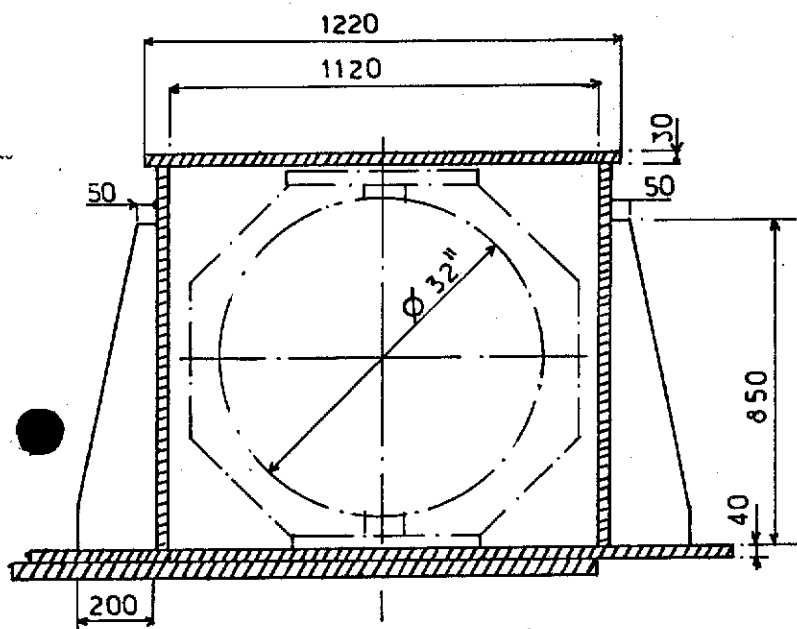

SECTION AA'

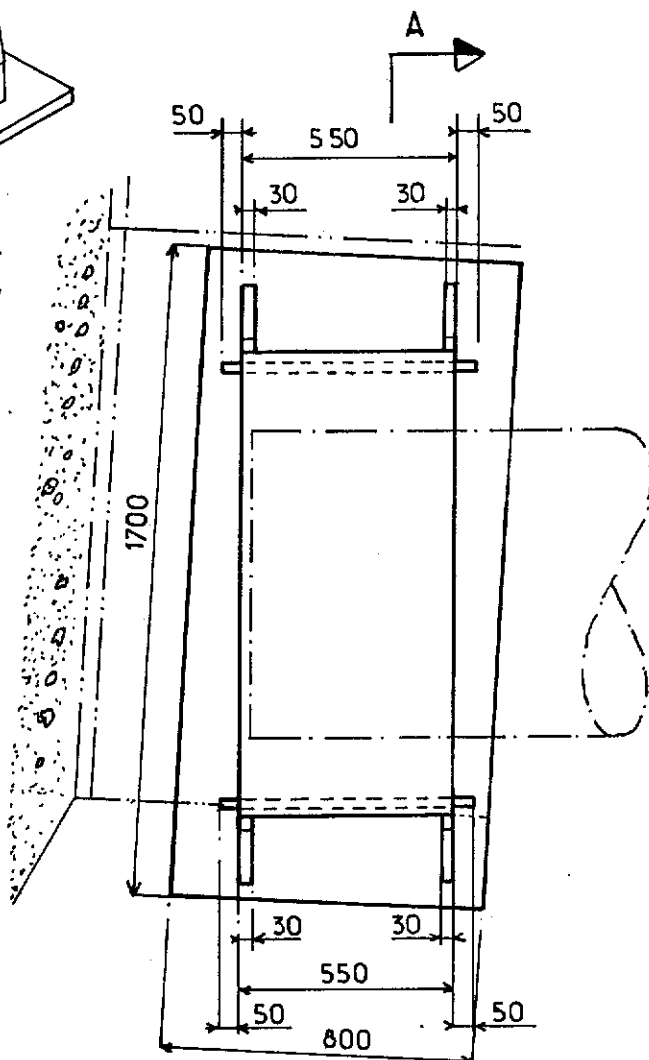

NOTES

FOR LOCATION SEE SK FF. 91.36.35.1355

FOR DETAIL OF FREE LOCK PIPE END SEE SK . FF . 91.36.35.1370 .

				elf aquitaine norge a/s p.o.box 168 4001 Stavanger	 elf FRIGG FIELD	Job no.	Installation CDP 1	System UNDERWATER
1	12.83	UP DATED	BVH/lac			Scale 1:20	BOX FOR FREE LOCK CELL D LEVEL G	GD4
Rev.	Date	DESCRIPTION	by	app.		Dwgr. no.	FF 91-36-35-1372	Rev. 1
Contractor JVD 1029-40.42.								Sheet


CDP 1 AS BUILT DRAWINGS

REFERENCE DRAWING LIST FOR:


[illegible][illegible]

							Job no.	Installation CDP 1	System UNDERWATER	
							Scale	BOXE FOR FREE Lock GD4		
Rev.	Date	DESCRIPTION	by	app.			Dwgr. no.		Rev.	Sheet
Contractor							FF	1372		/

GRID NORTH
19° 37'
PLAT NORTH

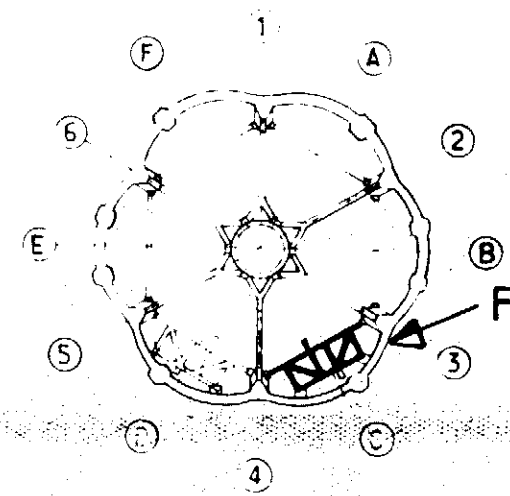

KEY PLAN

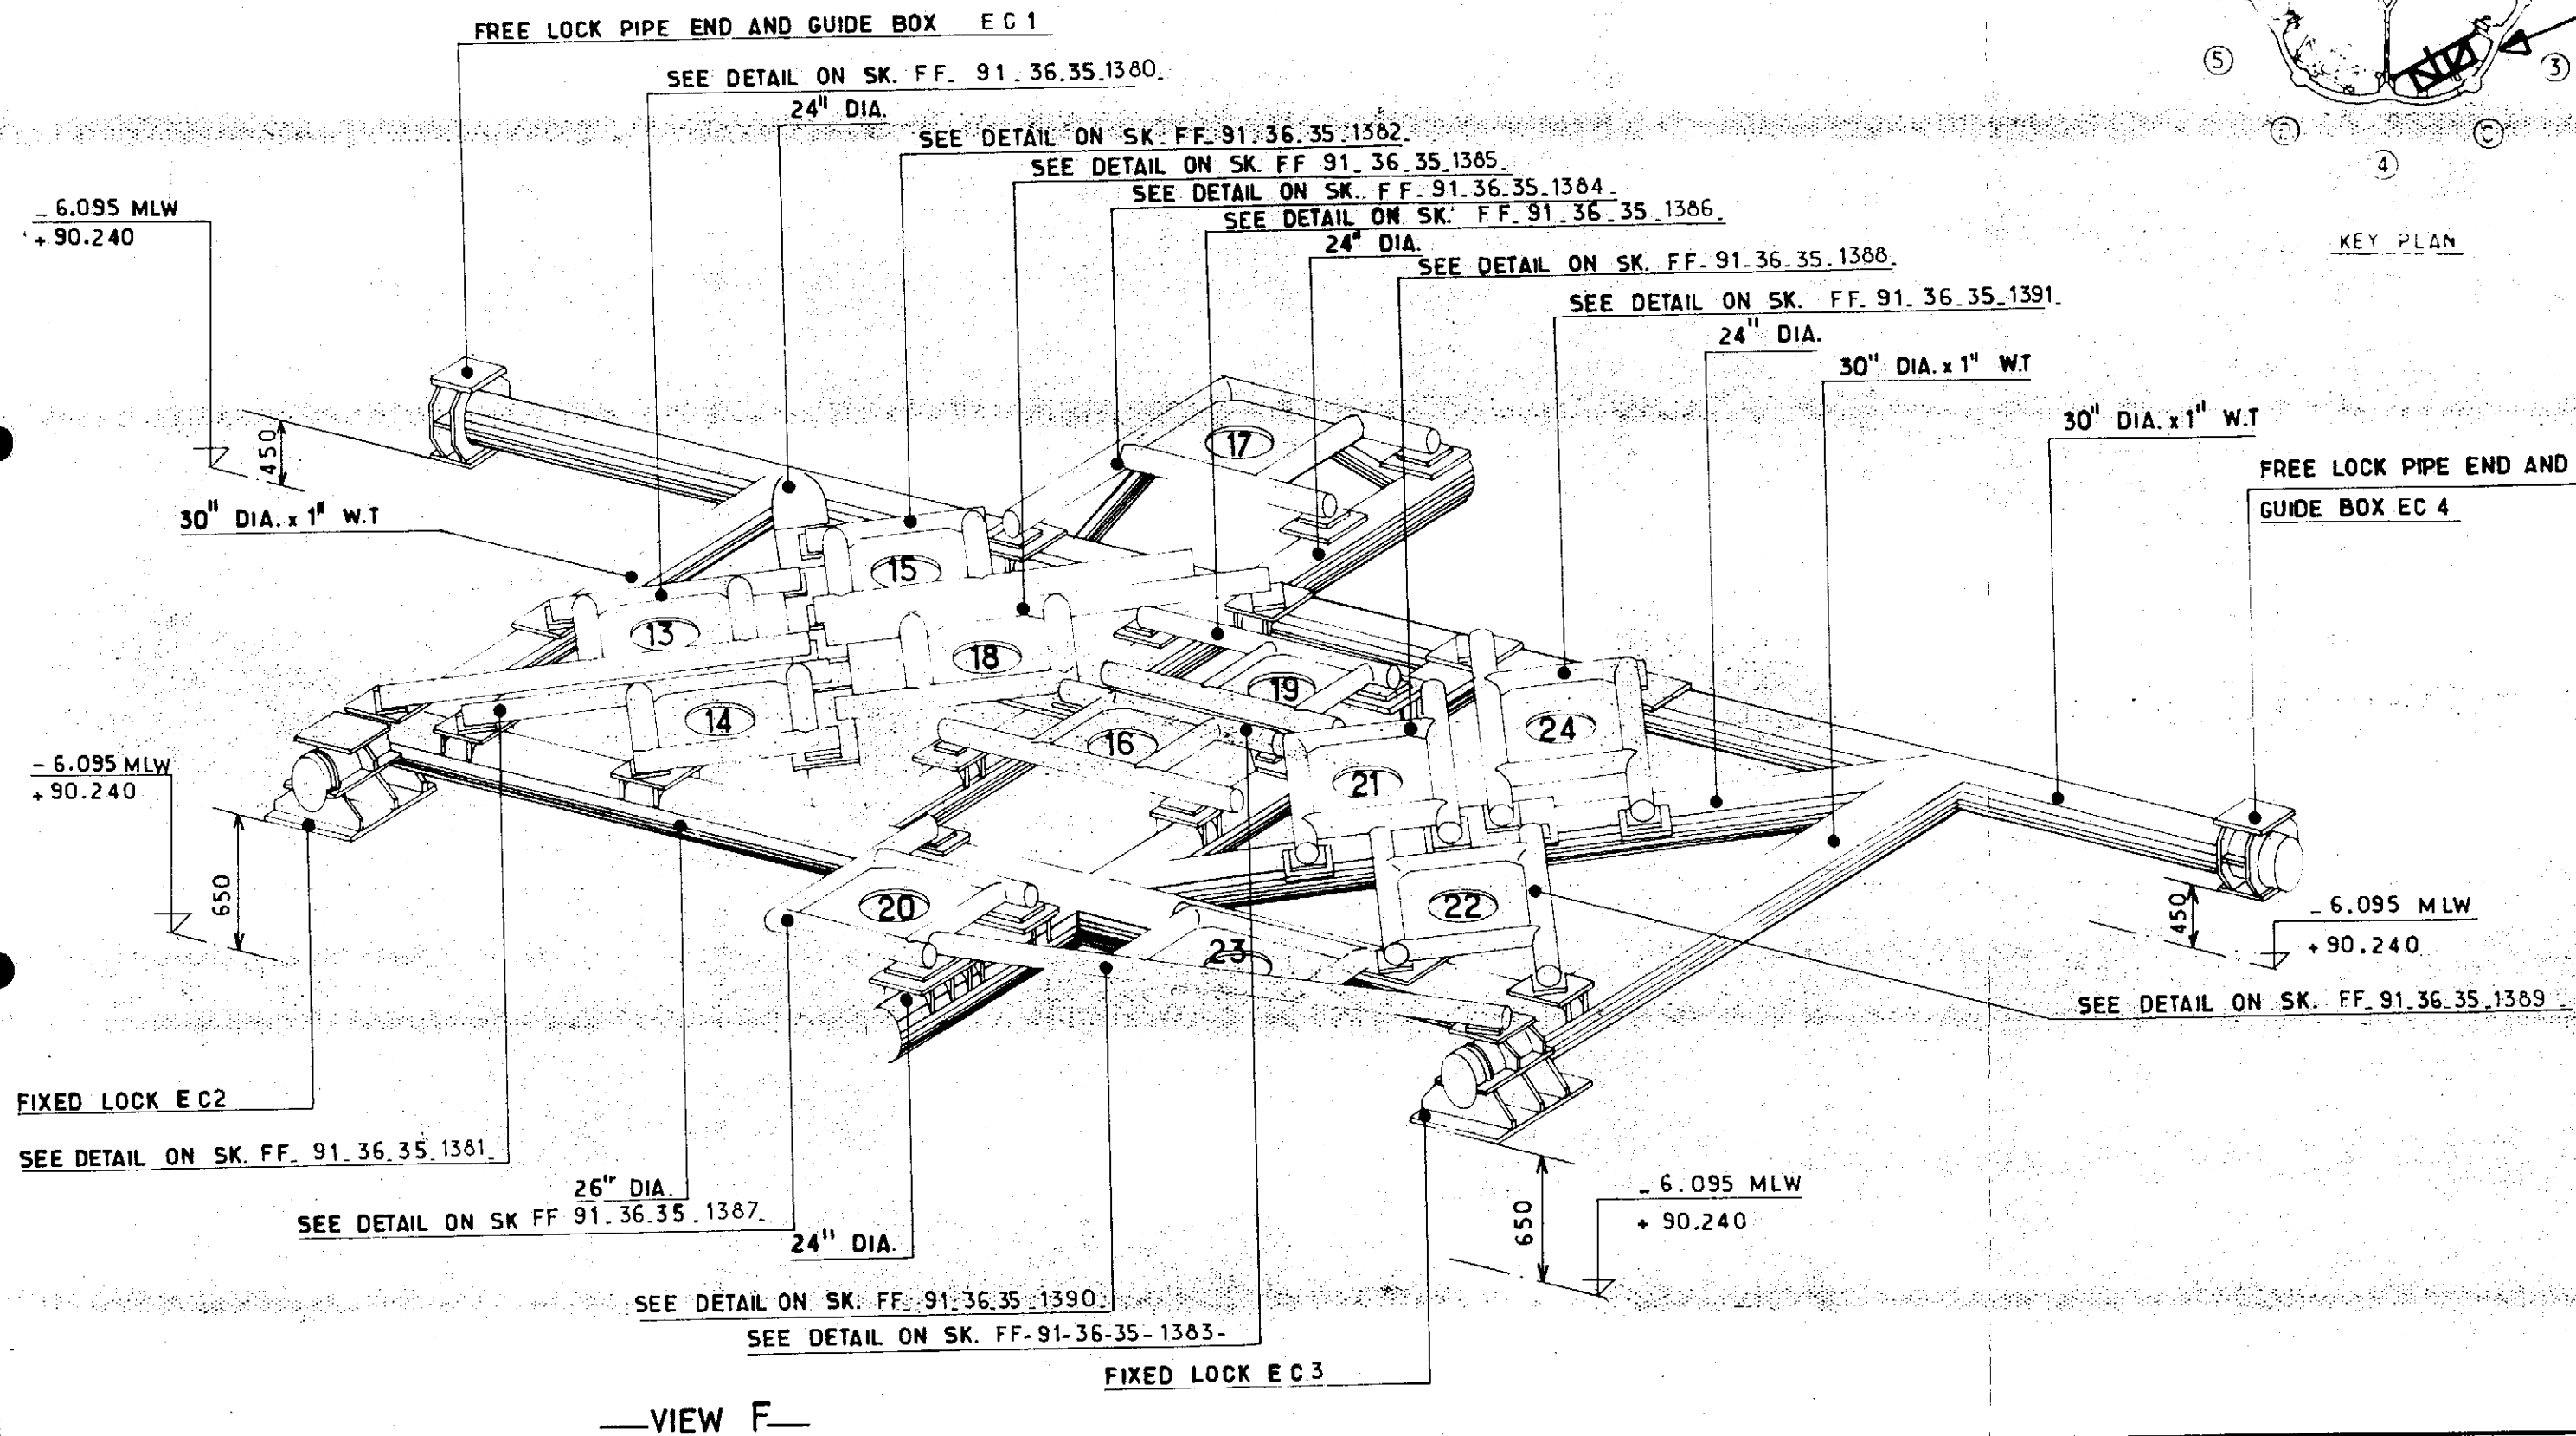

—VIEW F—

NOTES

FOR FREE LOCK PIPE ENDS AND GUIDE BOXES SEE SK FF 91-36-35-1392/1393/1394/1395.
FOR REPAIR OF GUIDE FRAME SUPPORTS, SEE FF 91 36 35 1396



					 elf	Job no.	Installation CDP 1	System UNDERWATER	
2	21.286	NOTE ADDED	T.B.			Scale —	GENERAL VIEW OF CONDUCTOR GUIDE FRAME CELL C LEVEL E		
1	12.83	UP DATED	BVH	/IC		Dwgr no. FF_91_36_35_1378	Rev. 2	Sheet /	
Rev.	Date	DESCRIPTION	by	app.					
Contractor JVD_1029_40_48					p.o. box 168 4001 Stavanger				

CDP 1 AS BUILT DRAWINGS

REFERENCE DRAWING LIST FOR: CONDUCTOR GUIDE FRAME

[illegible][illegible]

					elf aquitaine norge a/s p.o.box 168 4001 Stavanger	 elf	Job no.	Installation CDP 1	System UNDERWATER		
							Scale				
Rev.	Date	DESCRIPTION	by	app.			Dwgr. no.	FF — — 1378		Rev.	Sheet
Contractor					FRIGG FIELD						

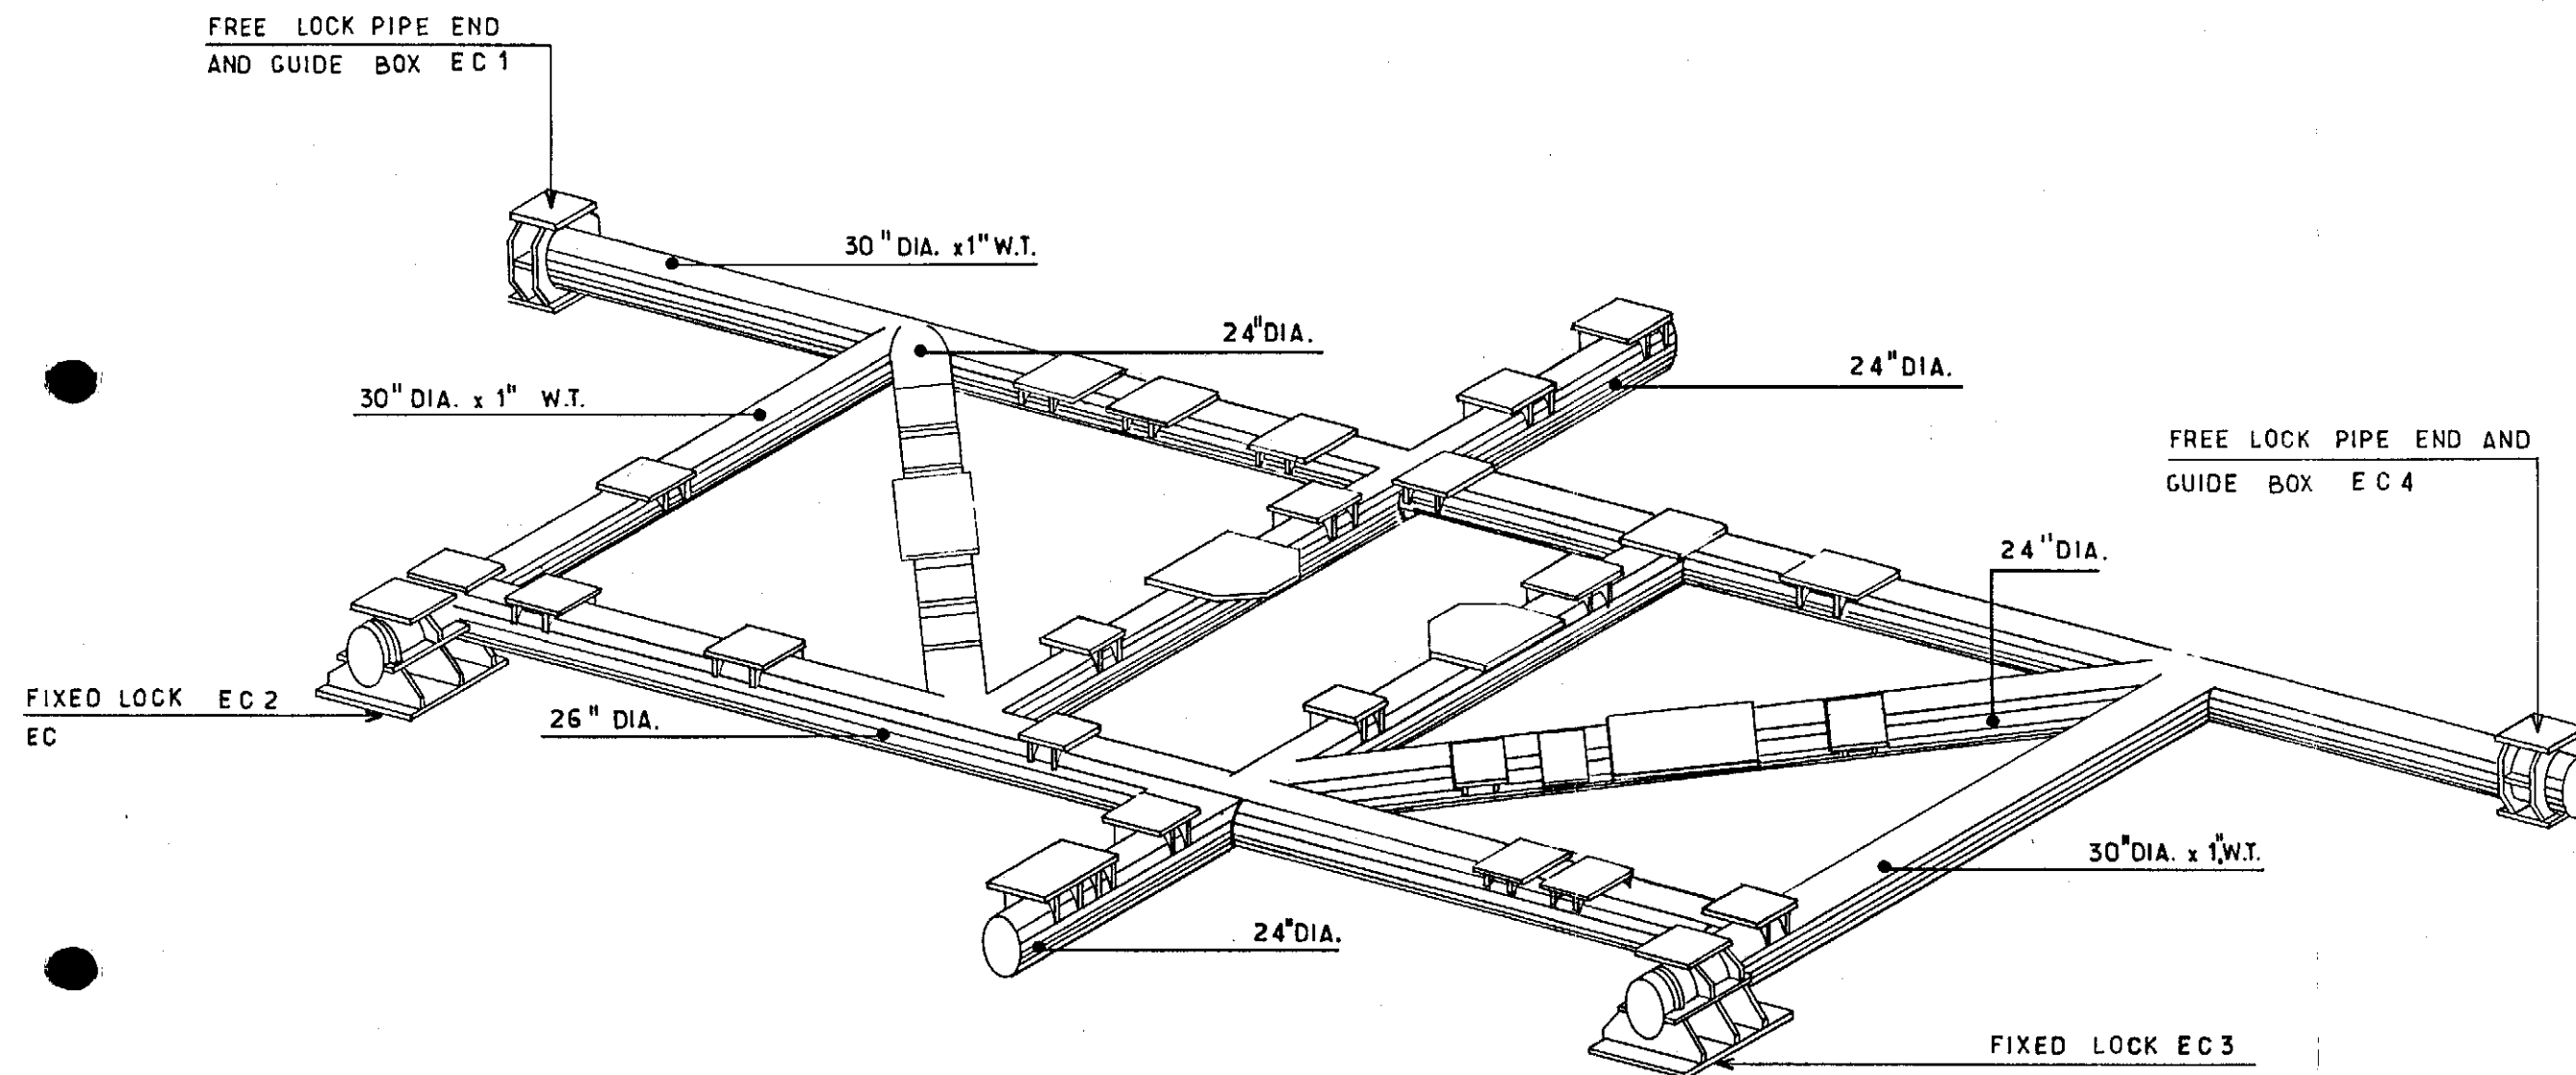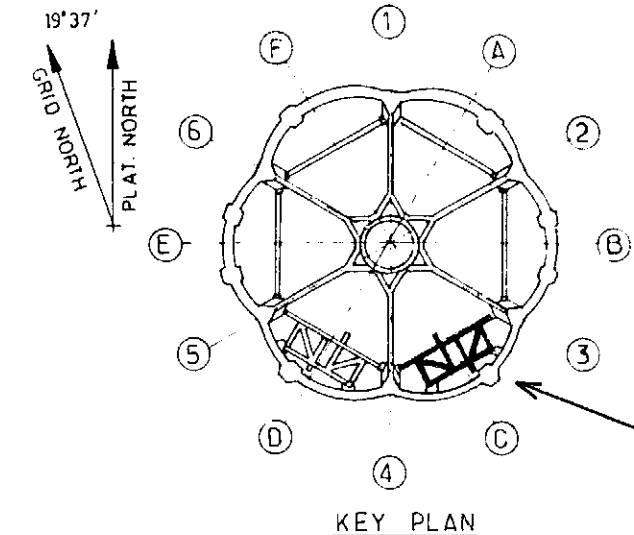

NOTES

FOR SECONDARY FRAME DETAILS SEE SK FF 91-36-35-1380 TO FF 91-36-35-1391
 FOR FREE LOCK PIPE ENDS AND GUIDE BOXES SEE SK FF 91-36-35-1392 / 1393 / 1394 / 1395.


elf aquitaine norge a/s		Job no.	Installation CDP 1	System UNDERWATER
p.o. box 168		Scale	GENERAL VIEW OF SECONDARY FRAME SUPPORT CELL C LEVEL E	
4001 Stavanger		Dwgr. no.	FF 91-36-35-1379	1
Contractor JVD 1029-40-49		FRIGG FIELD		
1	12.83	UP DATED	BY	JLC
Rev.	Date	DESCRIPTION	by	app.

CDP 1 AS BUILT DRAWINGS






REFERENCE DRAWING LIST FOR:

[illegible][illegible]

					Job no.	Installation	System	
					Scale	CDP 1	UNDERWATER	
Rev. Date DESCRIPTION by app.					Dwgr. no.			Rev.
Contractor					FF	1379		Sheet

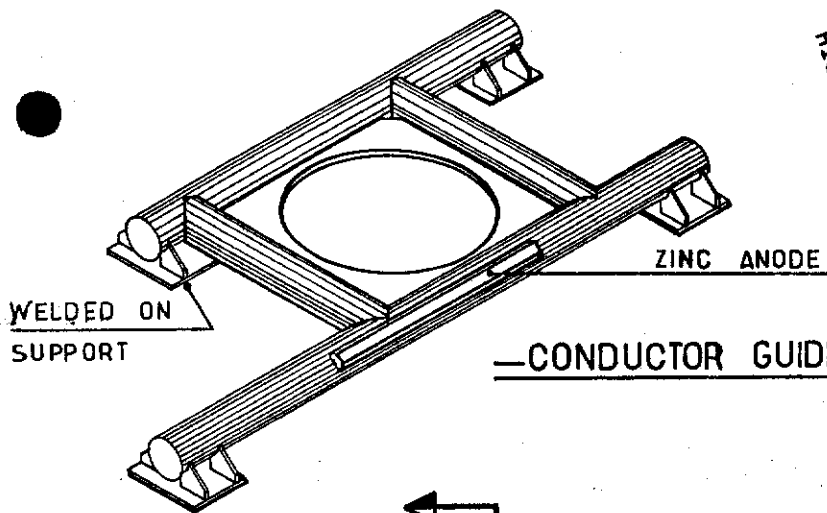

GRID NORTH
19°37'
PLAT. NORTH

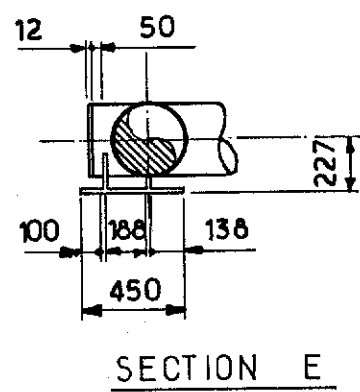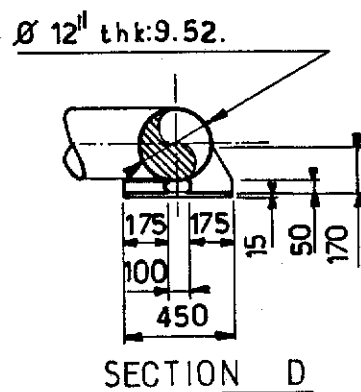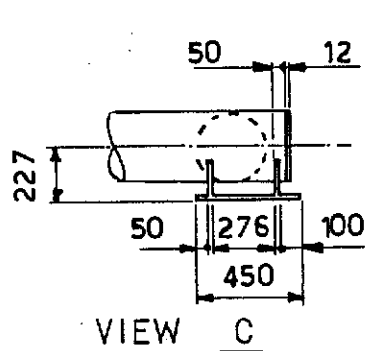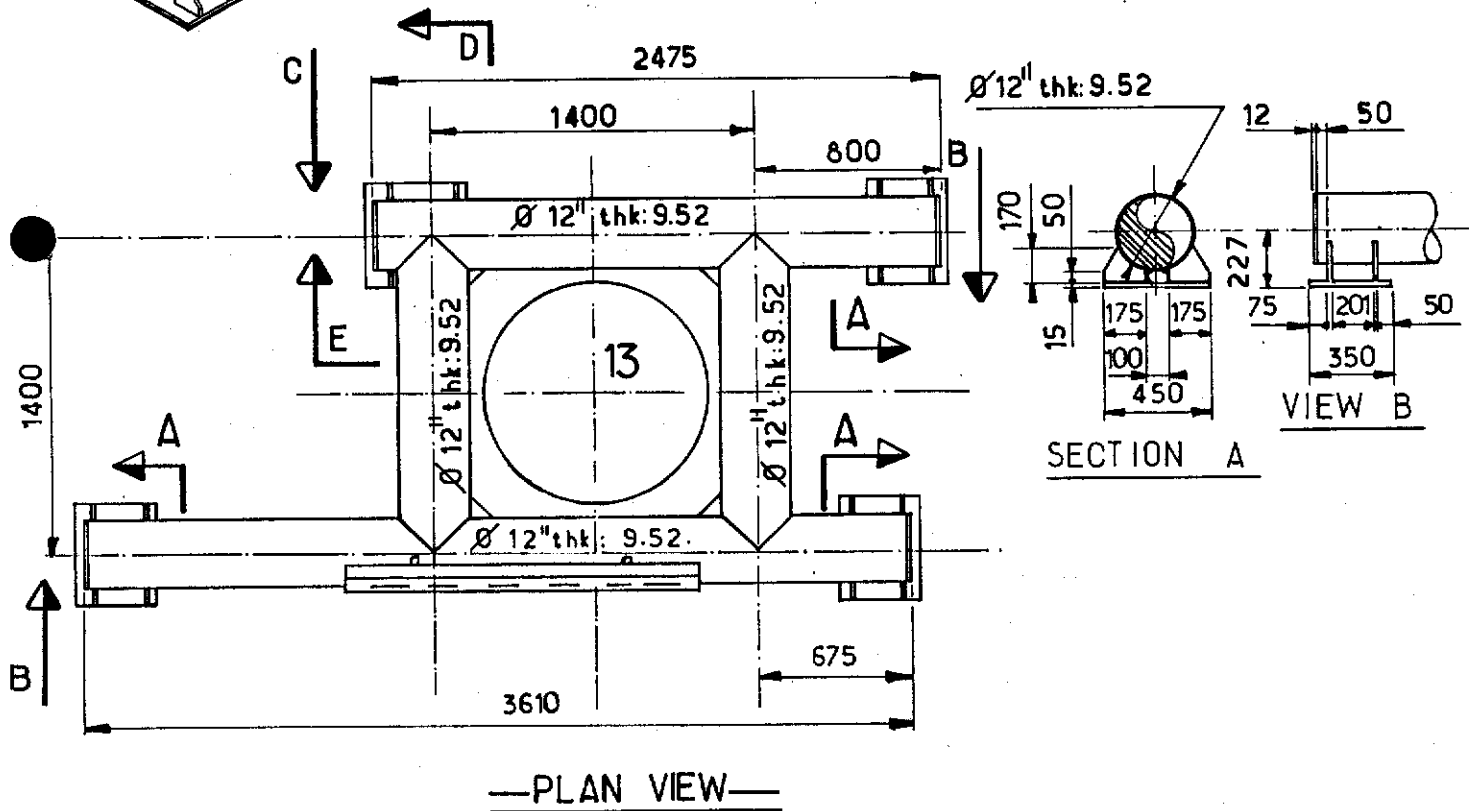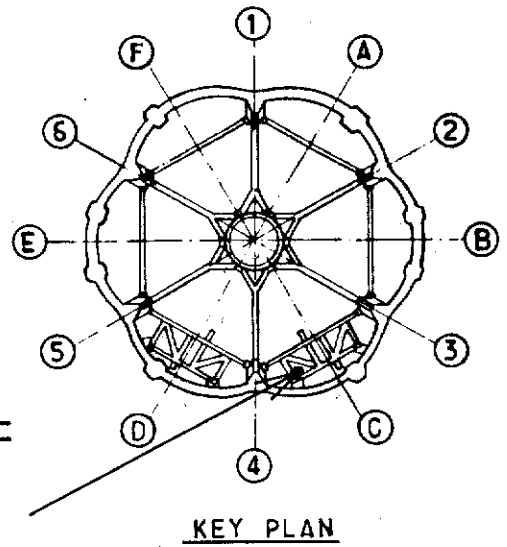

NOTES

FOR LOCATION SEE SK FF 91-36-35-1378
 FOR CONDUCTOR SLEEVE SEE SK FF-91-36-35-1491
 FOR ZINC ANODE SEE SK FF 91-36-35-1587


elf aquitaine norge a/s p.o. box 168 4001 Stavanger				Job no. Installation CDP 1		System UNDERWATER	
1	12,83	UP DATED	BVH/JLC	Scale 1:33		CONDUCTOR GUIDE N°13 CELL C SECONDARY FRAME LEVEL E	
Contractor JVD 1029_40_50				Dwgr. no. FF 91.36.35.1380		Rev. 1	Sheet /

CDP 1 AS BUILT DRAWINGS



REFERENCE DRAWING LIST FOR:

[illegible][illegible]


						 elf	Job no.	Installation CDP 1	System UNDERWATER	
							Scale			
Rev.	Date	DESCRIPTION	by	app.			Dwgr. no.	FF 1380	Rev.	Chg.
Contractor					4001 Stavanger	FRIGG FIELD				

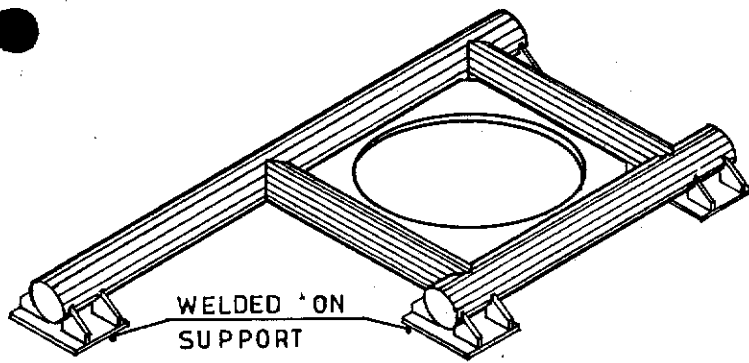


— CONDUCTOR GUIDE N°14 —

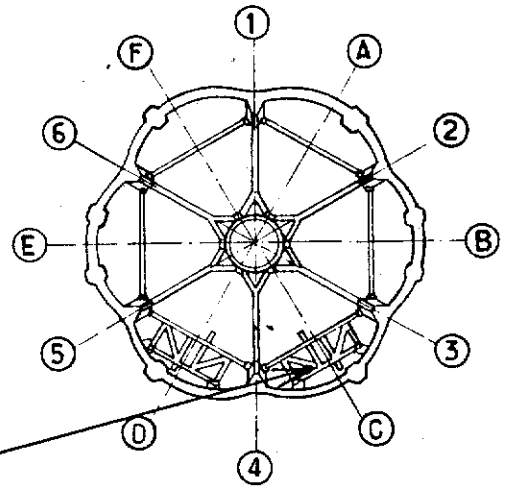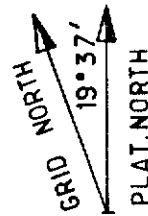


KEY PLAN

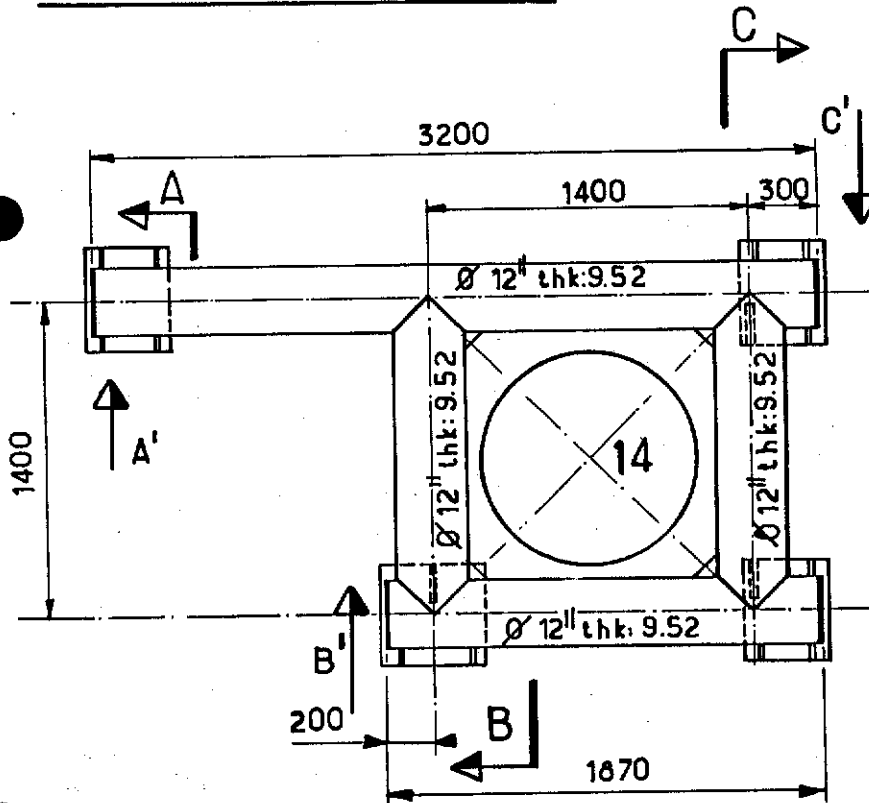

— PLAN VIEW —

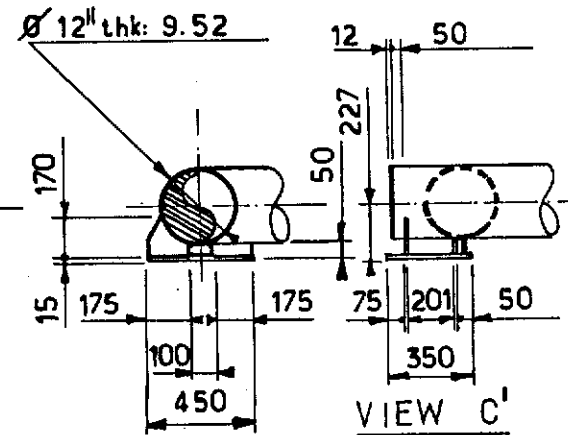


SECTION C

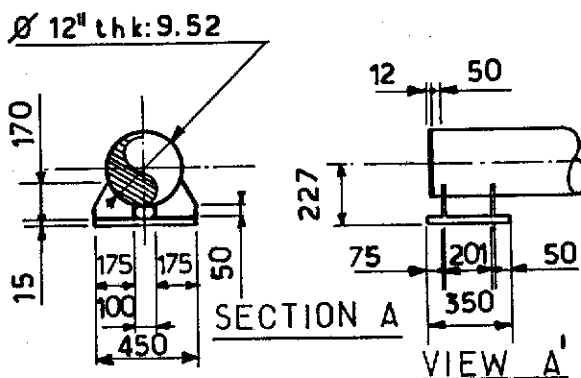

SECTION A

VIEW A'

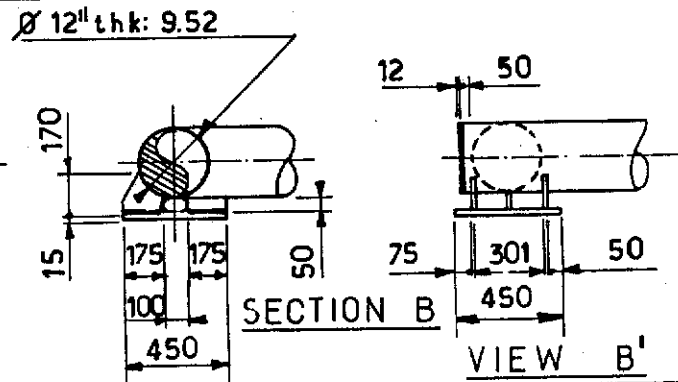

SECTION B

VIEW B'

NOTES

FOR LOCATION SEE SK FF. 91.36.35. 1378

FOR CONDUCTOR SLEEVE SK FF. 91.36.35.1491.


				elf aquitaine norge a/s		Job no.	Installation CDP 1	System UNDERWATER
1	12.83	UP DATED	BVH/LLC	p.o.box 168		Scale 1:33	CONDUCTOR GUIDE N°14 CELL C	
Rev.	Date	DESCRIPTION	by	app.		Dwgr. no.	SECONDARY FRAME LEVEL E	
Contractor JVD 1029_40.51.				4001 Stavanger		FF-91.36.35.1381		Rev. 1
				FRIGG FIELD				Sheet

CDP 1 AS BUILT DRAWINGS

REFERENCE DRAWING LIST FOR:


[illegible][illegible]

						elf aquitaine norge a/s p.o.box 168 4001 Stavanger	 elf	Job no.	Installation CDP 1	System UNDERWATER
								Scale		
Rev.	Date	DESCRIPTION	by	app.				Dwgr. no.	FF — — 1381	Hrs.
Contractor						FRIGG FIELD				

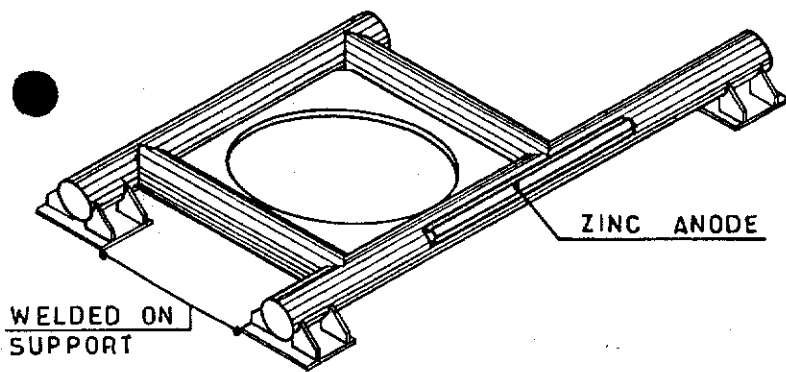


—CONDUCTOR GUIDE N°15—

GRID NORTH
19°37'
PLAT. NORTH

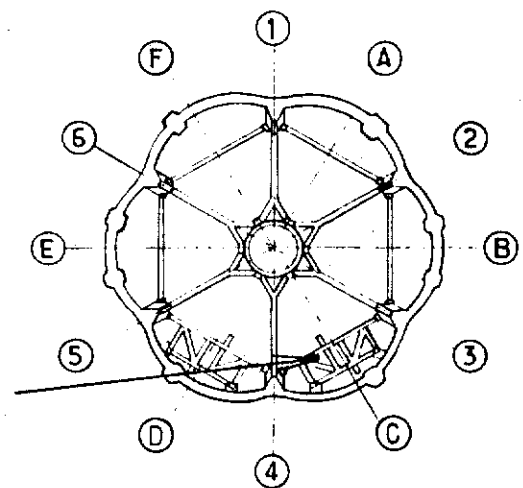


KEY PLAN

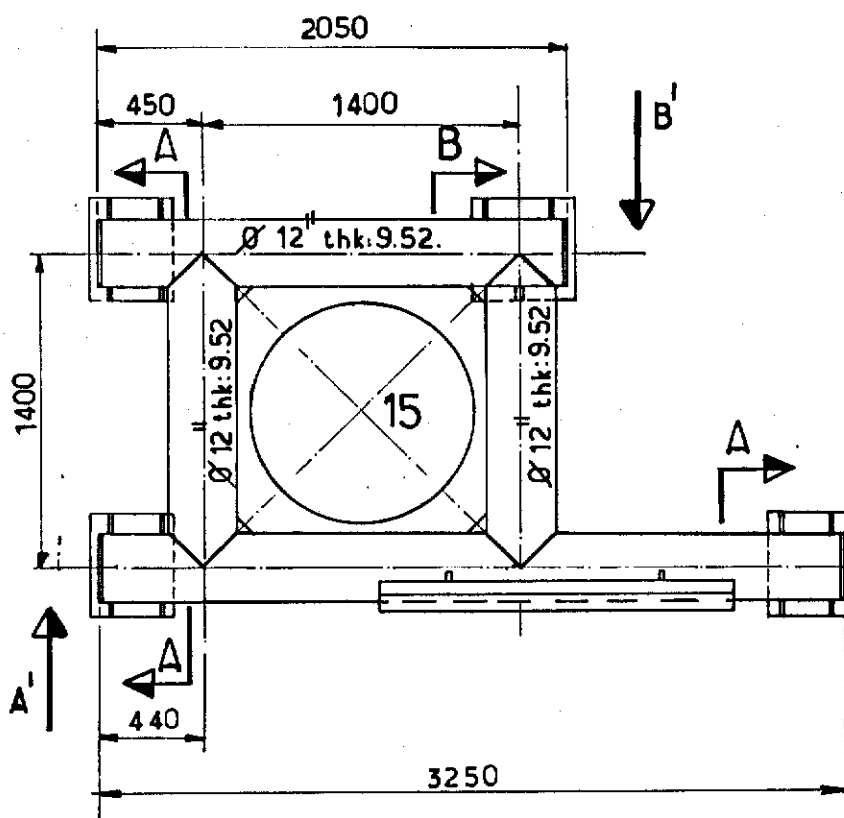

—PLAN VIEW—

—SECTION A—

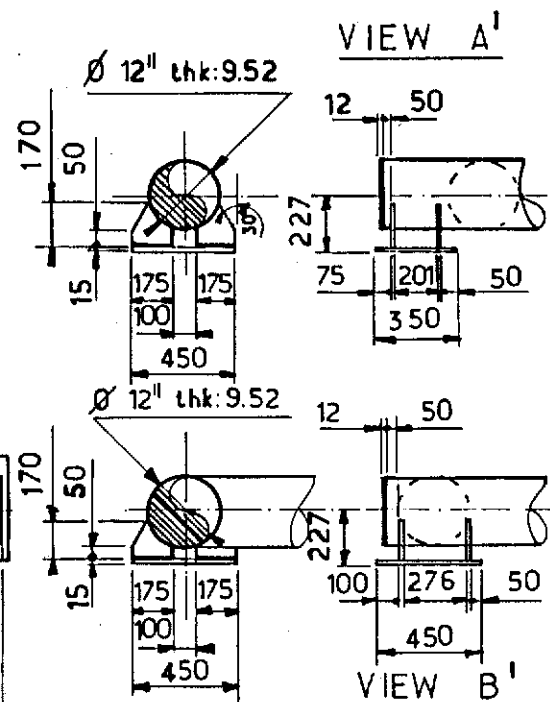

—SECTION B—

NOTES


FOR LOCATION SEE SK FF 91.36.35.1378
FOR CONDUCTOR SLEEVE SEE SK FF.91.36.35.1491
FOR ZINC ANODE SEE SK FF.91.36.35.1587

				elf aquitaine norge a/s		Job no.	Installation CDP 1	System UNDERWATER
1	1283	UP DATED	BVH/jlc	p.o.box 168		Scale 1:33	CONDUCTOR GUIDE N°15 CELL C	
Rev.	Date	DESCRIPTION	by	app.		Dwgr. no.	Rev	Sheet
Contractor JVD 1029_40_52_				4001 Stavanger		FF 91.36.35.1382	1	
					FRIGG FIELD			



CDP 1 AS BUILT DRAWINGS

● REFERENCE DRAWING LIST FOR:


[illegible][illegible][illegible]

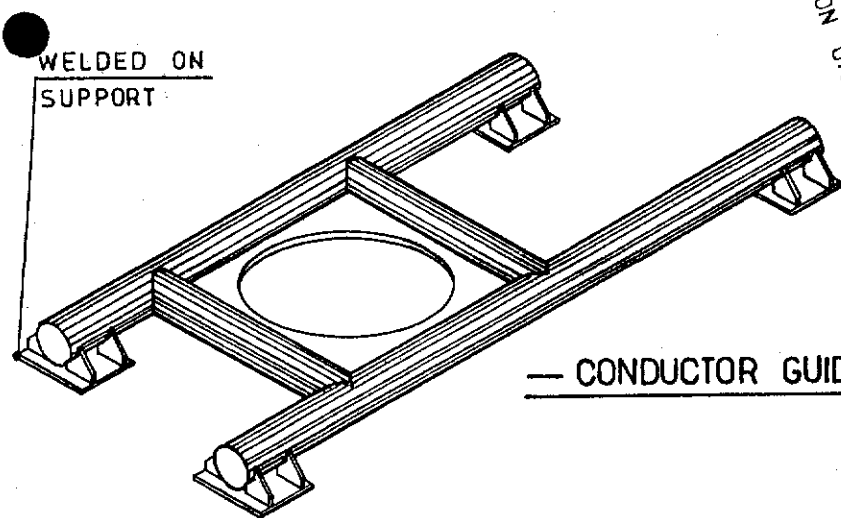

— CONDUCTOR GUIDE N°16 —

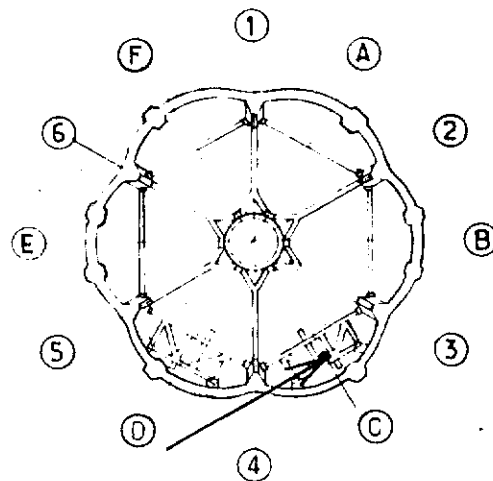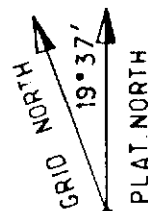

KEY PLAN

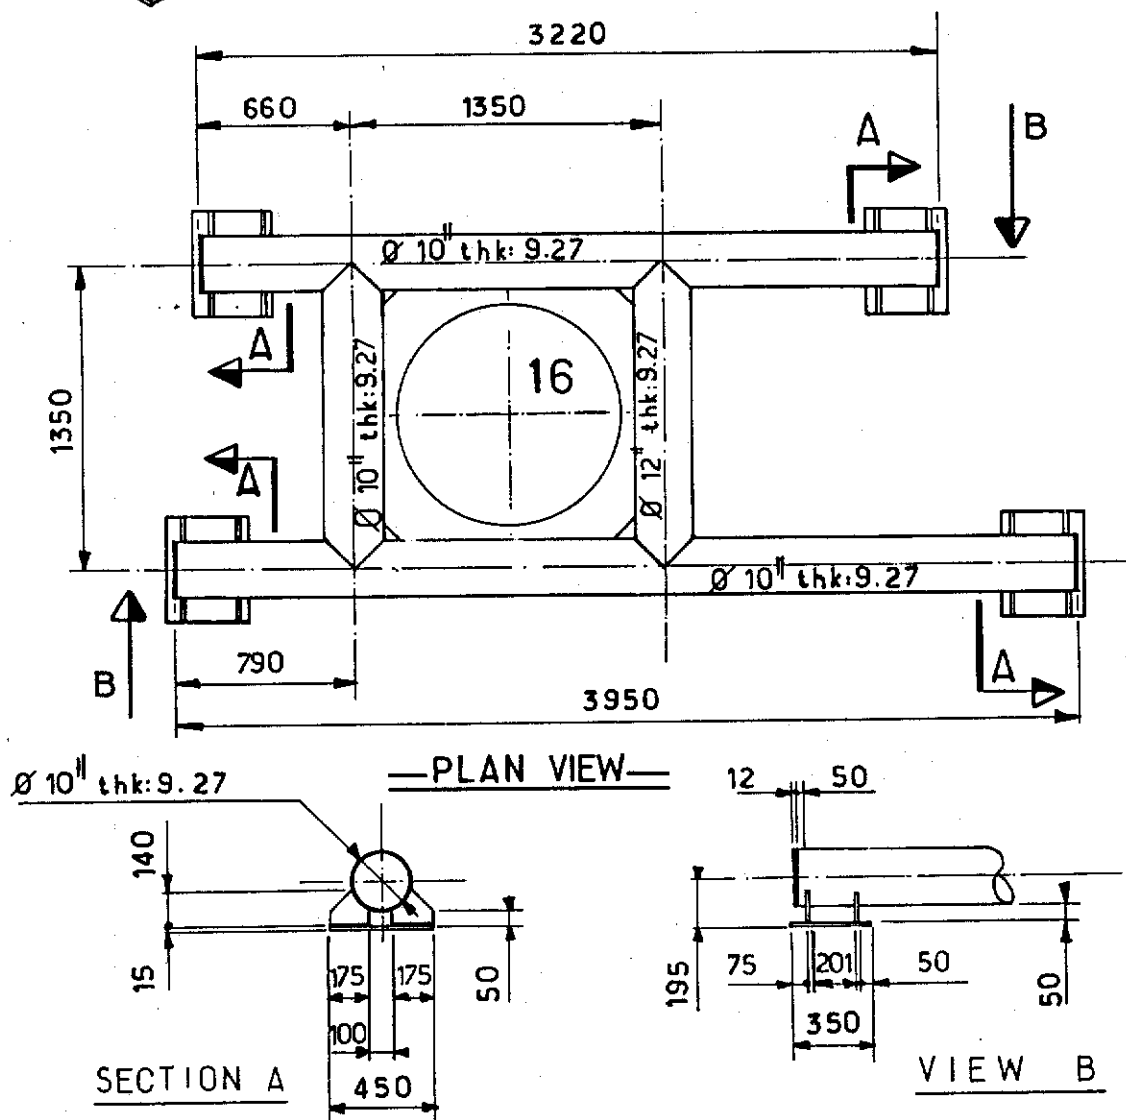

NOTES

FOR LOCATION SEE SK FF 91.36.35.1378
FOR CONDUCTOR SLEEVE SEE SK FF.91.36.35.1491.

						elf aquitaine norge a/s p.o.box 168 4001 Stavanger	 elf	Job no.	Installation CDP 1	System UNDERWATER		
1	1283	UP DATED	BVH	JLC				Scale 1:33	CONDUCTOR GUIDE N°16 CELL C SECONDARY FRAME LEVEL E			
Rev.	Date	DESCRIPTION	by	app.				Dwgr. no.	FF 91_36_35_1383_		No. 1	Sheet /
Contractor JVD 1029_40_53_						FRIGG FIELD						


CDP 1 AS BUILT DRAWINGS

REFERENCE DRAWING LIST FOR:


[illegible][illegible]

						elf aquitaine norge a/s p.o.box 168 4001 Stavanger	 elf	Job no.	Installation CDP 1	System UNDERWATER		
								Scale				
Rev.	Date	DESCRIPTION	by	app.				Dwgr. no.	FF — — 1383		Rev.	Drawn
Contractor						FRIGG FIELD						

WELDED ON
SUPPORT

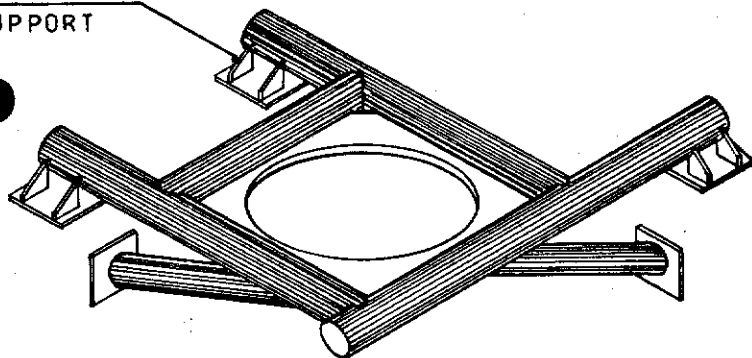


GRID NORTH
19°37'
PLAT. NORTH

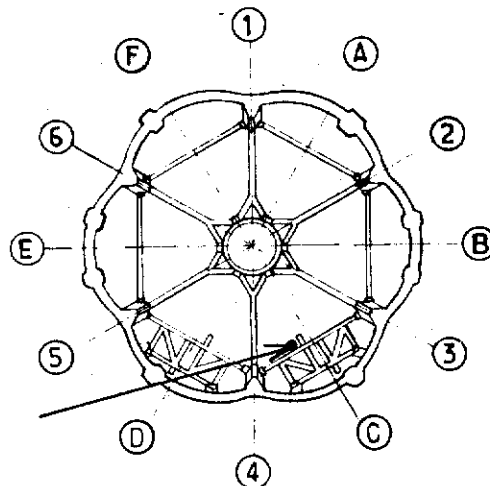


KEY PLAN

— CONDUCTOR GUIDE N°17 —


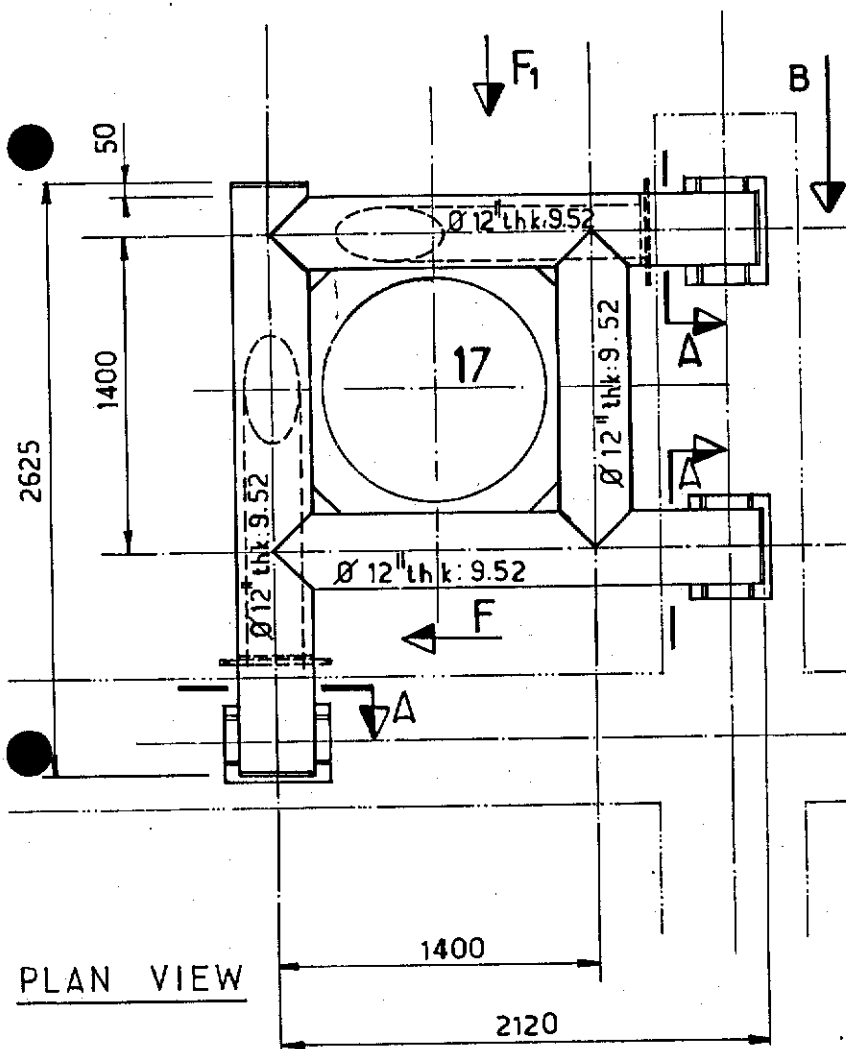


PLAN VIEW

SECTION A

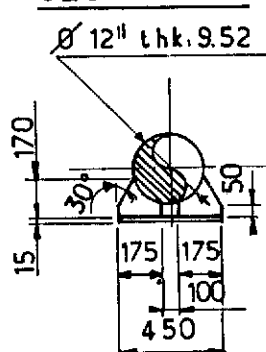

VIEW B

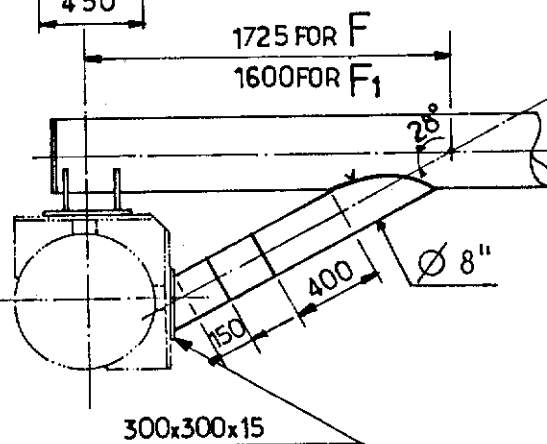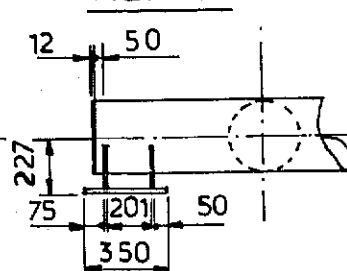

—VIEW F AND F1—

NOTES

FOR LOCATION SEE SK FF.91.36.35.1378
FOR CONDUCTOR SLEEVE SEE SK FF 91.36.35.1491


						elf aquitaine norge a/s p.o.box 168 4001 Stavanger	 elf	Job no.	Installation CDP 1	System UNDERWATER	
1	12,83	UP DATED	BVH	JJC	Scale 1:33			CONDUCTOR GUIDE N°17 CELL C SECONDARY FRAME		LEVEL E	
Rev.	Date	DESCRIPTION	by	app.	Dwgr. no.			FF 91_36_35_1384_		Rev 1	Sheet /
Contractor JVD 1029_40_54_						FRIGG FIELD					

CDP 1 AS BUILT DRAWINGS



REFERENCE DRAWING LIST FOR:

[illegible][illegible]


						elf aquitaine norge a/s p.o.box 168 4001 Stavanger	 elf	Job no.	Installation CDP 1	System UNDERWATER
								Scale		
Rev.	Date	DESCRIPTION	by	app.				Dwgr. no.		
Contractor						FRIGG FIELD	FF	— — 1384		

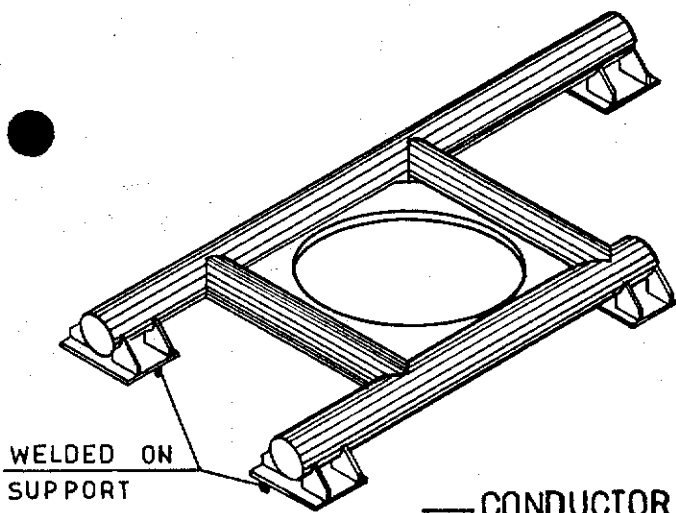



— CONDUCTOR GUIDE N°18 —

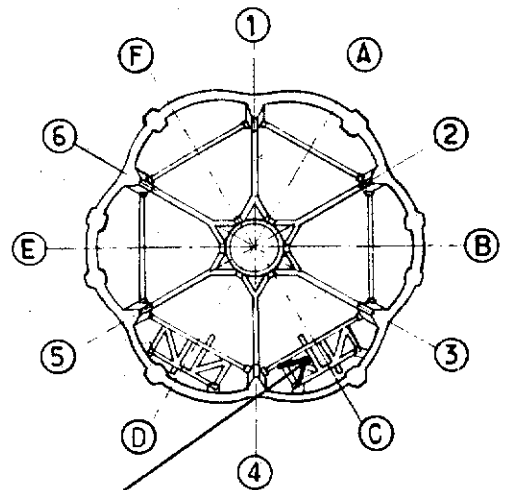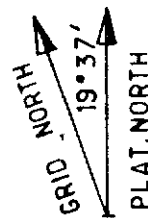

KEY PLAN

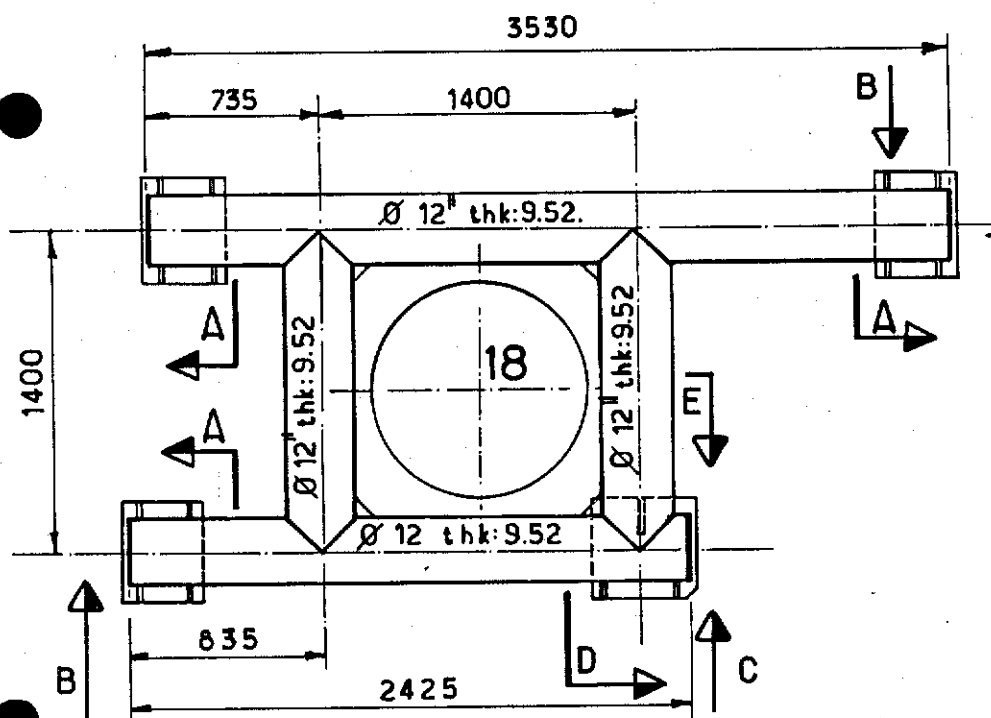

PLAN VIEW

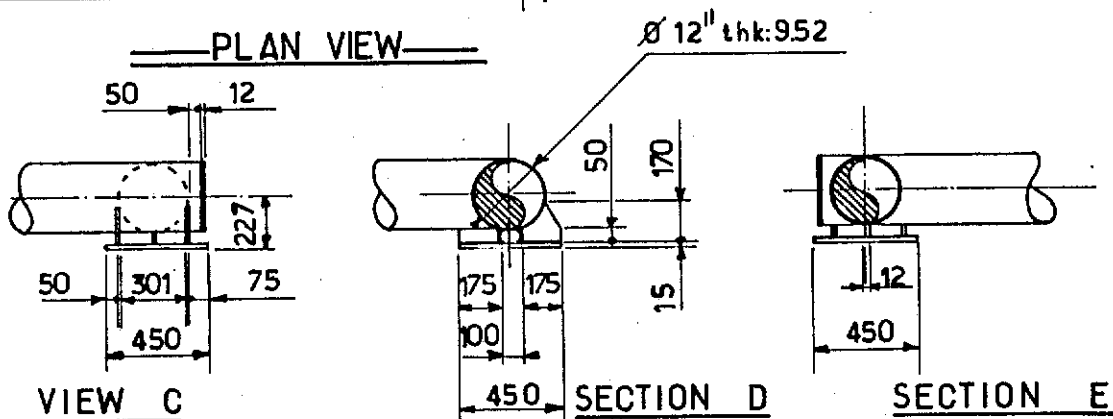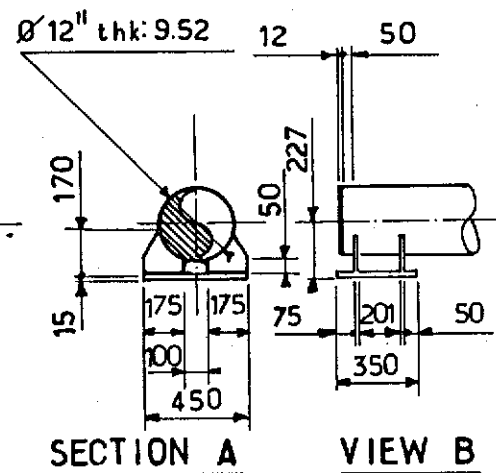

NOTES

FOR LOCATION SEE SK FF 91.36.35.1378.
FOR CONDUCTOR SLEEVE SEE SK FF 91.36.35.1491


						elf aquitaine norge a/s p.o.box 168 4001 Stavanger	 elf	Job no.	Installation CDP 1	System UNDERWATER		
1	12.83	UP DATED	BVH	JLC				Scale 1:33	CONDUCTOR GUIDE N°18 CELL C SECONDARY FRAME LEVEL E			
Rev.	Date	DESCRIPTION	by	app.				Dwgr. no.		Rev.	Sheet	
Contractor JVD 1029-40-55-						4001 Stavanger	FRIGG FIELD	FF 91.36.35.1385			1	/

CDP 1 AS BUILT DRAWINGS

REFERENCE DRAWING LIST FOR:

[illegible]

							Job no.	Installation CDP 1	System UNDERWATER
							Scale		
Rev.	Date	DESCRIPTION	by	app.			Dwgr. no.		
Contractor							FF	1385	
						FRIGG FIELD			

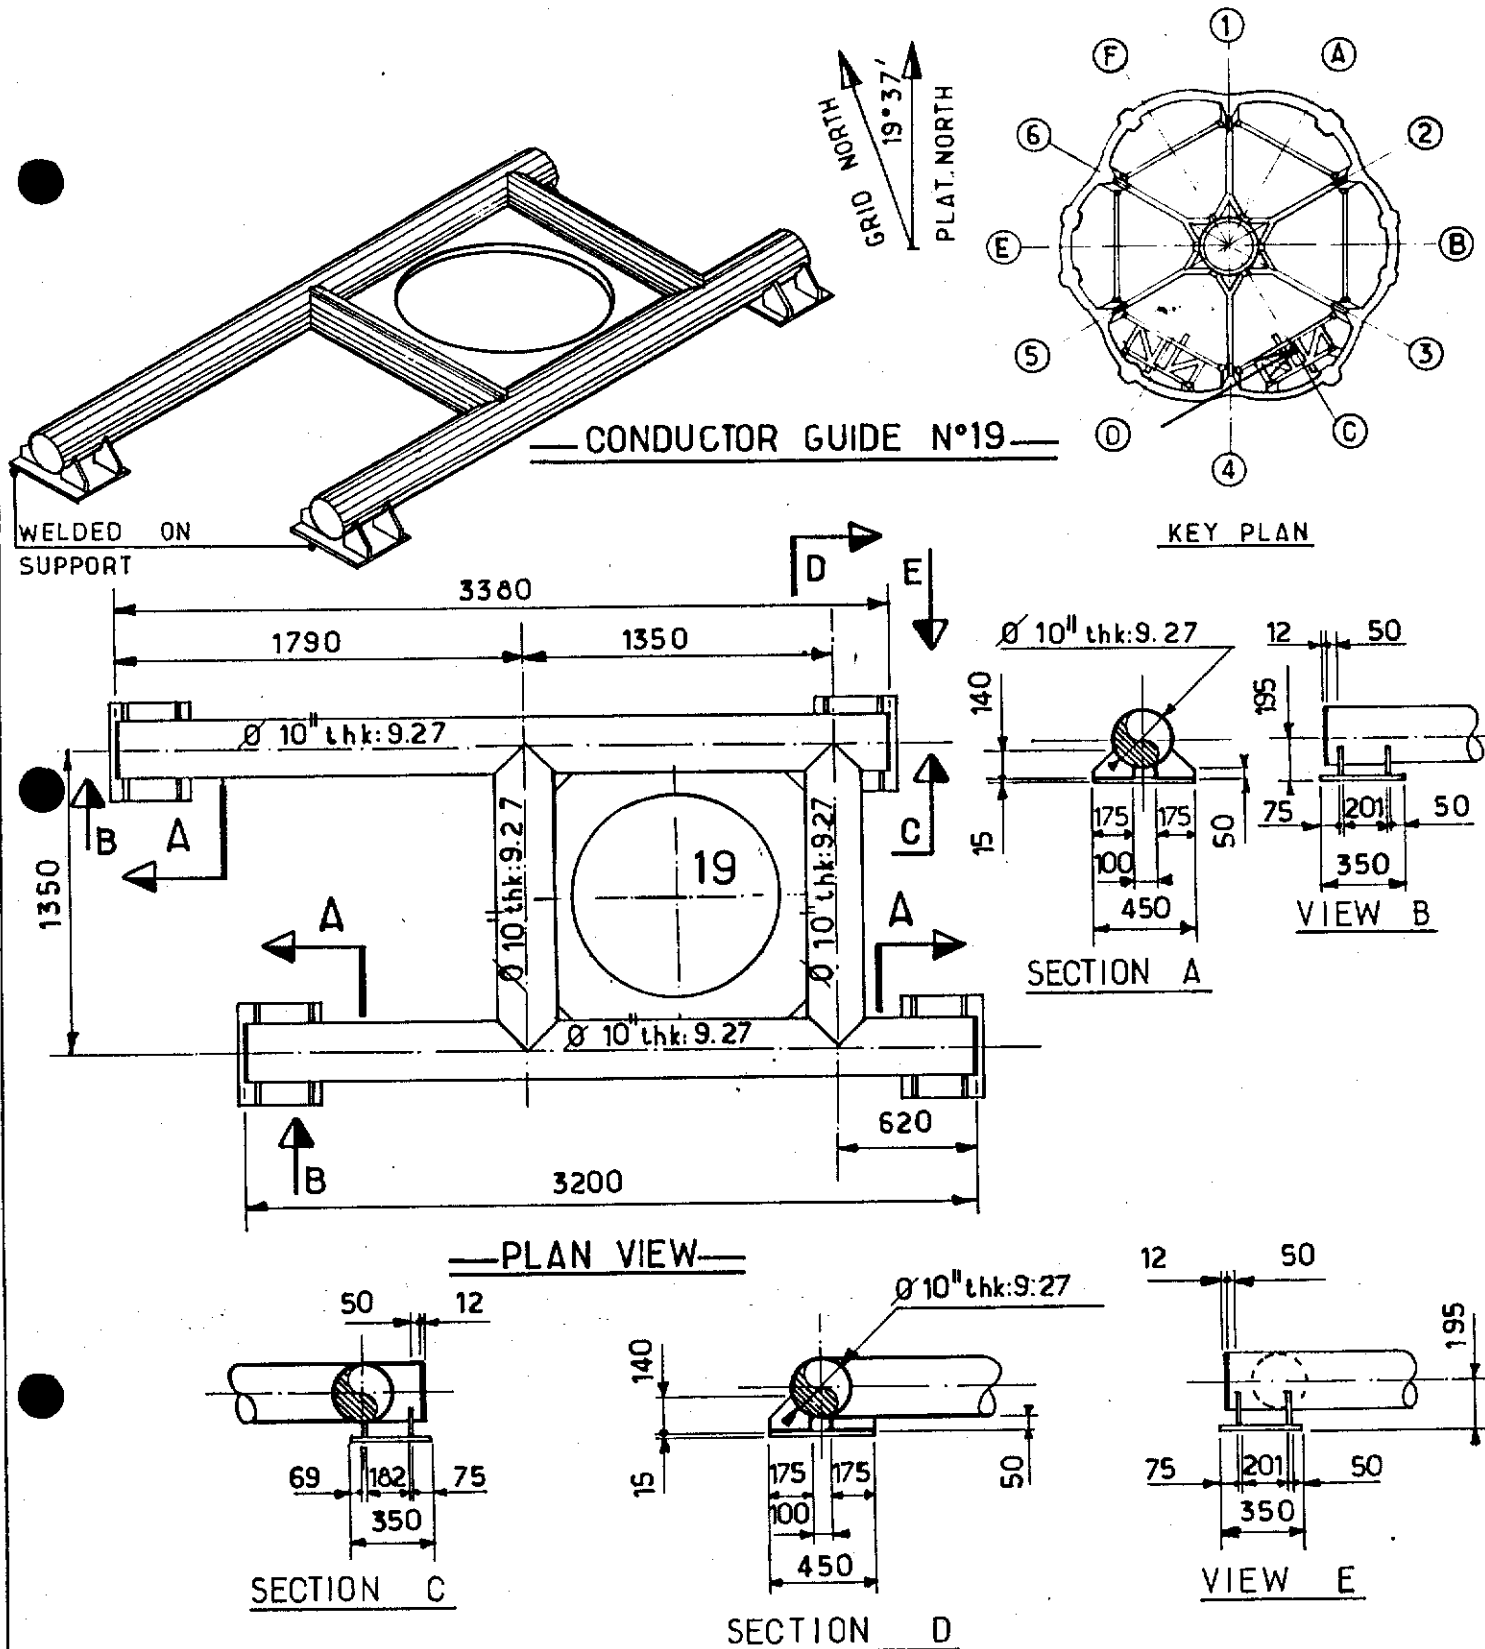

NOTES

FOR LOCATION SEE SK FF 91-36-35-1378
 FOR CONDUCTOR SLEEVE SEE SK FF-91-36-35-1491.


				elf aquitaine norge a/s p.o.box 168 4001 Stavanger	 elf FRIGG FIELD	Job no.	Installation	System
1	1283	UP DATED	B.V.H. / L.L.				CDP 1	UNDERWATER
Rev.	Date	DESCRIPTION	by	app.		Scale	CONDUCTOR GUIDE N°19 CELL C	
						1:33	SECONDARY FRAME LEVEL E	
Contractor JVD 1029-40-56						Dwgr. no.	FF 91-36-35-1386	Rev.
								1
								Sheet

CDP 1 AS BUILT DRAWINGS

REFERENCE DRAWING LIST FOR:

[illegible]


							Job no.	Installation CDP 1	System UNDERWATER	
							Scale			
Rev.	Date	DESCRIPTION	by	app.			Dwgr. no.	FF	1386	1386
Contractor						4001 Stavanger	FRIGG FIELD			

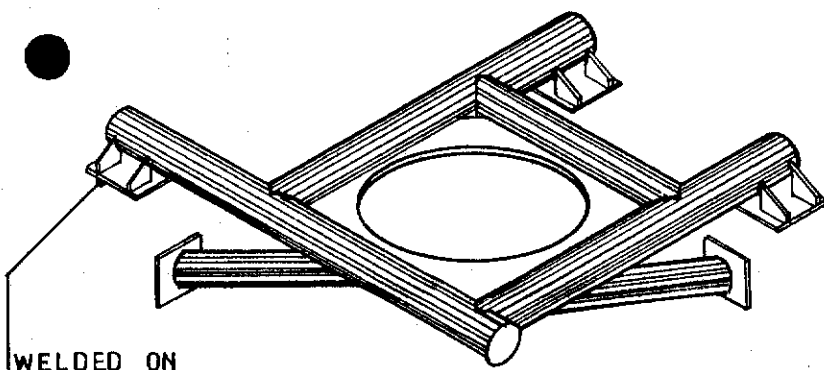


WELDED ON
SUPPORT

— CONDUCTOR GUIDE N°20 —

GRID NORTH
19°37'
PLAT NORTH

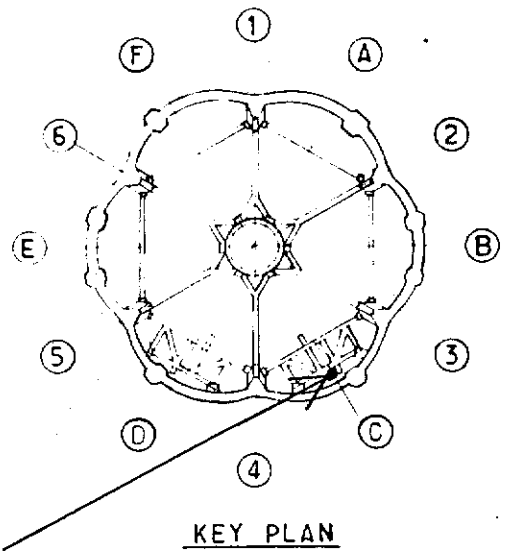


KEY PLAN


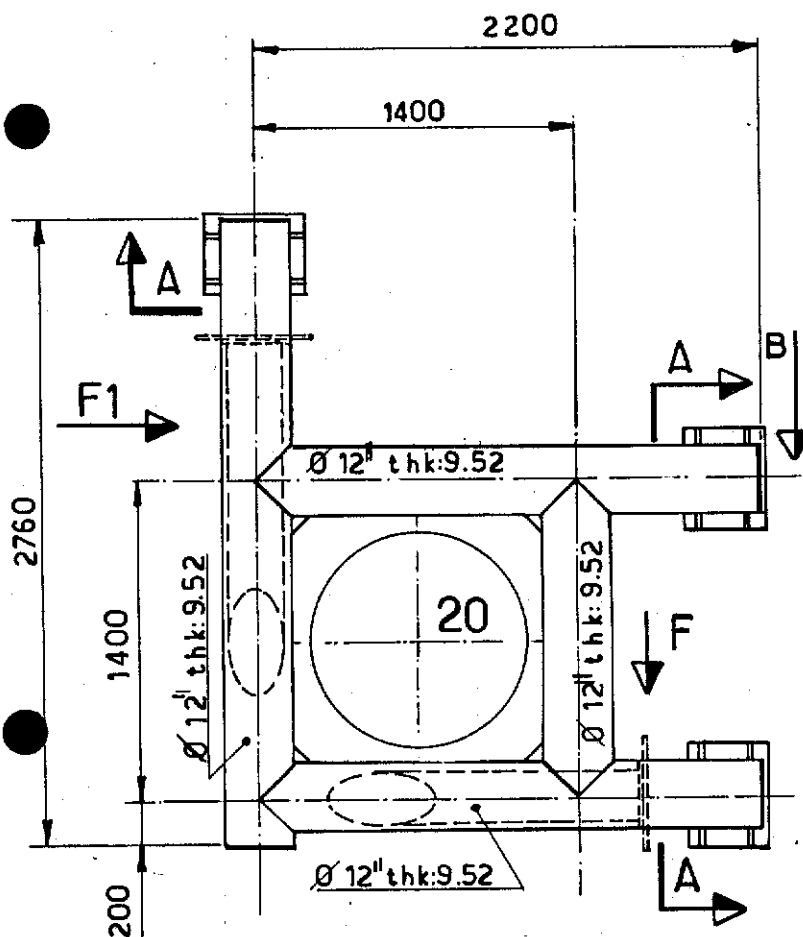


— PLAN VIEW —

SECTION A

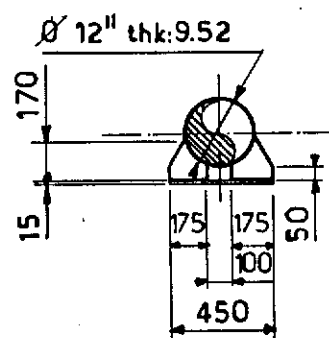

VIEW B

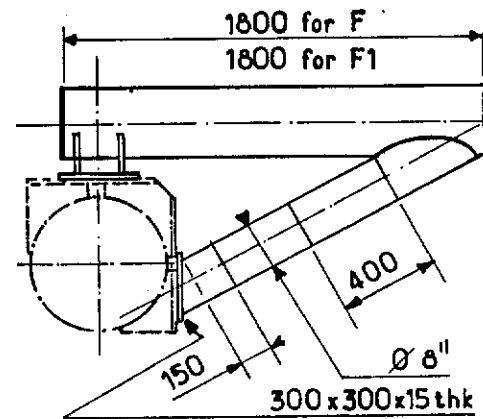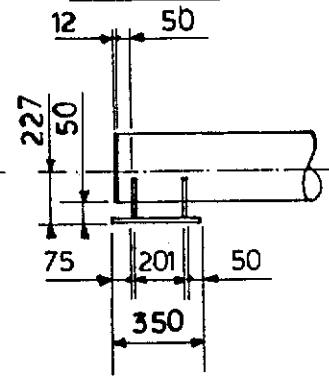

— VIEW F AND F1 —

NOTES

FOR LOCATION SEE SK FF 91-36-35-1378
FOR CONDUCTOR SLEEVE SEE SK FF 91-36-35-1491.

				elf aquitaine norge a/s		Job no.	Installation CDP 1	System UNDERWATER
1	12.83	UP DATED	BVH/jlc	p.o. box 168		Scale 1:33	CONDUCTOR GUIDE N° 20 CELL C SECONDARY FRAME LEVEL E	
Rev.	Date	DESCRIPTION	by	app.		Dwgr. no.	FF 91-36-35-1387	1
Contractor JVD 1029-40-57				4001 Stavanger		FRIGG FIELD		

CDP 1 AS BUILT DRAWINGS


REFERENCE DRAWING LIST FOR:

[illegible]

						 elf	Job no.	Installation CDP 1	System UNDERWATER
							Scale		
Rev.	Date	DESCRIPTION	by	app.			Dwgr. no.		
Contractor							FF	1387	
elf aquitaine norge a/s p.o.box 168 4001 Stavanger						FRIGG FIELD			

CONDUCTOR GUIDE N°21


ZINC ANODE

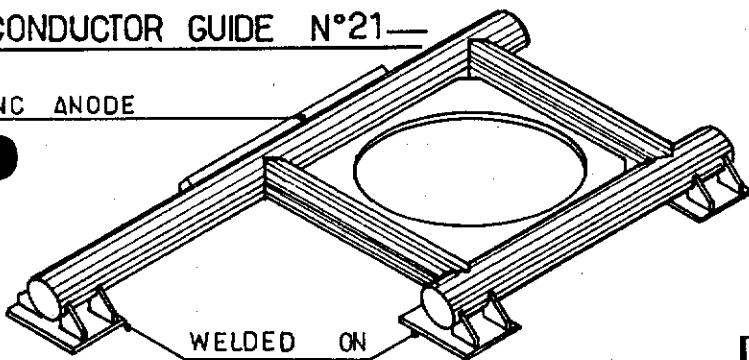


WELDED ON SUPPORT

3080


19°37'
GRD NORTH
PLAT. NORTH

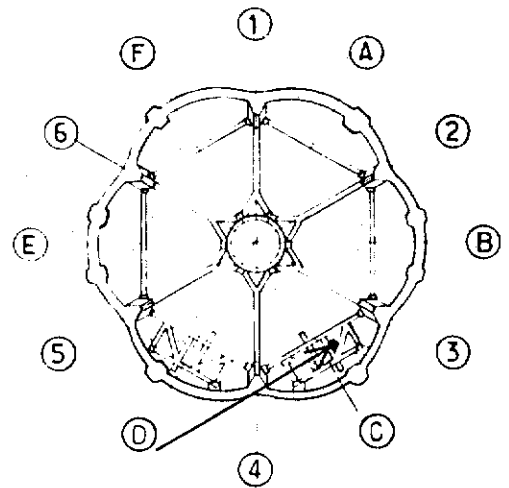

KEY PLAN

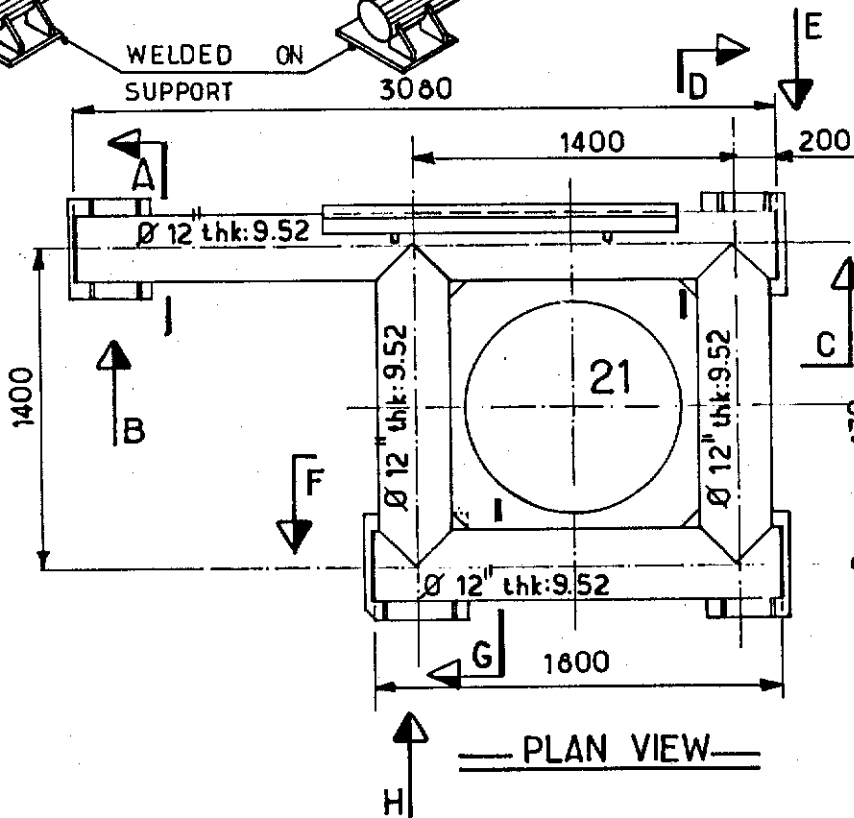


PLAN VIEW

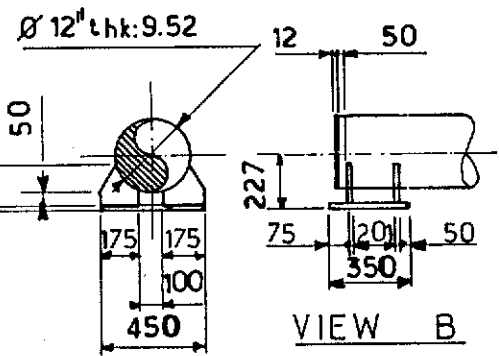


SECTION A


VIEW B

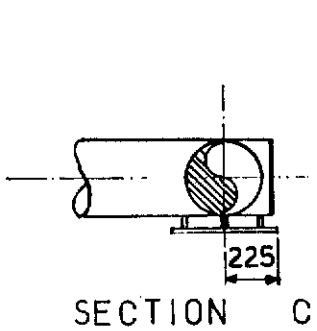


SECTION C

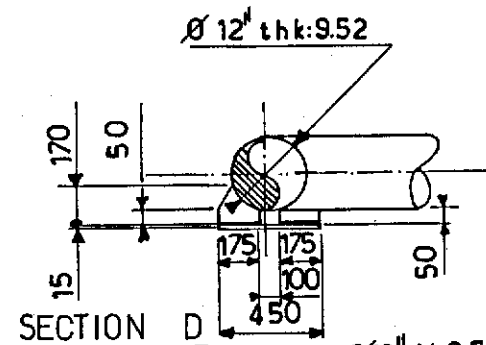


SECTION D

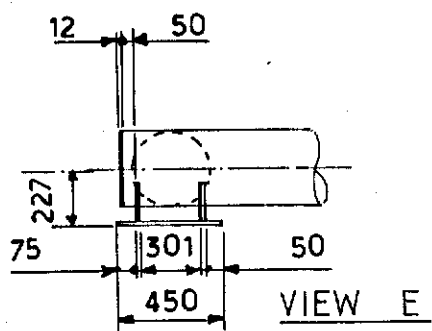


VIEW E

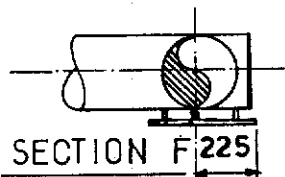

SECTION F

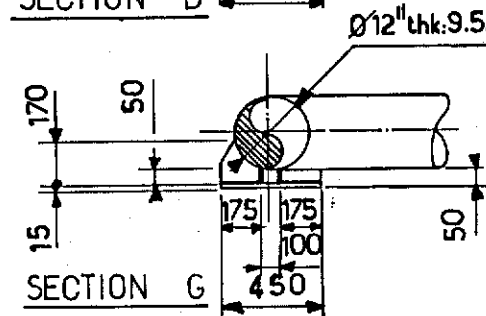

SECTION G

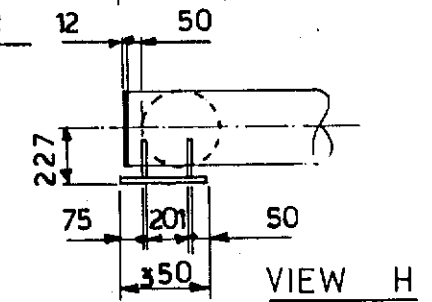

VIEW H

NOTES

FOR LOCATION SEE SK FF.91.36.35.1378

FOR CONDUCTOR SLEEVE SEE SK FF.91.36.35.1491.

FOR ZINC ANODE SEE

SK FF 91.36.35.1587

Rev.	Date	DESCRIPTION	by	app.
1	12.83	UP DATED	BVH	/110
Contractor JVD 1029_40_58_				

elf
aquitaine
norge a/s
p.o.box 168
4001 Stavanger

elf
FRIGG FIELD

Job no.	Installation CDP 1	System UNDERWATER
Scale 1:33	CONDUCTOR GUIDE N°21 CELL C SECONDARY FRAME LEVEL E	
Dwgr. no.	FF 91.36.35.1388	1


CDP 1 AS BUILT DRAWINGS

REFERENCE DRAWING LIST FOR:



[illegible]

							Job no.	Installation CDP 1	System UNDERWATER		
							Scale				
Rev.	Date	DESCRIPTION	by	app.	p.o.box 168		Dwgr. no.	FF — — 1388		ht.	thick.
Contractor					4001 Stavanger		FRIGG FIELD				


WELDED ON
SUPPORT

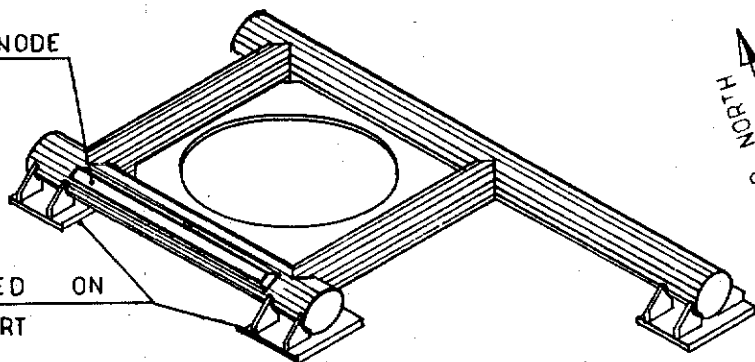

CONDUCTOR GUIDE N°22

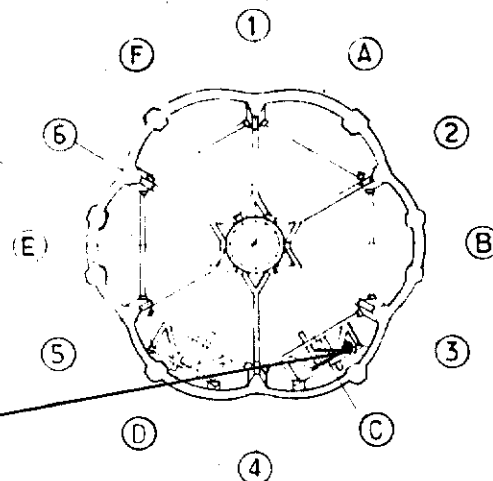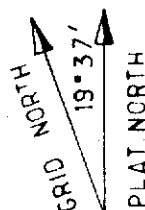


KEY PLAN

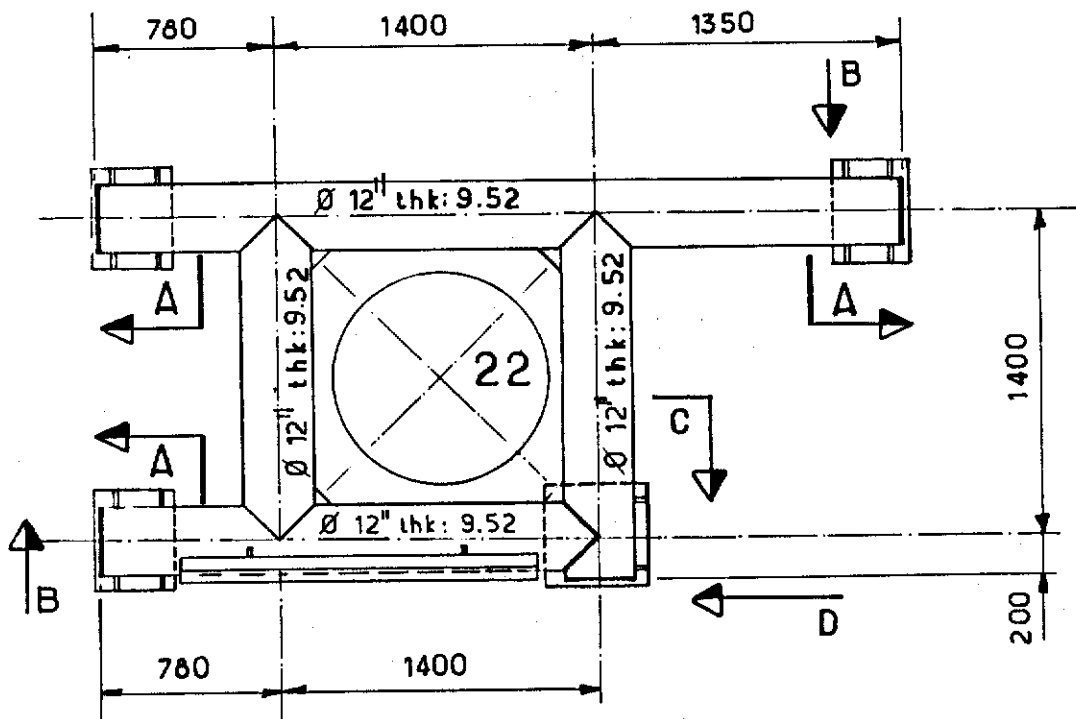



PLAN VIEW-

SECTION A

VIEW B

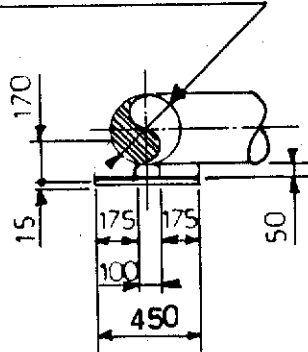

VIEW D

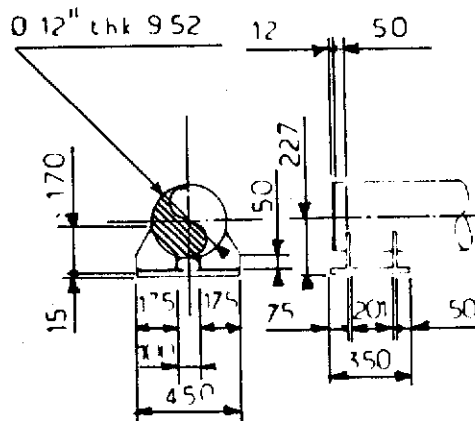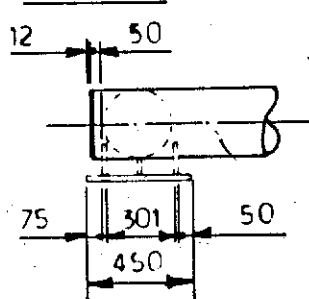

NOTES

FOR LOCATION SEE SK FF 91-36-35-1378
FOR CONDUCTOR SLEEVE SEE SK FF 91-36-35-1491.

FOR ZINC ANODE SEE SK FF 91-36-35-1587

FOR CONDUCTOR SLEEVE SEE SK FF 91-36-35-1389					Job no.		Installation CDP 1		System UNDERWATER	
 elf aquitaine norge a/s p.o.box 168 4001 Stavanger					 elf		Scale 1:33		CONDUCTOR GUIDE N°22 CELL C SECONDARY FRAME LEVEL E	
1 1283 UP DATED BYH/VC Rev. Date DESCRIPTION by app Contractor JVD 1029_40_59_					FRIGG FIELD		Dwgr. no. FF 91-36-35 - 1389		1 	

CDP 1 AS BUILT DRAWINGS

REFERENCE DRAWING LIST FOR:


[illegible]

							Job no.	Installation CDP 1	System UNDERWATER
							Scale		
Rev.	Date	DESCRIPTION	by	app.			Dwgr. no.		
Contractor						elf aquitaine norge a/s p.o.box 168 4001 Stavanger	FRIGG FIELD	FF	1389

CONDUCTOR GUIDE N°23

ZINC ANODE

GRID NORTH
19° 37'
PLAT. NORTH

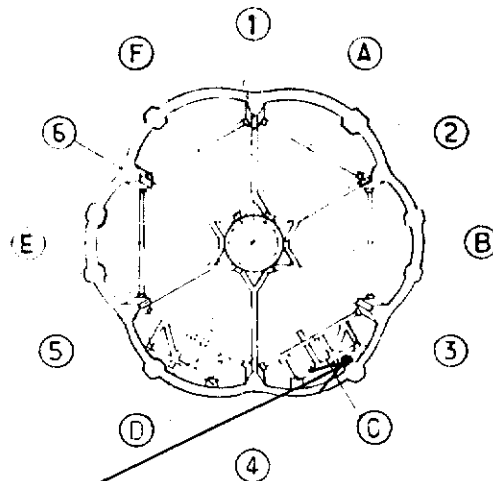


KEY PLAN


NOTES

FOR LOCATION SEE SK FF.91.36.35.1378
FOR CONDUCTOR SLEEVE SEE SK FF.91.36.35.1491
FOR ZINC ANODE SEE SK FF.91.36.35.1587


PLAN VIEW

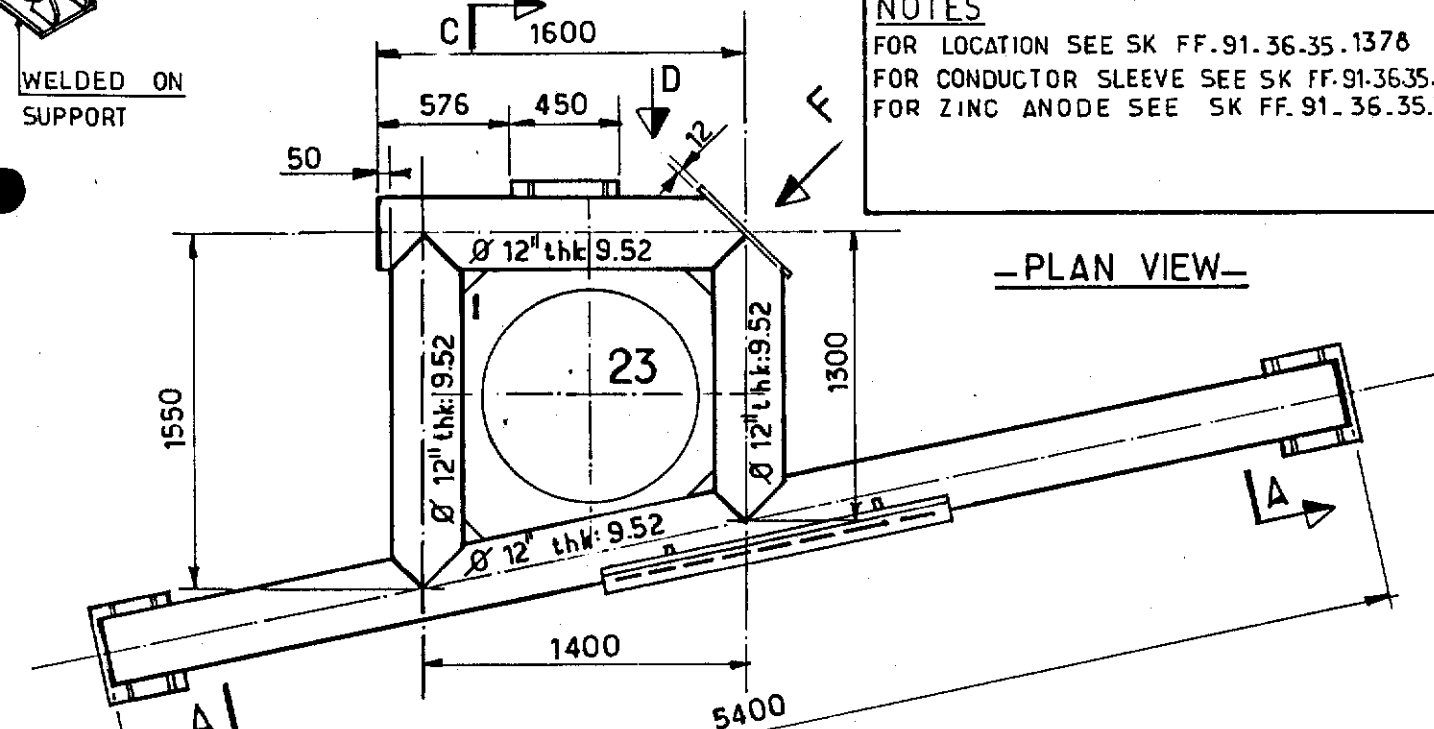


VIEW F

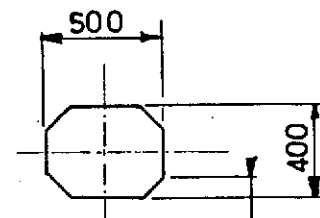



VIEW B

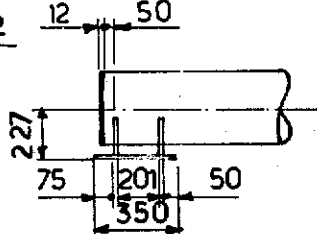

VIEW D

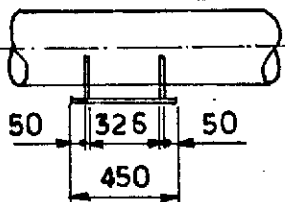

VIEW E

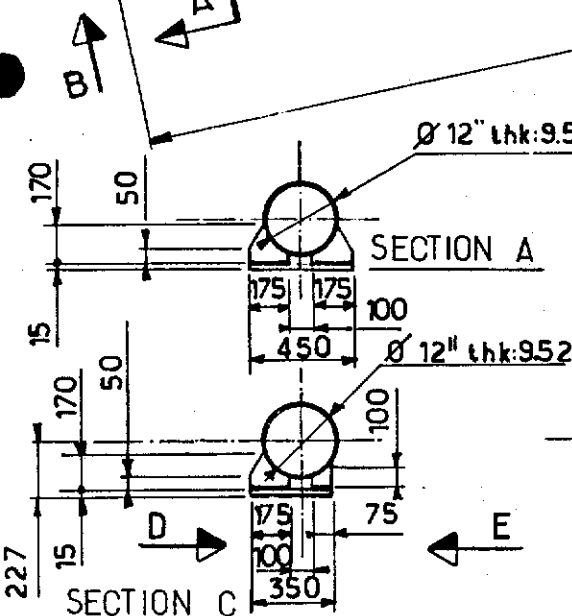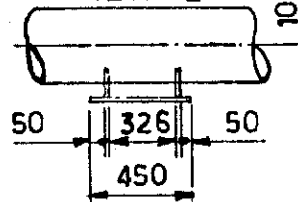

1	1283	UP DATED	BVH/lc
Rev.	Date	DESCRIPTION	by app.
Contractor JVD 1029_40_60.			

elf
aquitaine
norge a/s
p.o.box 168
4001 Stavanger



FRIGG FIELD



Job no.	Installation CDP 1	System UNDERWATER
Scale 1:33	CONDUCTOR GUIDE N°23 CELL C SECONDARY FRAME LEVEL E	
Dwgr. no	FF 91.36.35.1390.	1

CDP 1 AS BUILT DRAWINGS

REFERENCE DRAWING LIST FOR:


[illegible]

				elf aquitaine norge a/s p.o.box 168 4001 Stavanger		 elf		Job no.		Installation CDP 1		System UNDERWATER	
Rev. Date DESCRIPTION by app.								Scale					
Contractor				FRIGG FIELD				Dwgr. no. FF		1390		Yes ☐ No ☒	

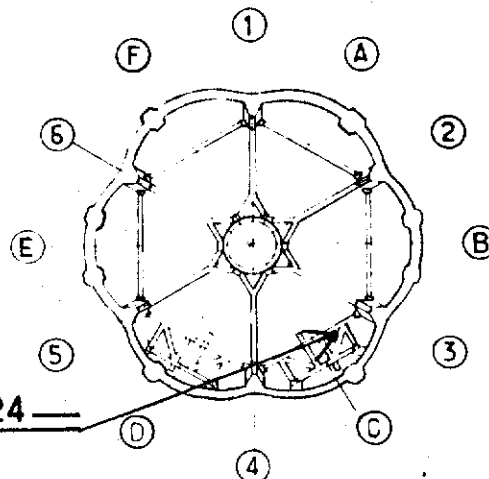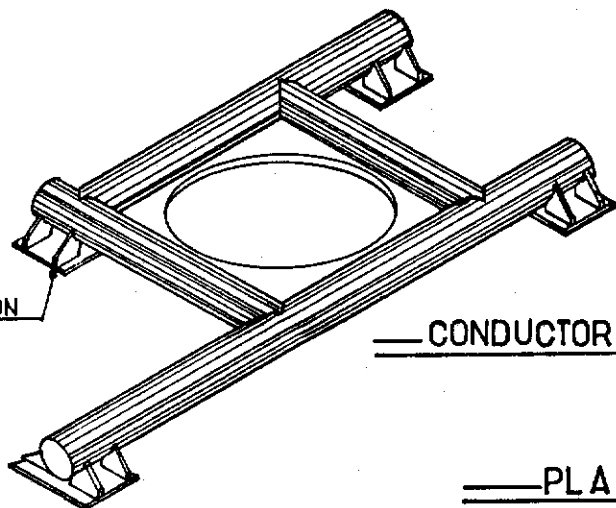


KEY PLAN


—PLAN VIEW—

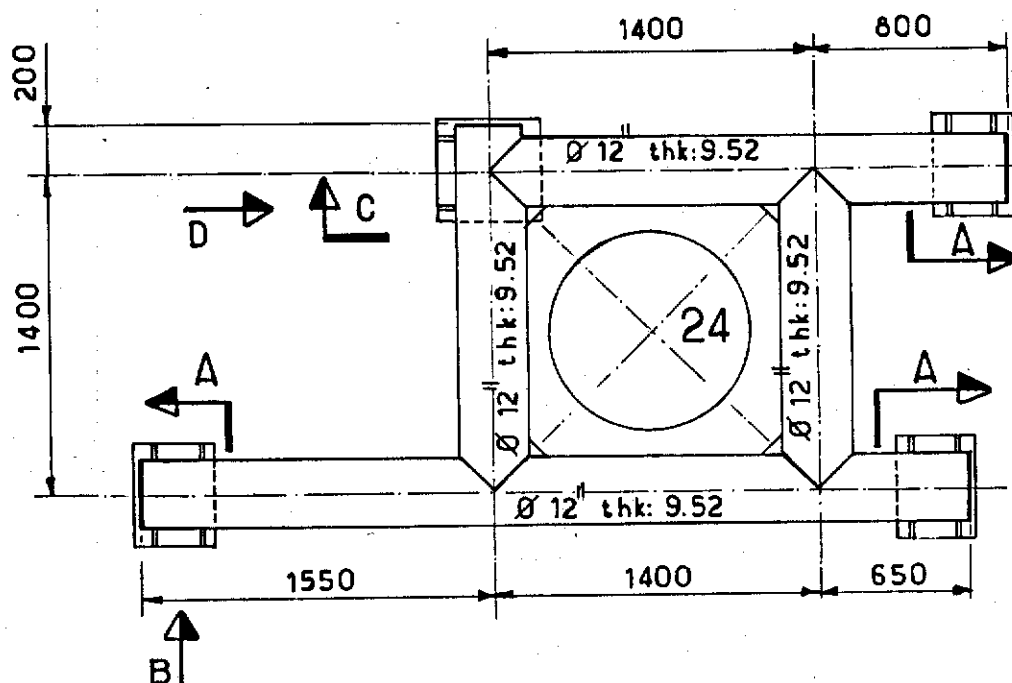


SECTION A

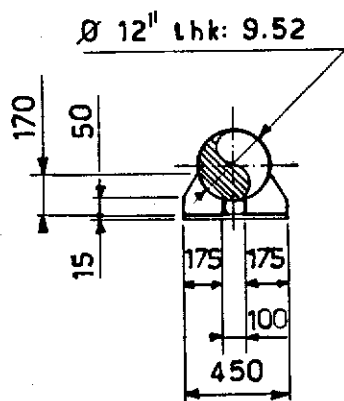


VIEW B

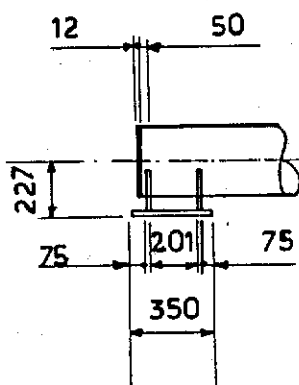

SECTION C

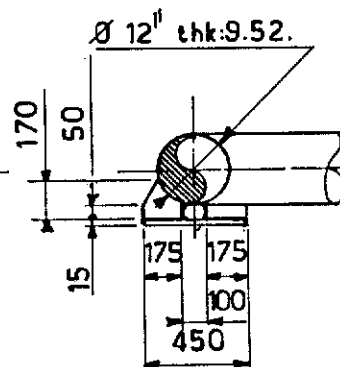

VIEW D

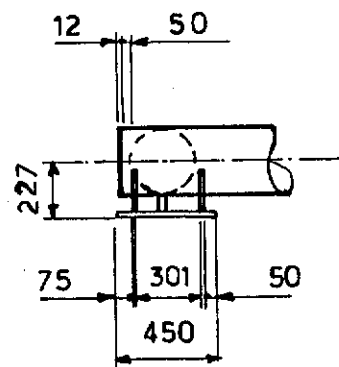

FOR LOCATION SEE SK FF 91_36.35_1378
FOR CONDUCTOR SLEEVE SEE SK FF_91.36_35_1491.




1	1283	UP DATED	BY H. J. L.	elf aquitaine norge a/s p.o. box 168 4001 Stavanger	 elf FRIGG FIELD	Job no.	Installation CDP 1	System UNDERWATER
						Scale 1:33	CONDUCTOR GUIDE N°24 CELL C SECONDARY FRAME LEVEL E	
Rev.	Date	DESCRIPTION	by	app.		Dwgr. no.	FF 91.36.35.1391.	No. 1
Contractor JVD 1029_40_61.								

CDP 1 AS BUILT DRAWINGS


REFERENCE DRAWING LIST FOR:

[illegible]

					elf aquitaine norge a/s p.o.box 168 4001 Stavanger	 elf	Job no.	Installation CDP 1	System UNDERWATER		
							Scale				
Rev.	Date	DESCRIPTION	by	app.			Dwgr. no.	FF ——— 1391		Rev.	Sheet
Contractor						FRIGG FIELD					

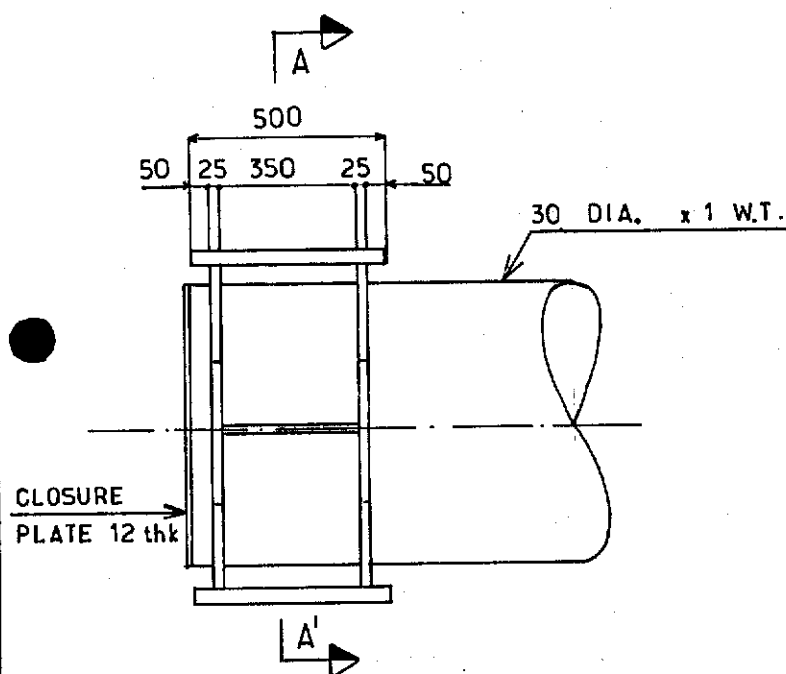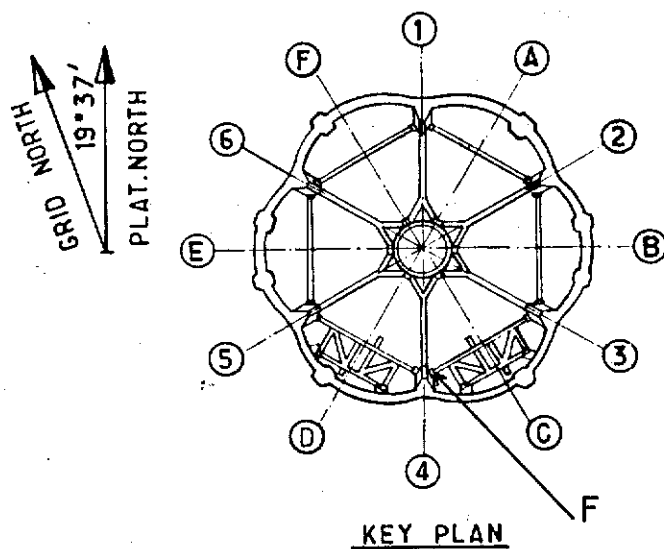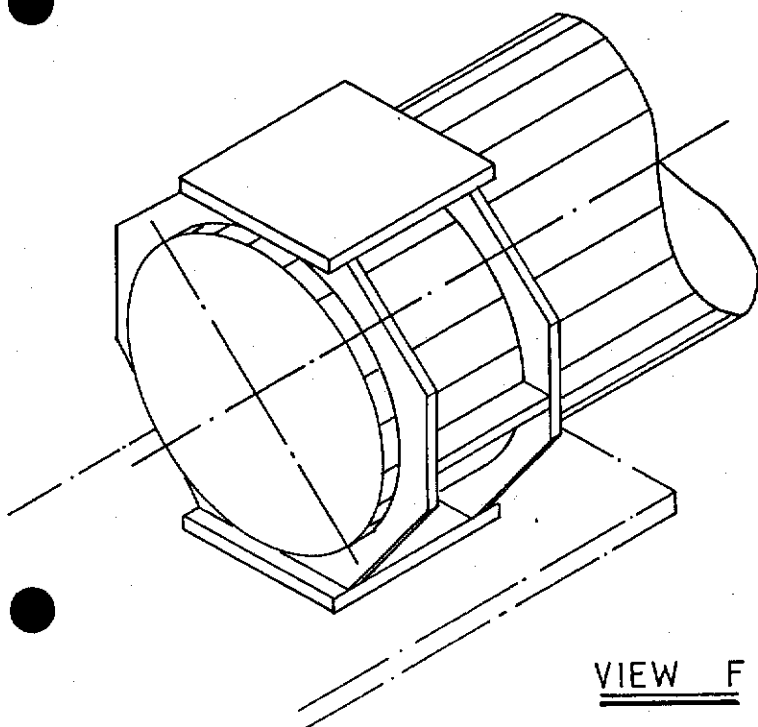

SECTION AA'

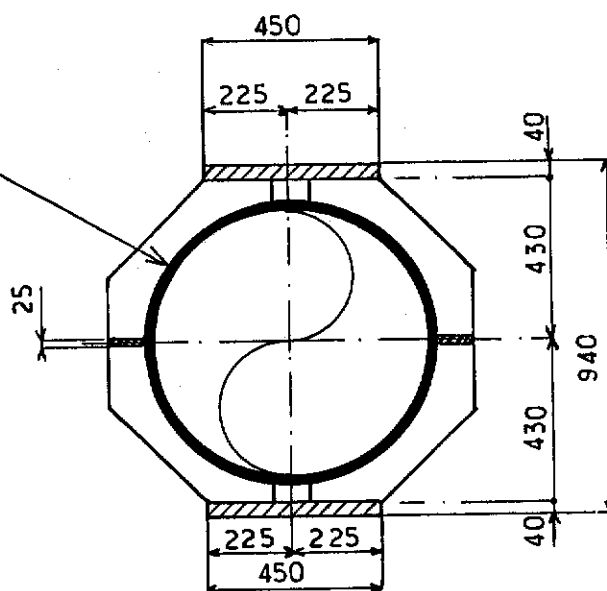

NOTES

FOR LOCATION SEE SK FF. 91.36.35. 1378.
FOR BOX FOR FREE LOCK SEE SK FF. 91.36.35. 1394.


					elf aquitaine norge a/s p.o.box 168 4001 Stavanger	 FRIGG FIELD	Job no.	Installation CDP 1	System UNDERWATER		
1	1283	UP DATED	BVH	J/LC			Scale 1:20	FREE LOCK PIPE END EC 1 CELL C LEVEL E			
Rev.	Date	DESCRIPTION	by	app.			Dwgr. no.	FF 91.36.35. 1392		Rev 1	Sheet /
Contractor JVD 1029.40.62.											

CDP 1 AS BUILT DRAWINGS

REFERENCE DRAWING LIST FOR:


[illegible]

						elf aquitaine norge a/s p.o.box 168 4001 Stavanger	 elf	Job no.	Installation CDP 1	System UNDERWATER	
								Scale			
Rev.	Date	DESCRIPTION	by	app.				Dwgr. no.		Rev.	Sheet
Contractor						4001 Stavanger	FRIGG FIELD	FF	1392		/


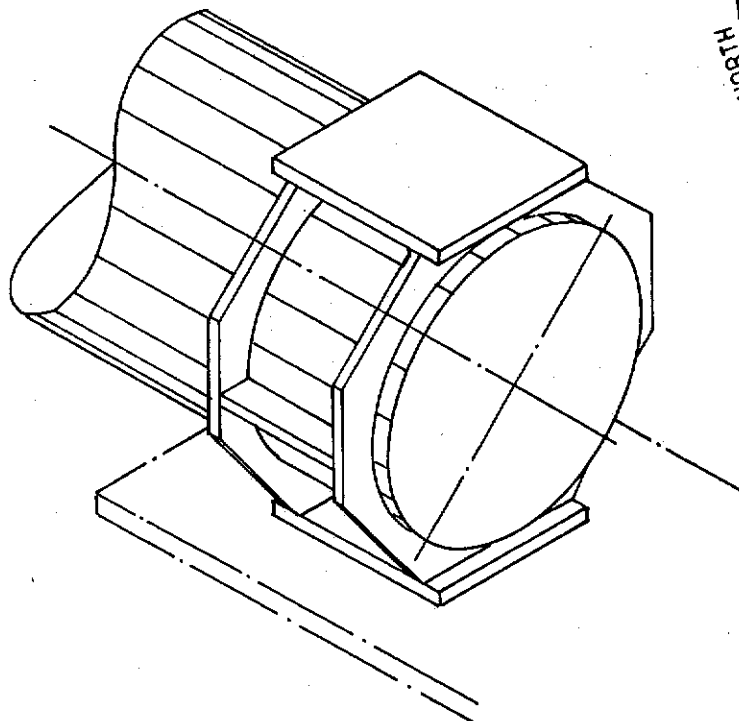


VIEW F

GRID NORTH
19°37'
PLAT. NORTH

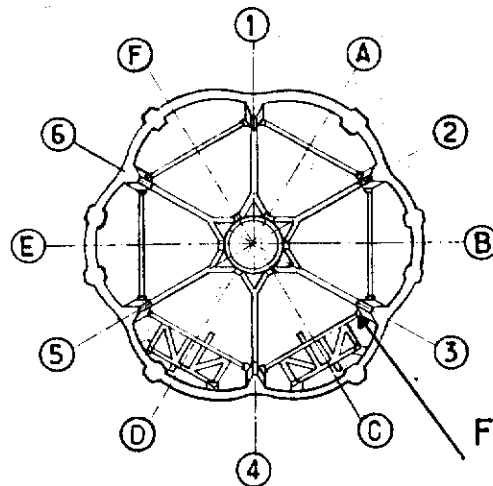

KEY PLAN

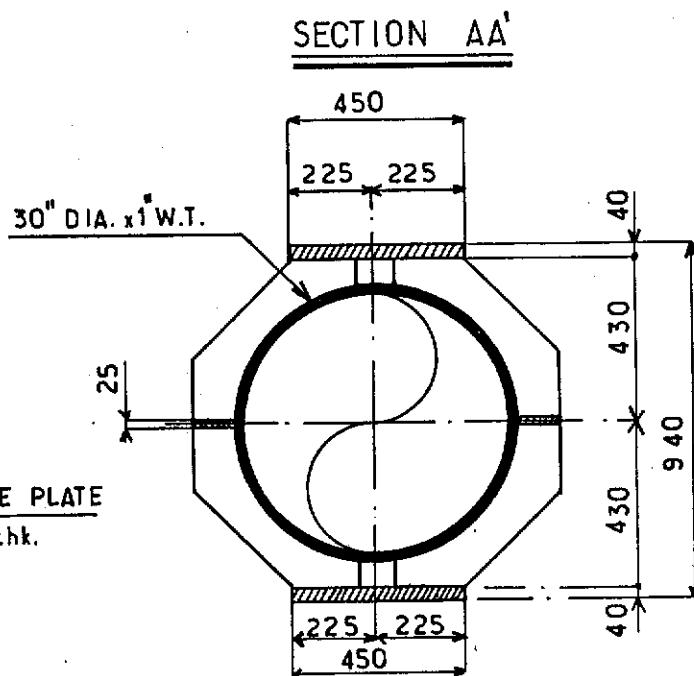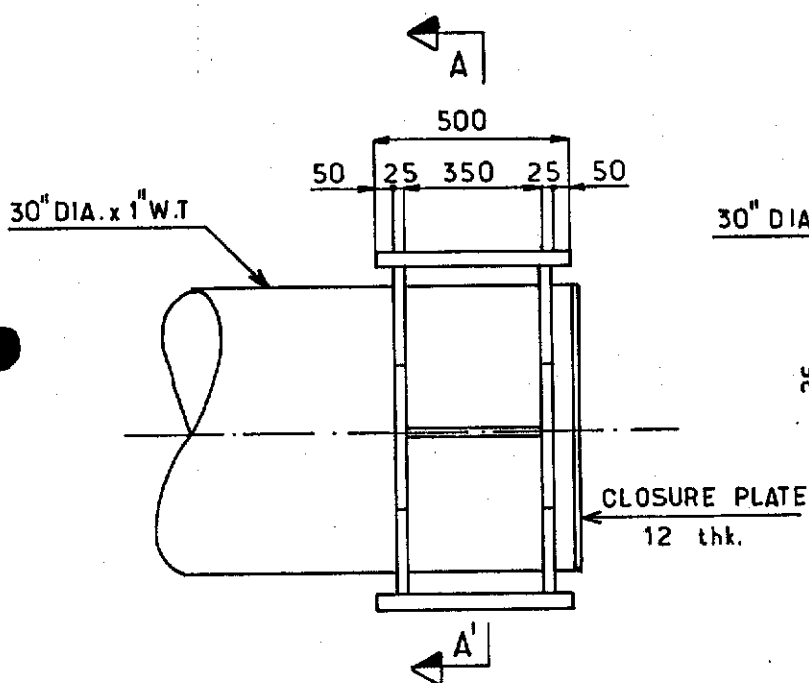

NOTES

FOR LOCATION SEE SK FF.91.36.35.1378
FOR BOX FOR FREE LOCK SEE SK FF.91.36.35.1395.


				elf aquitaine norge a/s		Job no.		Installation CDP 1		System UNDERWATER	
1	12.83	UP DATED	BYH JLC	p.o.box 168		Scale 1:20		FREE LOCK PIPE END EC4		CELL C LEVEL E	
Rev.	Date	DESCRIPTION	by	app.		Dwgr. no.		FF 91.36.35.1393		Rev	Sheet
Contractor JVD 1029 40 63				4001 Stavanger		FRIGG FIELD				1	

CDP 1 AS BUILT DRAWINGS


REFERENCE DRAWING LIST FOR:

[illegible][illegible]

					elf aquitaine norge a/s p.o.box 168 4001 Stavanger	 elf	FRIGG FIELD	Job no.	Installation CDP 1	System UNDERWATER	
								Scale			
Rev.	Date	DESCRIPTION	by	app.				Dwgr. no.	FF — — 1393		Rev.
Contractor											

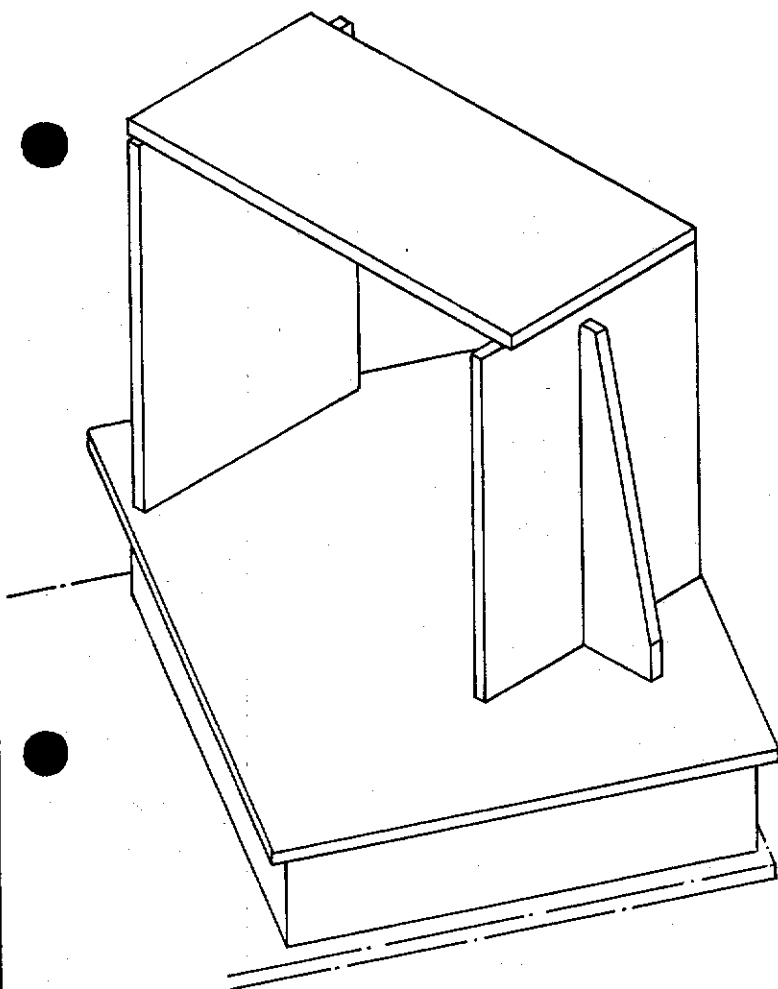


GRID NORTH
19° 37'
PLAT. NORTH

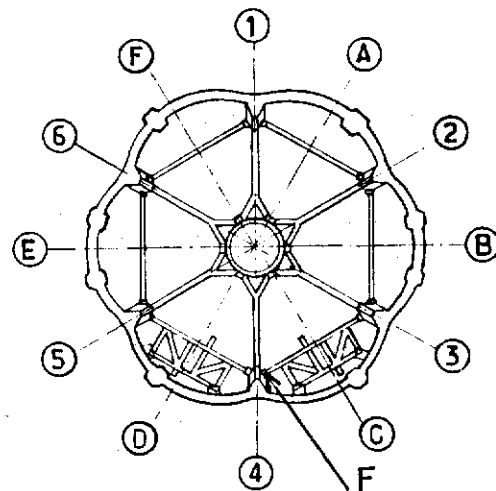


KEY PLAN

VIEW F

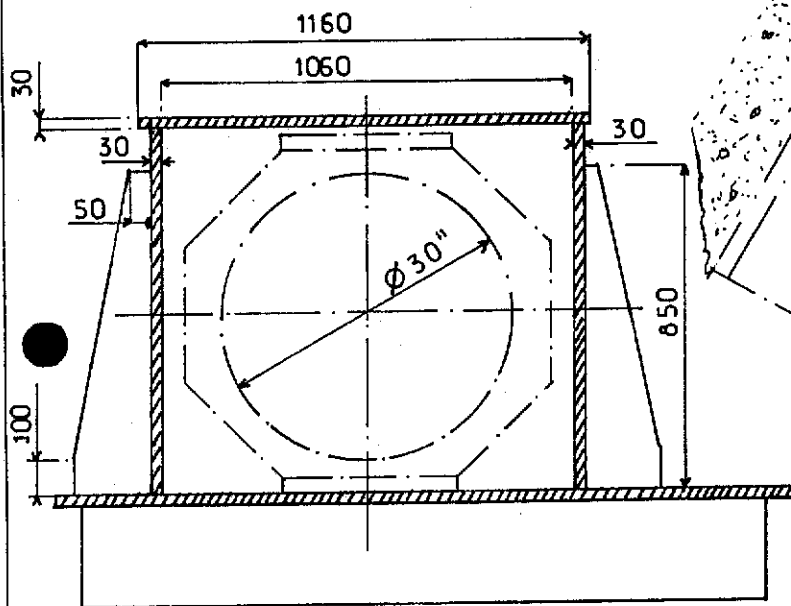

SECTION AA'

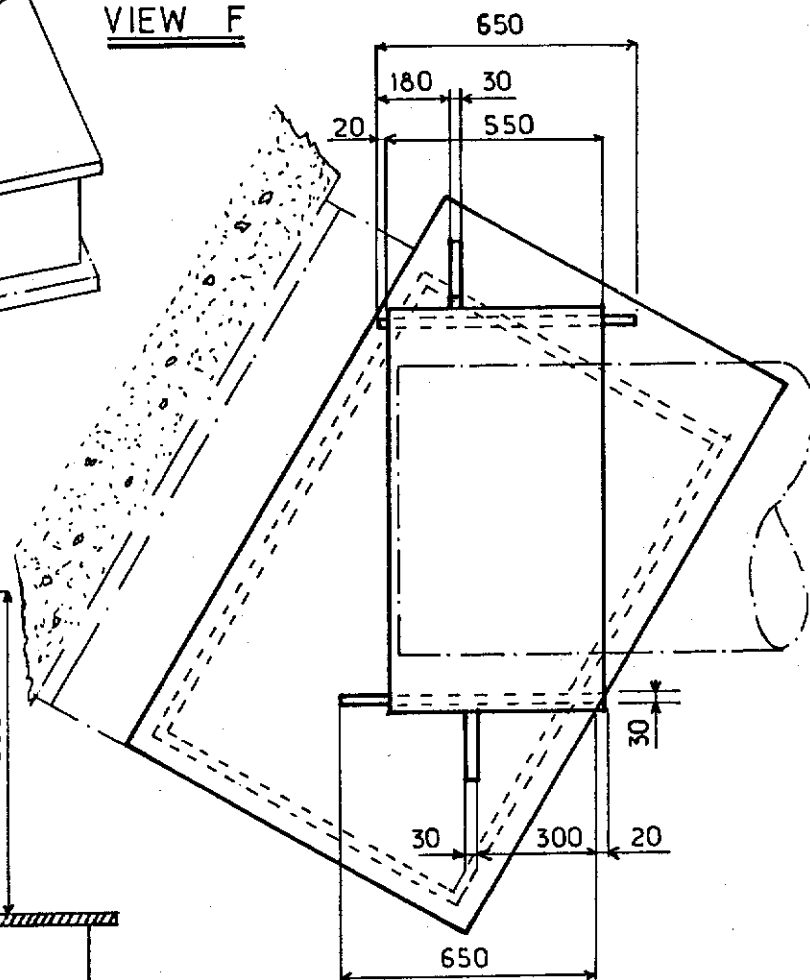

NOTES

FOR LOCATION SEE SK FF. 91.36.35.1378.

FOR DETAIL OF FREE LOCK PIPE END SEE SK FF. 91.36.35.1392.




				elf aquitaine norge a/s		 elf	Job no.	Installation CDP 1	System UNDERWATER
1	12.83	UP DATED	BVH	HC	p.o.box 168		Scale 1:20	BOX FOR FREE LOCK CELL C	EC1 LEVEL E
Rev.	Date	DESCRIPTION	by	app.	4001 Stavanger		Dwgr. no.	FF 91.36.35.1394	Rev 1
Contractor JVD 1029 40 64				FRIGG FIELD					Sheet

CDP 1 AS BUILT DRAWINGS

REFERENCE DRAWING LIST FOR:

[illegible][illegible]



						elf aquitaine norge a/s p.o.box 168 4001 Stavanger	 elf	Job no.	Installation CDP 1	System UNDERWATER
								Scale	BOXE FOR FREE LOCK EC1	
Rev.	Date	DESCRIPTION	by	app.				Dwgr. no.	FF — 1394	Rev.
Contractor						FRIGG FIELD				

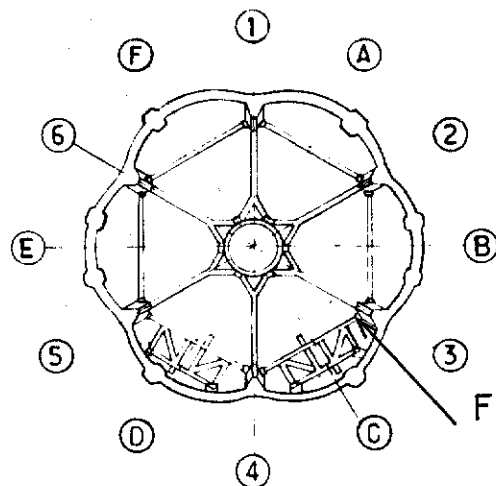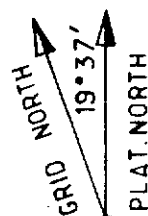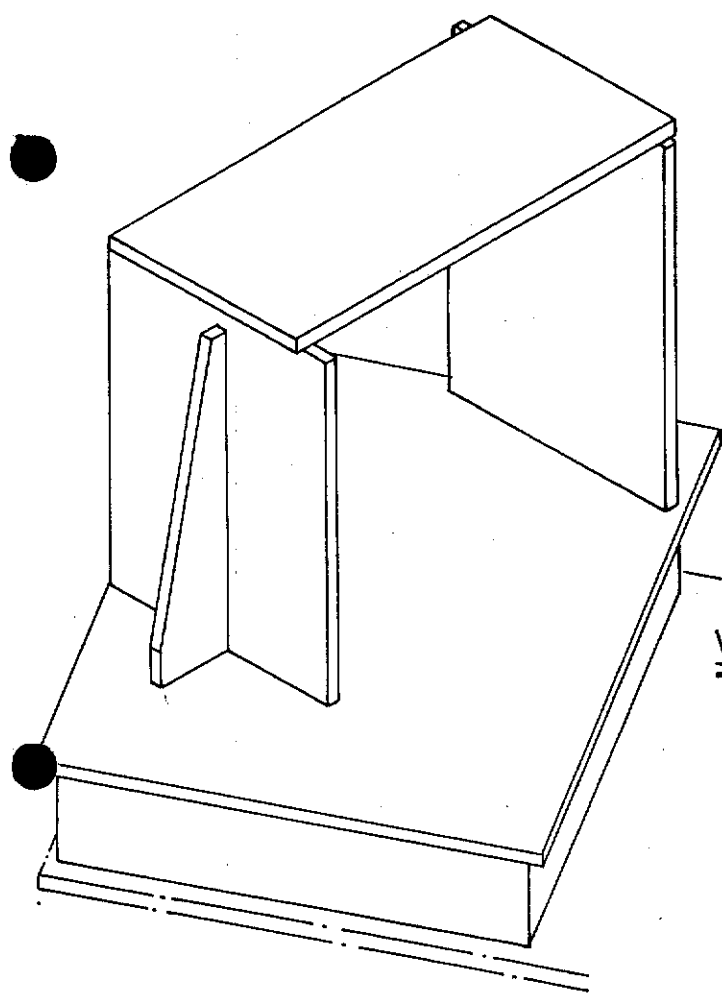

KEY PLAN

VIEW F

SECTION AA'

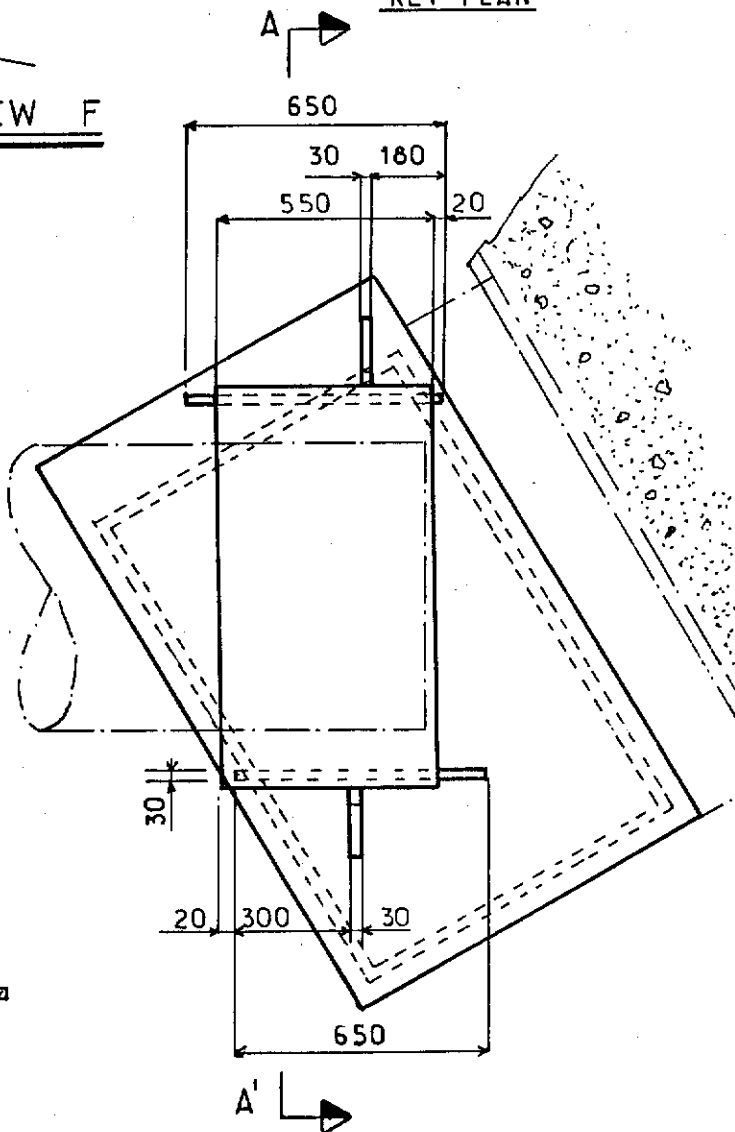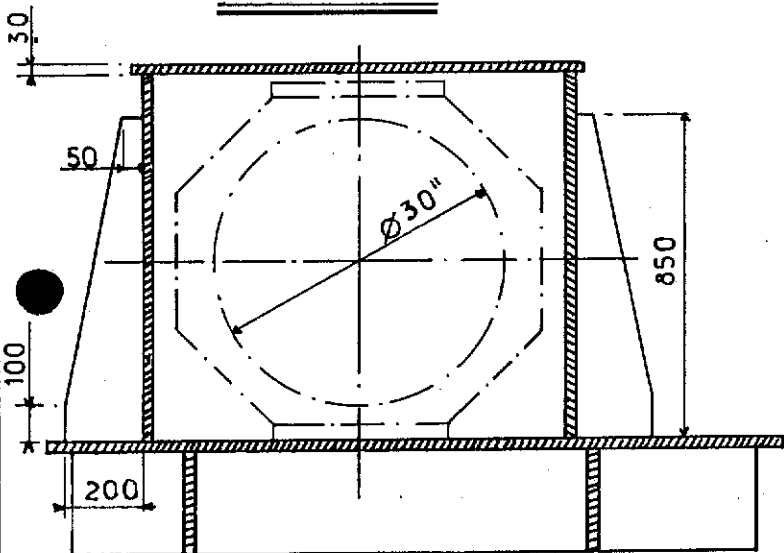

NOTES

FOR LOCATION SEE SK FF_91_36_35_1378.

FOR DETAIL OF FREE LOCK PIPE END SEE SK FF_91_36_35_1393.



12.83	UP DATED	BVH	elf aquitaine norge a/s p.o.box 168 4001 Stavanger		Job no.	Installation CDP 1	System UNDERWATER		
					Scale 1:20	BOX FOR FREE LOCK EC4 CELL C. LEVEL E			
Rev.	Date	DESCRIPTION	by	app.	Dwgr. no.	FF 91.36.35.1395		1	Sheet
Contractor JVD 1029.40.65.			4001 Stavanger		FRIGG FIELD				

CDP 1 AS BUILT DRAWINGS

REFERENCE DRAWING LIST FOR:

[illegible][illegible]

						elf aquitaine norge a/s p.o.box 168 4001 Stavanger	 elf	Job no.	Installation CDP 1	System UNDERWATER	
								Scale	BOXE FOR FREE LOCK EC4		
Rev.	Date	DESCRIPTION	by	app.				Dwgr. no.		Rev.	Sheet
Contractor								FF	1395		/

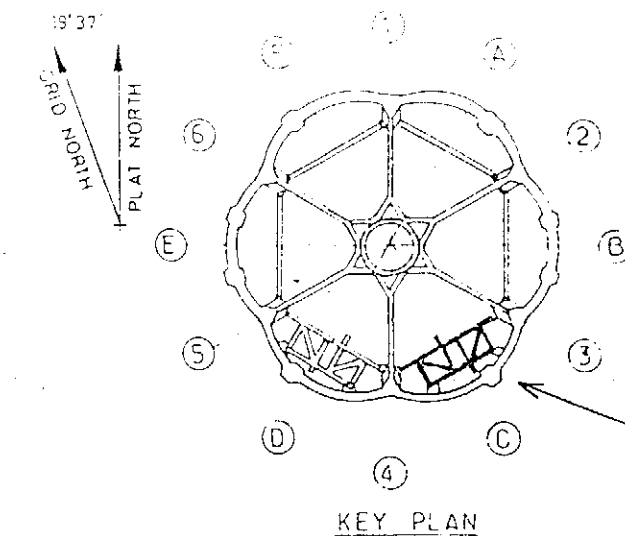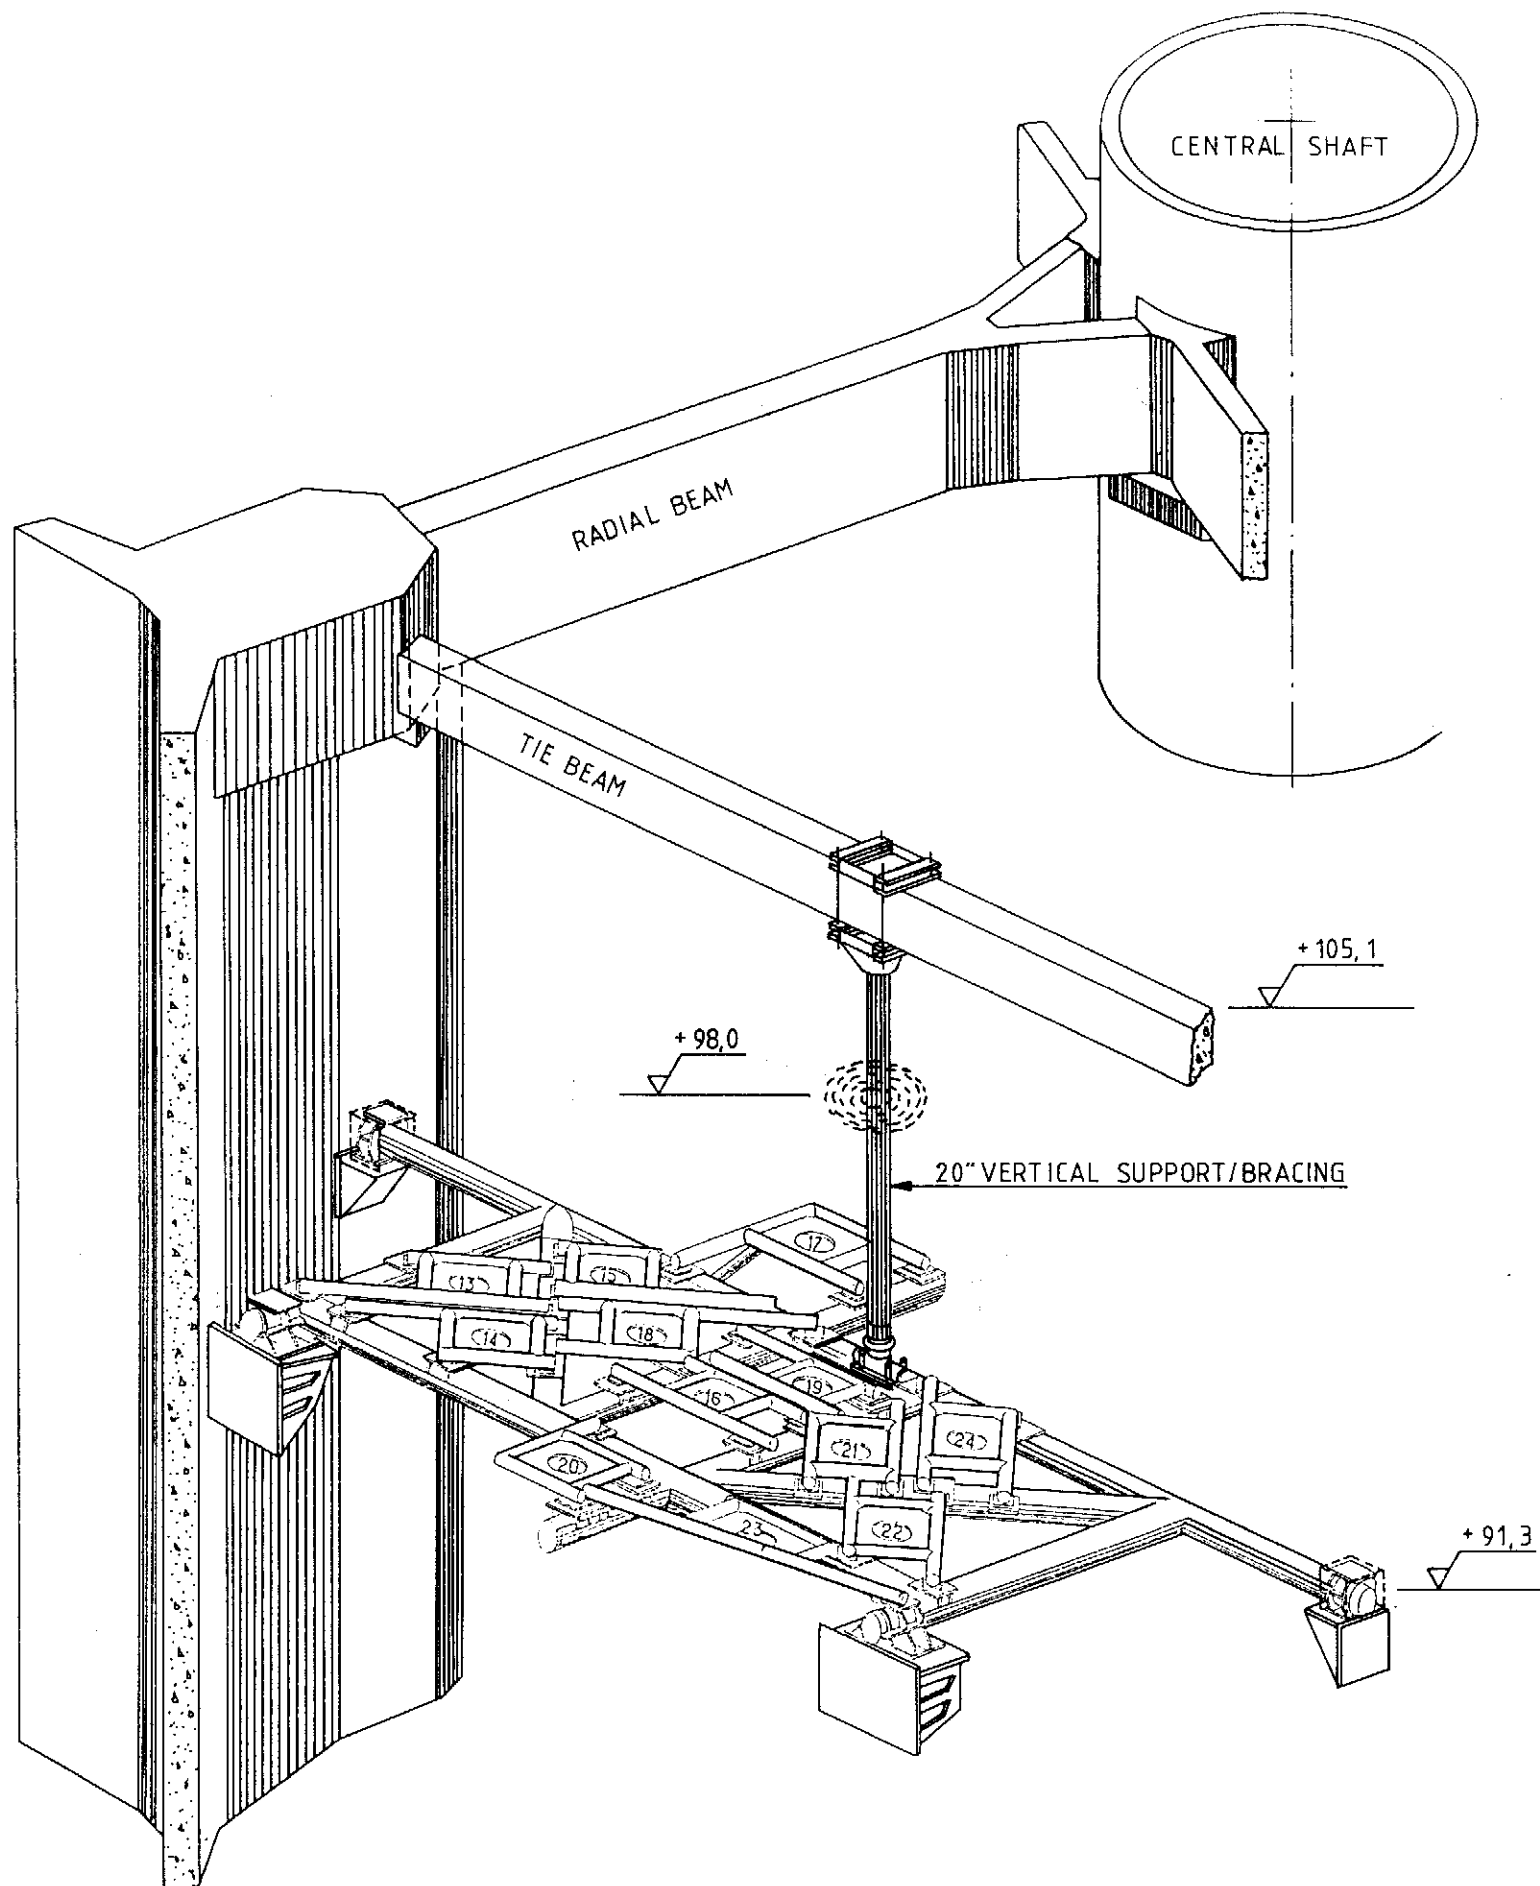

REF. DRG.
 FF 91 36 35 1397 GENERAL VIEW OF VERTICAL BRACING
 IN CELL C. LEVEL E.
 FF 91 36 35 1418 GENERAL VIEW OF VERTICAL BRACING
 IN CELL D. LEVEL E.

Contractor		elf aquitaine norge a/s		elf		Installation CDP1		System UNDERWATER	
Job no.		Scale NONE		Drwg. no.		Rev		Sheet	
20.2.86		First issue		FF 91 36 35 1396		0		1	
Date		DESCRIPTION		FRIGG FIELD					
by		app.							

CDP 1 AS BUILT DRAWINGS

REFERENCE DRAWING LIST FOR:

[illegible][illegible]

					elf aquitaine norge a/s p.o.box 168 4001 Stavanger	 elf	Job no.	Installation CDP 1	System UNDERWATER	
							Scale			
Rev.	Date	DESCRIPTION	by	app.			Dwgr. no.		Rev.	Sheet
Contractor							FF	1396	0	/

CDP 1 AS BUILT DRAWINGS

REFERENCE DRAWING LIST FOR:

[illegible][illegible]



						elf aquitaine norge a/s p.o.box 168 4001 Stavanger	 elf	Job no.	Installation CDP 1	System UNDERWATER			
								Scale					
Rev.	Date	DESCRIPTION			by	app.	FRIGG FIELD	Dwgr. no.	FF		1397	Rev	Sheet
Contractor												O	/

CDP 1 AS BUILT DRAWINGS

REFERENCE DRAWING LIST FOR: CONDUCTOR GUIDE FRAME

[illegible][illegible]

Rev. Date DESCRIPTION by app. elf aquitaine norge a/s p.o.box 168 4001 Stavanger  elf Job no. Installation CDP 1 System UNDERWATER				
Scale Dwgr. no. FF 1400 Rev. Sheet				

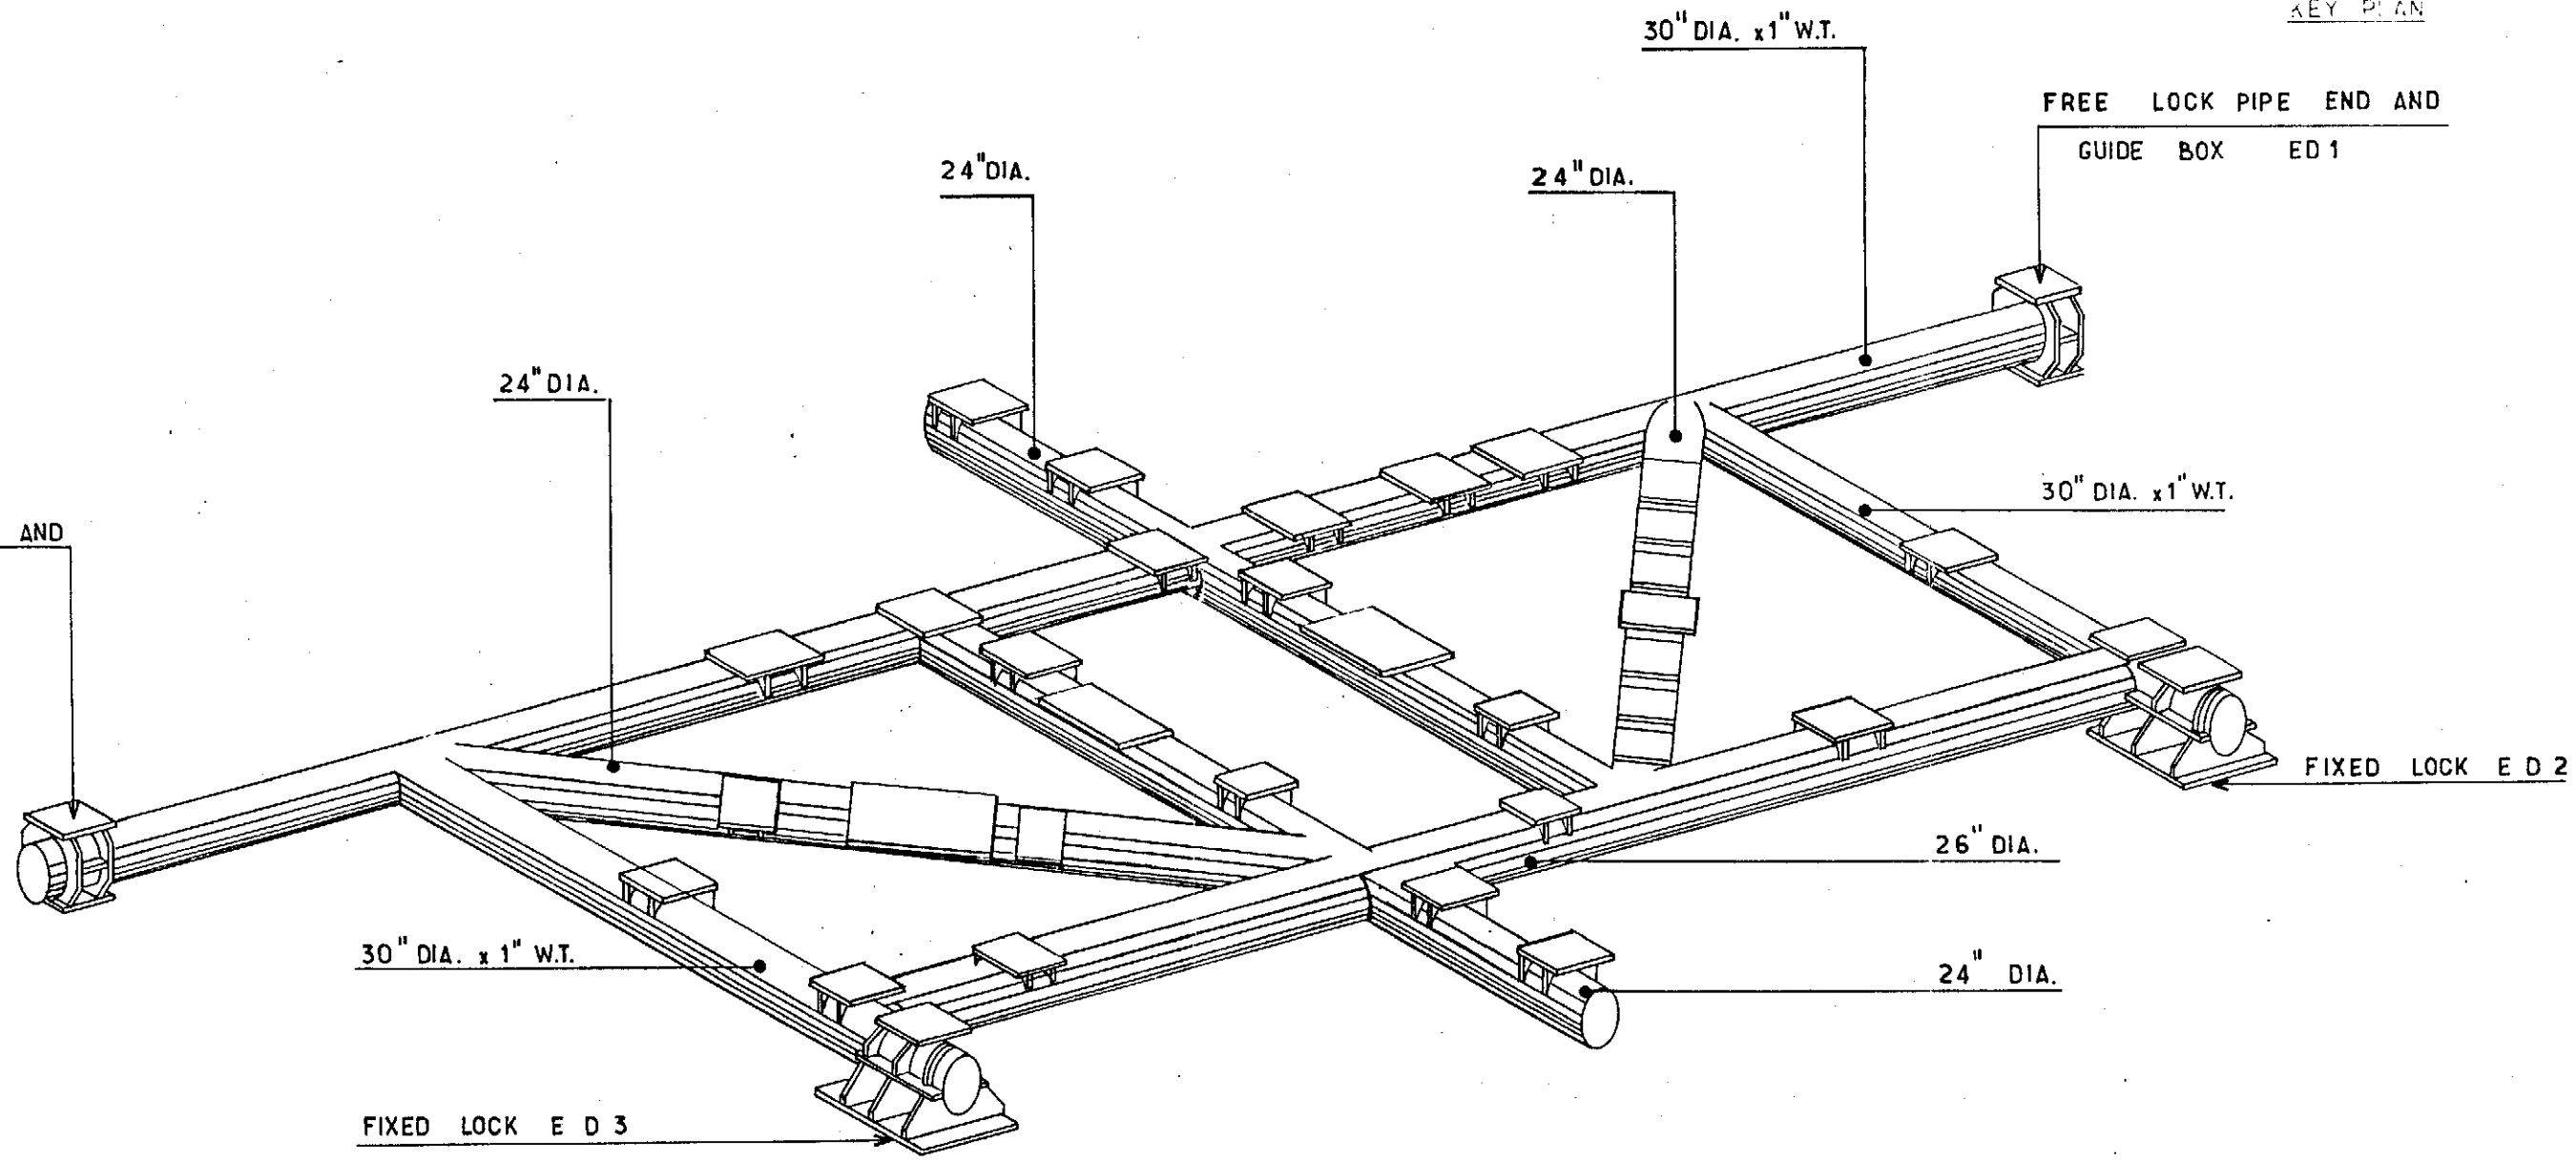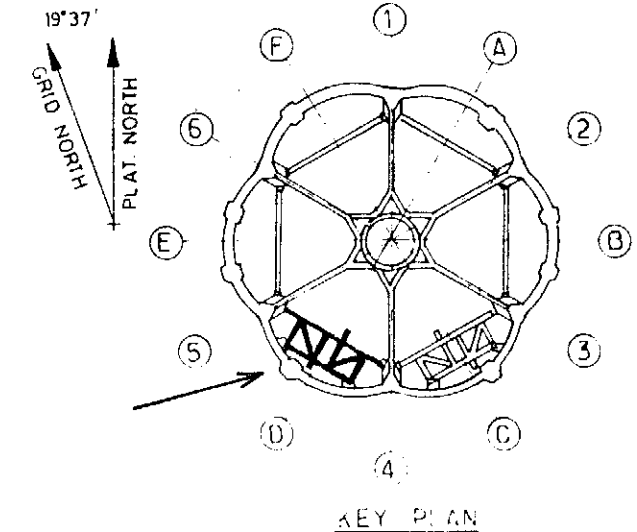

FREE LOCK PIPE END AND
GUIDE BOX ED 4

FREE LOCK PIPE END AND
GUIDE BOX ED 1

FIXED LOCK ED 2

FIXED LOCK ED 3

NOTES
FOR SECONDARY FRAME DETAILS SEE SK FF.91.36.35.1402. TO FF.91.36.35.1413.
FOR FREE LOCK PIPE ENDS AND GUIDE BOXES SEE SK FF.91.36.35.1414 / 1415 / 1416 / 1417.

						elf aquitaine norge a/s p.o.box 168 4001 Stavanger	 elf	Job no.	Installation CDP 1	System UNDERWATER	
1	12.83	UP DATED	BVH	JLC				Scale 	GENERAL VIEW OF SECONDARY FRAME SUPPORT CELL D LEVEL E		
Rev.	Date	DESCRIPTION	by	app.				Dwgr. no	FF 91-36-35-1401.	1	
Contractor JVD 1029.40.71.							FRIGG FIELD				







FRIGG FIELD

CDP 1 AS BUILT DRAWINGS

REFERENCE DRAWING LIST FOR:

[illegible][illegible]

						Job no.	Installation	System
						Scale	CDP 1	UNDERWATER
Rev.	Date	DESCRIPTION	by	app.		Dwgr. no.		Rev.
Contractor						FF		1401

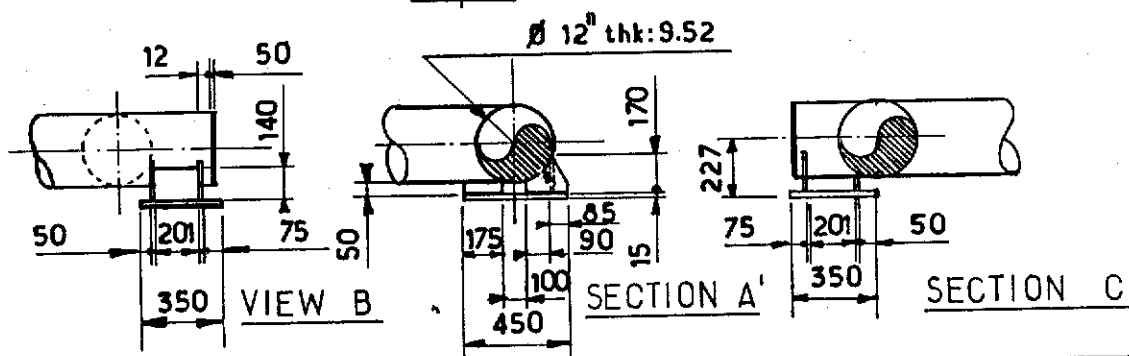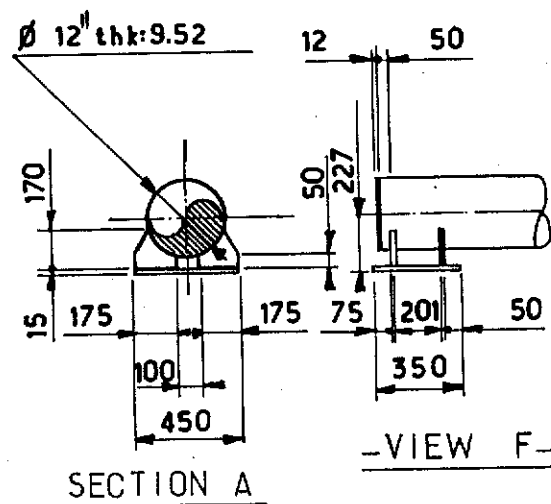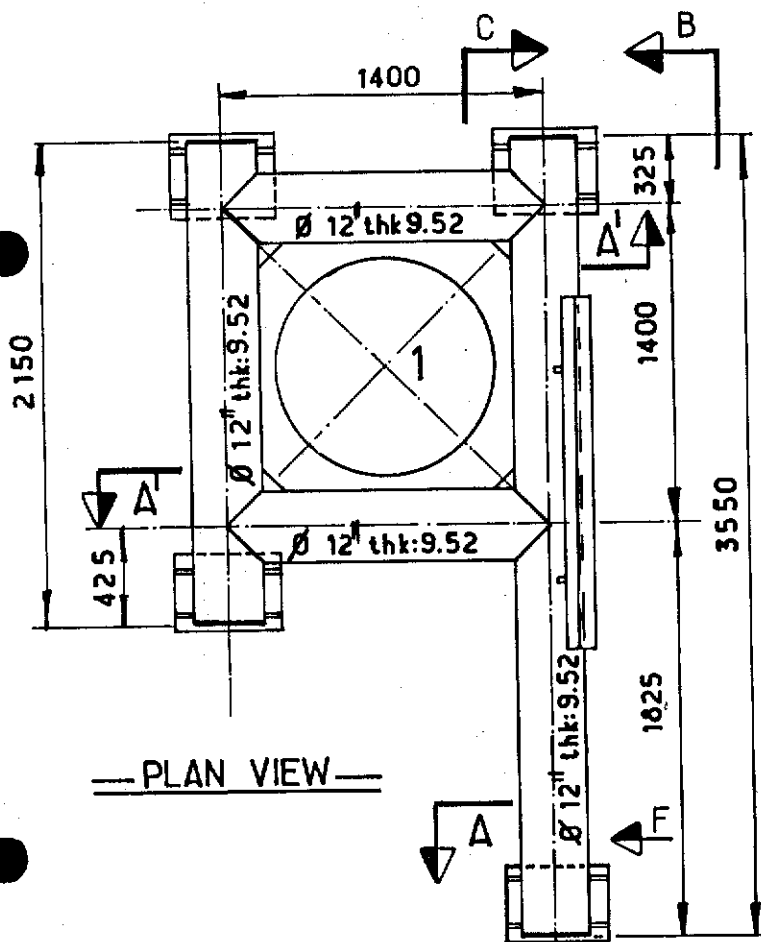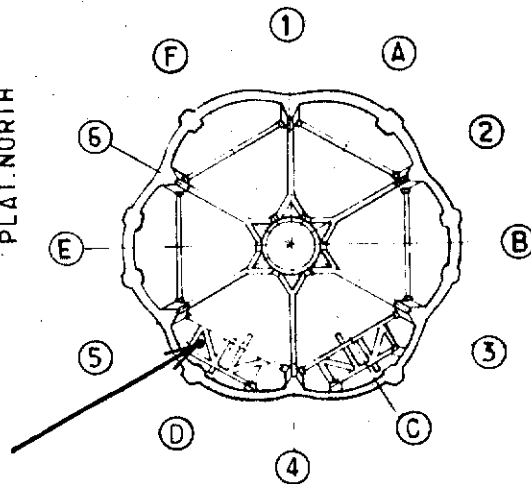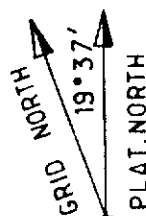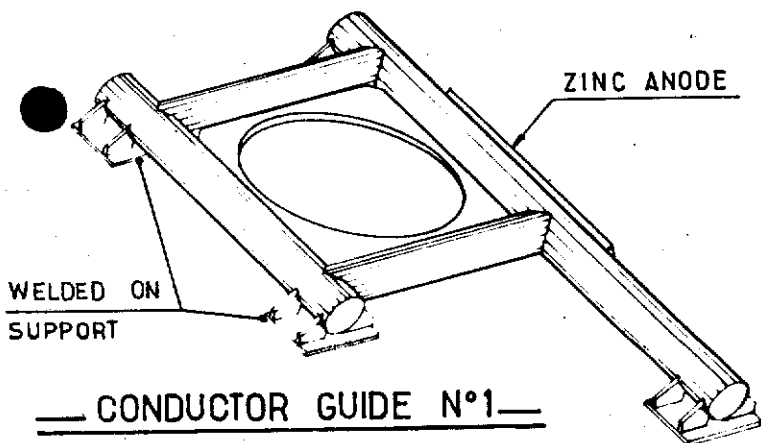

NOTES:

FOR LOCATION SEE SK FF. 91.36.35.1400

FOR CONDUCTOR SLEEVE SEE SK FF. 91.36.35.1491.

FOR ZINC ANODE SEE SK. FF 91.36.35.1587


				elf aquitaine norge a/s		Job no.	Installation CDP 1	System UNDERWATER
1	12.83	UP DATED	BVH JLC	p.o. box 168		Scale 1:33	CONDUCTOR GUIDE N°1 CELL D SECONDARY FRAME LEVEL E	
Rev.	Date	DESCRIPTION	by	app.		Dwgr. no.	FF 91.36.35.1402	1
Contractor JVD 1029-40.72.				4001 Stavanger		FRIGG FIELD		

CDP 1 AS BUILT DRAWINGS

REFERENCE DRAWING LIST FOR:



[illegible][illegible]

				elf aquitaine norge a/s p.o.box 168 4001 Stavanger		 elf		Job no. Scale		Installation CDP 1		System UNDERWATER	
Rev. Date DESCRIPTION by app.								Dwgr. no. FF — — 1402		Rev.		Sheet /	
Contractor				4001 Stavanger		FRIGG FIELD							

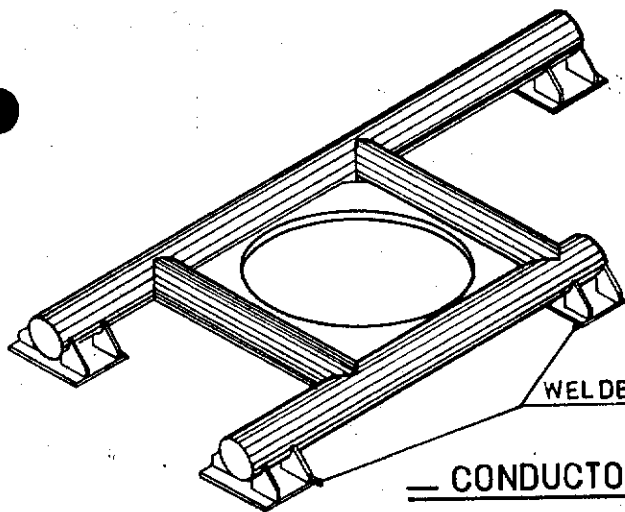


WELDED ON SUPPORT


— CONDUCTOR GUIDE N°2 —

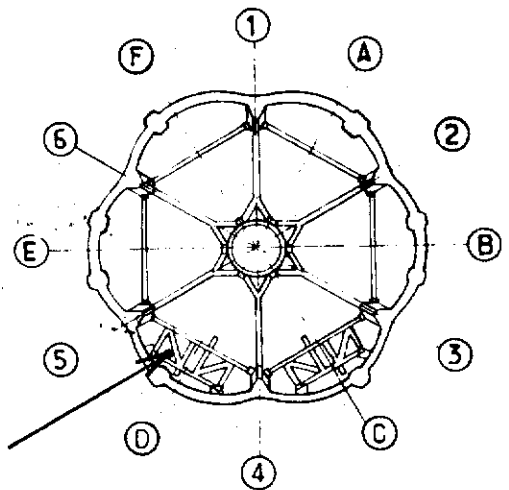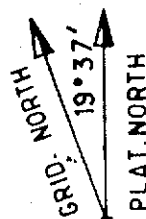


KEY PLAN

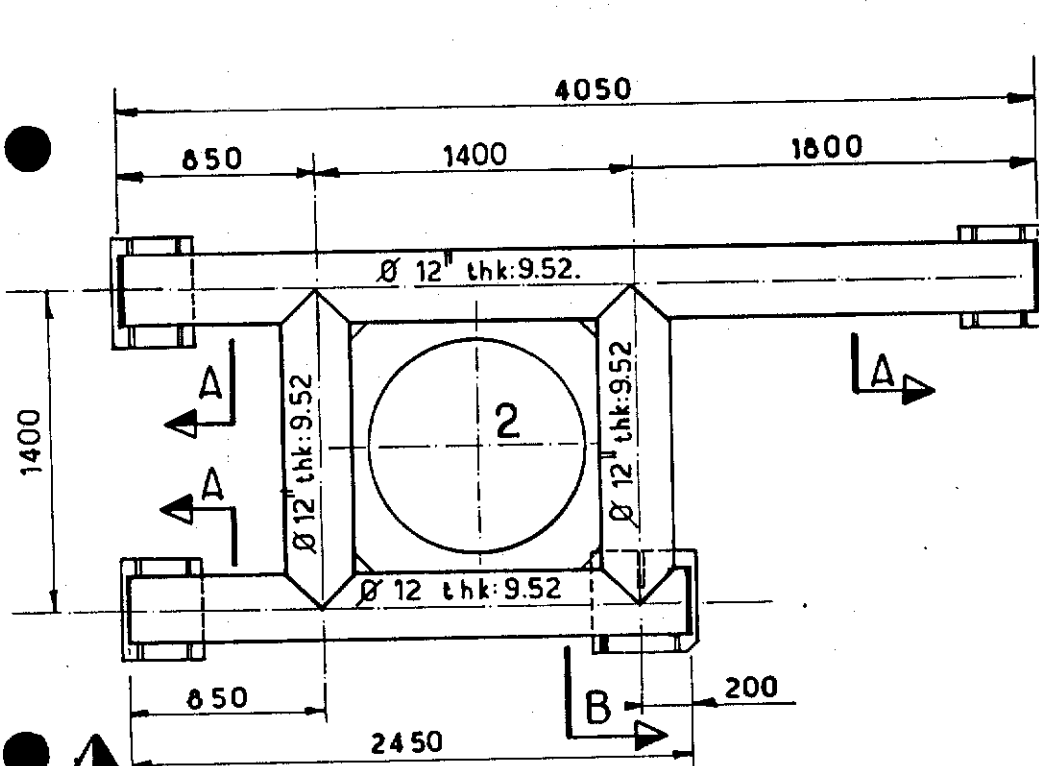

— PLAN VIEW —

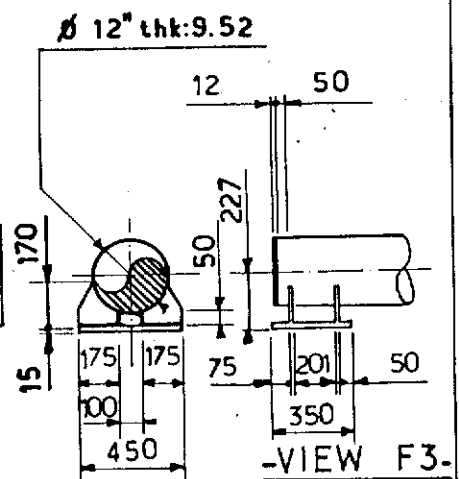

— SECTION A —

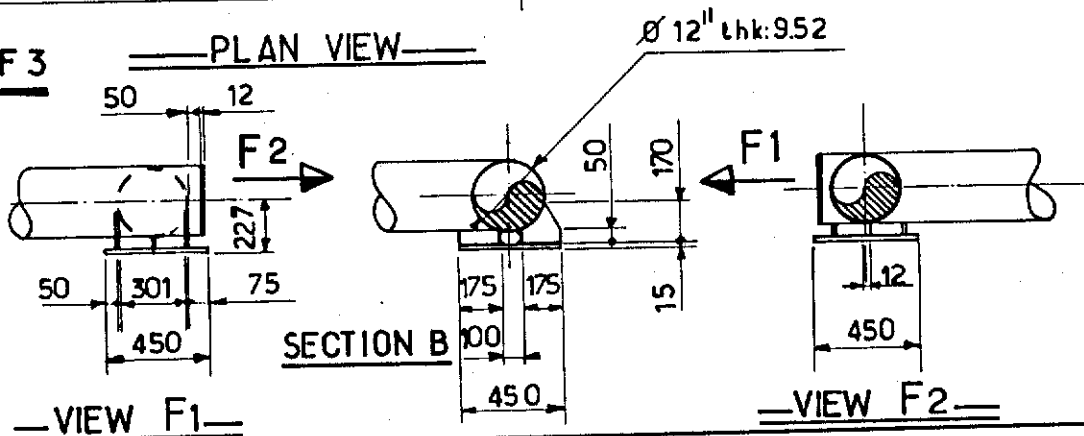

— VIEW F1 —

— VIEW F2 —

NOTES

FOR LOCATION SEE SK FF. 91. 36. 35. 1400.
FOR CONDUCTOR SLEEVE SEE SK FF. 91. 36. 35. 1491.


elf aquitaine norge a/s p.o. box 168 4001 Stavanger				elf		Job no.	Installation CDP 1	System UNDERWATER
1	12.83	UP DATED	BVH	HC		Scale 1:33	CONDUCTOR GUIDE N°2 CELL D SECONDARY FRAME LEVEL E	
Rev.	Date	DESCRIPTION	by	app.		Dwgr. no.	FF 91. 36. 35. 1403.	Rev 1
Contractor JVD1029_40.73				FRIGG FIELD		Sheet		

CDP 1 AS BUILT DRAWINGS



REFERENCE DRAWING LIST FOR:

[illegible][illegible]


				elf aquitaine norge a/s p.o.box 168 4001 Stavanger		 elf		Job no. Scale		Installation CDP 1		System UNDERWATER	
Rev. Date DESCRIPTION by app.				Contractor		FRIGG FIELD		Dwgr. no. FF — — 1403		Rev		Sheet /	

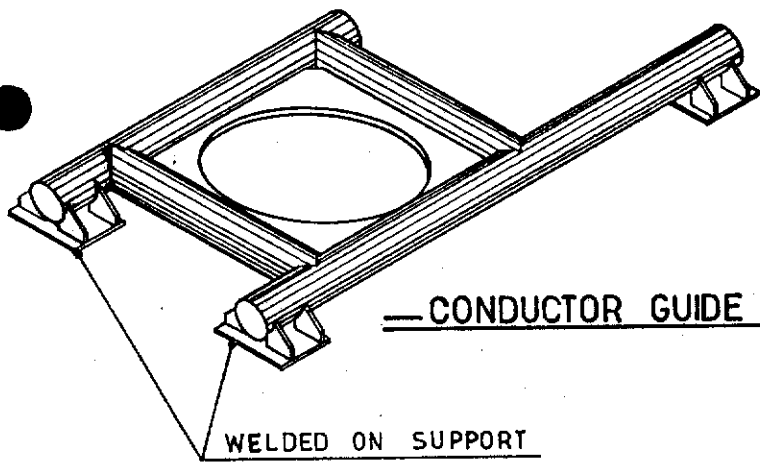

— CONDUCTOR GUIDE N°3 —

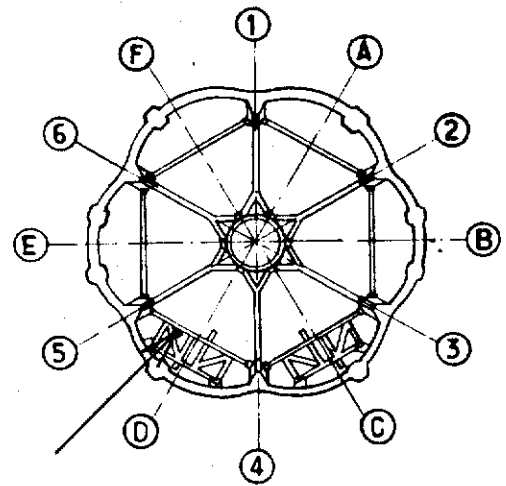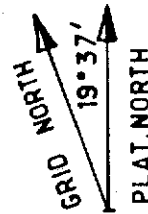


KEY PLAN

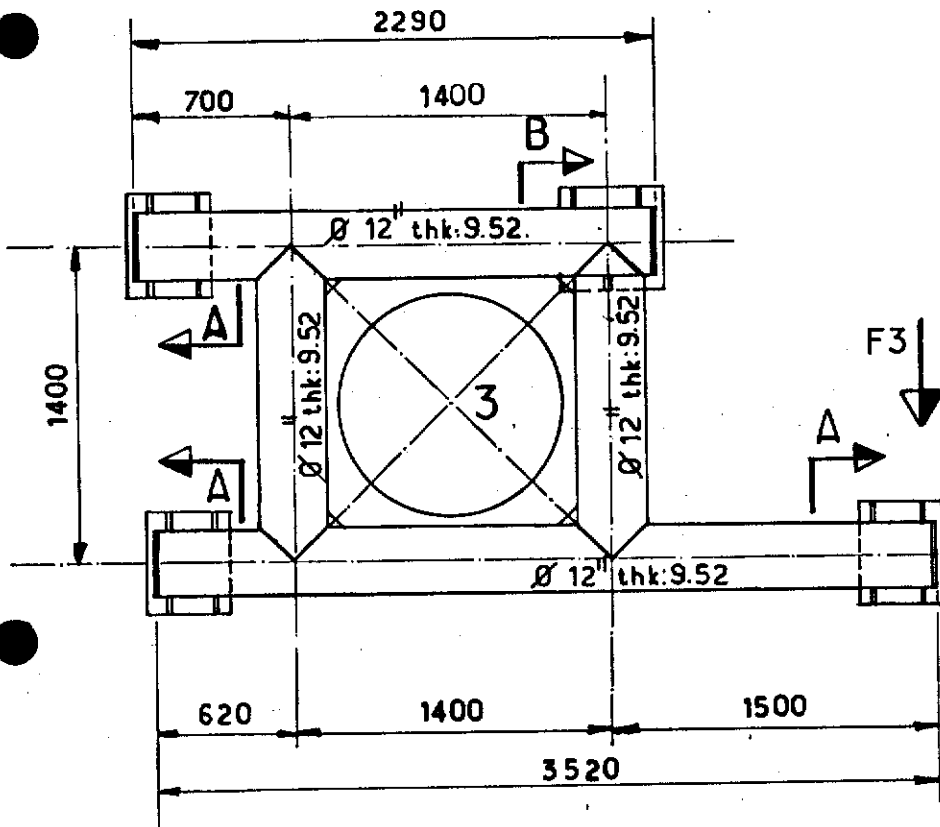


— PLAN VIEW —

— SECTION A —

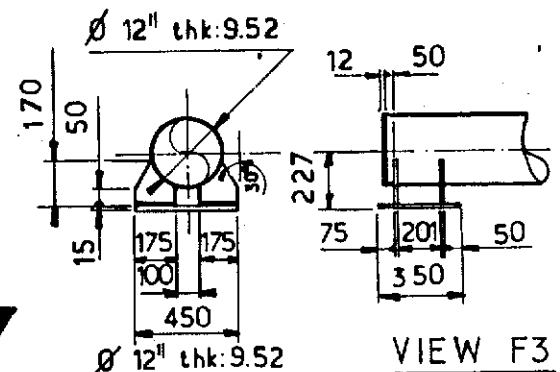

— SECTION B —

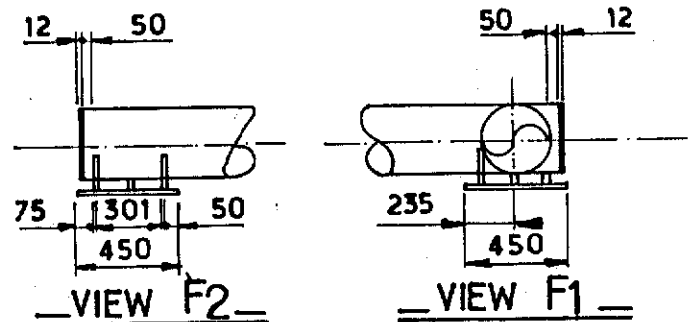

NOTES

FOR LOCATION SEE SK FF. 91.36.35.1400
FOR CONDUCTOR SLEEVE SEE SK FF. 91.36.35.1491.

1	1283	UP DATED	B.V.H	J.L.C
Rev.	Date	DESCRIPTION	by	app.
Contractor JVD 1029_40.74.				

elf
aquitaine
norge a/s
p.o. box 168
4001 Stavanger



FRIGG FIELD

Job no.	Installation CDP 1	System UNDERWATER
Scale 1:33	CONDUCTOR GUIDE N°3 CELL D SECONDARY FRAME LEVEL E	
Dwgr. no. FF. 91.36.35.1404	Rev. 1	Sheet /




CDP 1 AS BUILT DRAWINGS

●REFERENCE DRAWING LIST FOR:


[illegible][illegible]

						elf aquitaine norge a/s p.o.box 168 4001 Stavanger	 elf	Job no.	Installation CDP 1	System UNDERWATER	
								Scale			
Rev.	Date	DESCRIPTION	by	app.				Dwgr. no.		Rev	Sheet
Contractor							FRIGG FIELD	FF	1404		/


— CONDUCTOR GUIDE N°4 —

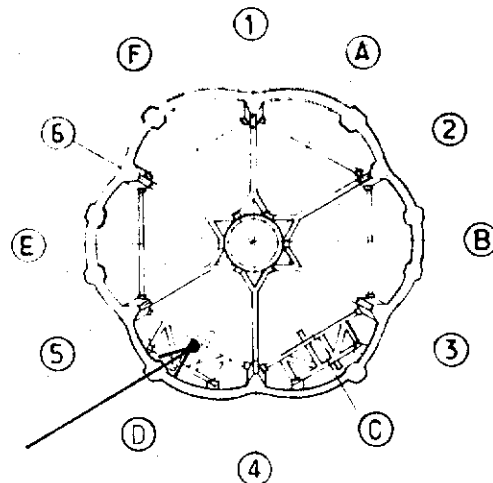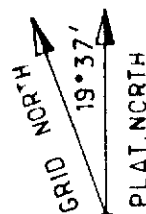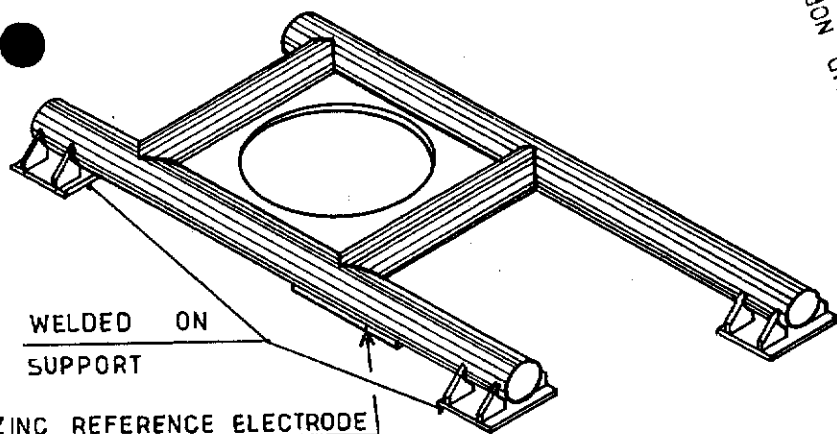


KEY PLAN

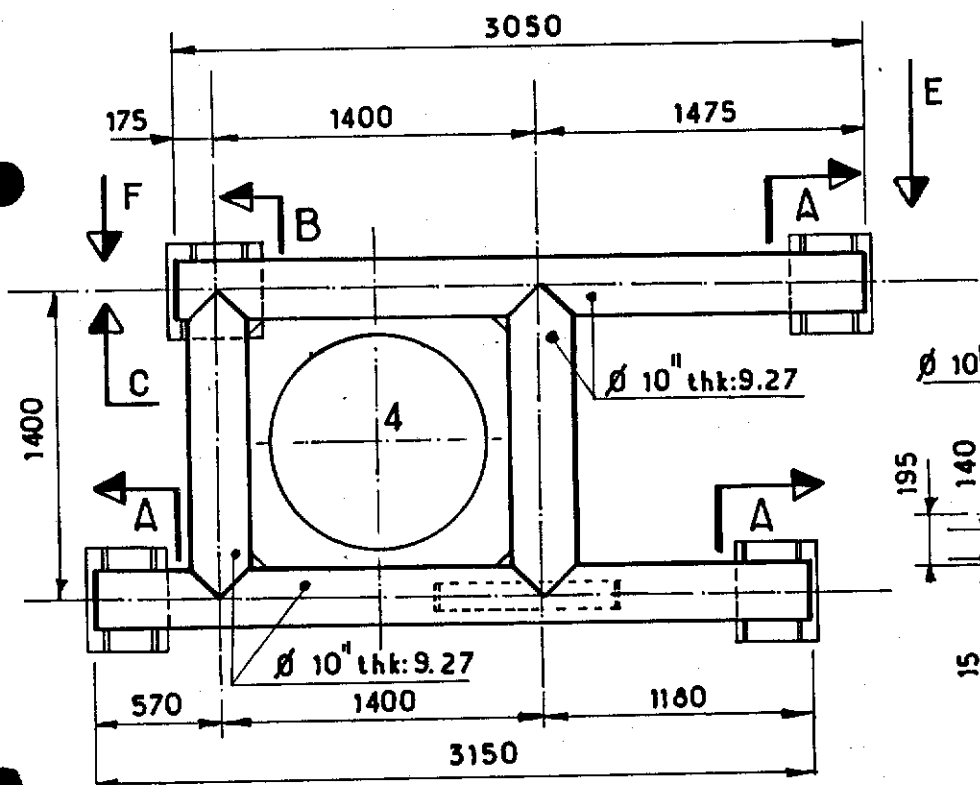


— PLAN VIEW —

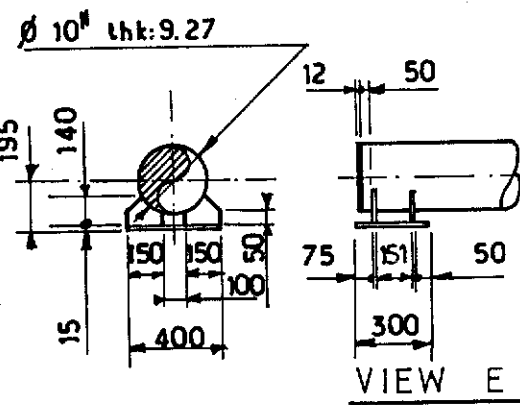


— SECTION A —

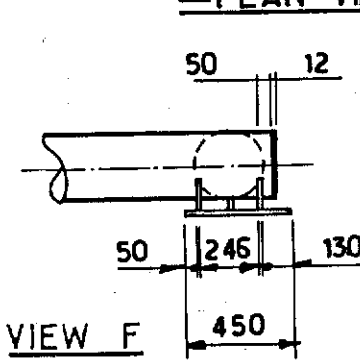

VIEW F

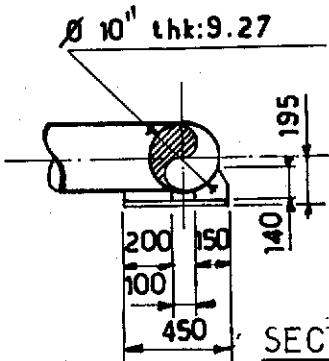

SECTION B

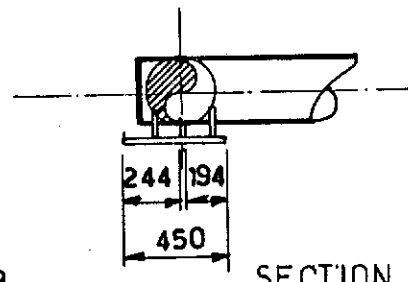

SECTION C

NOTES :

FOR LOCATION SEE SK FF. 91.36.35.1400
FOR CONDUCTOR SLEEVE SEE SK FF. 91.36.35.1491

FOR ZINC REFERENCE ELECTRODE SEE
SK FF 91.36.35.1588

					 elf	Job no.	Installation CDP 1	System UNDERWATER
						Scale 1:33	CONDUCTOR GUIDE N°4 CELL D SECONDARY FRAME LEVEL E	
						Dwgr. no.	FF. 91.36.35.1405.	1
1	12.83	UP DATED	BVH	JLC	elf aquitaine norge a/s p.o.box 168 4001 Stavanger			
Rev.	Date	DESCRIPTION	by	app.				
Contractor JVD 1029_40_75_						FRIGG FIELD		


CDP 1 AS BUILT DRAWINGS

REFERENCE DRAWING LIST FOR:

[illegible][illegible]


					elf aquitaine norge a/s p.o.box 168 4001 Stavanger	 elf	Job no.	Installation CDP 1	System UNDERWATER	
							Scale			
Rev.	Date	DESCRIPTION	by	app.	Contractor	FRIGG FIELD	Dwgr. no. FF		Rev.	Sheet
									1405	

WELDED ON
SUPPORT

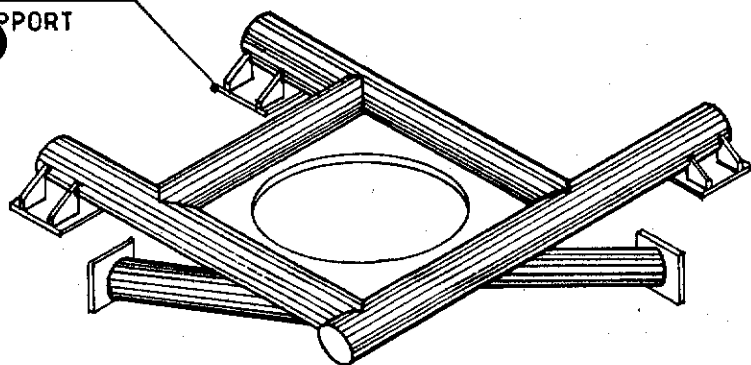


—CONDUCTOR GUIDE N°5—


GRID NORTH
19° 37'
PLAT NORTH

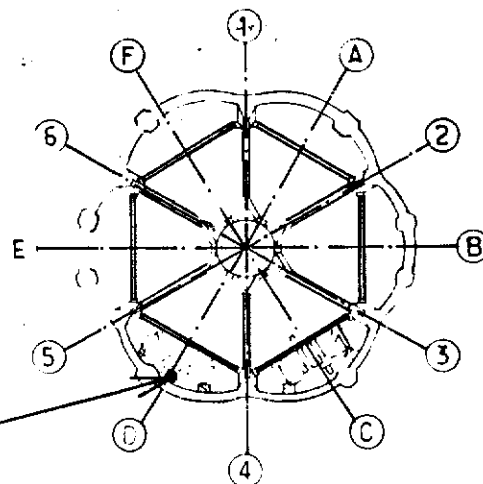

KEY PLAN

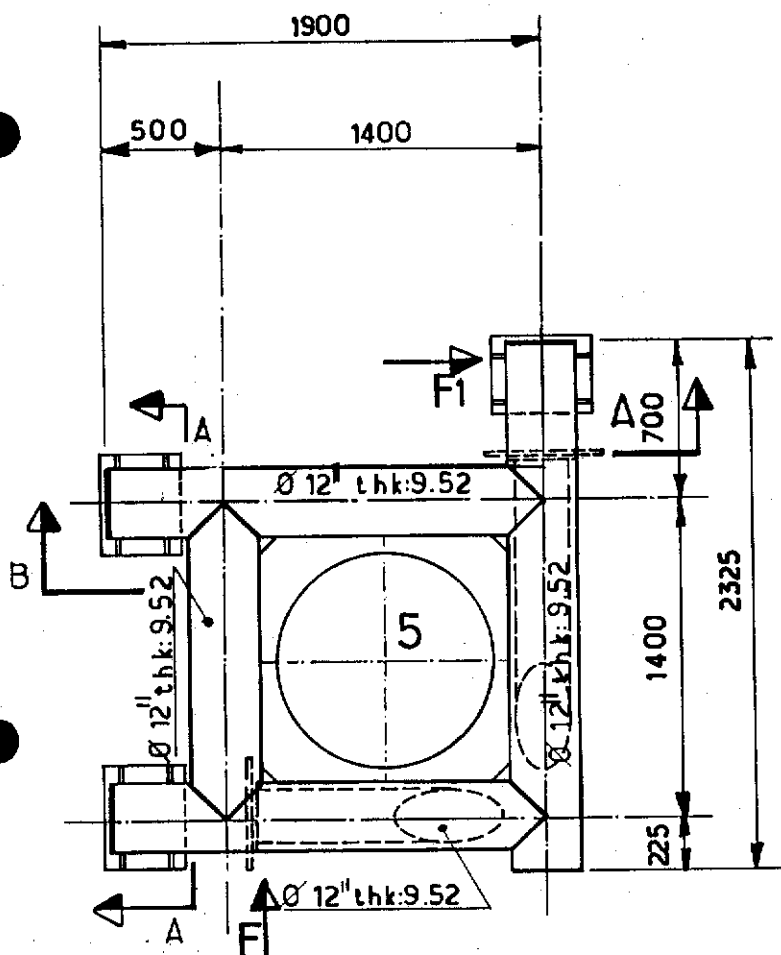

—PLAN VIEW—

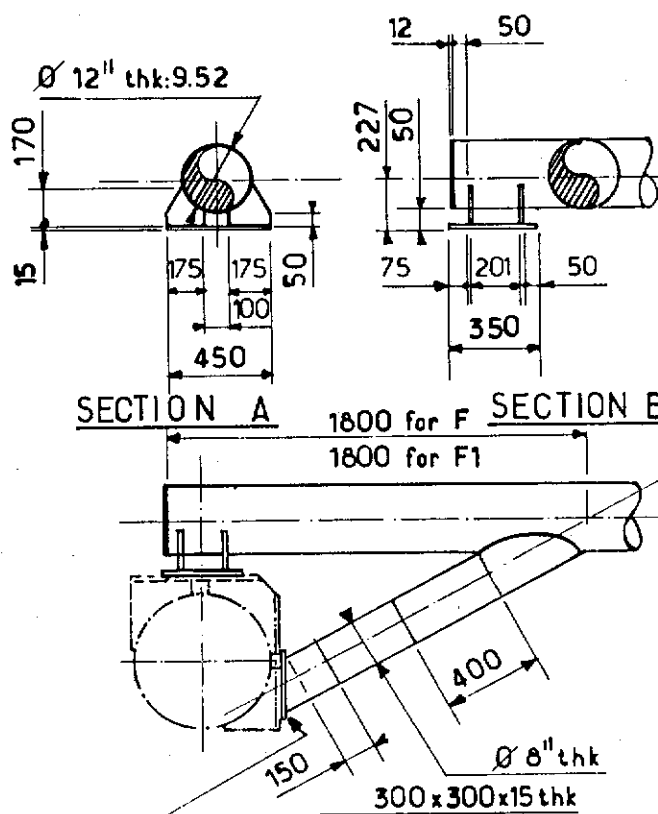

—VIEW F AND F1—

NOTES

FOR LOCATION SEE SK FF. 91.36.35.1400

FOR CONDUCTOR SLEEVE SEE SK FF. 91.36.35.1491

					elf aquitaine norge a/s p.o.box 168 4001 Stavanger	 elf	Job no.	Installation CDP 1	System UNDERWATER		
1	12.83	UP DATED	BVH	JLC			Scale 1:33	CONDUCTOR GUIDE N°5 CELL D SECONDARY FRAME LEVEL E			
Rev.	Date	DESCRIPTION	by	app.			Dwgr. no	FF_91.36.35.1406		Rev. 1	Sheet 1
Contractor JVD 1029_40.76					FRIGG FIELD						

CDP 1 AS BUILT DRAWINGS

REFERENCE DRAWING LIST FOR:

[illegible][illegible]


<table border="1"> <tr><td></td><td></td><td></td><td></td><td></td></tr> <tr><td></td><td></td><td></td><td></td><td></td></tr> <tr><td></td><td></td><td></td><td></td><td></td></tr> <tr><td></td><td></td><td></td><td></td><td></td></tr> </table>																					elf aquitaine norge a/s p.o.box 168 4001 Stavanger	 elf	Job no.	Installation CDP 1	System UNDERWATER	
Rev.	Date	DESCRIPTION	by	app.	Scale																					
Contractor					Dw gr. no.	FF	1406	Rev	Sheet																	

ZINC ANODE


WELDED ON
SUPPORT

GRID NORTH
19°37'
PLAT. NORTH

—CONDUCTOR GUIDE N°6—

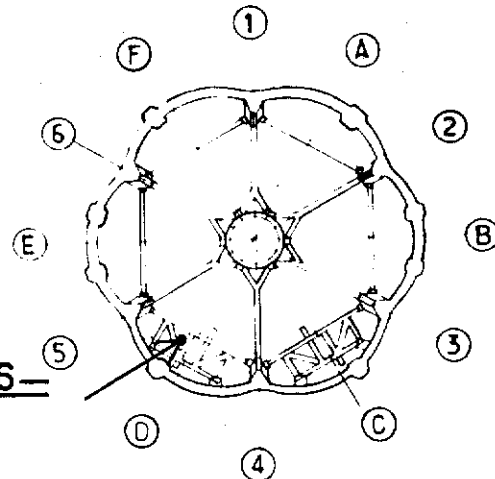

KEY PLAN

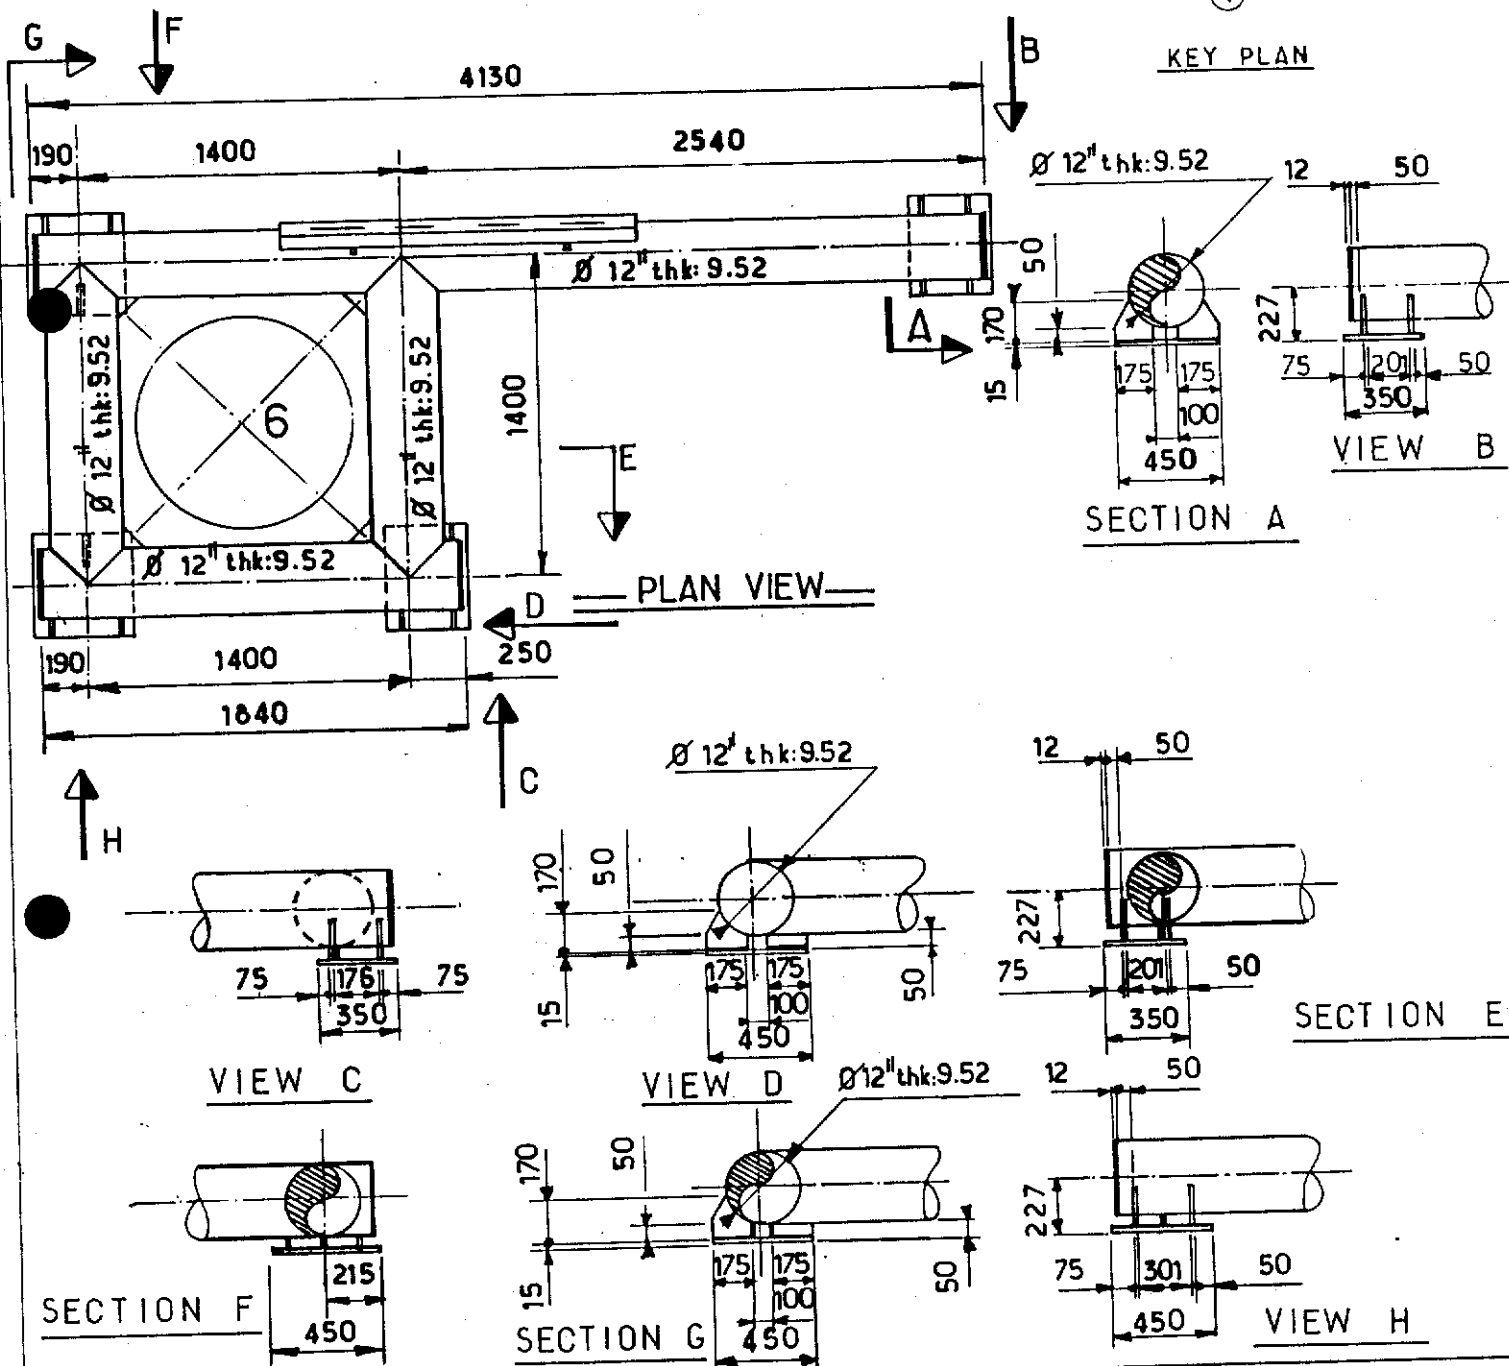

NOTES

FOR LOCATION SEE SK FF.91.36.35.1400
FOR CONDUCTOR SLEEVE SEE SK FF.91.36.35.1491

FOR ZINC ANODE SEE SK FF.91.36.35.1587

						elf aquitaine norge a/s p.o.box 168 4001 Stavanger	 elf	Job no.	Installation CDP 1	System UNDERWATER	
1	12.83	UP DATED	BYVH	JLC				Scale 1:33	CONDUCTOR GUIDE N°6 CELL D SECONDARY FRAME LEVEL E		
Rev.	Date	DESCRIPTION	by	app.				Dwgr. no.		Rev.	Sheet
Contractor JYD 1029_40.77.								FF 91.36.35.1407.		1	/

CDP 1 AS BUILT DRAWINGS

REFERENCE DRAWING LIST FOR:

[illegible]


				elf aquitaine norge a/s p.o.box 168 4001 Stavanger	 elf	Job no.	Installation CDP 1	System UNDERWATER	
						Scale			
Date	DESCRIPTION	by	app.	4001 Stavanger FRIGG FIELD	Dwgr. no. FF	_____ 14 07		Rev.	Sheet /
Sector									

ZINC ANODE


WELDED ON
PRIMARY FRAME

CONDUCTOR GUIDE N°7


GRID NORTH
19° 37'
PLAT. NORTH

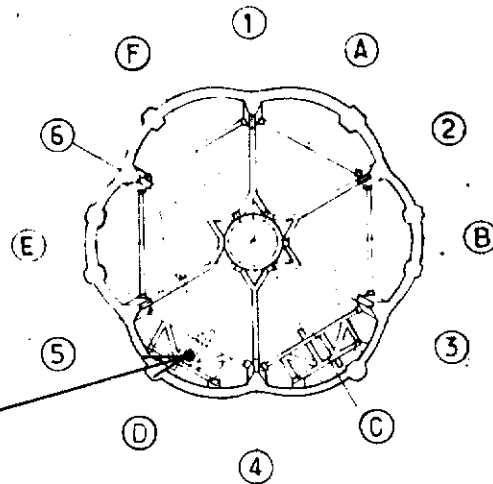


KEY PLAN

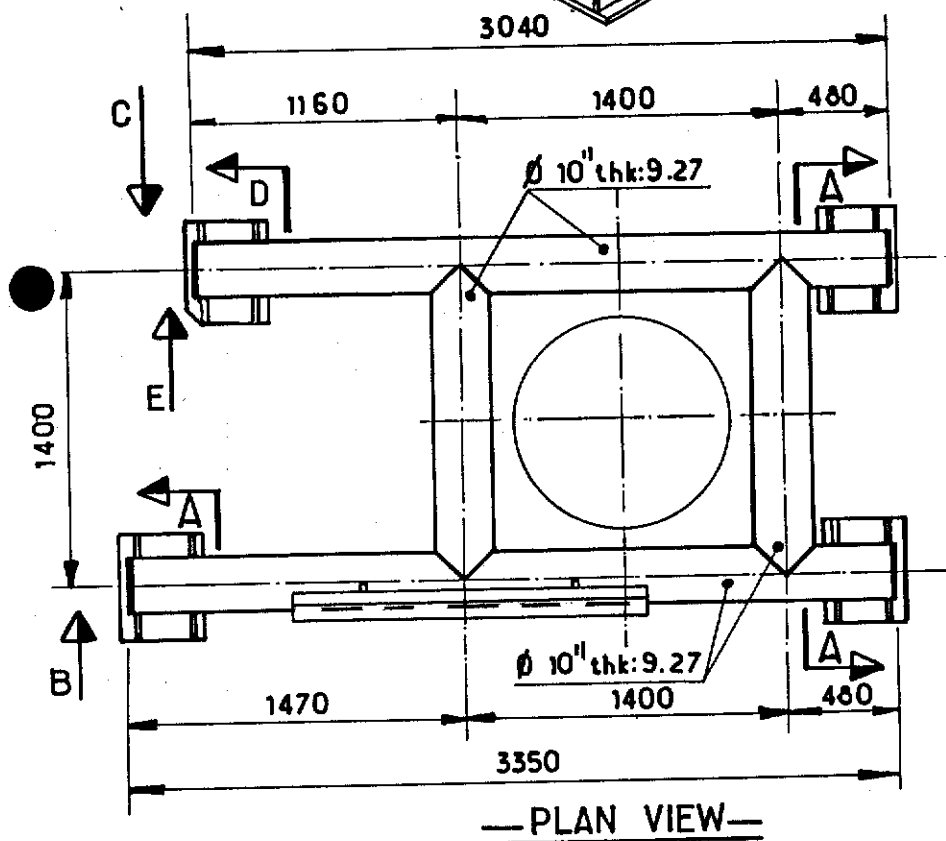


PLAN VIEW

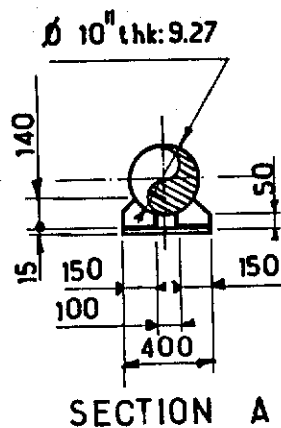


SECTION A

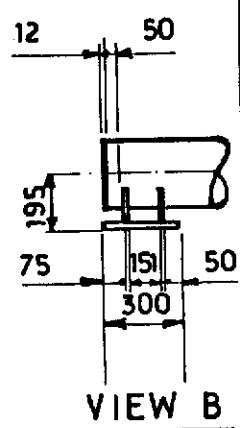


VIEW B

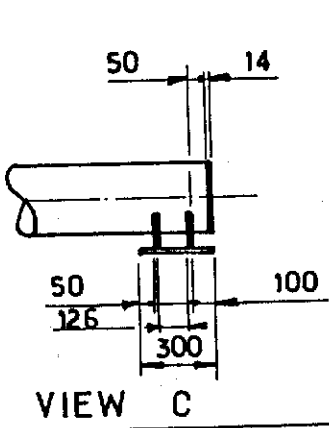

VIEW C

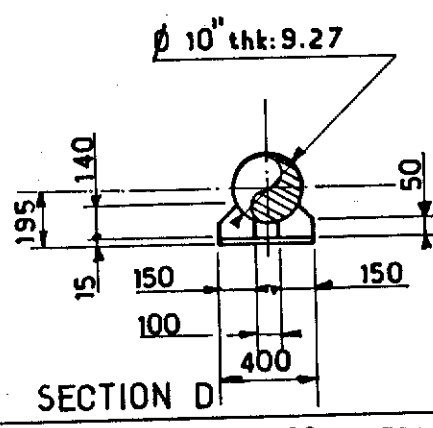

SECTION D

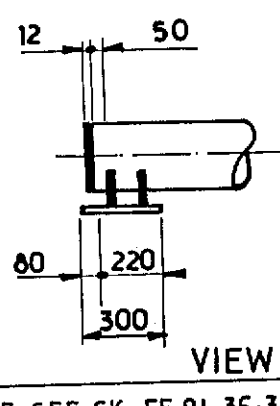

VIEW E

NOTES FOR LOCATION SEE SK FF.91.36.35.1400 FOR ZINC ANODE SEE SK. FF 91-36-35-1587
FOR CONDUCTOR SLEEVE SEE SK FF. 91-36-35-1491

					 elf	Job no.	Installation CDP 1	System UNDERWATER
1	12.83	UP DATED	BVH	JLC		Scale 1:33	CONDUCTOR GUIDE N°7 CELL D SECONDARY FRAME LEVEL E	
Rev.	Date	DESCRIPTION	by	app.		Dwgr. no	FF_91_36_35.1408	1
Contractor JVD 1029_40.78						4001 Stavanger		

CDP 1 AS BUILT DRAWINGS

REFERENCE DRAWING LIST FOR:


[illegible]

WELDED ON SUPPORT


ZINC REFERENCE
ELECTRODE

— CONDUCTOR GUIDE N°8 —

GRID NORTH
19° 37'
PLAT. NORTH

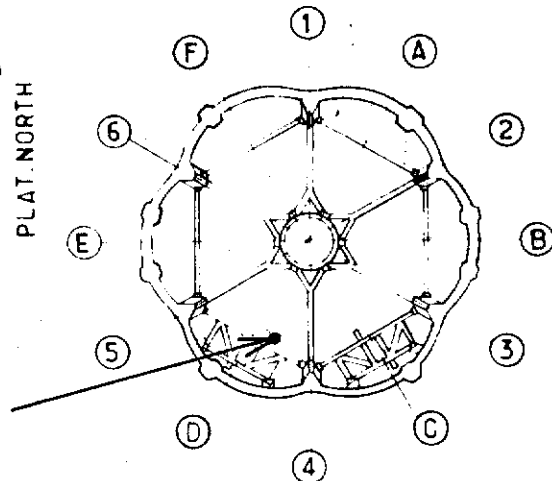


KEY PLAN

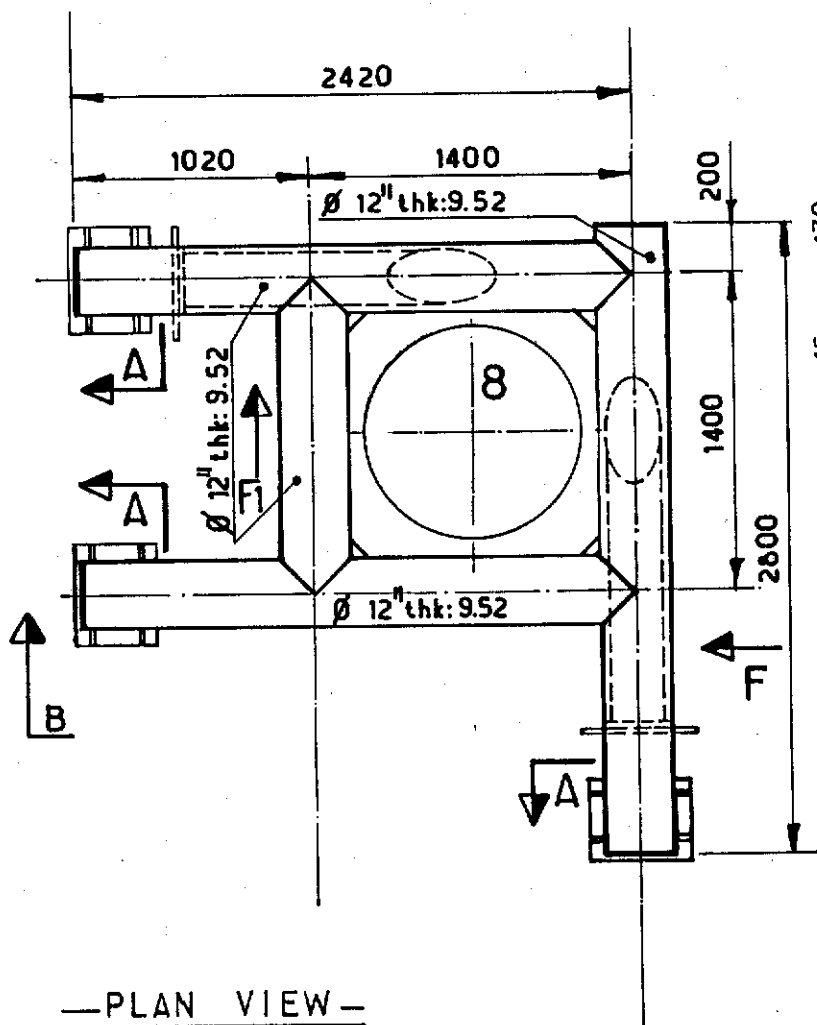

— PLAN VIEW —

SECTION A

VIEW B

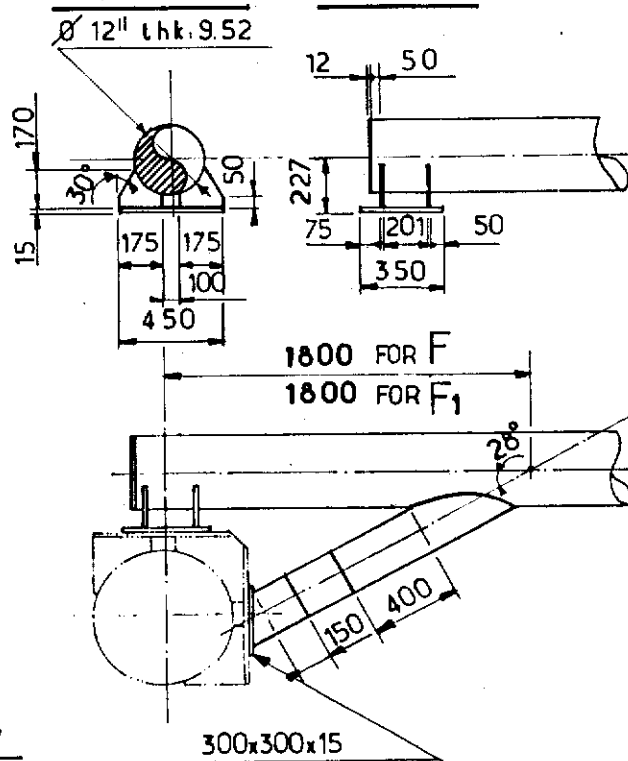

— VIEW F AND F1 —

NOTES

FOR LOCATION SEE SK. FF. 91.36.35.1400.
FOR CONDUCTOR SLEEVE SEE SK. FF. 91.36.35.1491.






				elf aquitaine norge a/s p.o. box 168 4001 Stavanger	 elf	Job no.	Installation CDP 1	System UNDERWATER
1	12.83	UP DATED	BVH/LLC			Scale 1:33	CONDUCTOR GUIDE N°8 CELL D	
Rev.	Date	DESCRIPTION	by	app.		Dwgr. no	SECONDARY FRAME	LEVEL E
Contractor JVD 1029_40. 79				4001 Stavanger	FRIGG FIELD	FF. 91.36.35.1409		1

CDP 1 AS BUILT DRAWINGS

●REFERENCE DRAWING LIST FOR:

[illegible]

						Job no.	Installation	System	
							CDP 1	UNDERWATER	
Rev.	Date	DESCRIPTION	by	app.		Scale			
Contractor						Dwgr. no.		Rev	Sheet
						FF	1409		/

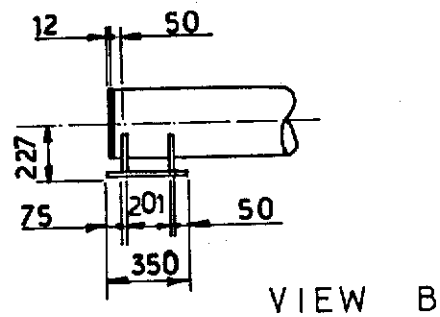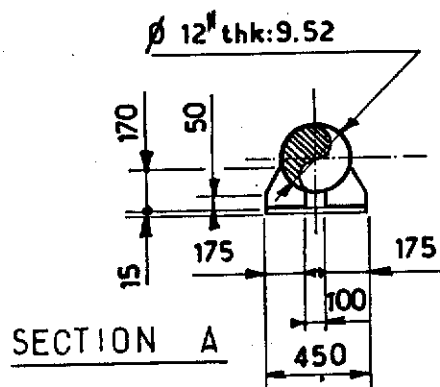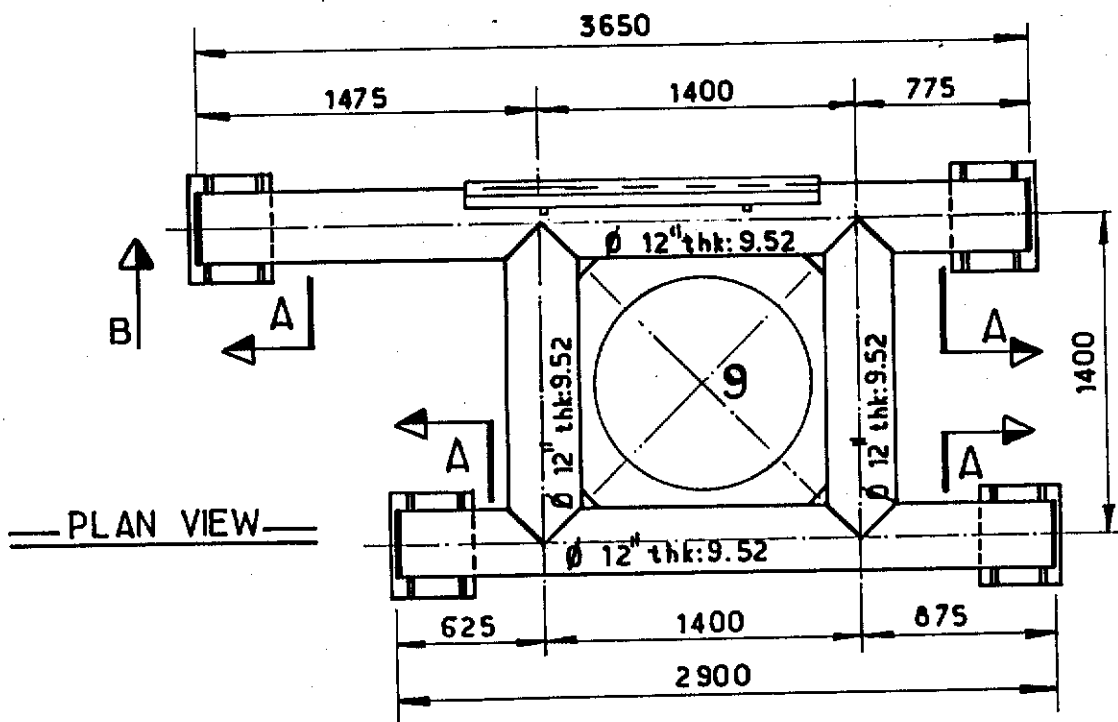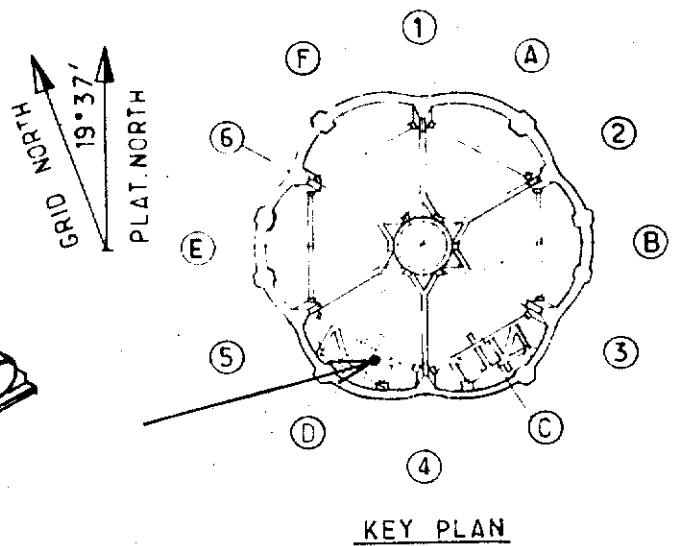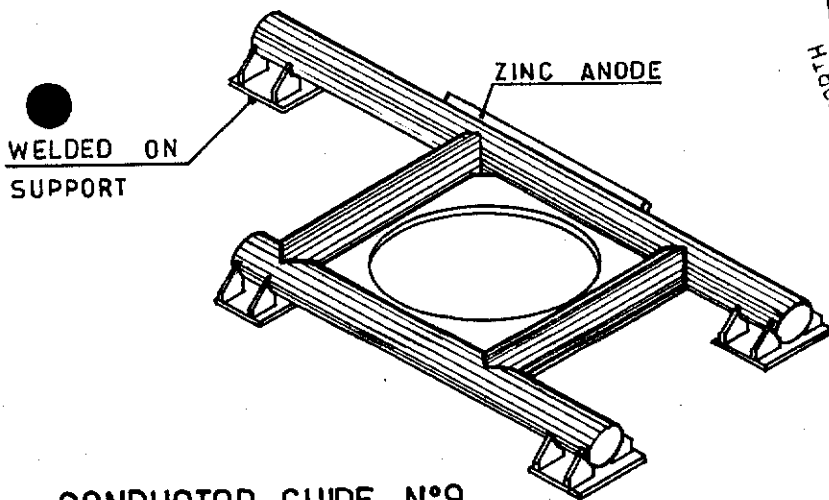

NOTES

FOR LOCATION SEE SK FF.91.36.35.1400.
FOR CONDUCTOR SLEEVE SEE SK FF.91.36.35.1491.

FOR ZINC ANODE SEE SK.FF 91-36-35-1587


				elf aquitaine norge a/s		Job no.	Installation CDP 1	System UNDERWATER
1	12.83	UP DATED	BVH J.L.C.	p.o.box 168 4001 Stavanger		Scale 1:33	CONDUCTOR GUIDE N°9 CELL D SECONDARY FRAME LEVEL E	
Rev.	Date	DESCRIPTION	by	app.		Dwgr. no	FF 91 36.35.1410.	1
Contractor JVD 1029_40_80.					FRIGG FIELD			

CDP 1 AS BUILT DRAWINGS



REFERENCE DRAWING LIST FOR:

[illegible]


				elf aquitaine norge a/s p.o.box 168 4001 Stavanger	 elf	Job no.	Installation CDP 1		System UNDERWATER	
						Scale				
Rev.	Date	DESCRIPTION	by	app.	FRIGG FIELD	Dwgr. no.	FF — — 1410		Rev	Sheet /
Contractor										

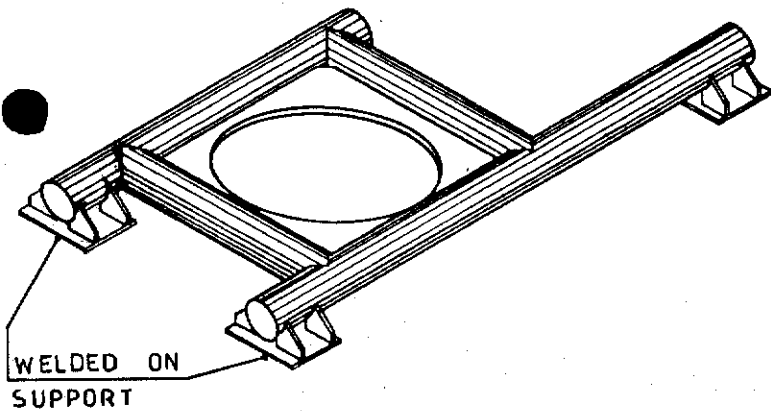

— CONDUCTOR GUIDE N°10 —

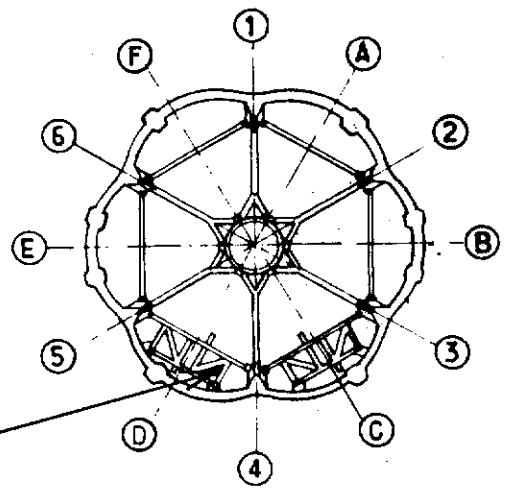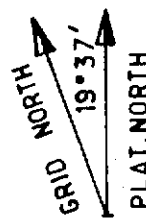


KEY PLAN

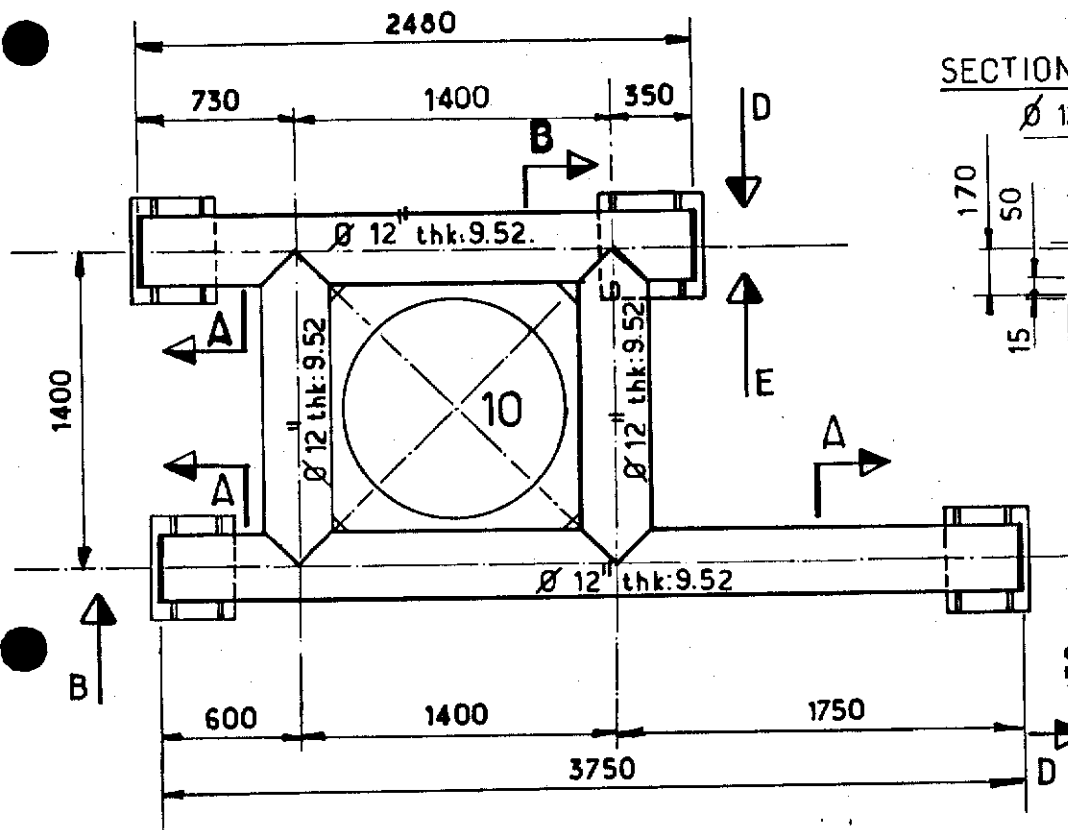


— PLAN VIEW —


SECTION A

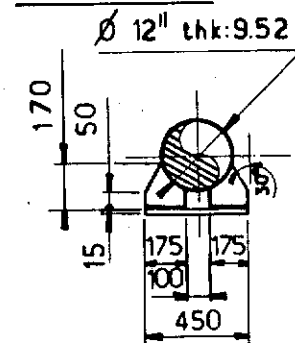


VIEW B

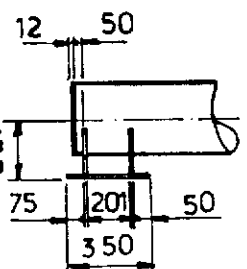

SECTION C

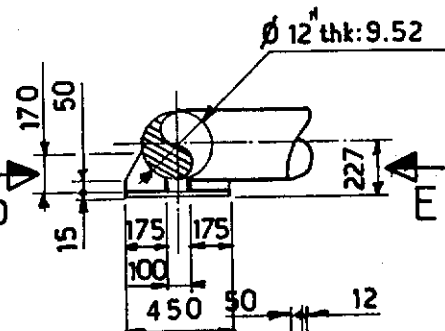


12 50

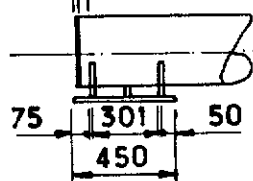

VIEW D

SECTION E

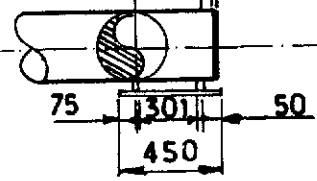

NOTES

FOR LOCATION SEE SK FF.91.36.35.1400.
FOR CONDUCTOR SLEEVE SEE SK FF.91.36.35.1491.

Rev.	Date	DESCRIPTION	by	app.
1	12,83	UP DATED	BVH	JLC
Contractor JVD 1029-40-81-				

elf
aquitaine
norge a/s
p.o. box 168
4001 Stavanger



FRIGG FIELD

Job no.	Installation CDP 1	System UNDERWATER
Scale 1:33	CONDUCTOR GUIDE N° 10 CELL D	
Dwgr. no.	FF.91.36.35.1411	Rev. 1
SECONDARY FRAME		SHEET

CDP 1 AS BUILT DRAWINGS

REFERENCE DRAWING LIST FOR:

[illegible][illegible]

					elf aquitaine norge a/s p.o.box 168 4001 Stavanger		Job no.	Installation CDP 1	System UNDERWATER	
							Scale			
Rev.	Date	DESCRIPTION	by	app.	FRIGG FIELD	Dwgr. no. FF <u> </u> <u> </u> <u>1411</u>	Rev	Sheet /		
Contractor										


				elf		 elf	Job no.	Installation CDP 1	System UNDERWATER		
1	12,83	UP DATED	B.VH	/11C			Scale 1:33	CONDUCTOR GUIDE N° 11 CELL D SECONDARY FRAME LEVEL E			
Rev.	Date	DESCRIPTION	by	app.		p.o.box 168	Dwgr. no				
Contractor JVD 1029_40_82.				4001 Stavanger		FRIGG FIELD	FF 91 36 35 1412			1	

CDP 1 AS BUILT DRAWINGS


REFERENCE DRAWING LIST FOR:

[illegible]

				elf aquitaine norge a/s p.o.box 168 4001 Stavanger	 elf	Job no.	Installation CDP 1	System UNDERWATER		
						Scale				
Rev.	Date	DESCRIPTION	by	app.	FRIGG FIELD	Dwgr. no.			Rev.	Sheet
Contractor						4001 Stavanger	FF	1412		

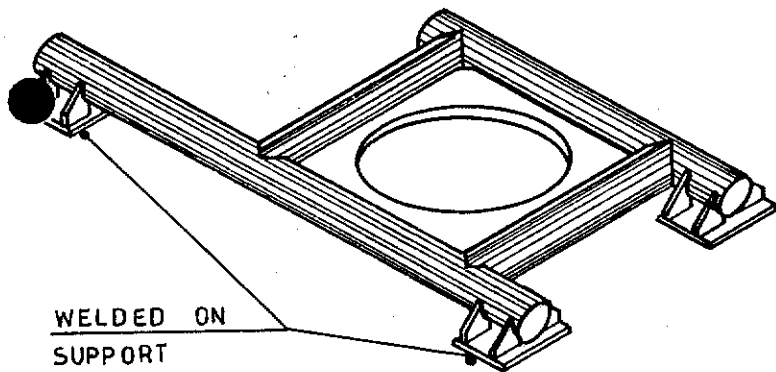


GRID NORTH
19° 37'
PLAT. NORTH

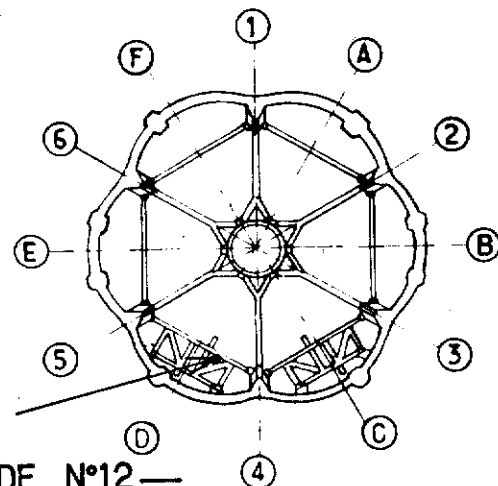


— CONDUCTOR GUIDE N°12 —

KEY PLAN

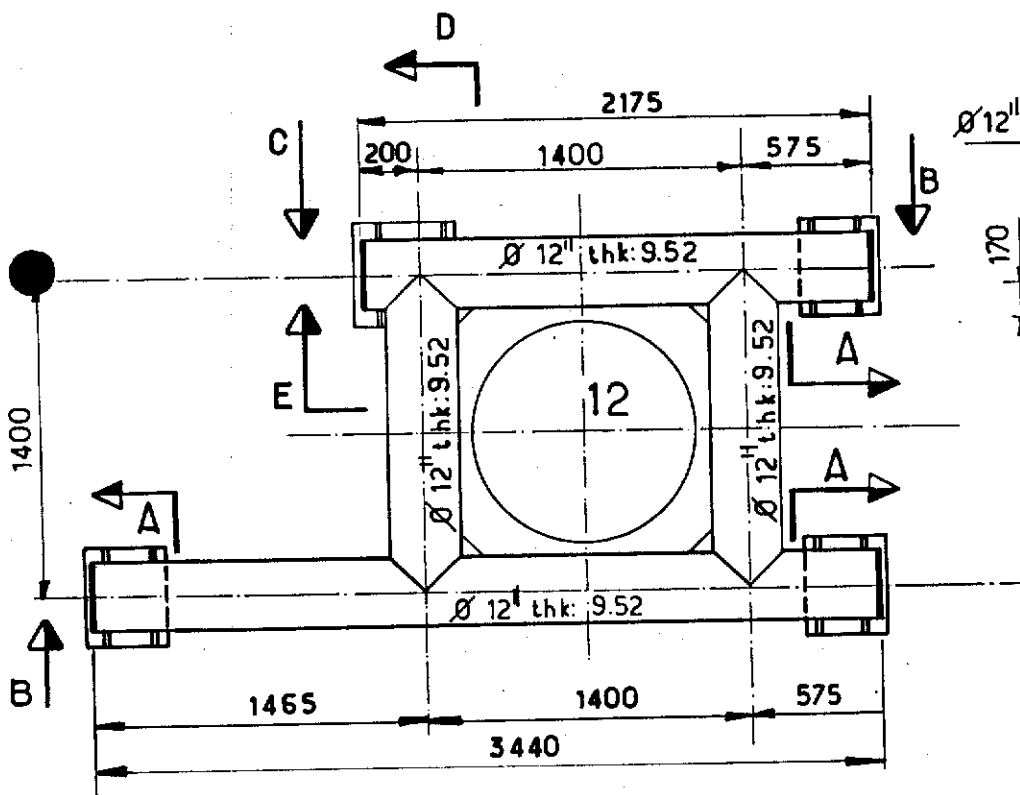


—PLAN VIEW—

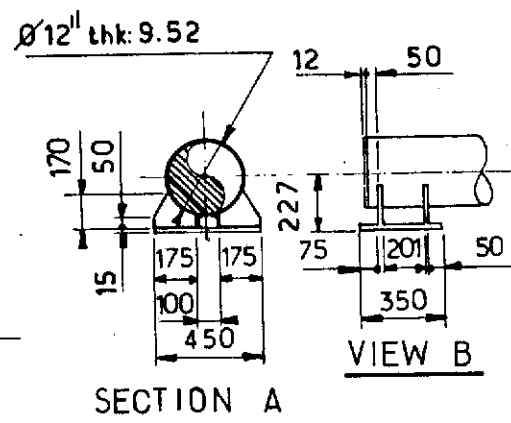


SECTION A


VIEW B

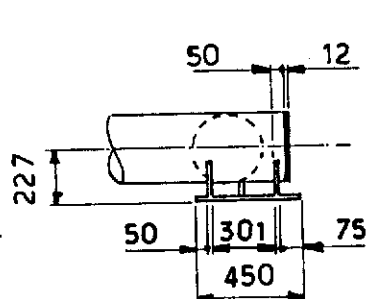

VIEW C

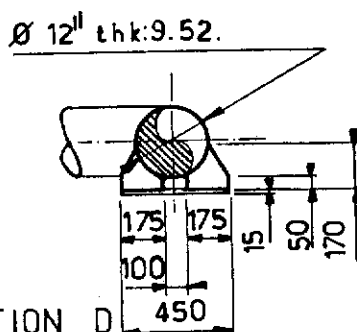

SECTION D

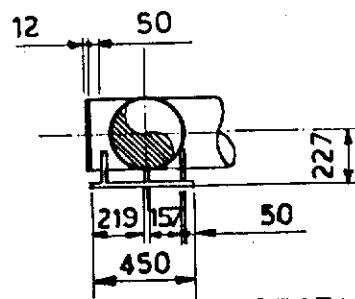

SECTION E

NOTES

FOR LOCATION SEE SK FF. 91.36.35.1400
FOR CONDUCTOR SLEEVE SEE SK FF. 91.36.35.1491.


					elf aquitaine norge a/s p.o.box 168 4001 Stavanger	 FRIGG FIELD	Job no.	Installation CDP 1	System UNDERWATER	
1	1283	UP DATED	BVH	JLC			Scale 1:33	CONDUCTOR GUIDE N°12 CELL D SECONDARY FRAME LEVEL E		
Rev.	Date	DESCRIPTION	by	app.			Dwgr. no.		Rev	Sheet
Contractor JVD 1029_40_83.							FF 91.36.35_1413		1	/

CDP 1 AS BUILT DRAWINGS

REFERENCE DRAWING LIST FOR:


[illegible]

				elf		Job no.		Installation		System	
				aquitaine				CDP 1		UNDERWATER	
				norge a/s				Scale			
Rev. Date DESCRIPTION by app.				p.o.box 168		Dwgr. no.				Rev	
Contractor				4001 Stavanger		FF		1413		Sheet	


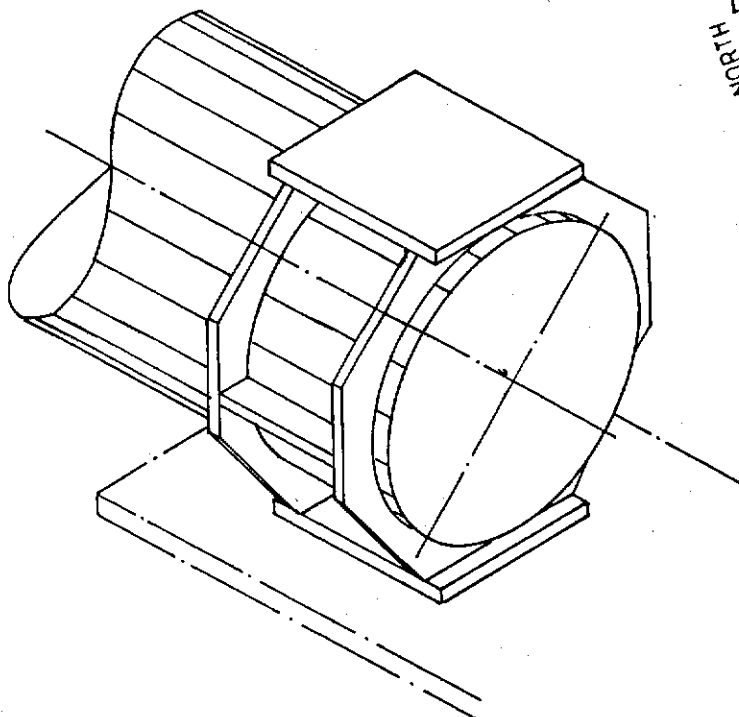


VIEW F

DIR. NORTH
19° 37'
PLAT. NORTH

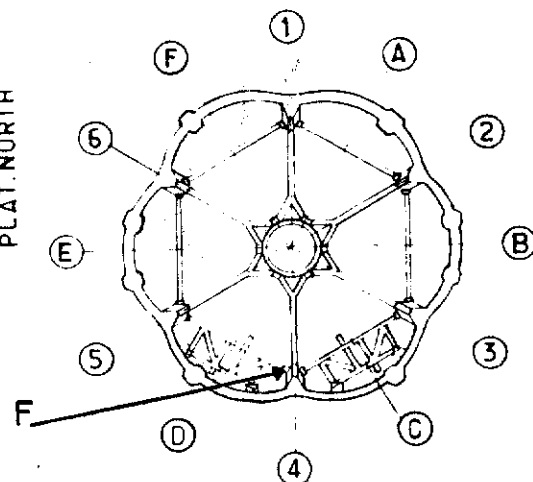

KEY PLAN

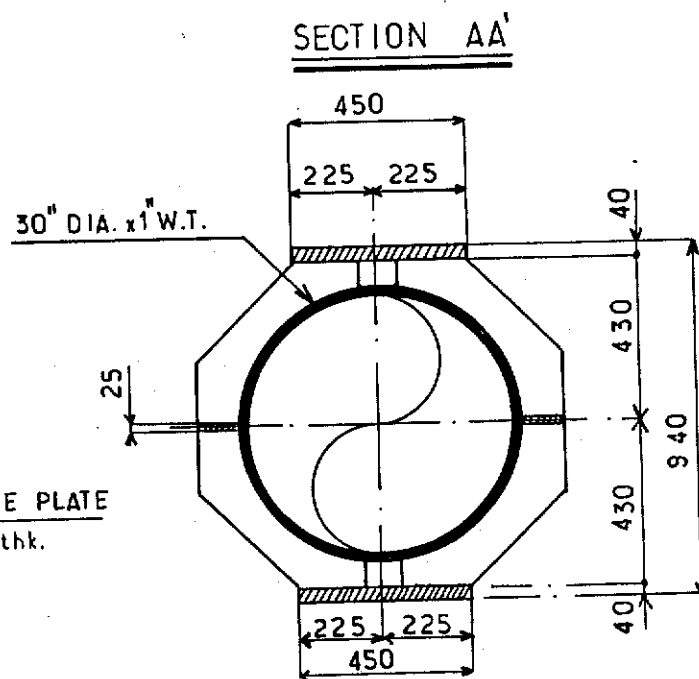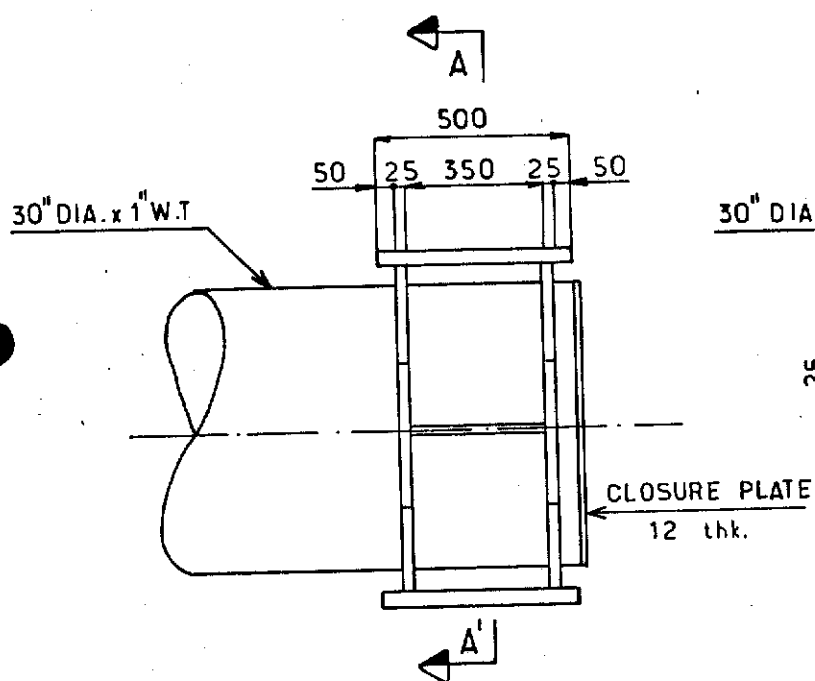

NOTES

FOR LOCATION SEE SK FF. 91. 36. 35. 1400.
FOR BOX FOR FREE LOCK SEE SK FF. 91. 36. 35. 1416.


					elf aquitaine norge a/s p.o.box 168 4001 Stavanger	 elf FRIGGFIELD	Job no.	Installation CDP 1	System UNDERWATER	
1	12.83	UP DATED	BYH	LC			Scale 1:20	FREE LOCK CELL D	PIPE END LEVEL E	ED 1
Rev.	Date	DESCRIPTION	by	app.			Dwgr. no.	FF 91.36.35.1414.		1
Contractor JVD 1029.40.84.										

CDP 1 AS BUILT DRAWINGS


REFERENCE DRAWING LIST FOR:

[illegible]

						elf aquitaine norge a/s p.o.box 168 4001 Stavanger	 elf	Job no.	Installation	System
								Scale	CDP 1	UNDERWATER
Rev.	Date	DESCRIPTION	by	app.				Dwgr. no.		Rev.
Contractor						FRIGG FIELD	FF	— — 14/14		/

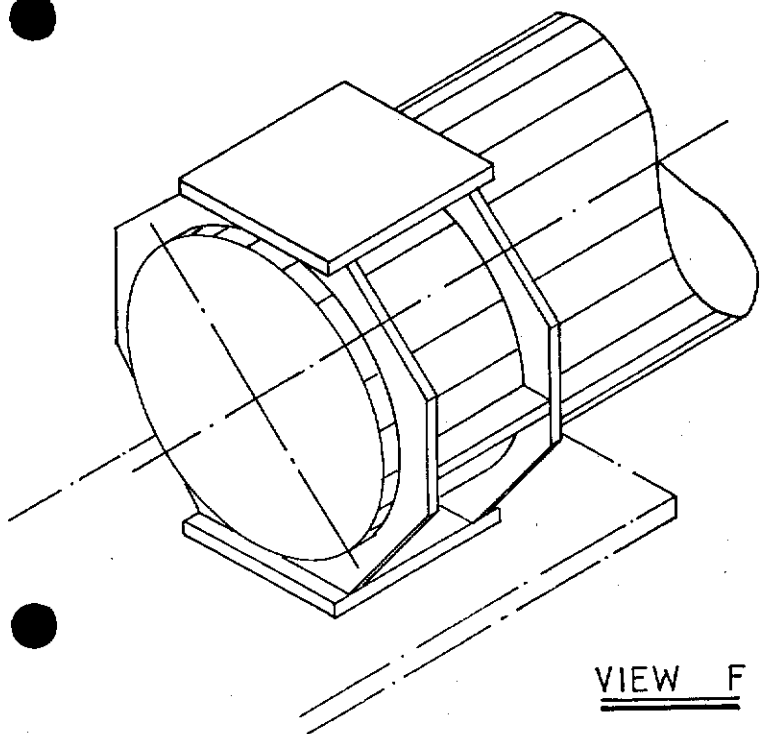


GRID NORTH
19° 37'
PLAT. NORTH

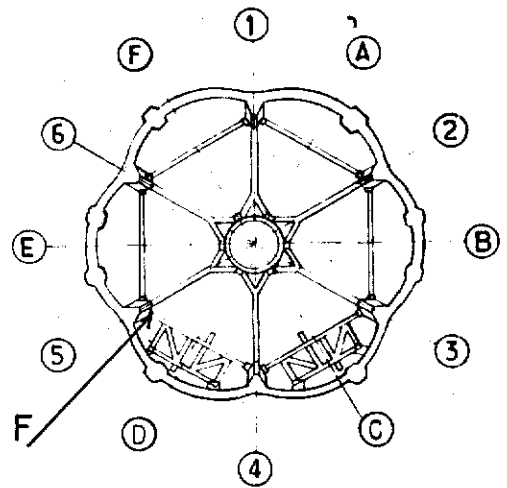


KEY PLAN

VIEW F

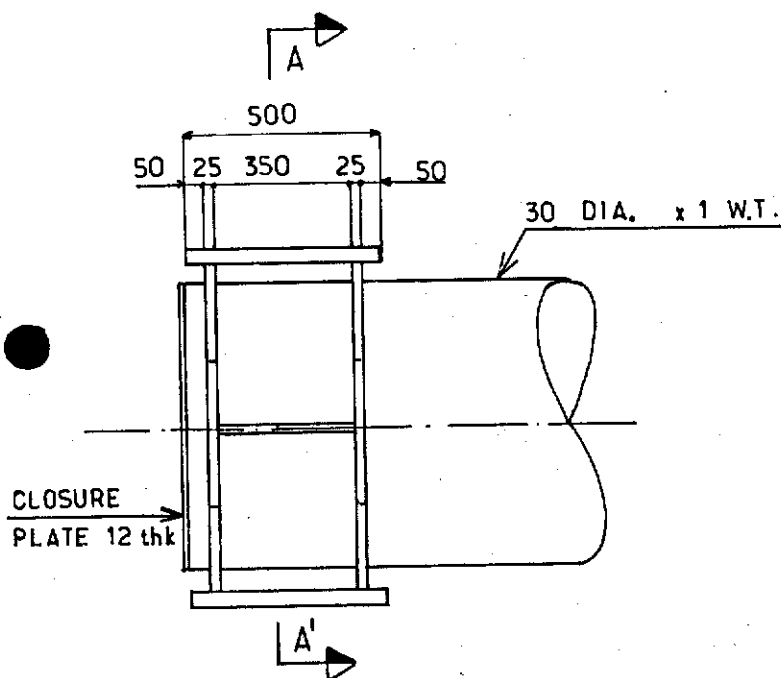

SECTION AA'

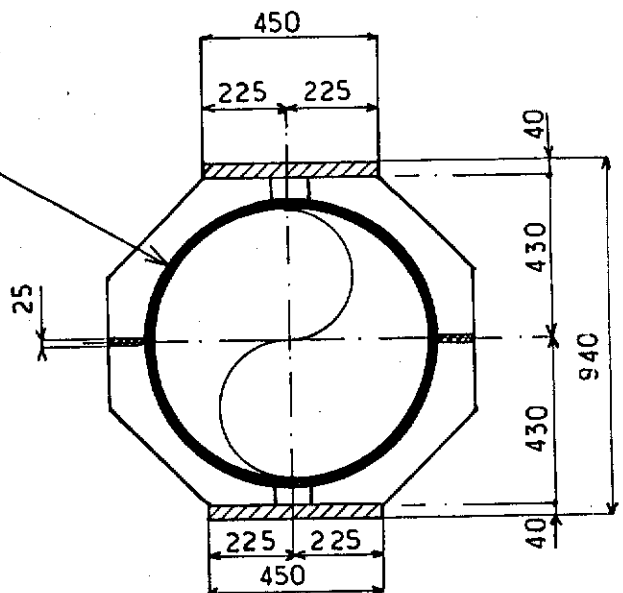

NOTES

FOR LOCATION SEE SK FF. 91.36.35.1400
FOR BOX FOR FREE LOCK SEE SK FF. 91.36.35.1417.


				elf aquitaine norge a/s		 elf	Job no.	Installation CDP 1	System UNDERWATER		
1	1283	UP DATED	BYH	l/c	p.o.box 168		Scale 1:20	FREE LOCK CELL D	PIPE END ED 4 LEVEL E		
Rev.	Date	DESCRIPTION	by	app.			Dwgr. no.	FF 91.36.35.1415.	Rev. 1	Sheet /	
Contractor JVD 1029.40.85.				4001 Stavanger							

CDP 1 AS BUILT DRAWINGS

REFERENCE DRAWING LIST FOR:


[illegible][illegible]

				elf aquitaine norge a/s p.o.box 168 4001 Stavanger		 elf		Job no.		Installation CDP 1		System UNDERWATER	
								Scale					
Rev.		Date		DESCRIPTION		by		app.		Dwgr. no.		Rev.	
										FF — — 14/5		Sheet /	
Contractor						FRIGG FIELD							



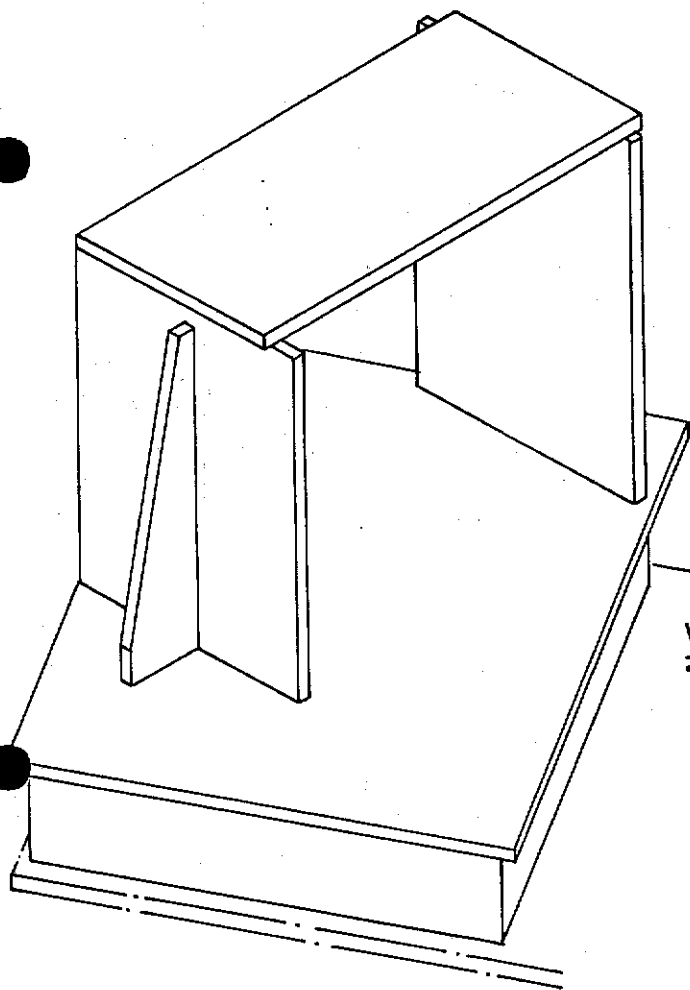


VIEW F


GRID NORTH
19° 37'
PLAT. NORTH

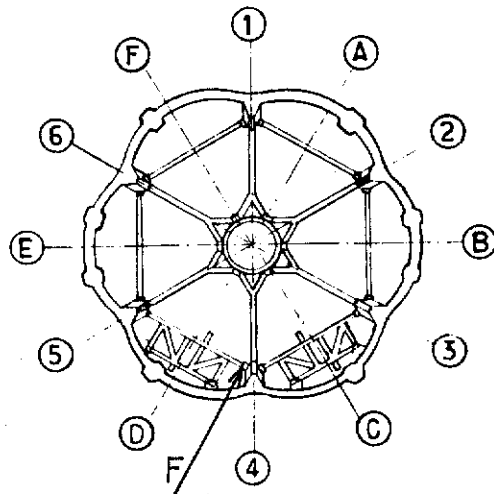

KEY PLAN

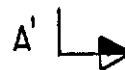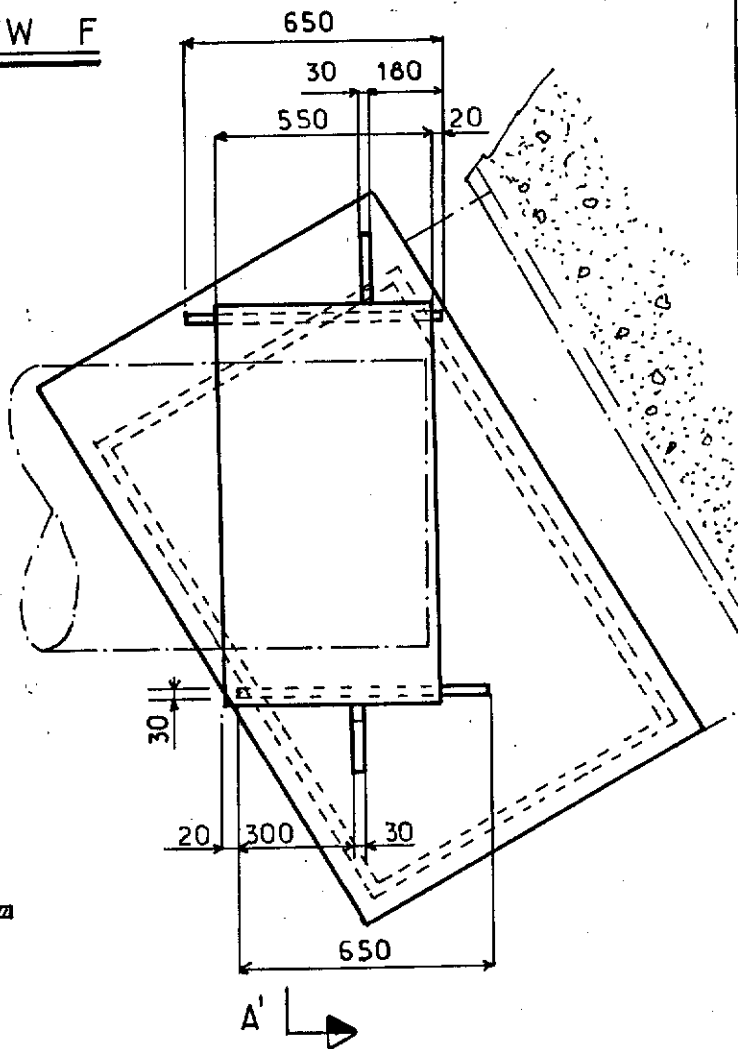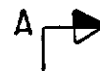

SECTION AA'

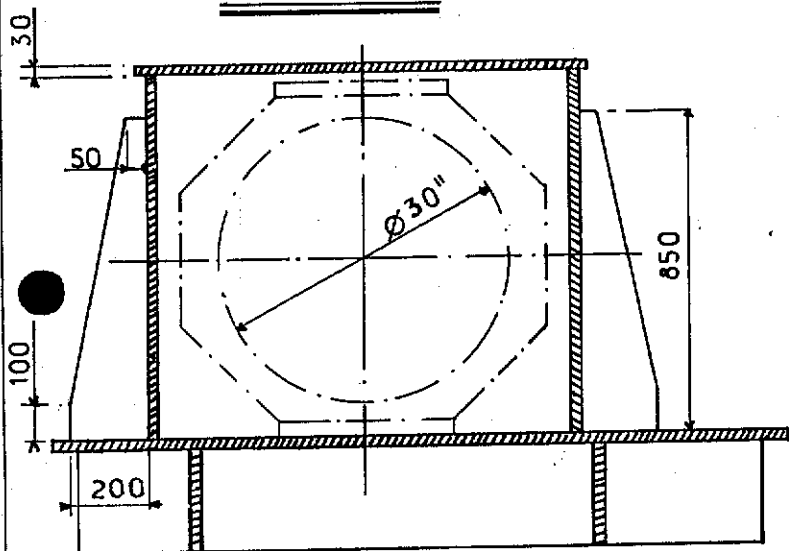

NOTES

FOR LOCATION SEE SK FF_91_36_35_1400.

FOR DETAIL OF FREE LOCK PIPE END SEE SK FF_91_36_35_1414.


						 elf	Job no.	Installation CDP 1	System UNDERWATER		
12.83		UP DATED		BVH / LC			Scale 1:20	BOX FOR FREE LOCK ED1 CELL D LEVEL E			
Rev.	Date	DESCRIPTION		by	app.		Dwgr. no.	FF 91-36-35-1416		Rev 1	Sheet /
Contractor JVD 1029.40.86.							4001 Stavanger	FRIGG FIELD			

CDP 1 AS BUILT DRAWINGS


REFERENCE DRAWING LIST FOR:

[illegible][illegible]

						elf aquitaine norge a/s p.o.box 168 4001 Stavanger	 elf	Job no.	Installation CDP 1	System UNDERWATER	
								Scale	BOXE FOR FREE. Lock ED1		
Rev.	Date	DESCRIPTION	by	app.				Dwgr. no.		Rev.	Sheet
Contractor								FF	— — 1416		/

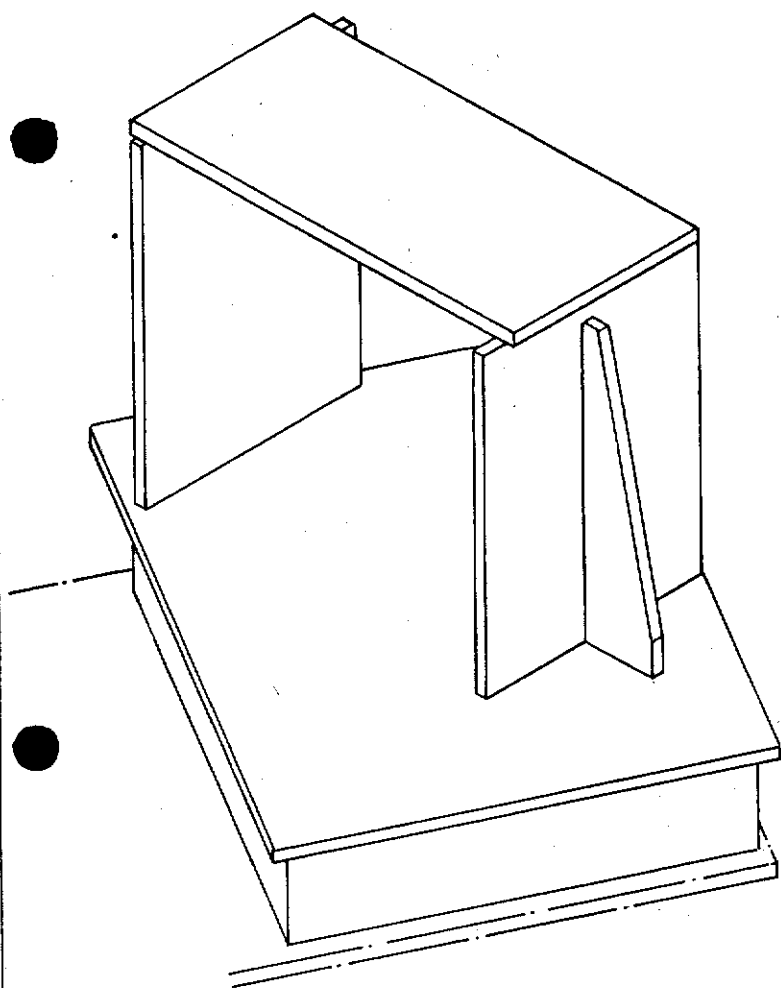


GRID NORTH
19°37'
PLAT. NORTH

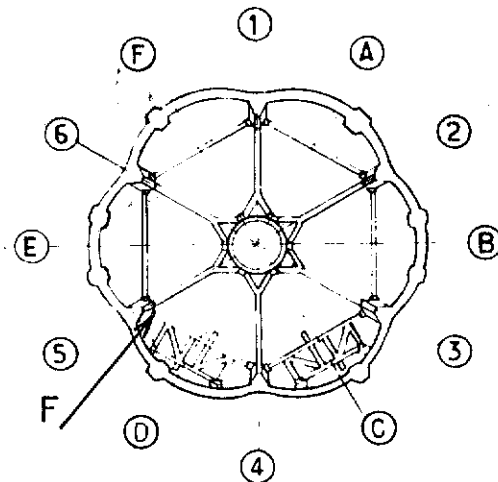


KEY PLAN

VIEW F

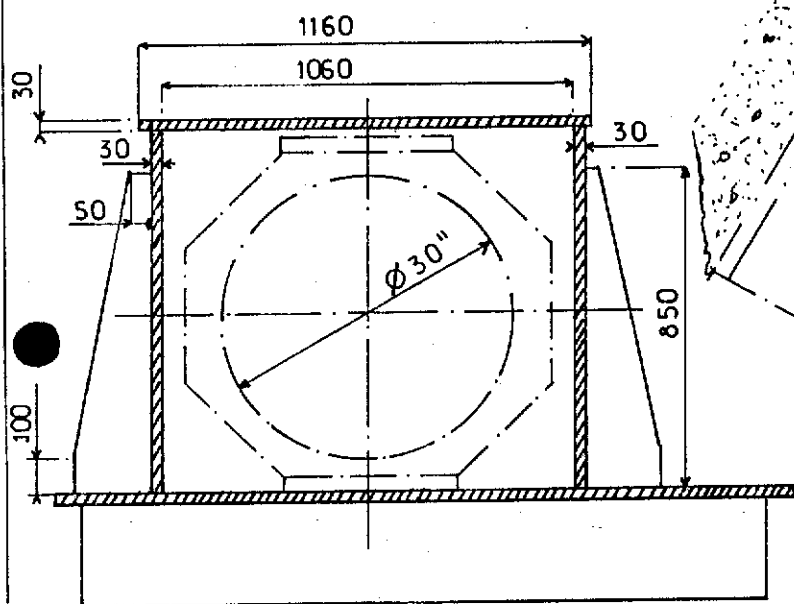

SECTION AA'

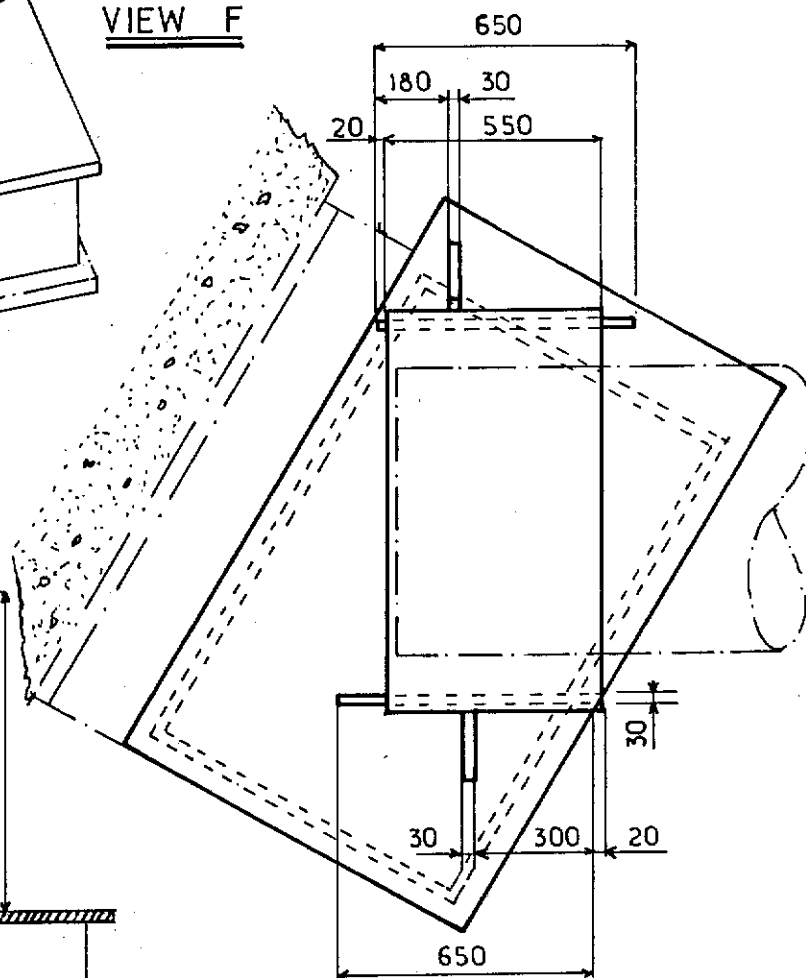

NOTES

FOR LOCATION SEE SK FF.91.36.35.1400.

FOR DETAIL OF FREE LOCK PIPE END SEE SK FF.91.36.35.1415.

1	12.83	UP DATED	B.VH	J.L.C
Rev.	Date	DESCRIPTION	by	app.
Contractor JVD 1029 40 87				

elf
aquitaine
norge a/s
p.o.box 168

4001 Stavanger



FRIGG FIELD

Job no.	Installation CDP 1	System UNDERWATER
Scale 1:20	BOX FOR FREE LOCK ED4 CELL D LEVEL E	
Dwgr. no. FF 91.36.35.1417	Re. 1	Sheet /

CDP 1 AS BUILT DRAWINGS

REFERENCE DRAWING LIST FOR:

[illegible][illegible]

						elf aquitaine norge a/s p.o.box 168 4001 Stavanger	 elf	FRIGG FIELD	Job no.	Installation CDP 1	System UNDERWATER
									Scale	BOXE FOR FREE Lock ED4	
Rev.	Date	DESCRIPTION	by	app.	Contractor				Dwgr. no. FF ———— 1417	Rev.	Sheet /




0	20.2.86	first issue	T.B.
rev.	date	DESCRIPTION	by
			
elf aquitaine norge as p.o box 168 - 4001 Stavanger			
Installation		System	
CDP1		UNDERWATER	
Job no		GENERAL VIEW OF VERTICAL BRACING IN CELL D	
Scale		LEVEL E	
1:50			
FRIGG FIELD			
91 36 35 1418 0			

CDP 1 AS BUILT DRAWINGS


REFERENCE DRAWING LIST FOR:

[illegible][illegible]



						elf aquitaine norge a/s		 elf		Job no.		Installation CDF 1		System UNDERWATER	
						p.o.box 168				Scale					
Rev.		Date		DESCRIPTION		by		app.		Dwgr. no.		Rev.		Sheet	
										FF		1413		0	
Contractor								4001 Stavanger		FRIGG FIELD					

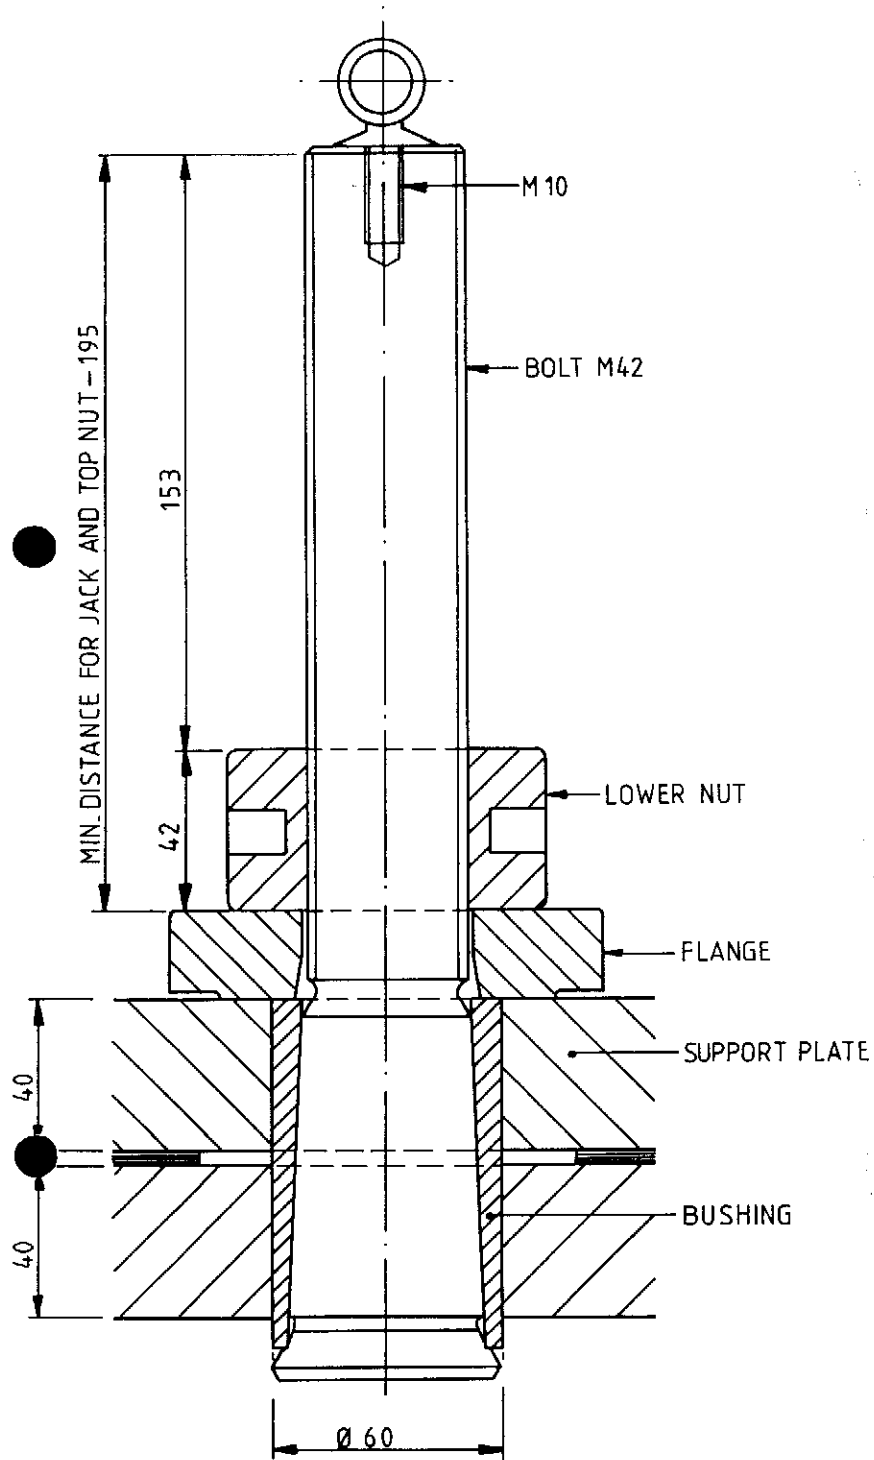

SHEAR KEY AS INSTALLED
1:2

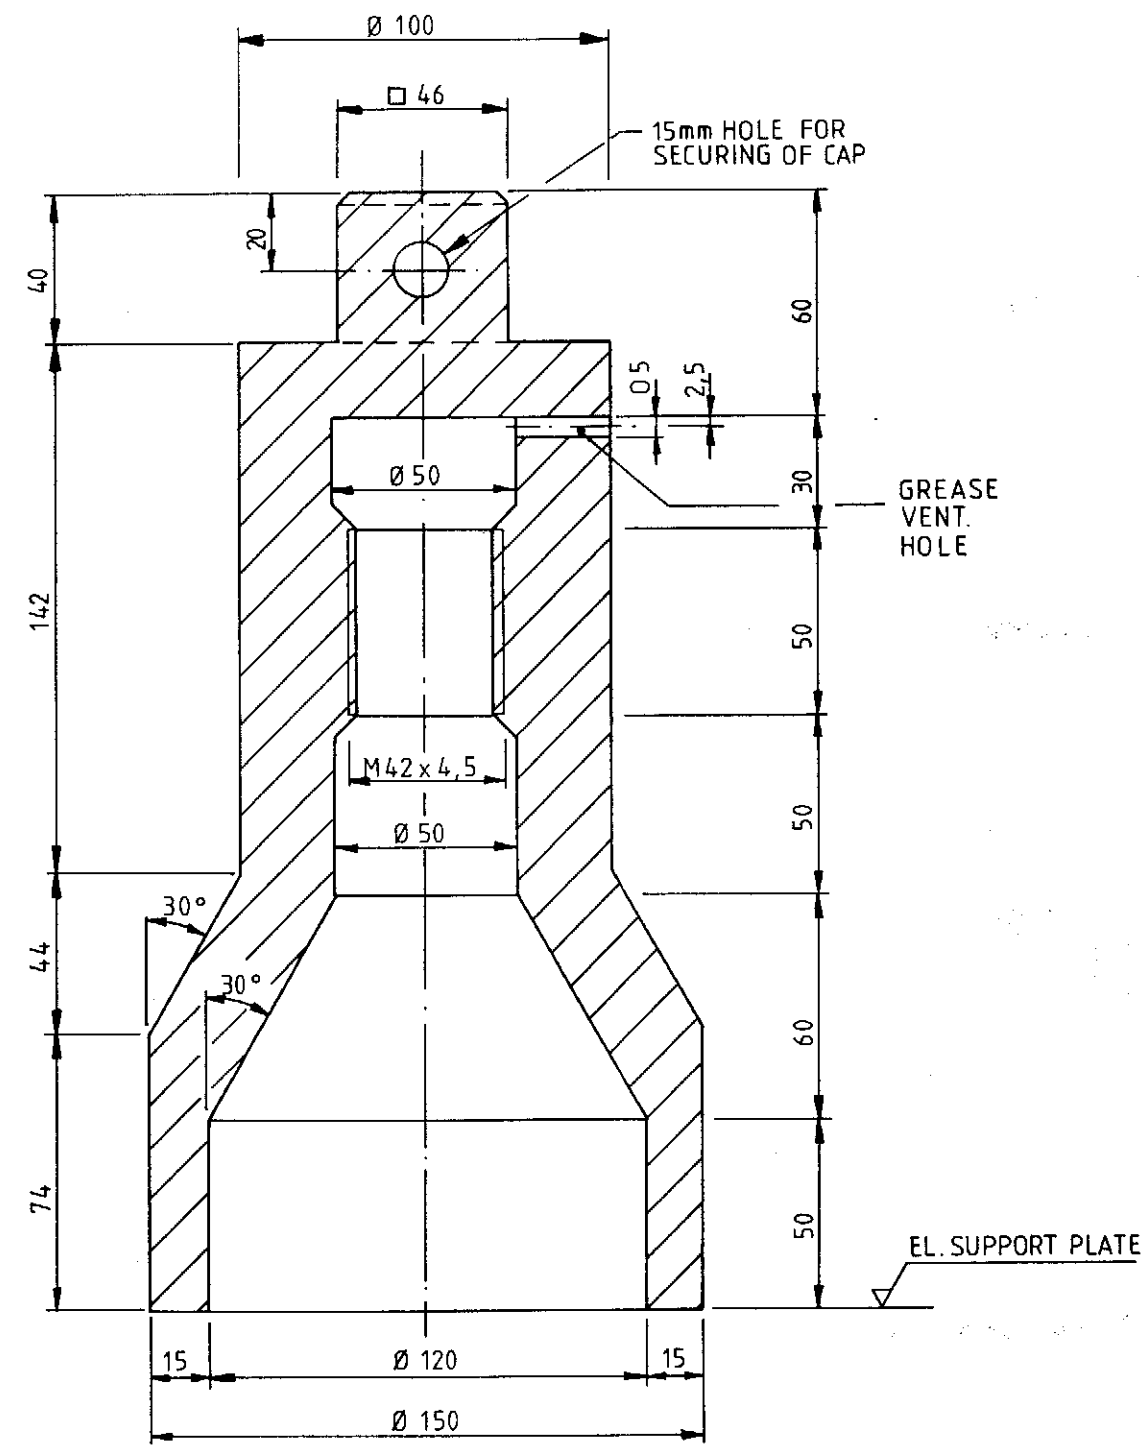

**CORROSION PROTECTION CAP
FOR SHEAR KEY BOLT/NUT**
1:2

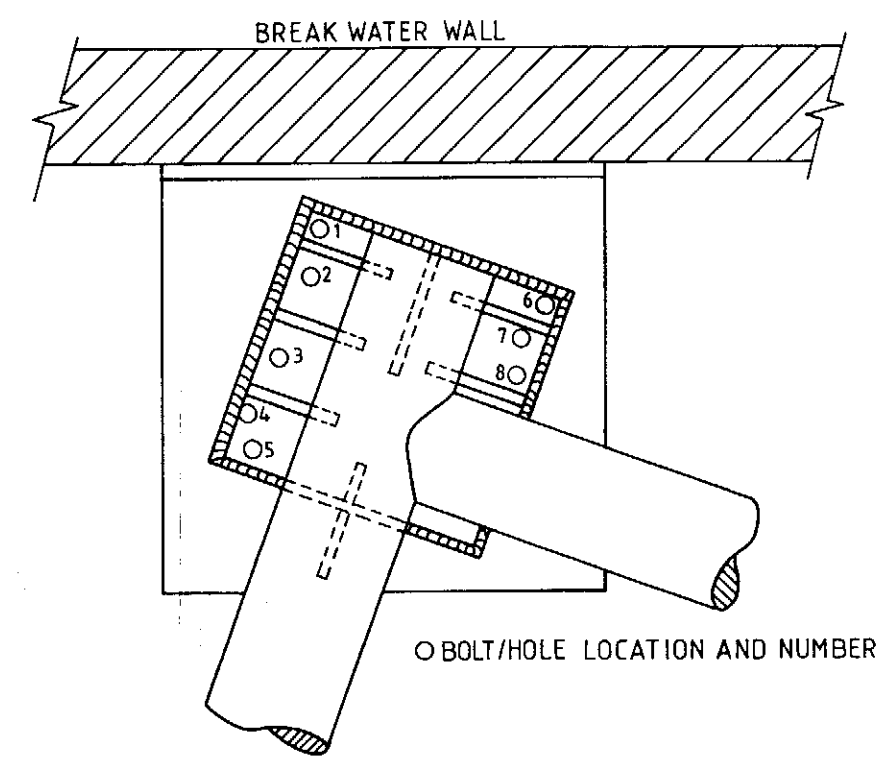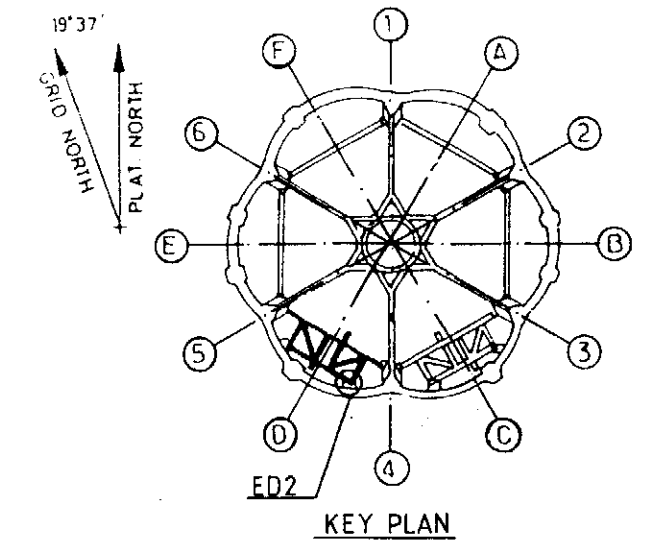

○ BOLT/HOLE LOCATION AND NUMBER

NOTES
NEW SHEAR KEY BOLTS INSTALLED IN HOLE No. 1,2,6 & 7.
FOR LOCATION, SEE FF 9136 35 1378

elf
aquitaine
norge as
P.O. Box 168
4001 Stavanger



Installation	CDP1	System	UNDERWATER
Job no.	SHEAR KEY BOLTS FOR CONDUCTOR GUIDE FRAME SUPPORT ED 2 IN CELL C AT ELEV. E		
Scale	AS NOTED		
Drwg. no.	FF 91 36 35 14 19		
Rev.	0	Sheet	


CDP 1 AS BUILT DRAWINGS

REFERENCE DRAWING LIST FOR:


[illegible][illegible]

					elf		 elf	Job no.	Installation CDP 1		System UNDERWATER	
					aquitaine			Scale				
24-12-86 rev. Date DESCRIPTION by app.					norge a/s p.o.box 168		FRIGG FIELD	Dwgr. no.	FF		Rev.	Sheet
Contractor					4001 Stavanger			1419				/

GRID NORTH
19° 37'
PLAT NORTH

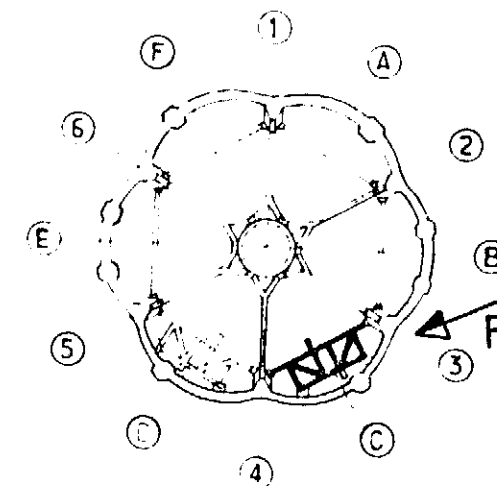

KEY PLAN

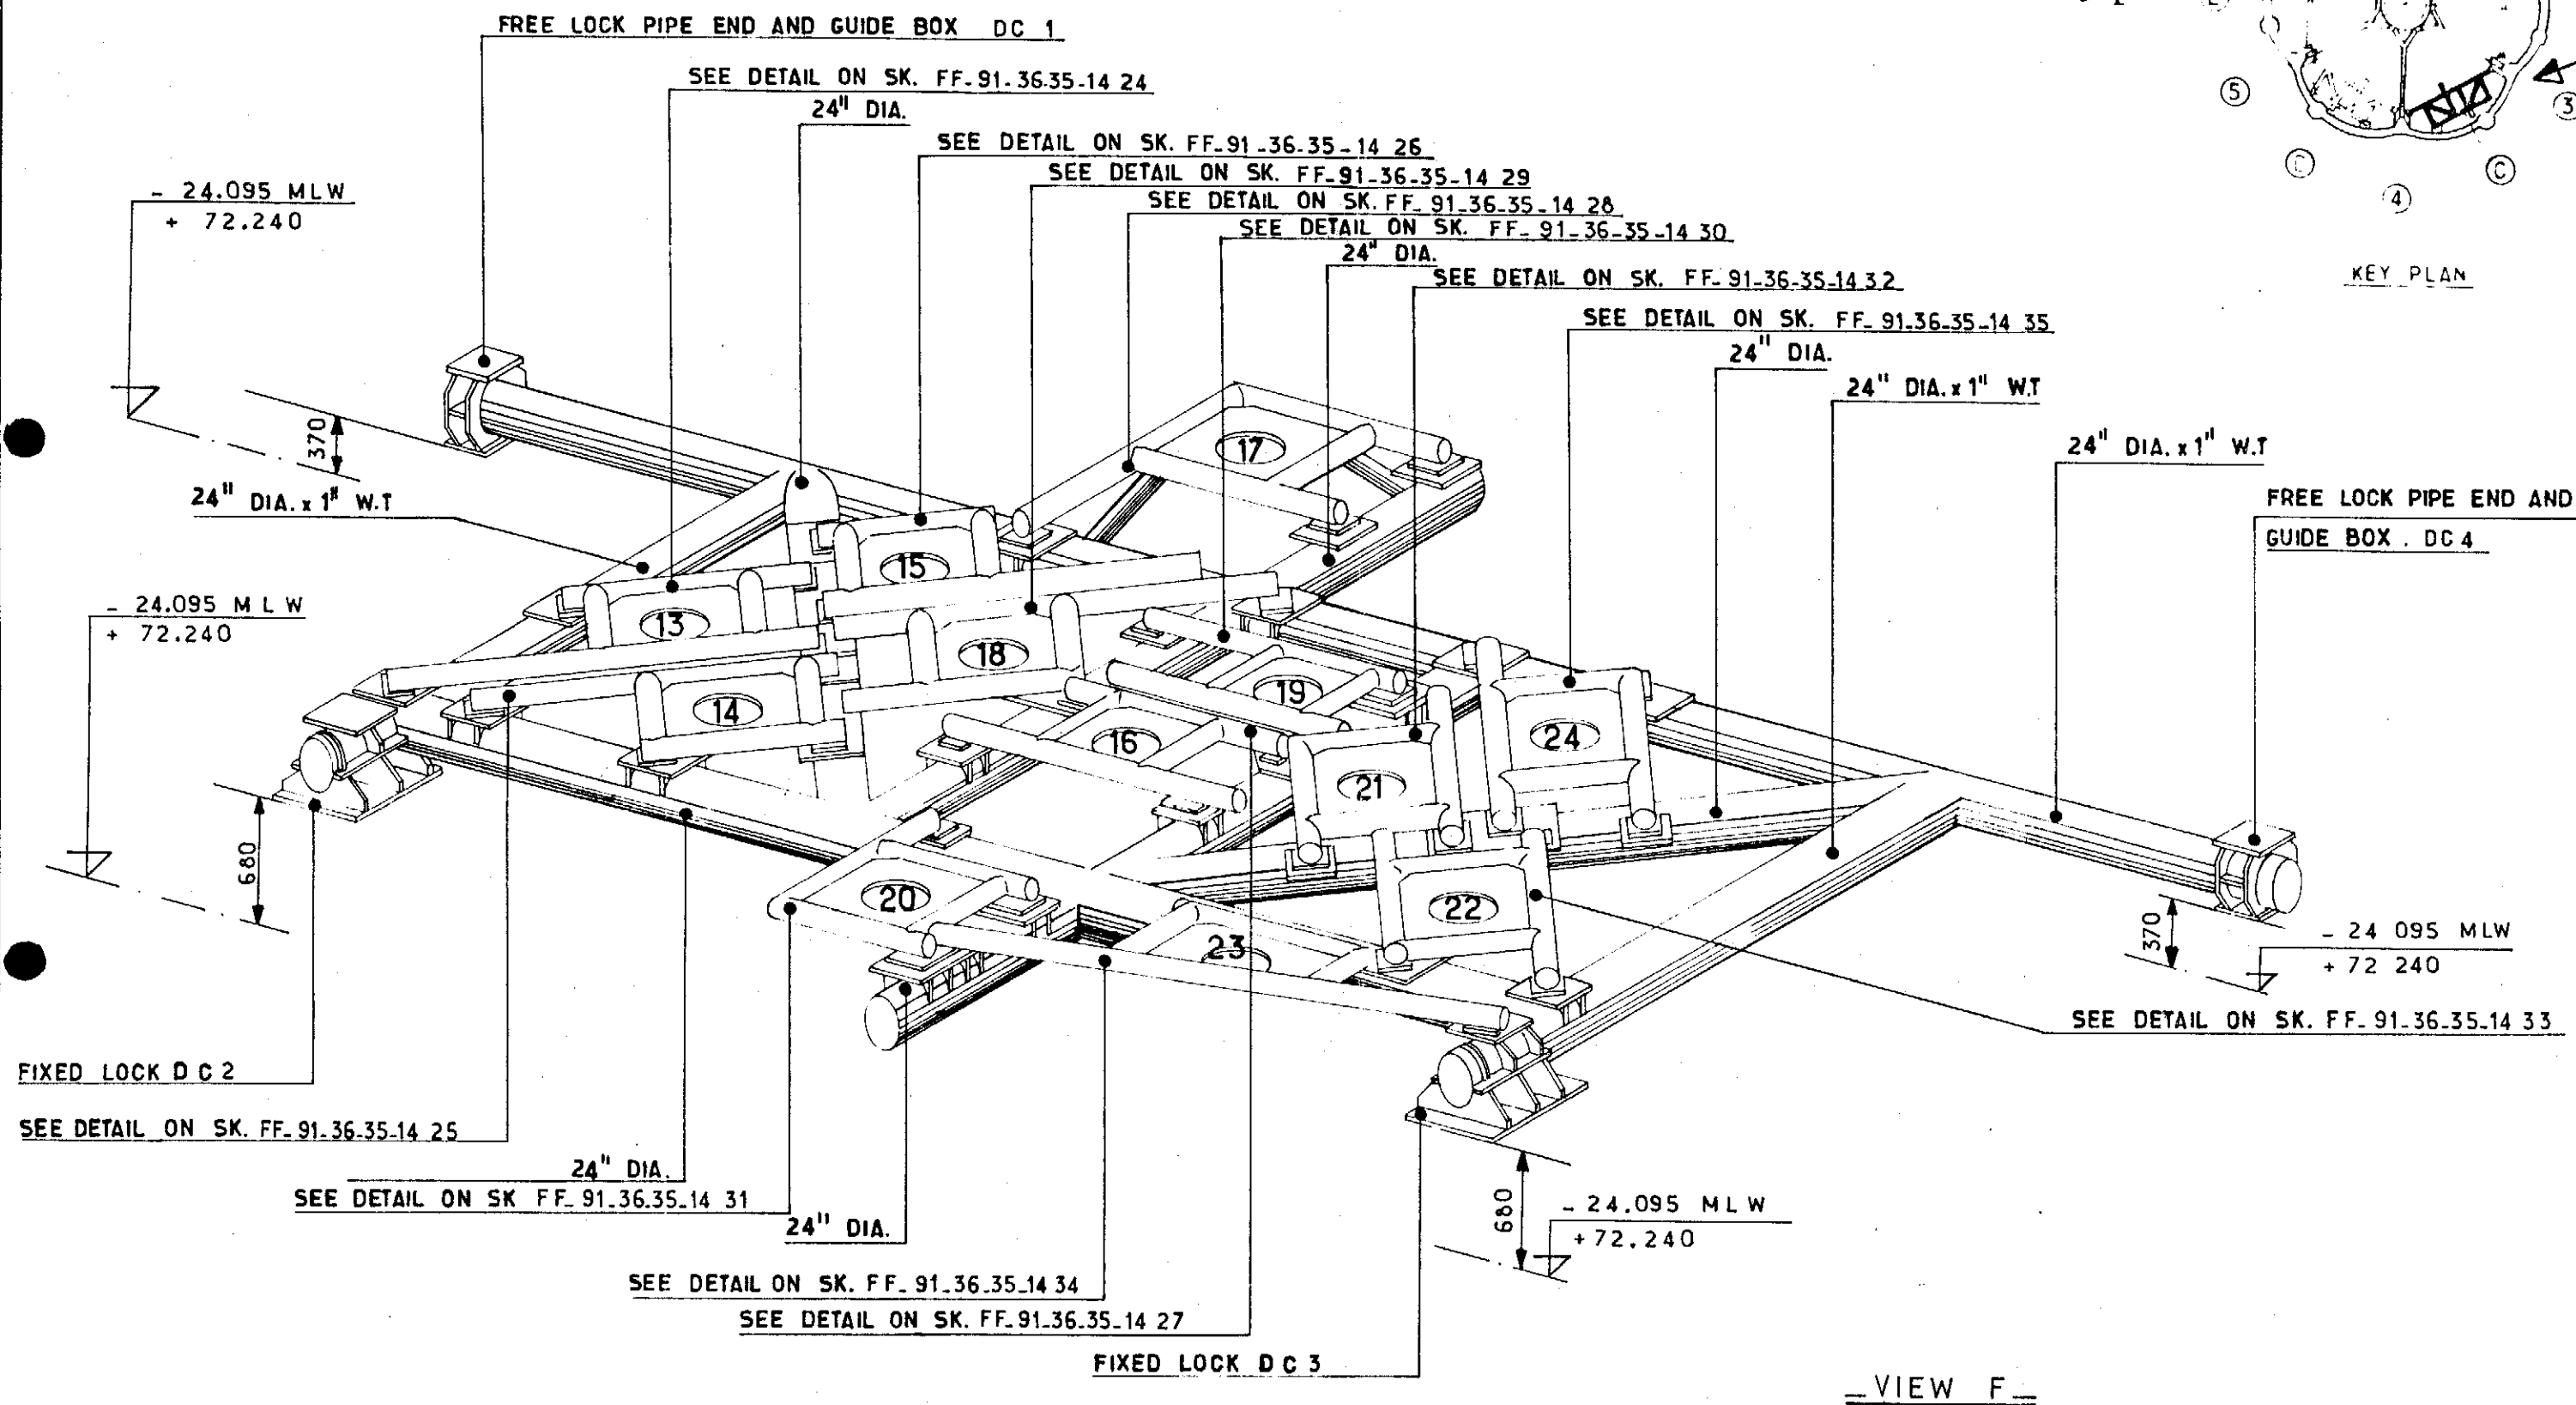

VIEW F

NOTES

FOR FREE LOCK PIPE ENDS AND GUIDE BOXES SEE SK FF 91-36-35-1436/1437/1438/1439.



						elf aquitaine norge a/s p.o.box 168 4001 Stavanger	 elf	Job no.	Installation CDP 1	System UNDERWATER
1	12.83	UP DATED	BYVH	JLC				Scale 	GENERAL VIEW OF CONDUCTOR GUIDE FRAME CELL C LEVEL D	
Rev.	Date	DESCRIPTION	by	app				Dwgr. no		
Contractor JVD_1029_40.92						4001 Stavanger	FRIGG FIELD	FF 91.36-35.14 22_		1

CDP 1 AS BUILT DRAWINGS

REFERENCE DRAWING LIST FOR: CONDUCTOR GUIDE FRAME

[illegible][illegible]

						 elf	Job no.	Installation CDP 1	System UNDERWATER	
							Scale			
Rev.	Date	DESCRIPTION	by	app.			Dwgr. no.		Rev.	Sheet
Contractor						4001 Stavanger	FF	1422		/

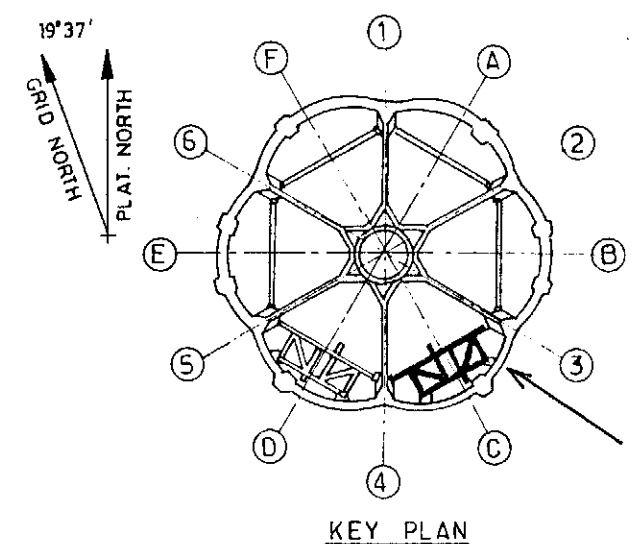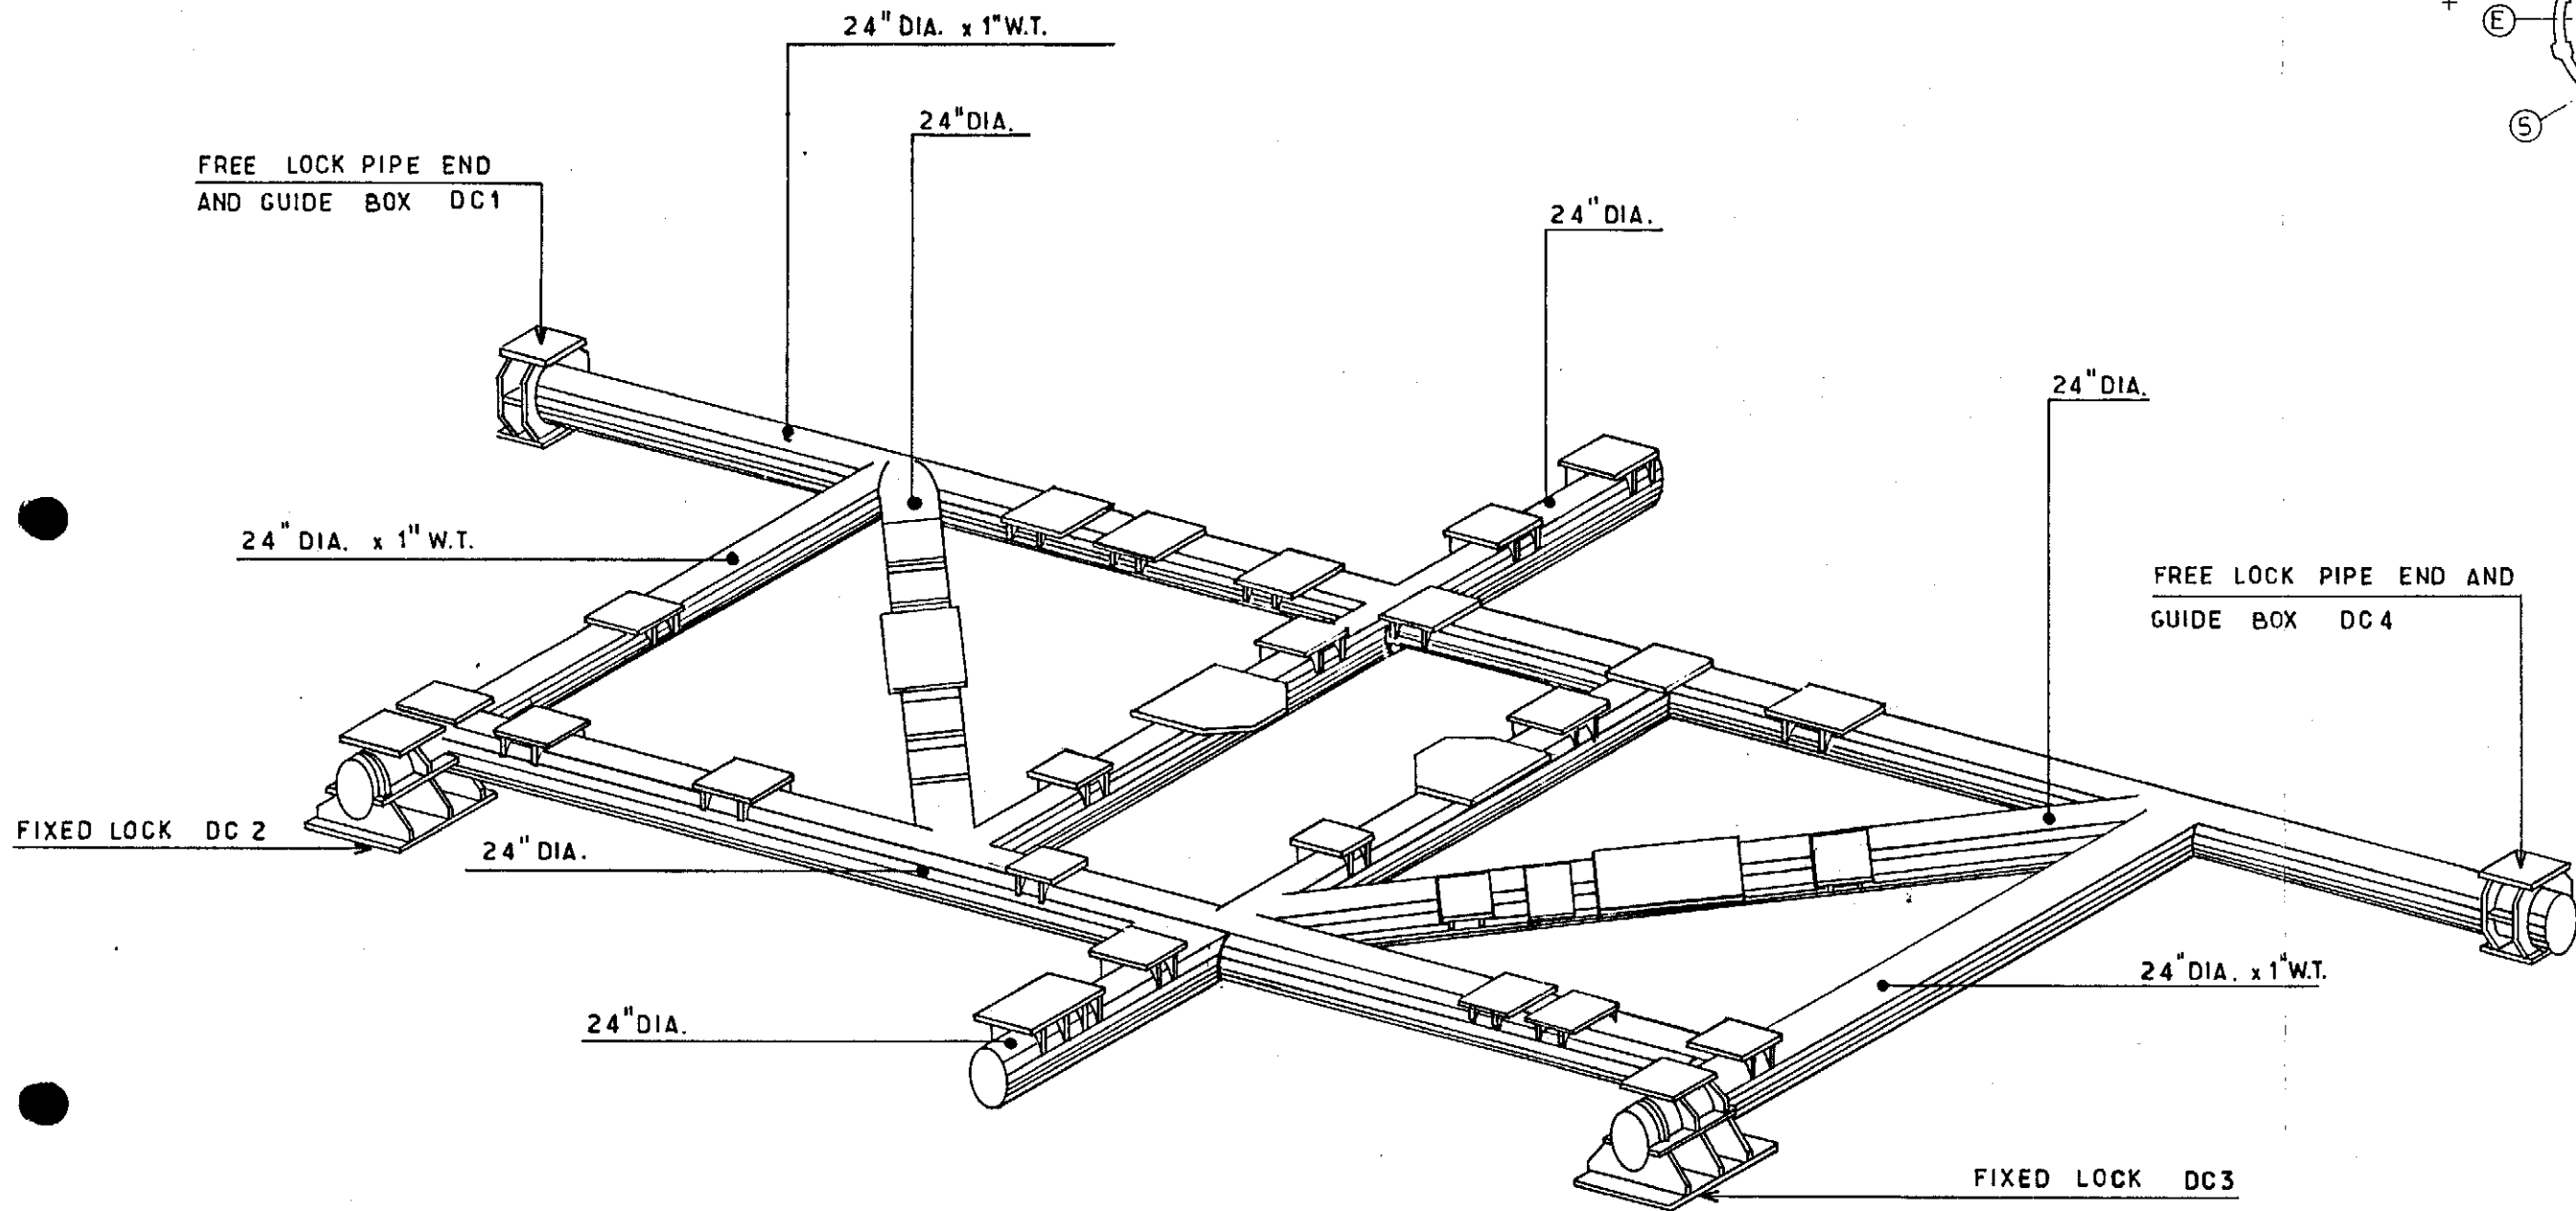

NOTES
 FOR SECONDARY FRAME DETAILS SEE SK FF.91.36.35.1424 TO FF.91.36.35.1435
 FOR FREE LOCK PIPE ENDS AND GUIDE BOXES SEE SK FF.91.36.35.1436/1437/1438/1439.

elf aquitaine norge a/s p.o.box 168 4001 Stavanger				Job no. Installation CDP 1		System UNDERWATER	
1 12.03 UP DATED B.VH J.L.C				Scale GENERAL VIEW OF SECONDARY FRAME SUPPORT		CELL C LEVEL D	
Rev. Date DESCRIPTION by app.				Dwgr. no. FF 91-36-35-1423.		1	
Contractor JVD 1029.40.93				FRIGG FIELD			

CDP 1 AS BUILT DRAWINGS

REFERENCE DRAWING LIST FOR:

[illegible][illegible]


					Job no.	Installation	System	
					Scale	CDP 1	UNDERWATER	
Rev.	Date	DESCRIPTION	by	app.		Dwgr. no.		
Contractor						FF 1423		
elf aquitaine norge a/s p.o. box 168 4001 Stavanger					FRIGG FIELD	Rev.		Sheet

WELDED ON
SUPPORT


ZINC ANODE

—CONDUCTOR GUIDE N°13—


GRID NORTH
19°37'
PLAT. NORTH

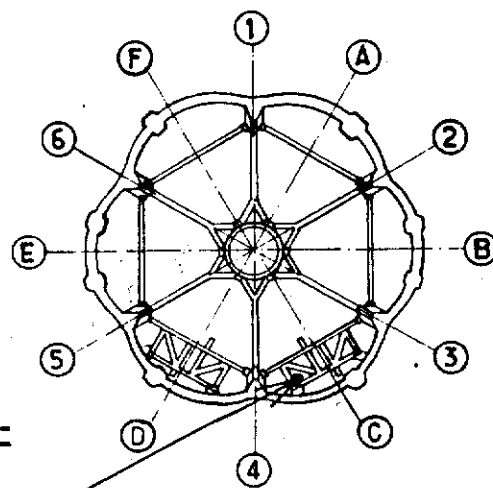


KEY PLAN

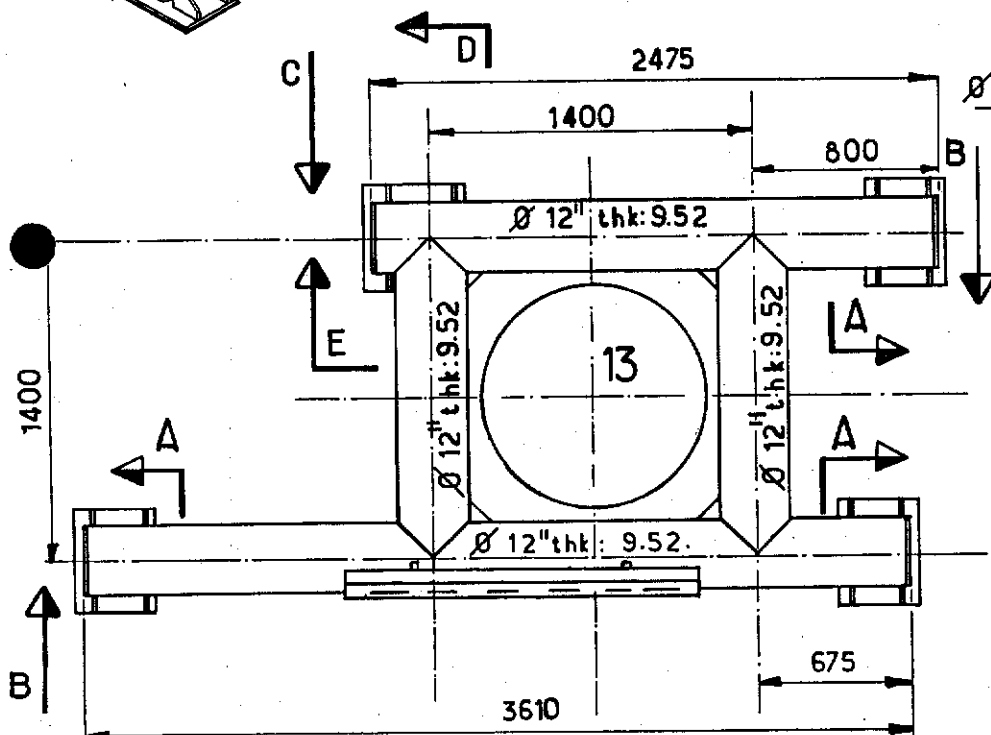


—PLAN VIEW—

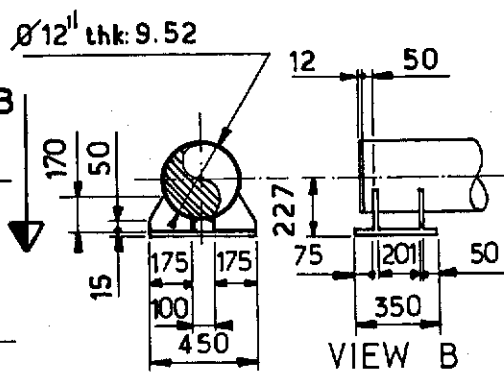


SECTION A

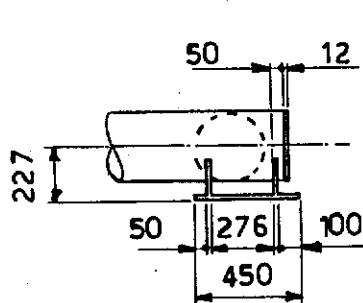

VIEW C

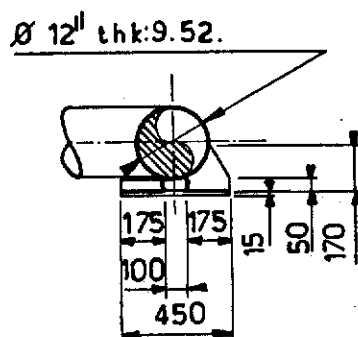

SECTION D

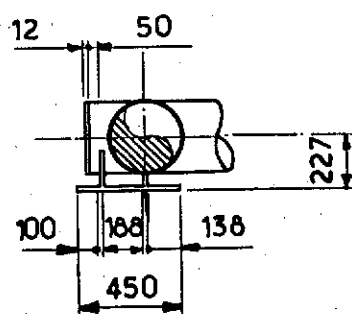

SECTION E

NOTES

FOR LOCATION SEE SK FF 91-36-35-1422
FOR CONDUCTOR SLEEVE SEE SK FF-91-36-35-1491
FOR ZINC ANODE SEE SK FF 91 36 35

Rev.	Date	DESCRIPTION	by	app.
1	12.83	UP DATED	BVH	JLC
Contractor JVD 1029_40_94				

elf
aquitaine
norge a/s
p.o.box 168
4001 Stavanger



FRIGG FIELD


Job no.	Installation CDP 1	System UNDERWATER
Scale 1:33	CONDUCTOR GUIDE N°13 CELL C SECONDARY FRAME LEVEL D	
Dwgr. no. FF 91.36.35.1424	Rev. 1	Sheet /

CDP 1 AS BUILT DRAWINGS

REFERENCE DRAWING LIST FOR:


[illegible][illegible]

						elf aquitaine norge a/s p.o.box 168 4001 Stavanger	 elf	Job no.	Installation	System
									CDP 1	UNDERWATER
Rev.	Date	DESCRIPTION	by	app.				Scale		
Contractor							Dwgr. no.			
							FF	1424		

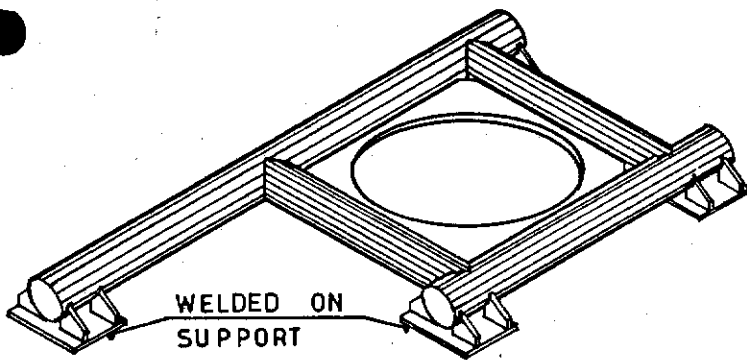


— CONDUCTOR GUIDE N°14 —


GRID NORTH
19° 37'
PLAT. NORTH

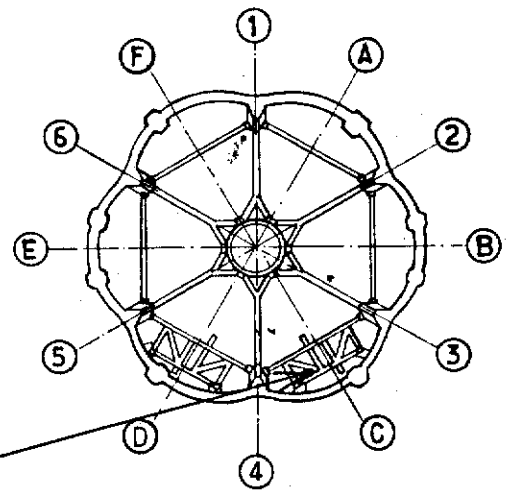


KEY PLAN

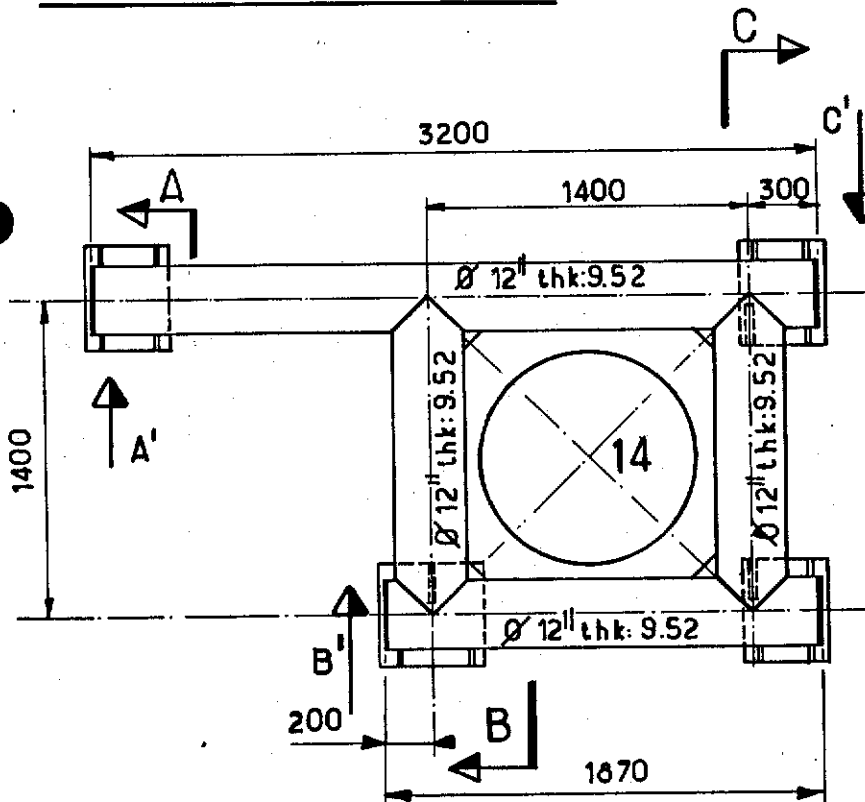

— PLAN VIEW —

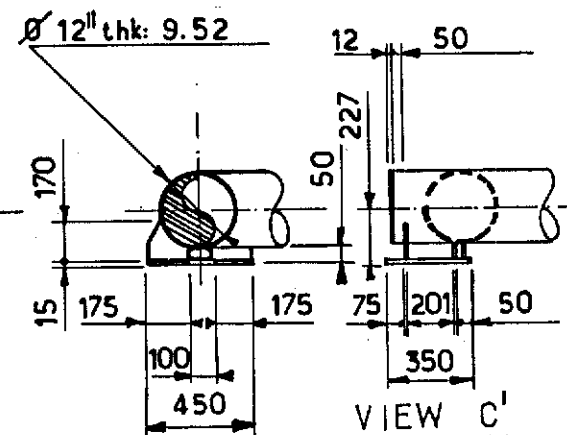


SECTION C

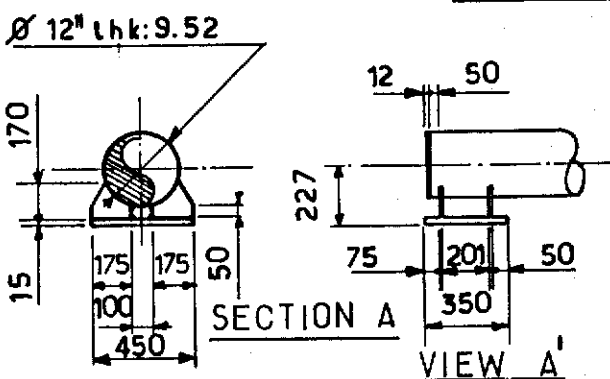

SECTION A

VIEW A'

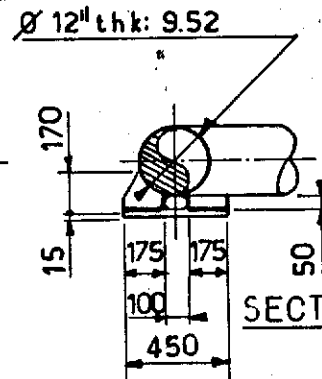

SECTION B

VIEW B'

NOTES

FOR LOCATION SEE SK FF. 91.36.35.1422
FOR CONDUCTOR SLEEVE SK FF. 91.36.35.1491.


				elf aquitaine norge a/s		 elf	Job no.	Installation CDP 1	System UNDERWATER
1	12.83	UP DATED	BVH	p.o.box 168			Scale 1:33	CONDUCTOR GUIDE N°14 CELL C SECONDARY FRAME LEVEL D	
Rev.	Date	DESCRIPTION	by	app.	4001 Stavanger		Dwgr. no.	FF.91.36.35.1425	Rev. 1
Contractor JVD 1029_40_95.									

CDP 1 AS BUILT DRAWINGS



REFERENCE DRAWING LIST FOR:

[illegible][illegible]


							Job no.	Installation CDP 1	System UNDERWATER
							Scale		
Rev.	Date	DESCRIPTION	by	app.			Dwgr. no.		
Contractor							FF	1425	

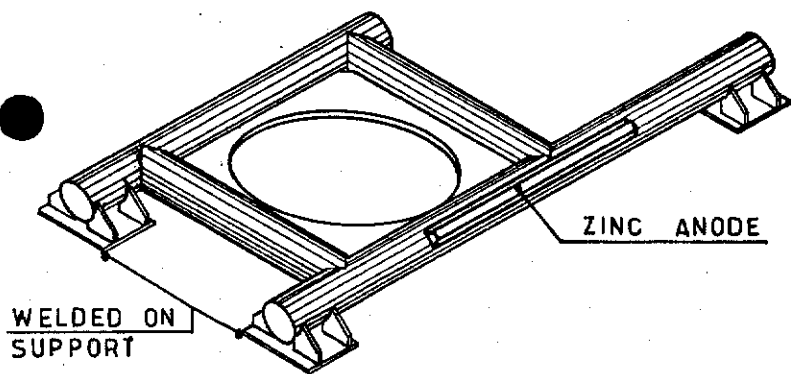

—CONDUCTOR GUIDE N°15—

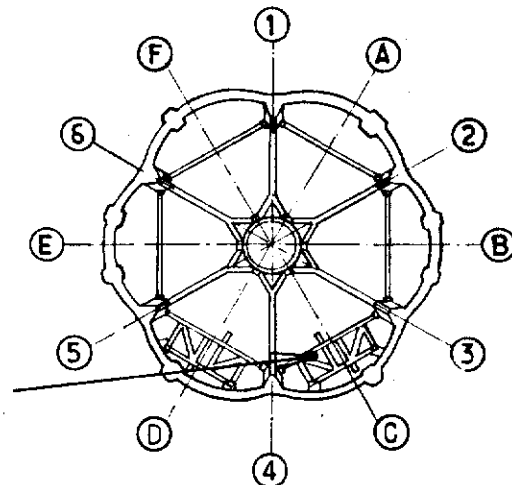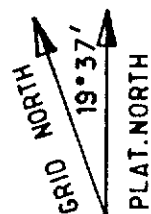


KEY PLAN

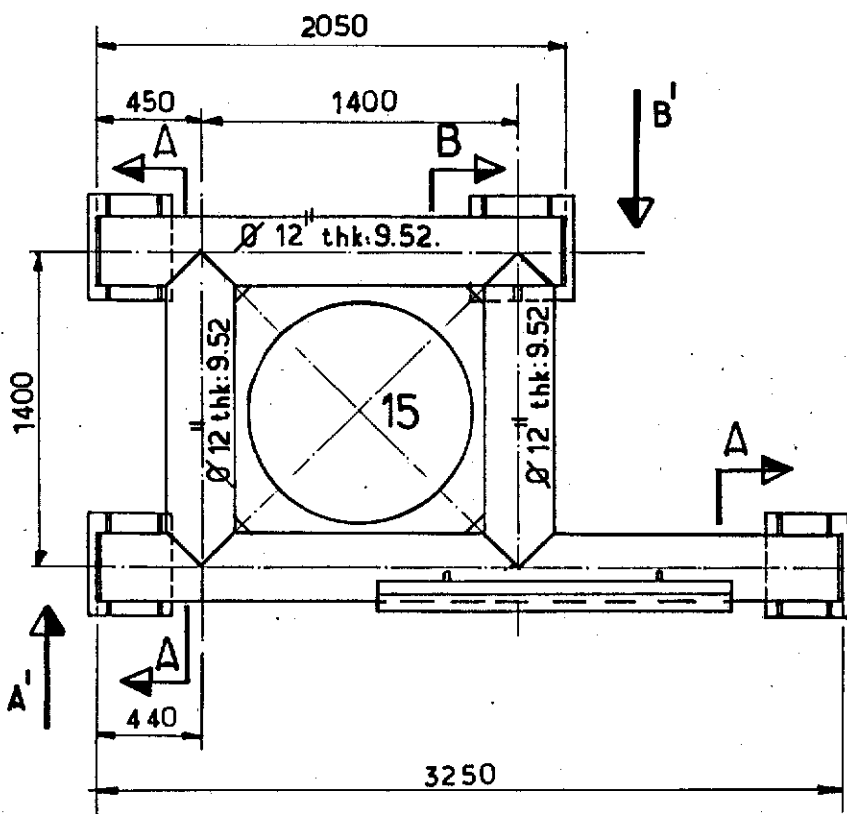

—PLAN VIEW—

—SECTION A—

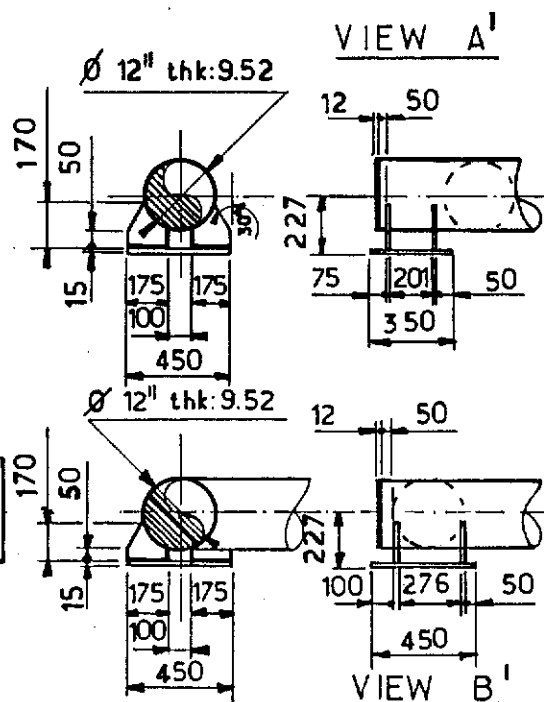

—SECTION B—

NOTES

FOR LOCATION SEE SK FF 91.36.35.1422.
FOR CONDUCTOR SLEEVE SEE SK FF.91.36.35.1491
FOR ZINC ANODE SEE SK FF.91.36.35.1587

1	1283	UP DATED	BVH/JLL
Rev.	Date	DESCRIPTION	by app.
Contractor JVD 1029_40_96_			

elf
aquitaine
norge a/s
p.o.box 168
4001 Stavanger

elf
FRIGG FIELD

Job no.	Installation CDP 1	System UNDERWATER
Scale 1:33	CONDUCTOR GUIDE N°15 CELL C SECONDARY FRAME LEVEL D	
Dwgr. no. FF 91.36.35.1426	Rev. 1	Sheet


CDP 1 AS BUILT DRAWINGS

REFERENCE DRAWING LIST FOR:



[illegible][illegible]

						 elf	Job no.	Installation CDP 1	System UNDERWATER
							Scale		
Rev.	Date	DESCRIPTION	by	app.			Dwgr. no.		
Contractor							FF	1426	


WELDED ON
SUPPORT

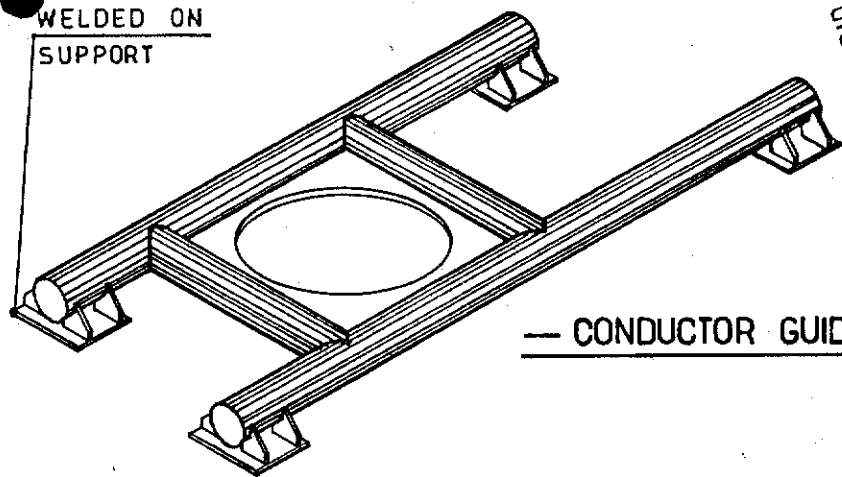

— CONDUCTOR GUIDE N°16 —

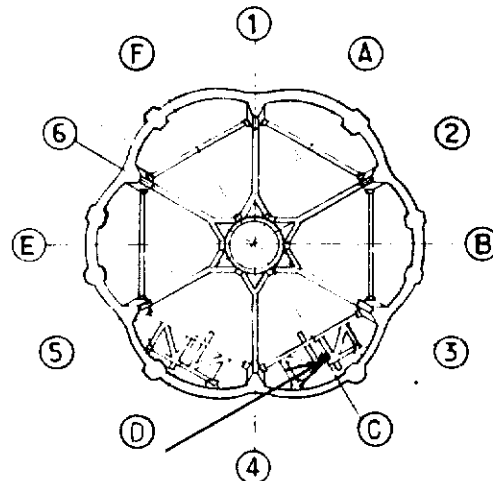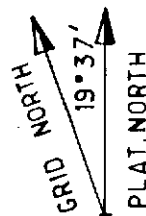

KEY PLAN

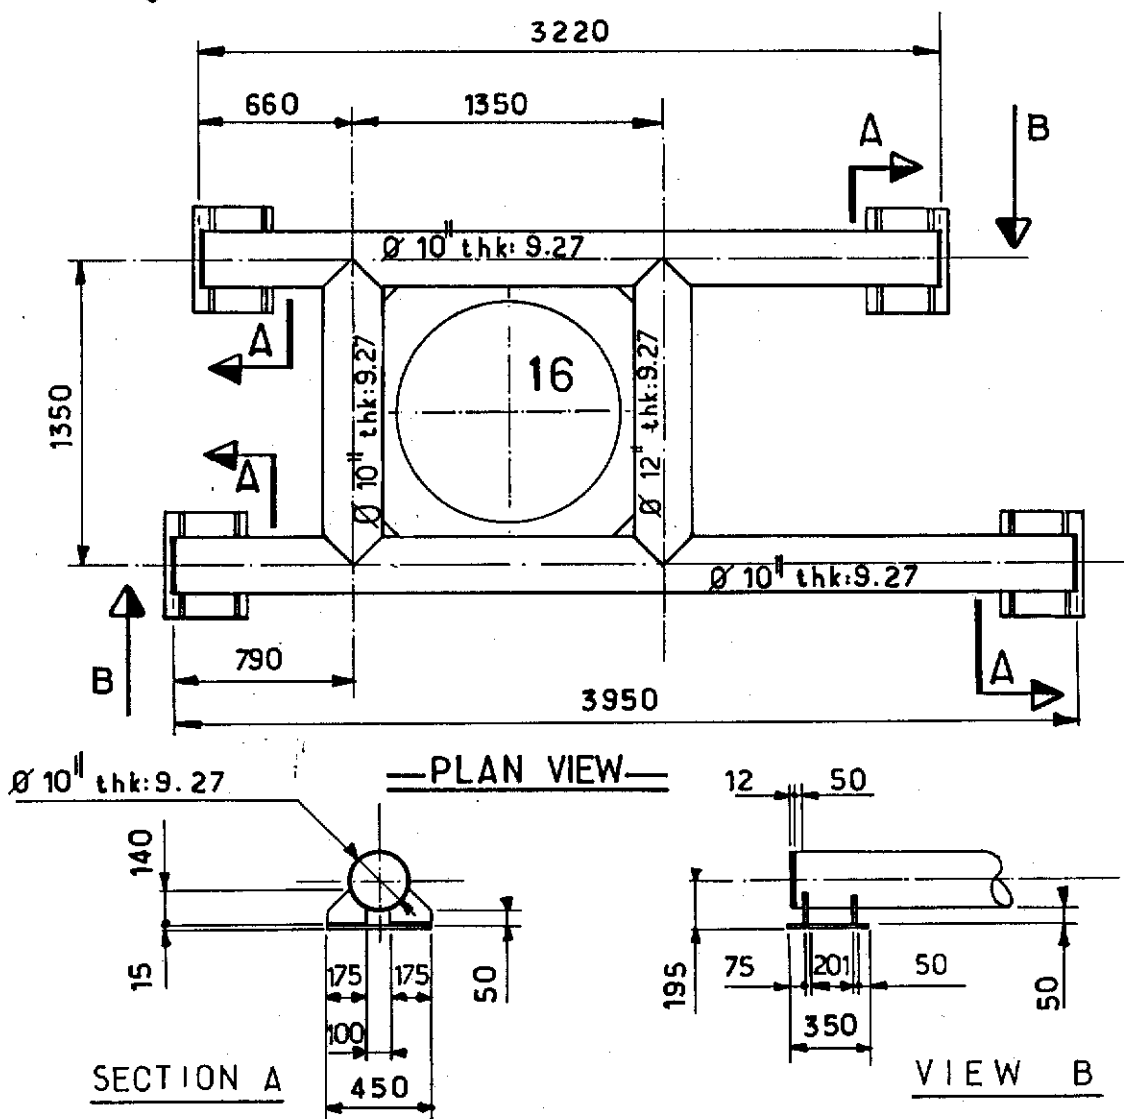

NOTES

FOR LOCATION SEE SK FF 91.36.35.1422.
FOR CONDUCTOR SLEEVE SEE SK FF.91.36.35.1491.

					elf aquitaine norge a/s p.o.box 168 4001 Stavanger	 elf	Job no.	Installation CDP 1	System UNDERWATER	
1	1283	UP DATED	BVH/LLC	Scale 1:33			CONDUCTOR GUIDE N°16 CELL C		LEVEL D	
Rev.	Date	DESCRIPTION	by	app.			Dwgr. no.		Rev	Sheet
Contractor JVD 1029_40.97_					FRIGG FIELD	FF 91_36_35_1427		1	/	




CDP 1 AS BUILT DRAWINGS

REFERENCE DRAWING LIST FOR:

[illegible][illegible]


							Job no.	Installation CDP 1	System UNDERWATER
							Scale		
Rev.	Date	DESCRIPTION	by	app.			Dwgr. no.		
Contractor						elf aquitaine norge a/s p.o.box 168 4001 Stavanger	FRIGG FIELD FF — — 1427		

WELDED ON
SUPPORT

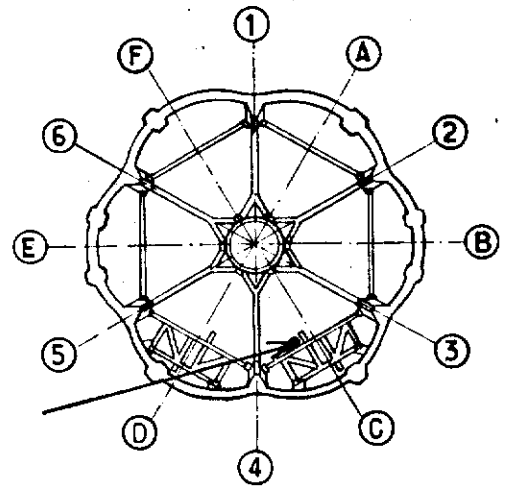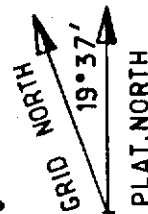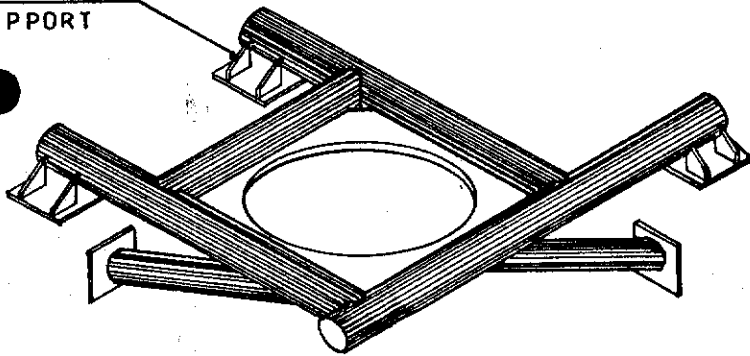


KEY PLAN

— CONDUCTOR GUIDE N°17 —


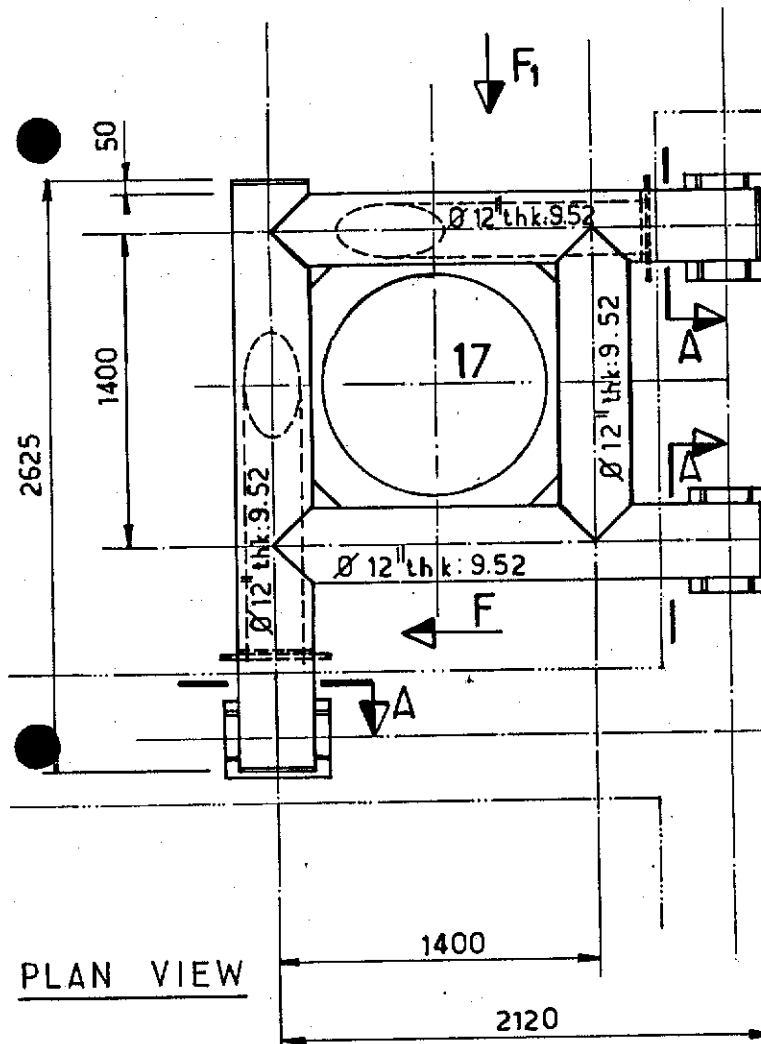


PLAN VIEW

SECTION A

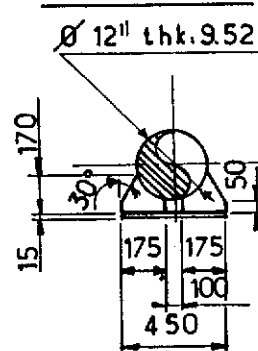

VIEW B

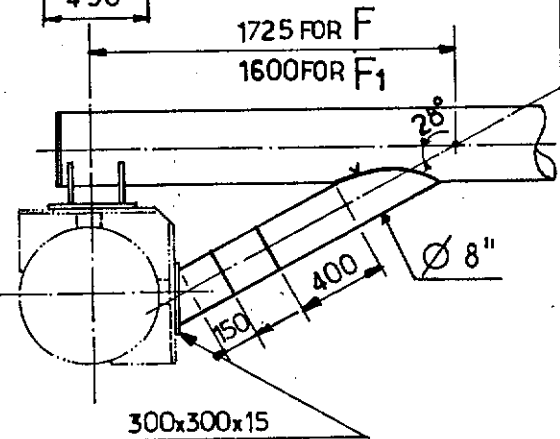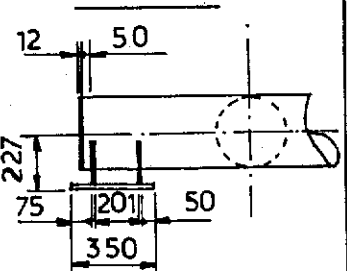

—VIEW F AND F1—

NOTES

FOR LOCATION SEE SK FF.91.36.35.1422
FOR CONDUCTOR SLEEVE SEE SK FF 91.36.35.1491


					elf aquitaine norge a/s p.o.box 168 4001 Stavanger		 elf FRIGG FIELD	Job no.	Installation CDP 1	System UNDERWATER
1	12,83	UP DATED	BYH	JLC	Scale 1:33	CONDUCTOR GUIDE N°17 CELL C SECONDARY FRAME LEVEL D				
Rev.	Date	DESCRIPTION	by	app.	Dwgr. no.	Rev		Sheet		
Contractor JVD 1029_40_98					FF 91_36.35_1428 1					

CDP 1 AS BUILT DRAWINGS



REFERENCE DRAWING LIST FOR:

[illegible][illegible]






					elf aquitaine norge a/s p.o.box 168 4001 Stavanger	 elf	Job no.	Installation CDP 1	System UNDERWATER	
							Scale			
Rev.	Date	DESCRIPTION	by	app.			Dwgr. no.	FF	1428	
Contractor					FRIGG FIELD					

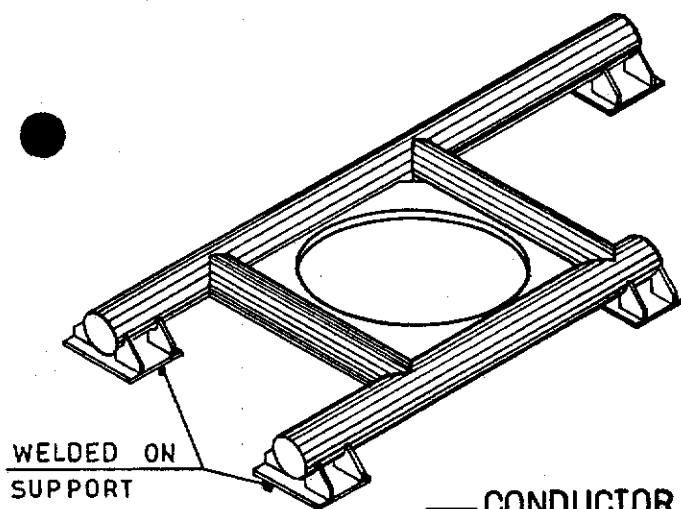

— CONDUCTOR GUIDE N°18 —

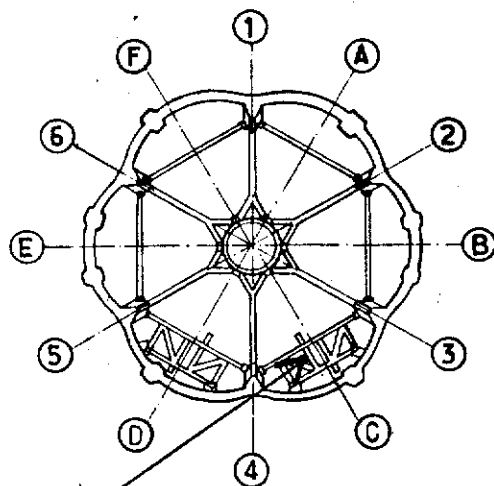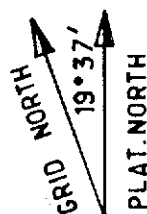

KEY PLAN

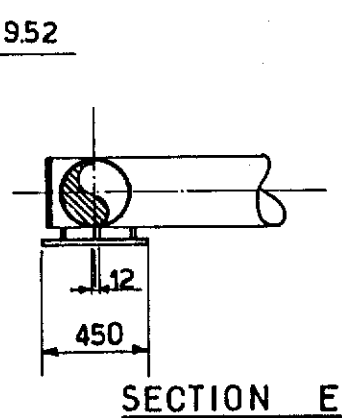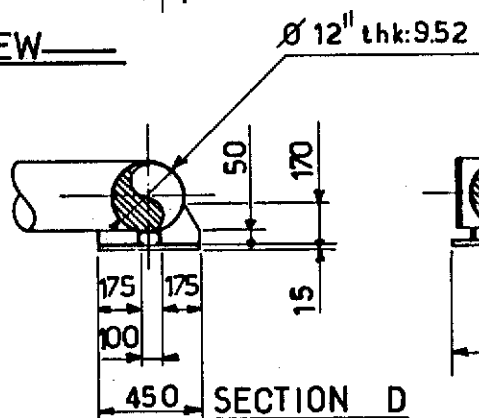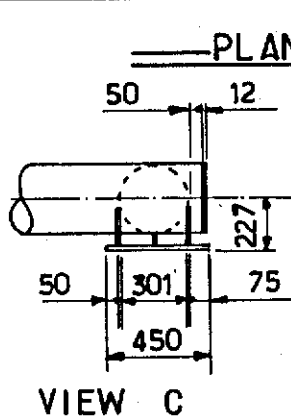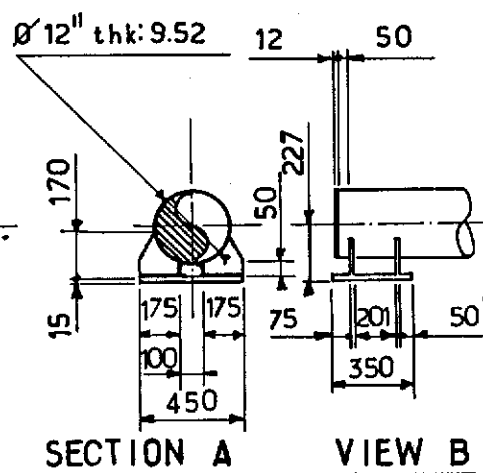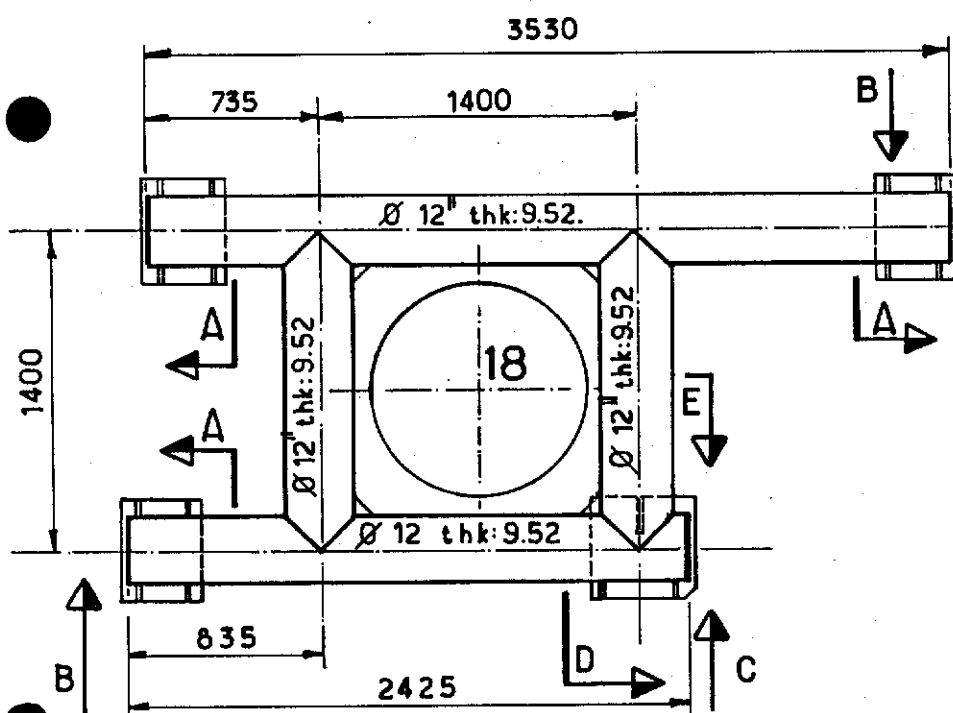

NOTES

FOR LOCATION SEE SK FF 91.36.35.1422
FOR CONDUCTOR SLEEVE SEE SK FF 91.36.35.1491


					elf aquitaine norge a/s p.o.box 168 4001 Stavanger	 elf	Job no.	Installation CDP 1	System UNDERWATER
1	12.83	UP DATED	BVH	JLC			Scale 1:33	CONDUCTOR GUIDE N°18 CELL C SECONDARY FRAME LEVEL D	
Rev.	Date	DESCRIPTION	by	app.			Dwgr. no.	FF 91.36.35.1429	Rev. 1
Contractor JVD 1029_40_99_					FRIGG FIELD				

CDP 1 AS BUILT DRAWINGS

REFERENCE DRAWING LIST FOR:

[illegible]

						elf aquitaine norge a/s p.o.box 168 4001 Stavanger	 elf	Job no.	Installation CDP 1	System UNDERWATER		
								Scale				
Rev.	Date	DESCRIPTION	by	app.				Dwgr. no.	FF — — 1429		Rev.	Sheet
Contractor						4001 Stavanger	FRIGG FIELD					

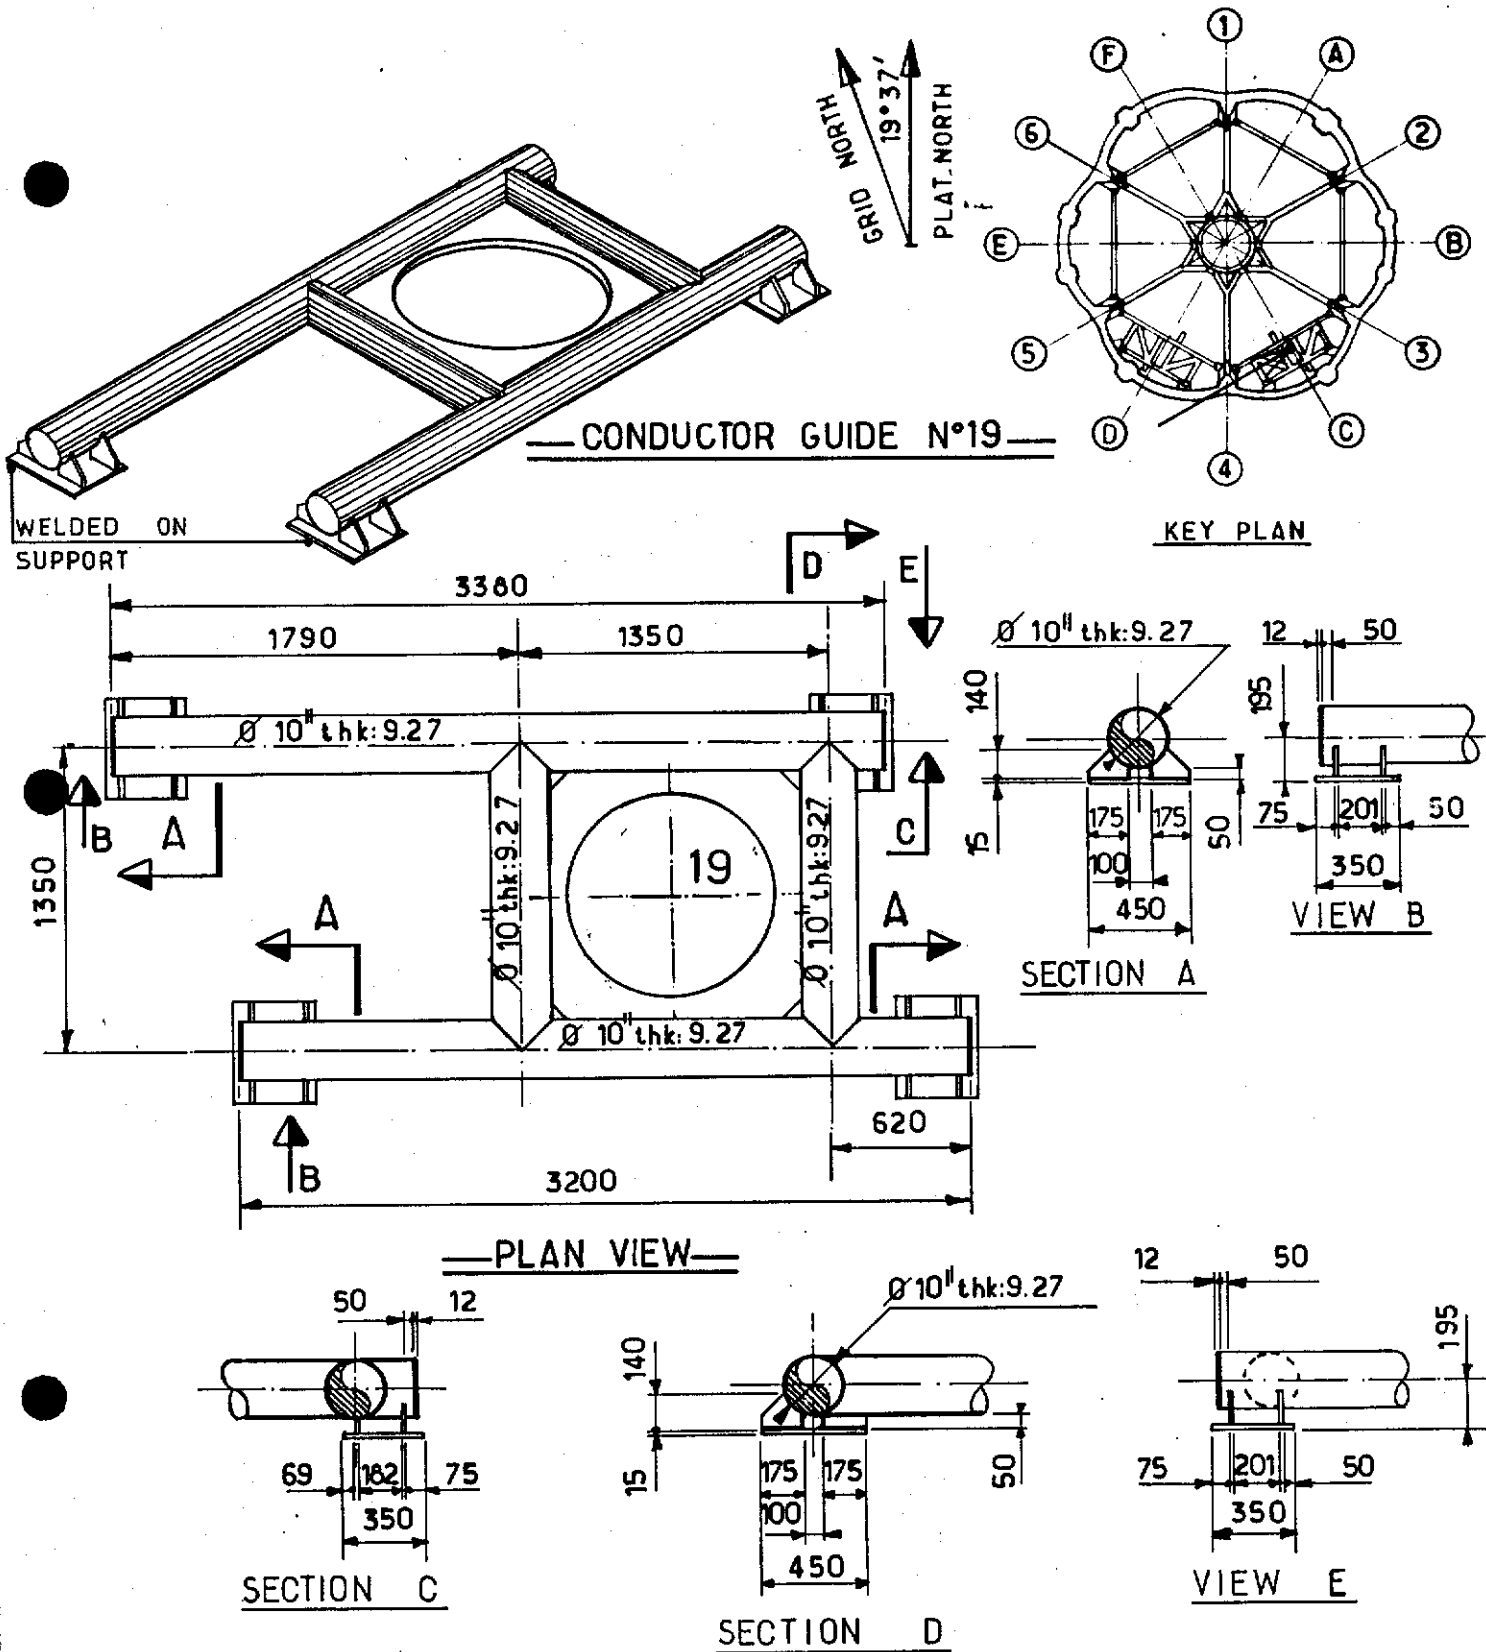

NOTES

FOR LOCATION SEE SK FF 91-36-35-1422
FOR CONDUCTOR SLEEVE SEE SK FF-91-36-35-1491.


				elf aquitaine norge a/s p.o. box 168 4001 Stavanger	 elf	Job no.	Installation CDP 1	System UNDERWATER
1	12.83	UP DATED	BYH/LC			Scale 1:33	CONDUCTOR GUIDE N°19 CELL C SECONDARY FRAME	LEVEL D
Rev.	Date	DESCRIPTION	by	app.		Dwgr. no.	FF 91-36-35-1430	Rev.
Contractor	JVD 1029-40-100				FRIGG FIELD			Sheet

CDP 1 AS BUILT DRAWINGS

REFERENCE DRAWING LIST FOR:



[illegible]

						elf aquitaine norge a/s p.o.box 168 4001 Stavanger	 elf	Job no.	Installation CDP 1	System UNDERWATER
								Scale		
Rev.	Date	DESCRIPTION	by	app.				Dwgr. no.		
Contractor								FF	1430	

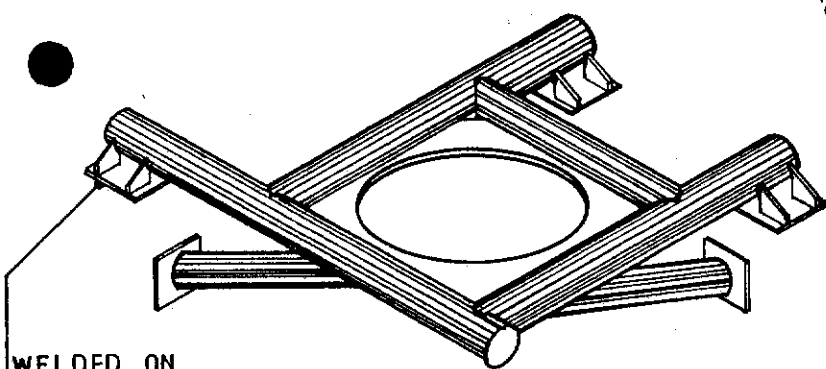


WELDED ON
SUPPORT

— CONDUCTOR GUIDE N°20 —

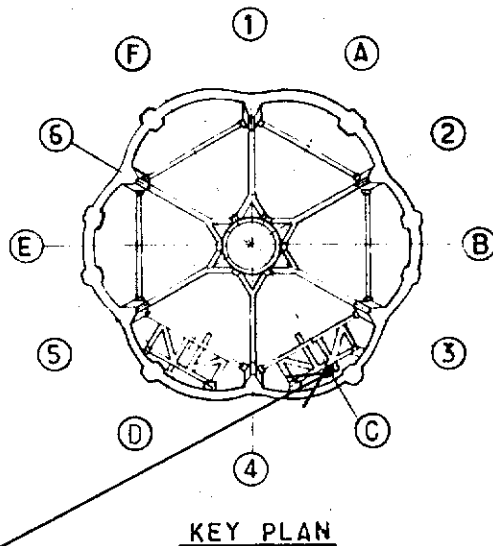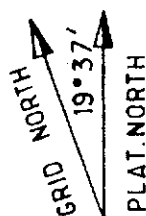


KEY PLAN


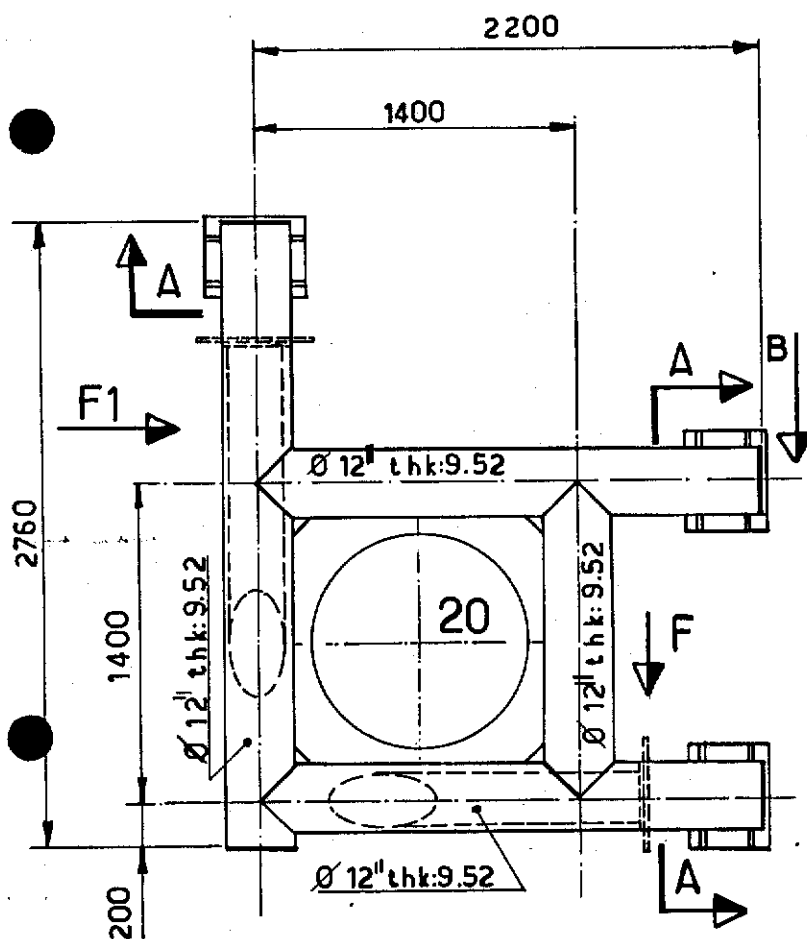


— PLAN VIEW —

SECTION A

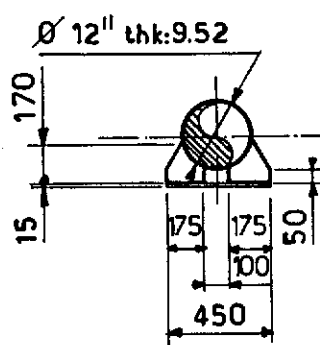

VIEW B

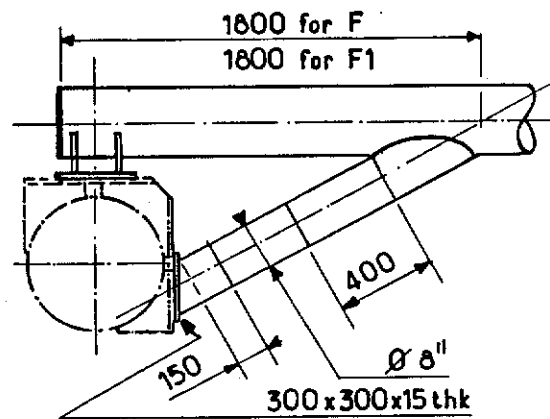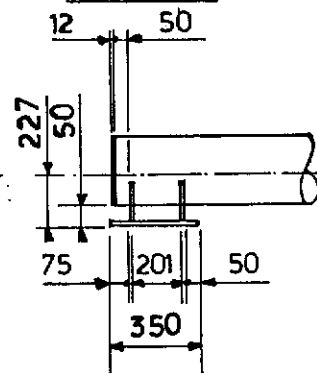

— VIEW F AND F1 —

NOTES

FOR LOCATION SEE SK FF 91-36-35-1422
FOR CONDUCTOR SLEEVE SEE SK FF-91-36-35-1491.

						elf aquitaine norge a/s p.o.box 168 4001 Stavanger	 elf	Job no.	Installation CDP 1	System UNDERWATER		
1	1283	UP DATED	BVH	LC				Scale 1:33	CONDUCTOR GUIDE N° 20 CELL C SECONDARY FRAME LEVEL D			
Rev.	Date	DESCRIPTION	by	app.				Dwgr. no.	FF 91-36-35-1431		Rev 1	Sheet /
Contractor JVD 1029-40-101-												

CDP 1 AS BUILT DRAWINGS


REFERENCE DRAWING LIST FOR:

[illegible]


						elf aquitaine norge a/s p.o.box 168 4001 Stavanger	 elf	Job no.	Installation	System
								Scale	CDP 1	UNDERWATER
Rev.	Date	DESCRIPTION	by	app.				Dwgr. no.		
Contractor						4001 Stavanger	FRIGG FIELD	FF	1431	

CONDUCTOR GUIDE N°21


ZINC ANODE

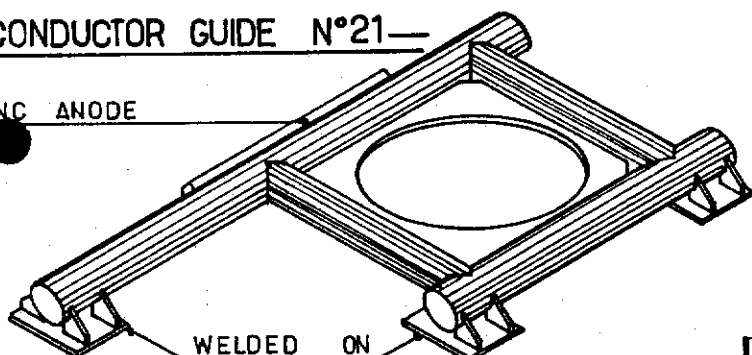


GRD NORTH
19°37'
PLAT. NORTH

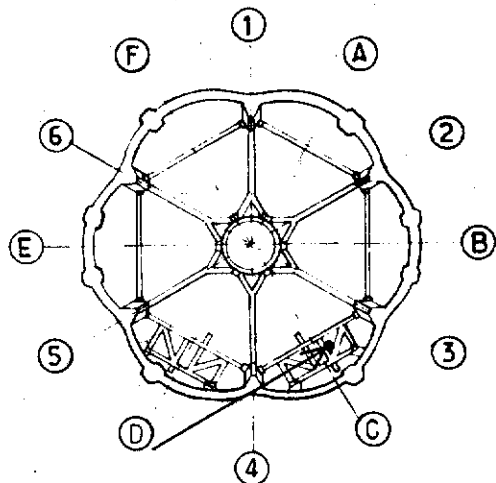

KEY PLAN

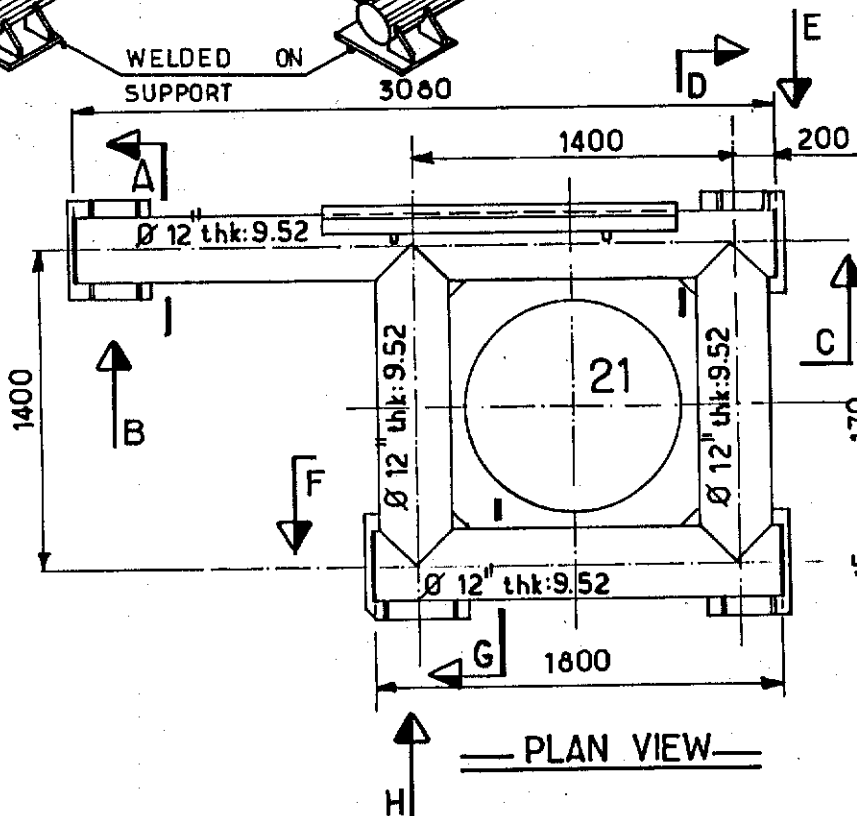


PLAN VIEW

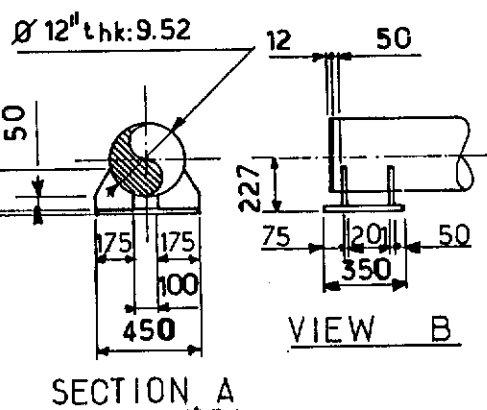


SECTION A


VIEW B

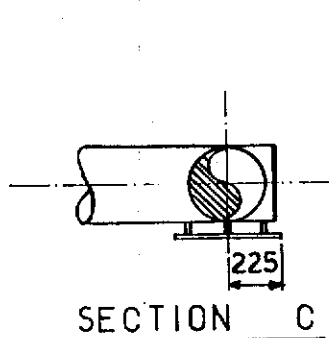


SECTION C

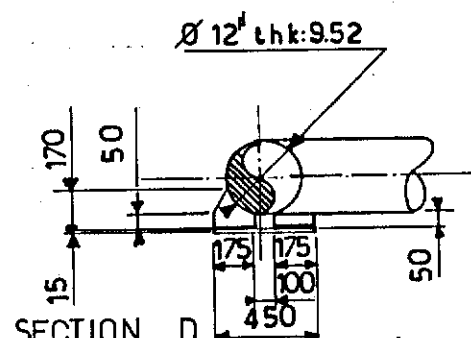


SECTION D

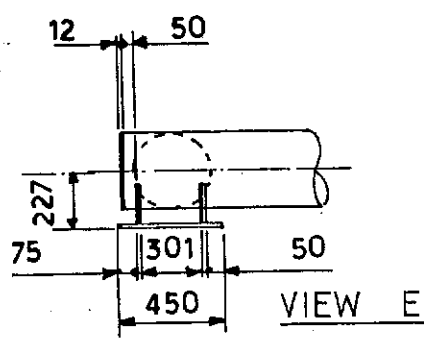


VIEW E

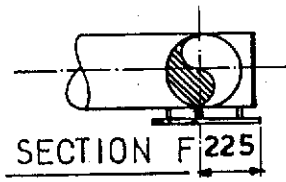

SECTION F

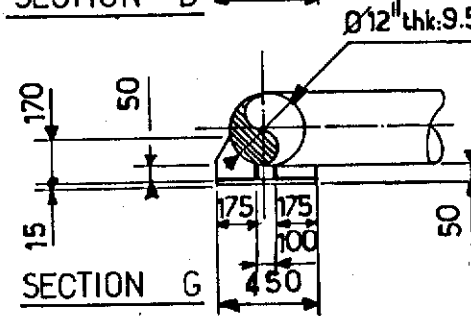

SECTION G

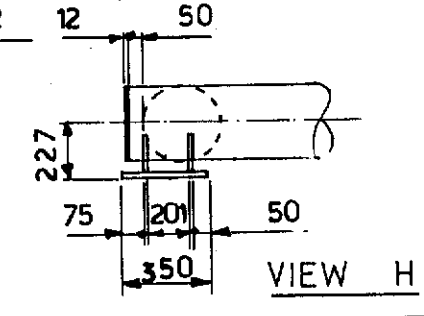

VIEW H

NOTES

FOR LOCATION SEE SK FF.91.36.35.1422

FOR CONDUCTOR SLEEVE SEE SK FF 91.36.35.1491.

FOR ZINC ANODE SEE SK FF 91-36-35-1587

						 elf	Job no.	Installation CDP 1	System UNDERWATER
1	12.83	UP DATED	BVH	1-1C			Scale 1:33	CONDUCTOR GUIDE N°21 CELL C SECONDARY FRAME LEVEL D	
Rev.	Date	DESCRIPTION	by	app.			Dwgr. no.		
Contractor JVD 1029_40-102.					4001 Stavanger		FRIGG FIELD	FF 91.36.35.14 32	1

CDP 1 AS BUILT DRAWINGS


REFERENCE DRAWING LIST FOR:

[illegible]

							Job no.	Installation CDP 1	System UNDERWATER
							Scale		
Rev.	Date	DESCRIPTION	by	app.			Dwgr. no.	FF — — 1432	H.L. Sheet /
Contractor						elf aquitaine norge a/s p.o.box 168 4001 Stavanger	FRIGG FIELD		


ZINC ANODE

WELDED ON
SUPPORT

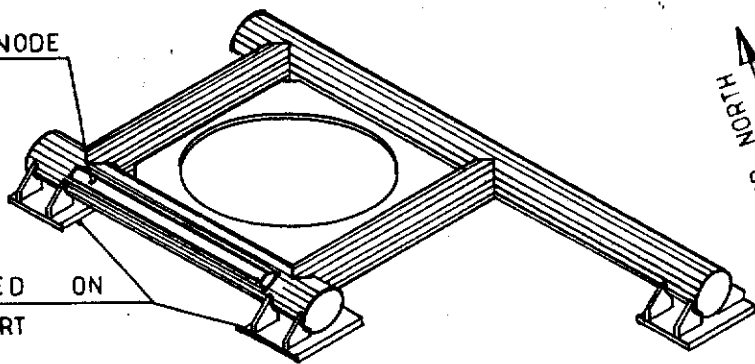


CONDUCTOR GUIDE N°22

GRID NORTH
19°37'
PLAT. NORTH

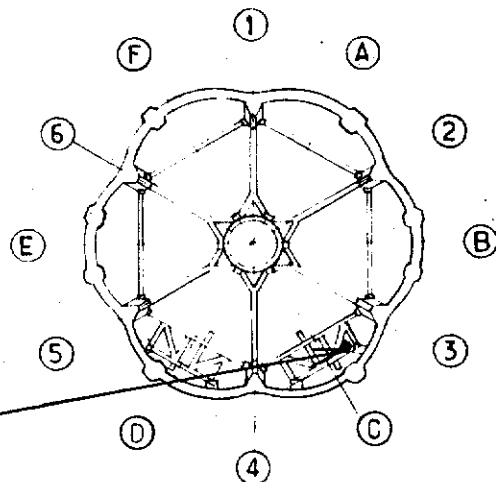

KEY PLAN

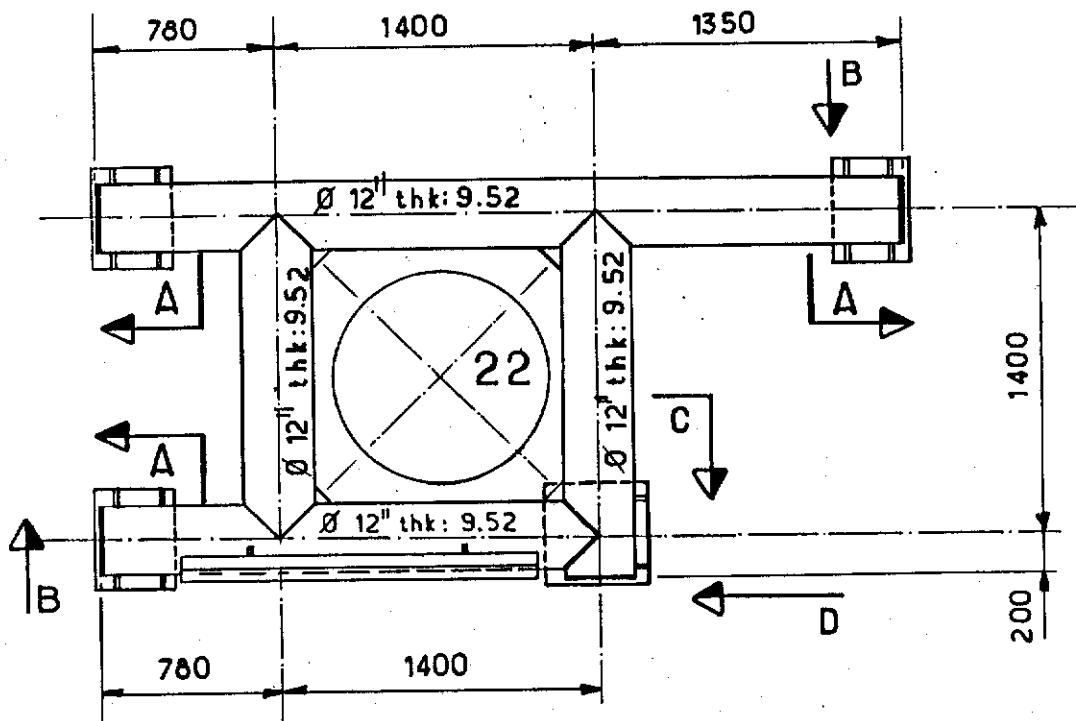


PLAN VIEW



SECTION A

VIEW B

SECTION C
Ø 12" thk: 9.52

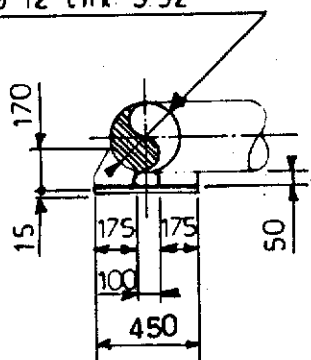

VIEW D

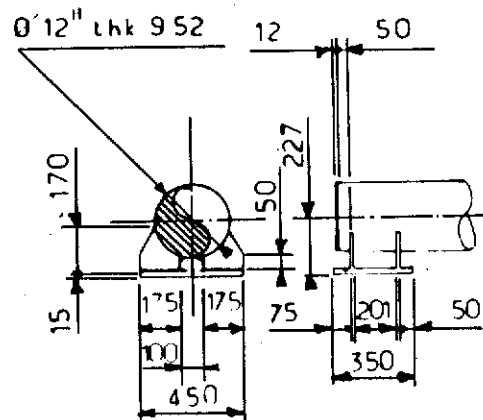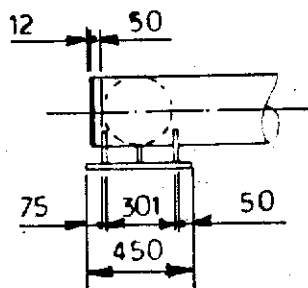

NOTES

FOR LOCATION SEE SK FF 91-36-35-1422-
FOR CONDUCTOR SLEEVE SEE SK FF 91-36-35-1491.

FOR ZINC ANODE SEE SK FF 91-36-35-1587

					elf aquitaine norge a/s p.o.box 168 4001 Stavanger	 elf	Job no.	Installation CDP 1	System UNDERWATER		
1	1283	UP DATED	BVH	MLC			Scale 1:33	CONDUCTOR GUIDE N°22 CELL C SECONDARY FRAME LEVEL D			
Rev.	Date	DESCRIPTION	by	app.			Dwgr. no.	FF 91-36-35-1433.		Rev.	Sheet
Contractor JVD 1029_40_103_							FRIGG FIELD		1		/

CDP 1 AS BUILT DRAWINGS


REFERENCE DRAWING LIST FOR:

[illegible]



							Job no.	Installation CDP 1	System UNDERWATER	
							Scale			
Rev.	Date	DESCRIPTION	by	app.			Dwgr. no.			
							FF	1433		
Contractor										
elf aquitaine norge a/s p.o.box 168 4001 Stavanger						FRIGG FIELD				

—CONDUCTOR GUIDE N°23—

ZINC ANODE

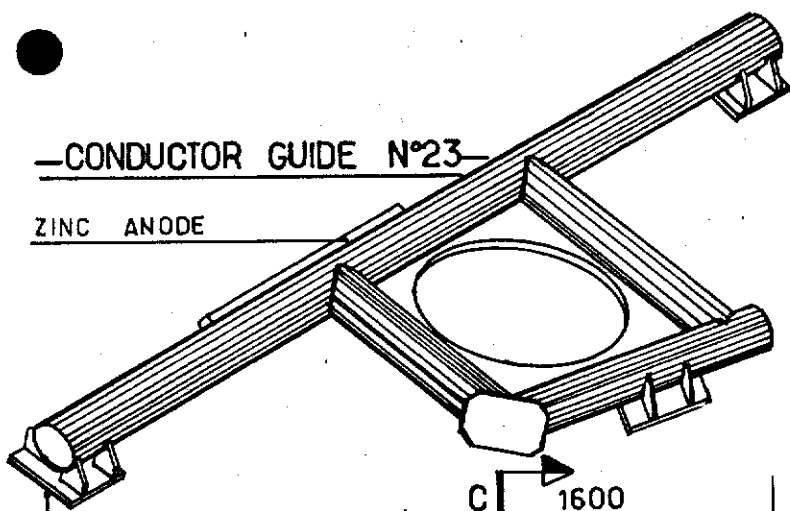

WELDED ON
SUPPORT

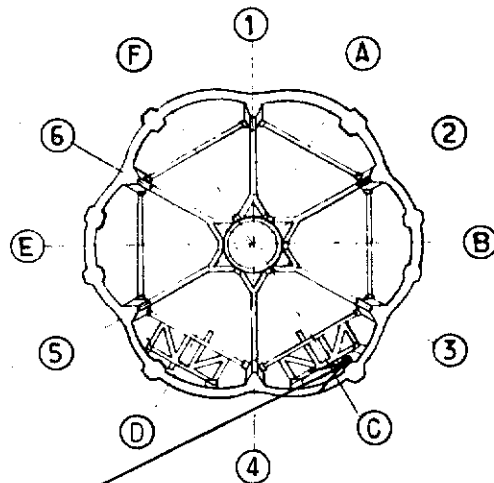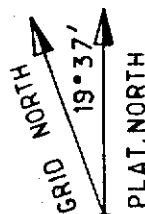


KEY PLAN


NOTES

FOR LOCATION SEE SK FF.91.36.35.1422.
FOR CONDUCTOR SLEEVE SEE SK FF.91.36.35.1491
FOR ZINC ANODE SEE SK FF.91.36.35.1587


—PLAN VIEW—

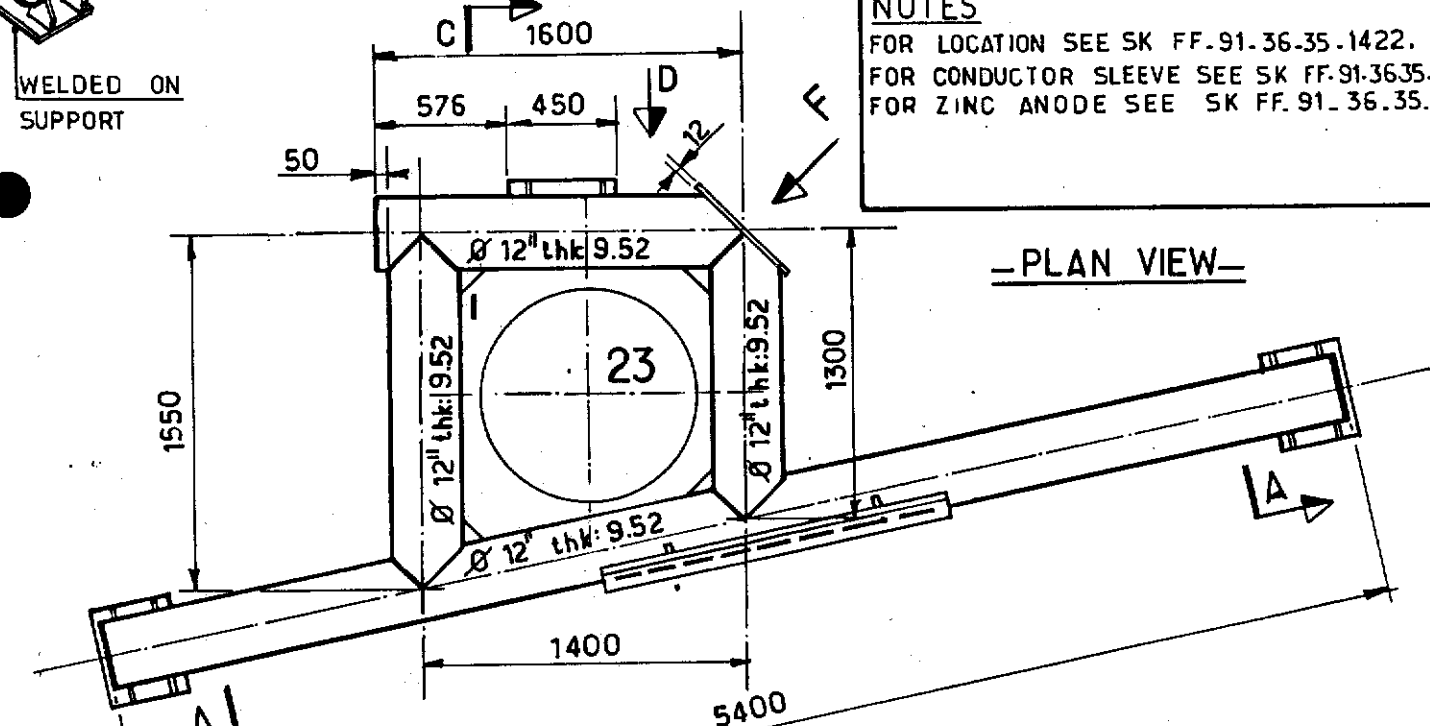


—VIEW F—

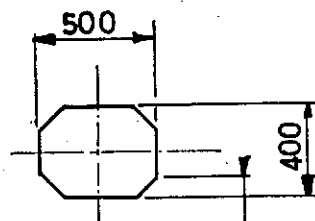


VIEW B

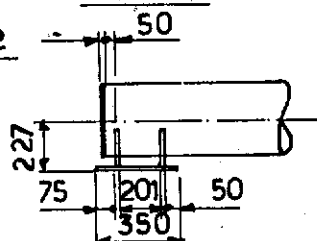


VIEW D

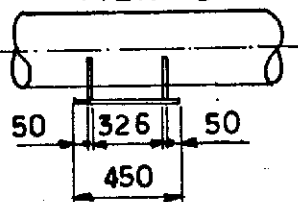


VIEW E

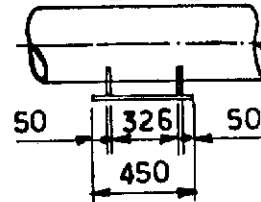

SECTION A

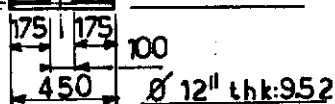

SECTION C

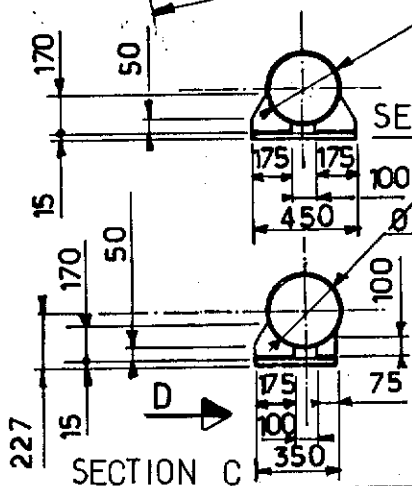

Rev.	Date	DESCRIPTION	by	app.
1	1283	UP DATED	BVH	/lc
Contractor JVD 1029_40_104_				

elf
aquitaine
norge a/s
p.o.box 168
4001 Stavanger

elf
FRIGG FIELD

Job no.	Installation CDP 1	System UNDERWATER
Scale 1:33	CONDUCTOR GUIDE N°23 CELL C SECONDARY FRAME LEVEL D	
Dwgr. no.	FF 91_36_35.1434_	Rev 1
		Sheet


CDP 1 AS BUILT DRAWINGS

REFERENCE DRAWING LIST FOR:

[illegible]


				elf		Job no.		Installation		System	
				aquitaine				CDP 1		UNDERWATER	
				norge a/s				Scale			
Rev.	Date	DESCRIPTION	by	app.	p.o.box 168	elf		Dwgr. no.		Rev.	Drawn
Contractor					4001 Stavanger	FRIGG FIELD		FF — — 1434			/

WELDED ON
SUPPORT

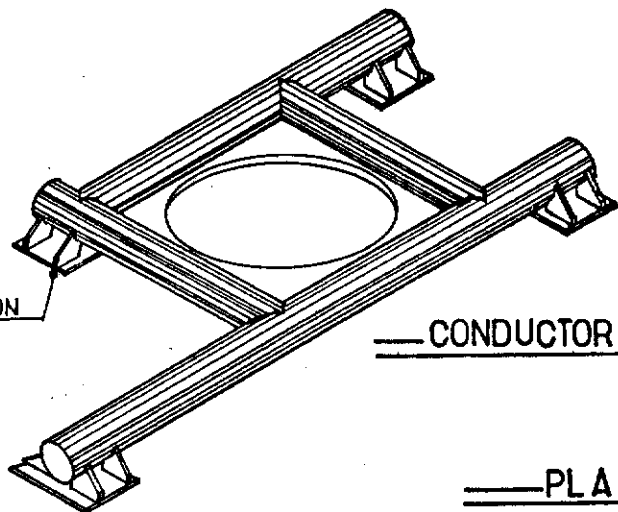


CONDUCTOR GUIDE N°24

GRID NORTH
19° 37'
PLAT. NORTH

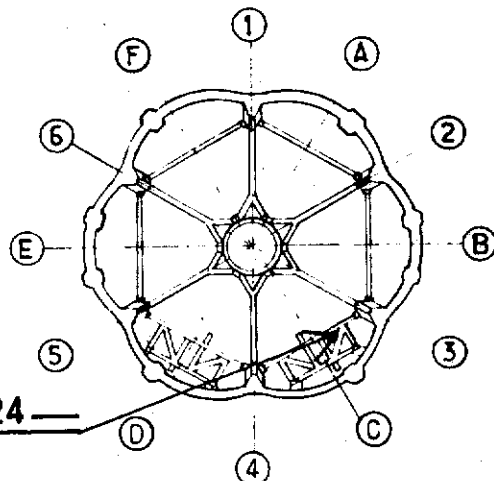


KEY PLAN

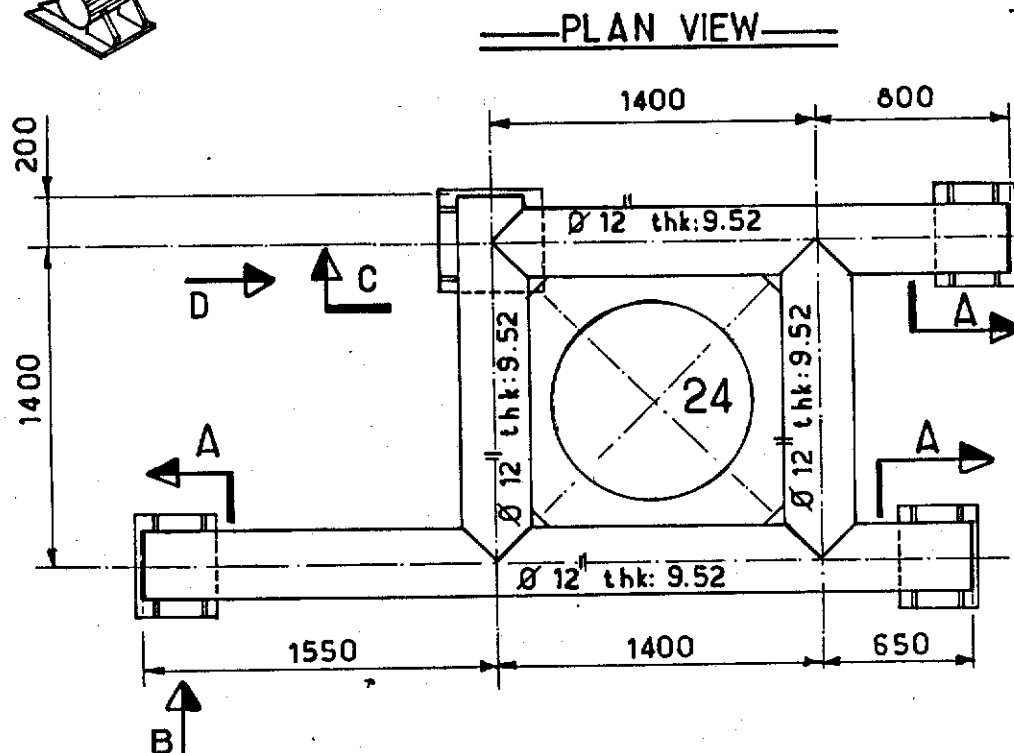


SECTION A

Ø 12" thk: 9.52

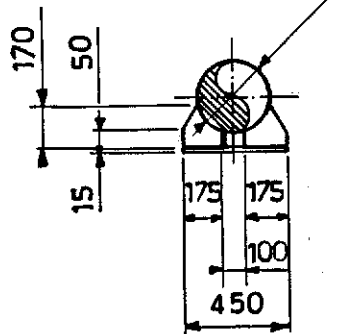


VIEW B

12 50

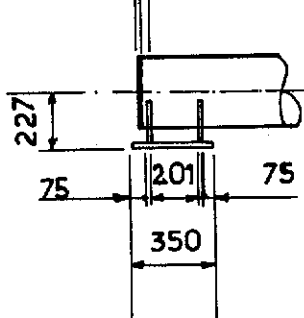


SECTION C

Ø 12" thk: 9.52

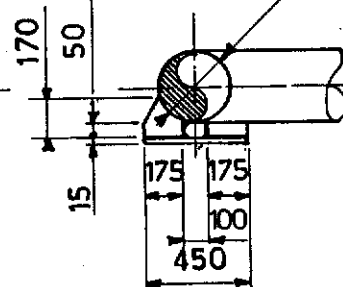

VIEW D

12 50

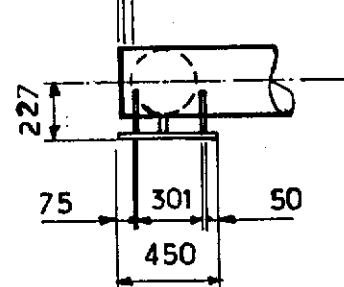

NOTES

FOR LOCATION SEE SK FF 91.36.35.1422
FOR CONDUCTOR SLEEVE SEE SK FF.91.36.35.1491.

Rev.	Date	DESCRIPTION	by	app.
1	12.83	UP DATED	BV.H	J.C
Contractor	JVD	1029_40.105_		

elf
aquitaine
norge a/s
p.o.box 168
4001 Stavanger

elf
FRIGG FIELD


Job no.	Installation	System
	CDP 1	UNDERWATER
Scale	CONDUCTOR GUIDE N°24 CELL C SECONDARY FRAME LEVEL D	
1:33		
Dwgr. no.	Rev	Sheet
FF 91.36.35.1435	1	

CDP 1 AS BUILT DRAWINGS


REFERENCE DRAWING LIST FOR:

[illegible]


						 elf	Job no.	Installation CDP 1	System UNDERWATER		
							Scale				
Rev.	Date	DESCRIPTION	by	app.			Dwgr. no.	FF — — 1435		Rev.	Sheet
Contractor					4001 Stavanger	FRIGG FIELD					

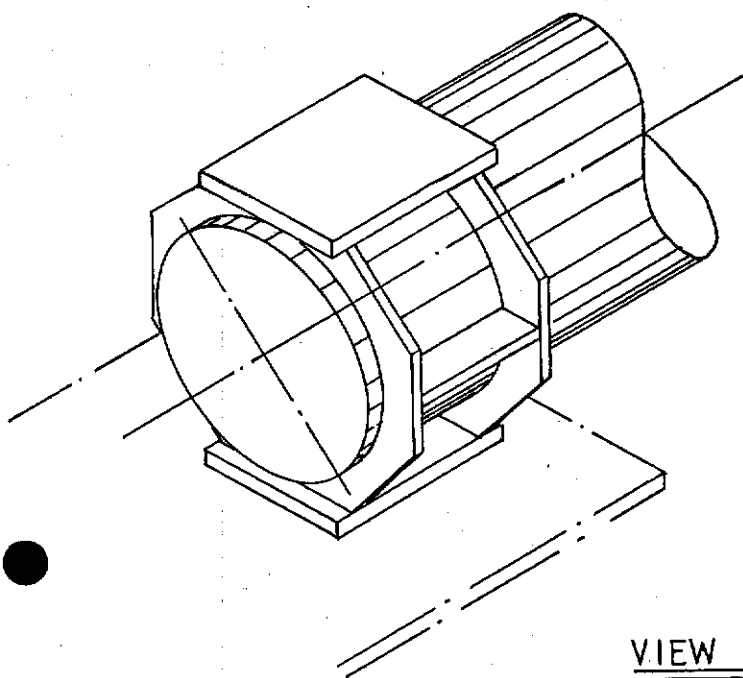


NORTH
 19°37'
 PLAT. NORTH

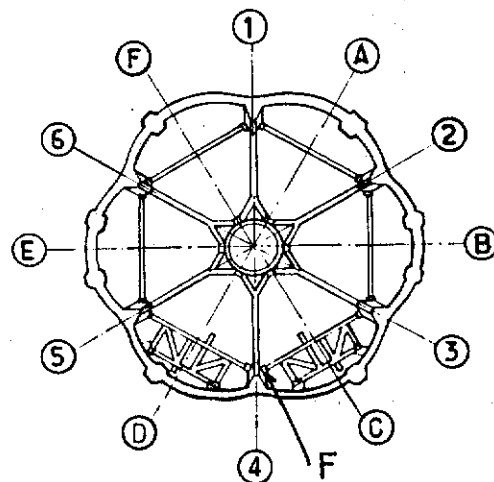

KEY PLAN

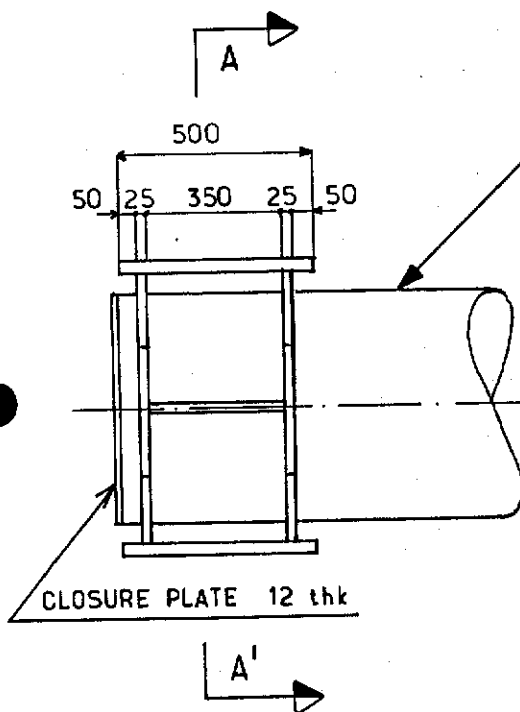

24" DIA. x 1" W.T.

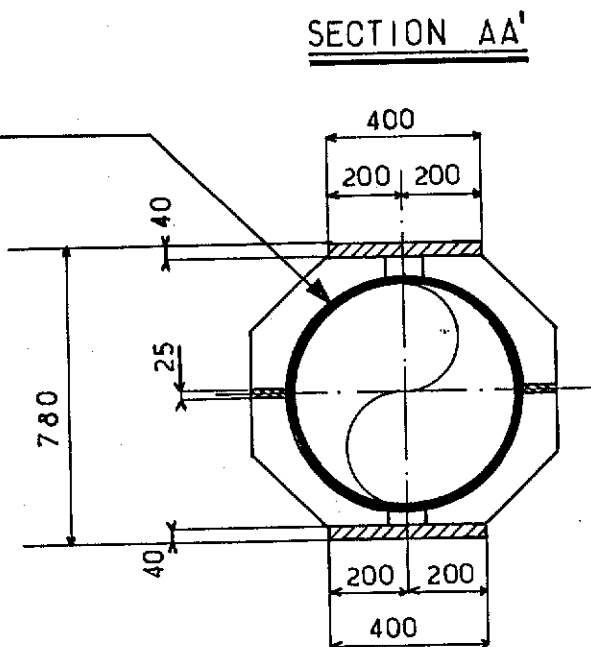

NOTES

FOR LOCATION SEE SK FF_91_36_35_1422
 FOR BOX FOR FREE LOCK SEE SK FF_91_36_35_1438


				elf aquitaine norge a/s		 elf		Job no.	Installation CDP 1	System UNDERWATER
1	12.83	UP DATED	BVH /LC	p.o. box 168				Scale 1:20	FREE LOCK PIPE END CELL C LEVEL D	DC1
Rev.	Date	DESCRIPTION	by	app.	4001 Stavanger	FRIGG FIELD	Dwgr. no.	FF 91-36-35-1436	Rev 1	Sheet
Contractor JVD 1029_40.106.										

CDP 1 AS BUILT DRAWINGS


REFERENCE DRAWING LIST FOR:

[illegible]

							Job no.	Installation CDP 1	System UNDERWATER		
							Scale				
Rev.	Date	DESCRIPTION	by	app.			Dwgr. no.			Rev.	Sheet
Contractor							FF	1436			/


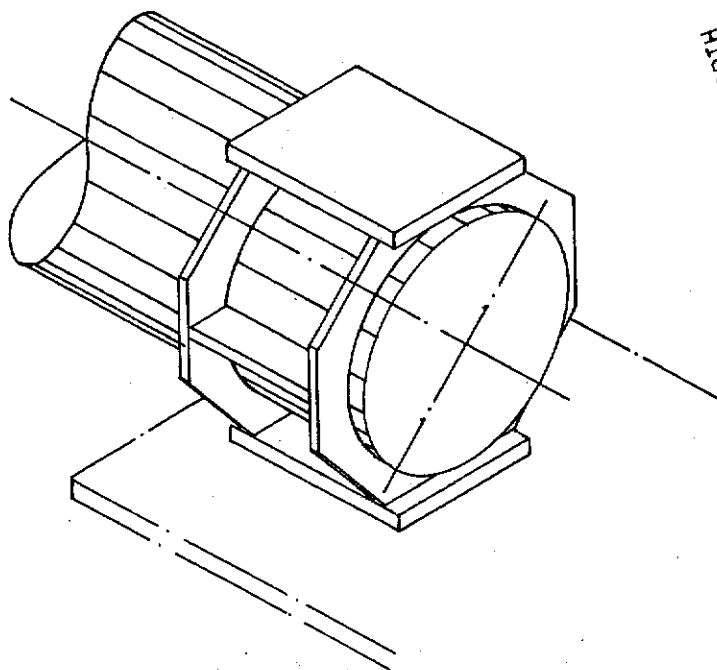


GRID NORTH
19° 37'
PLAT. NORTH

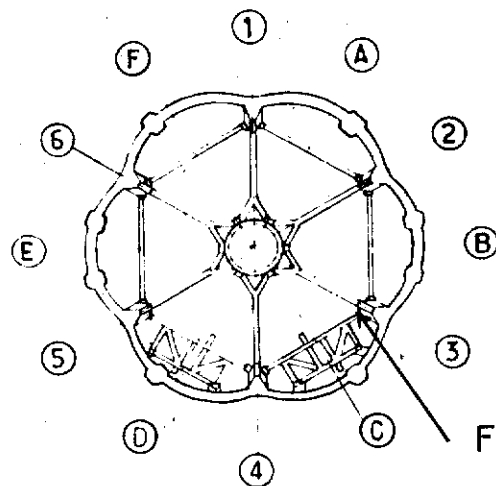

KEY PLAN

VIEW F

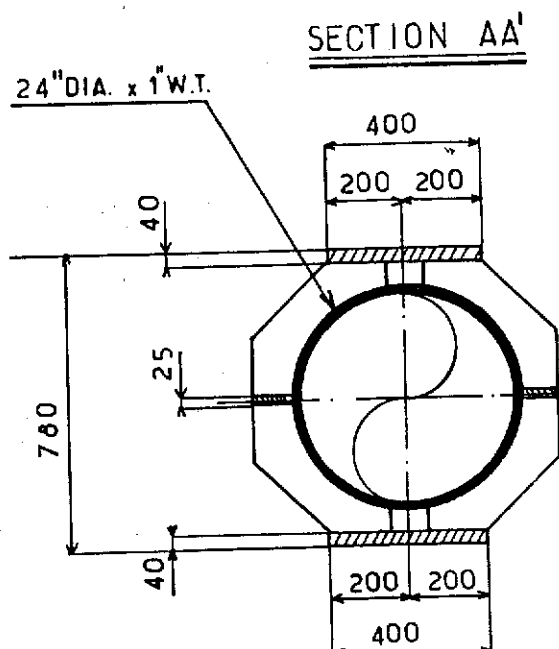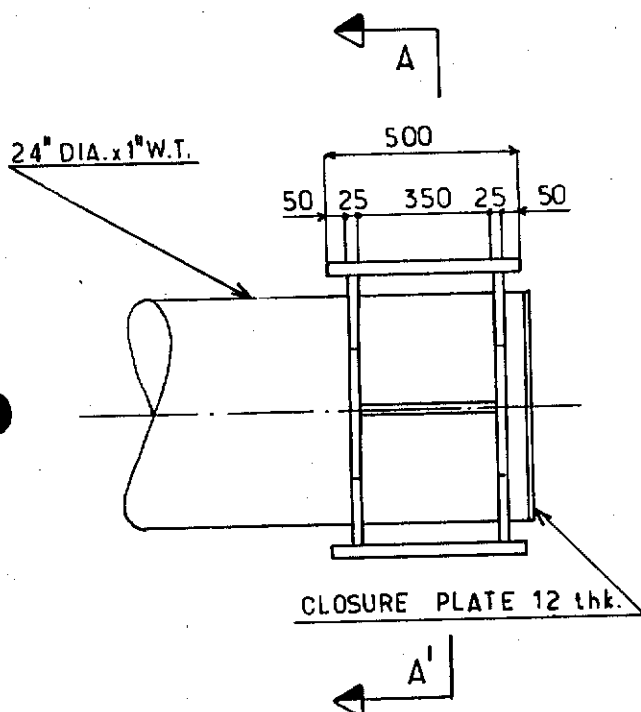

NOTES

FOR LOCATION SEE SK FF. 91.36.35.1422
FOR BOX FOR FREE LOCK SEE SK FF. 91.36.35.1439


					elf aquitaine norge a/s p.o.box 168 4001 Stavanger	 elf	Job no.	Installation CDP 1	System UNDERWATER	
1	1283	UP DATED	BVH	J-LC			Scale 1:20	FREE LOCK PIPE END CELL C	DC 4 LEVEL D	
Rev.	Date	DESCRIPTION	by	app.			Dwgr. no.	FF 91.36.35.1437	No. 1	Sheet /
Contractor JVD 1029.40.107.							FRIGG FIELD			

CDP 1 AS BUILT DRAWINGS

REFERENCE DRAWING LIST FOR:

[illegible]

						elf aquitaine norge a/s p.o.box 168 4001 Stavanger	 elf	Job no.	Installation CDP 1	System UNDERWATER	
								Scale			
Rev.	Date	DESCRIPTION	by	app.				Dwgr. no. FF	1437	Rev.	Sheet /
Contractor											

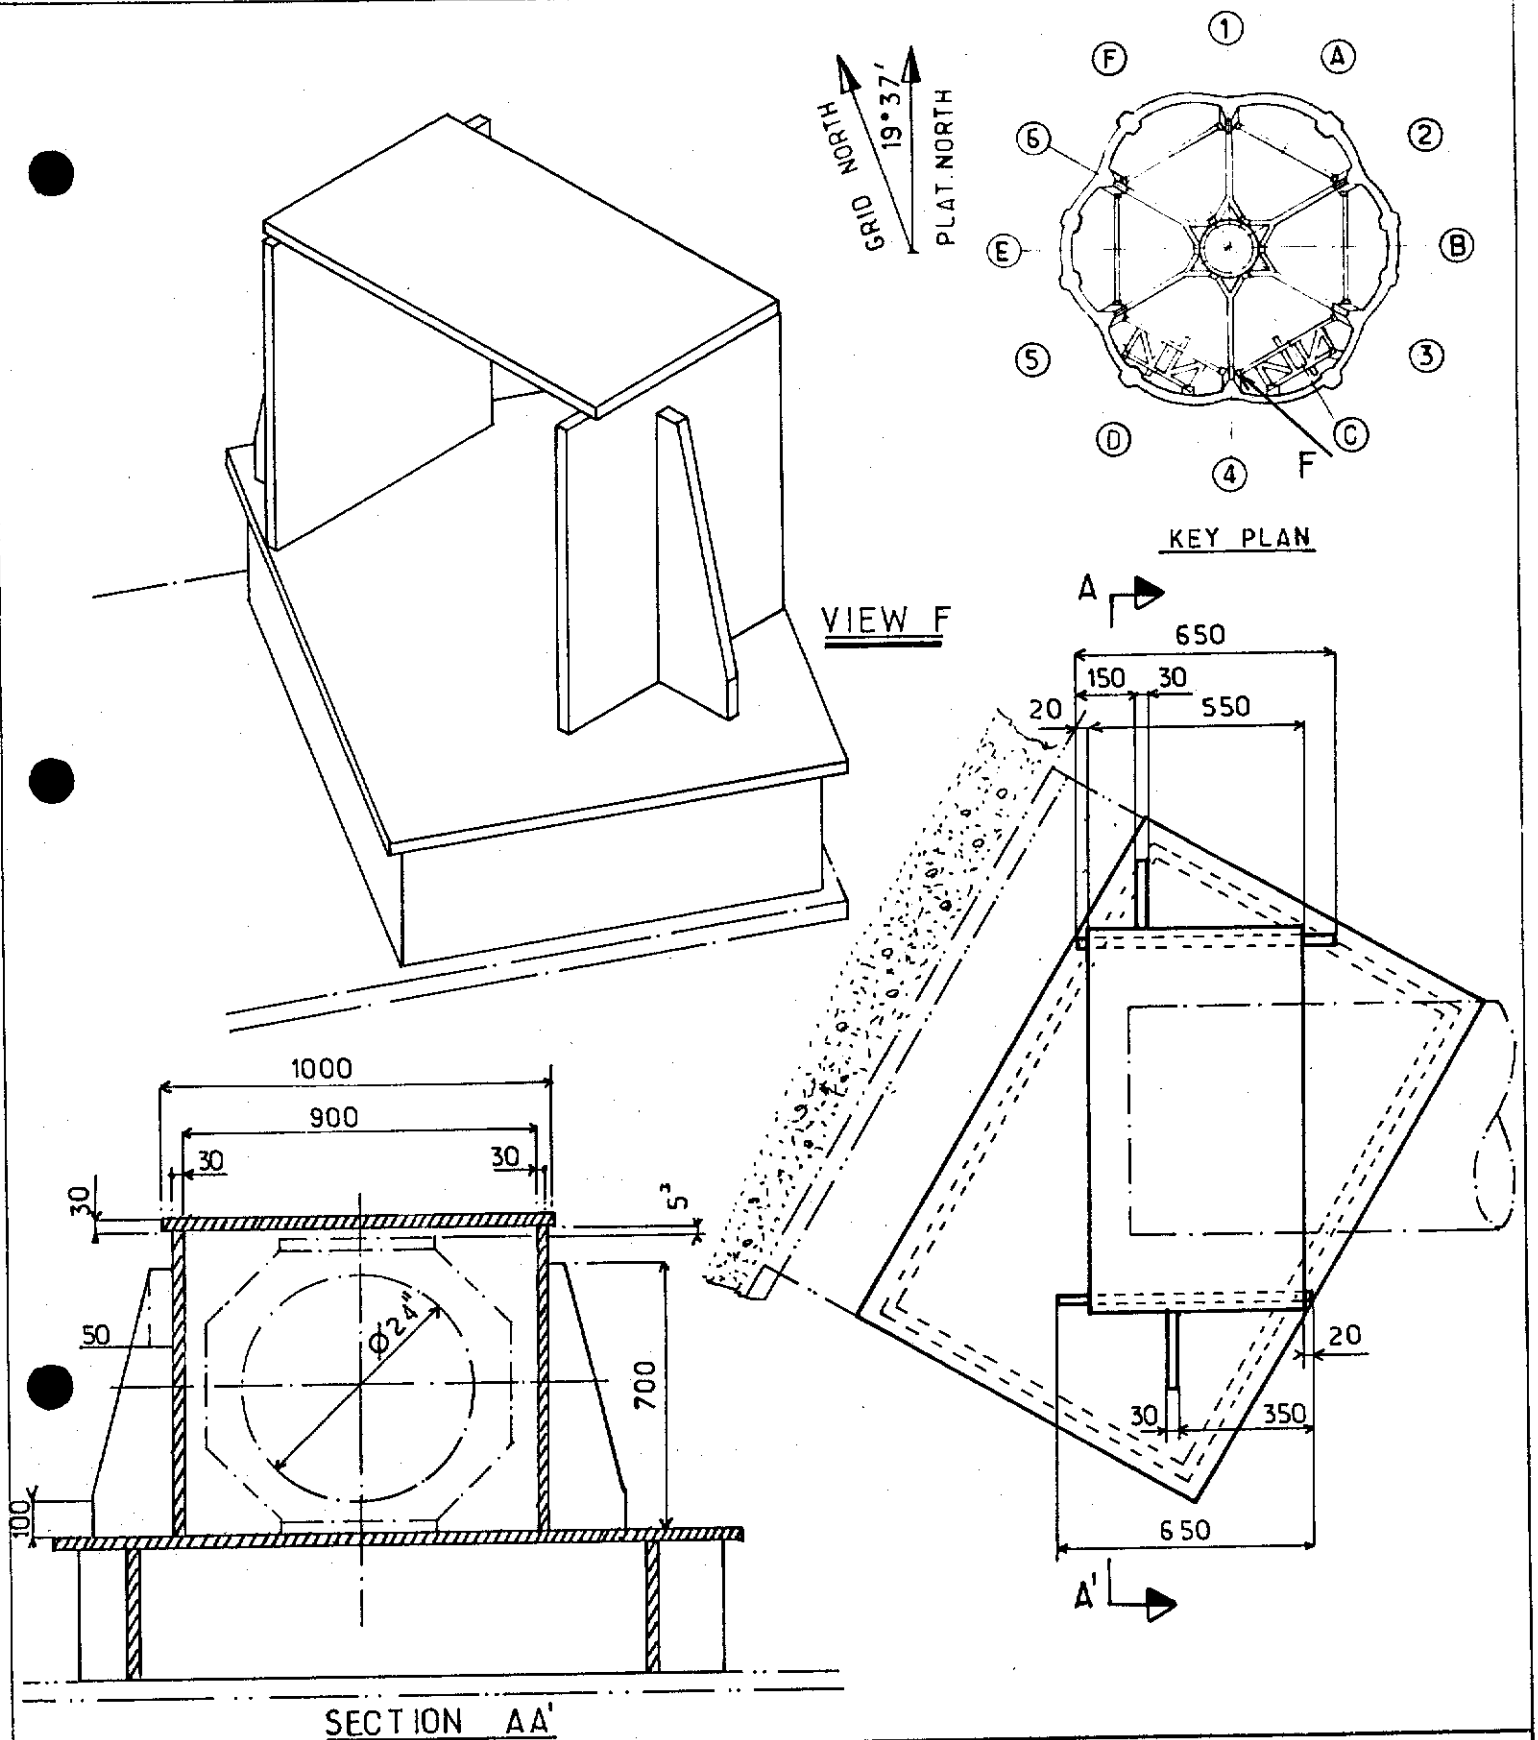

NOTES

FOR LOCATION SEE SK FF_91_36_35.1422.

FOR DETAIL OF FREE LOCK PIPE END SEE SK FF_91_36_35.1436.


				elf aquitaine norge a/s		 FRIGG FIELD	Job no.	Installation CDP 1	System UNDERWATER
1	1283	UP DATED	BVH	JLC	p.o.box 168		Scale 1:20	BOX FOR FREE LOCK DC1 CELL C LEVEL 0	
Rev.	Date	DESCRIPTION	by	app.	Contractor JVD 1029_40.108		Dwgr. no.	FF 91-36-35-1438-	1
					4001 Stavanger				

CDP 1 AS BUILT DRAWINGS



REFERENCE DRAWING LIST FOR:

[illegible]

					elf aquitaine norge a/s p.o.box 168 4001 Stavanger	 elf	Job no.	Installation CDP 1	System UNDERWATER		
							Scale	BOXE FOR FREE Lock DC1			
Rev.	Date	DESCRIPTION	by	app.			Dwgr. no.	FF — — 1438		Rev.	Sheet
Contractor					4001 Stavanger	FRIGG FIELD					


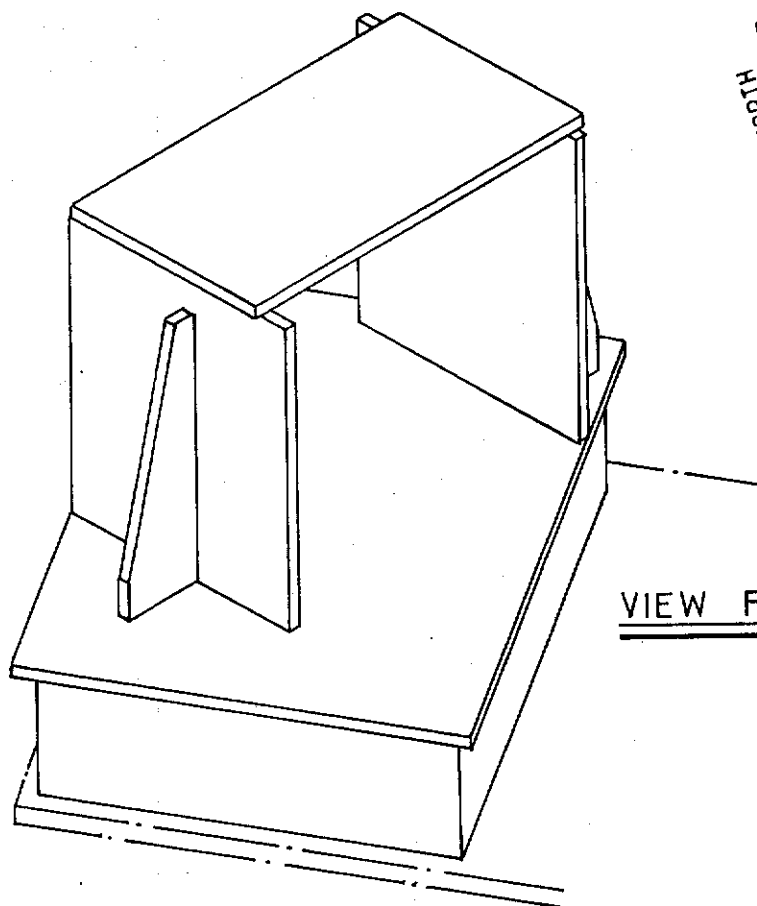


VIEW F

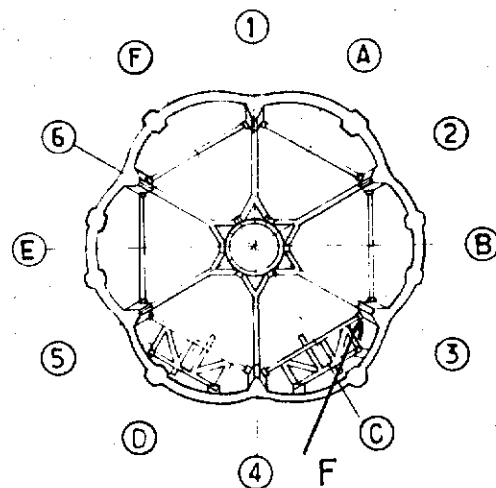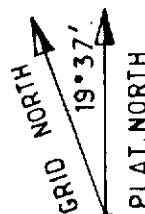

KEY PLAN

SECTION AA'

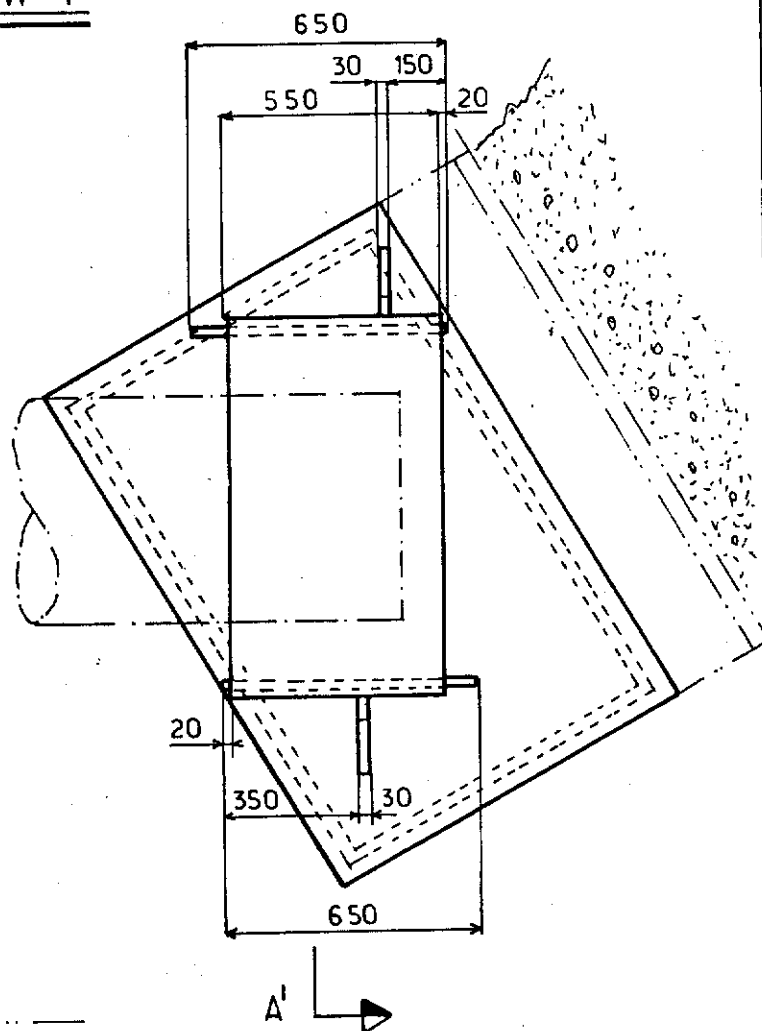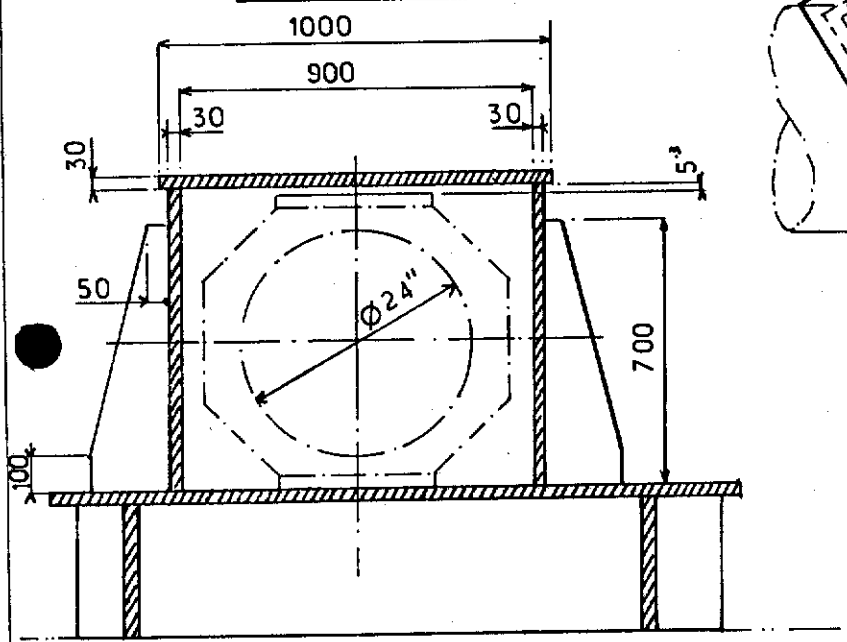

NOTES

FOR LOCATION SEE SK FF. 91.36.35.1422.

FOR DETAIL OF FREE LOCK PIPE END SEE SK. FF. 91.36.35.1437.



				elf aquitaine norge a/s p.o. box 168 4001 Stavanger	 elf	Job no.	Installation CDP 1	System UNDERWATER
1	12.83	UP DATED	B.V.H./J.C.			Scale 1:20	BOX FOR FREE LOCK CELL C	DC4 LEVEL D
Rev.	Date	DESCRIPTION	by	app.		Dwgr. no.	FF 91.36.35.1439.	
Contractor JVD 1029.40.109.				FRIGG FIELD			1	

CDP 1 AS BUILT DRAWINGS

REFERENCE DRAWING LIST FOR:

[illegible]

					elf aquitaine norge a/s p.o.box 168 4001 Stavanger	 elf	Job no.	Installation CDP 1	System UNDERWATER
							Scale	BOXE FOR FREE LOCK Dc4	
Rev.	Date	DESCRIPTION	by	app.	FRIGG FIELD	Dwgr. no. FF <u> </u> <u> </u> <u>1439</u>	Rev.	Sheet /	
Contractor									

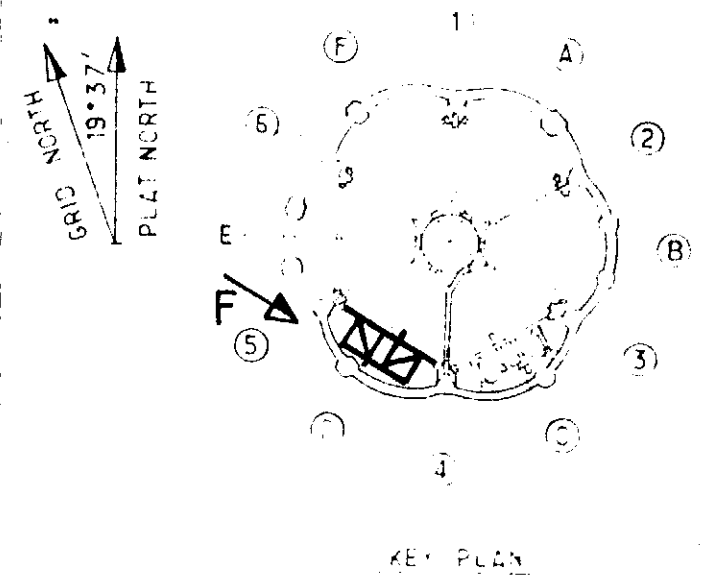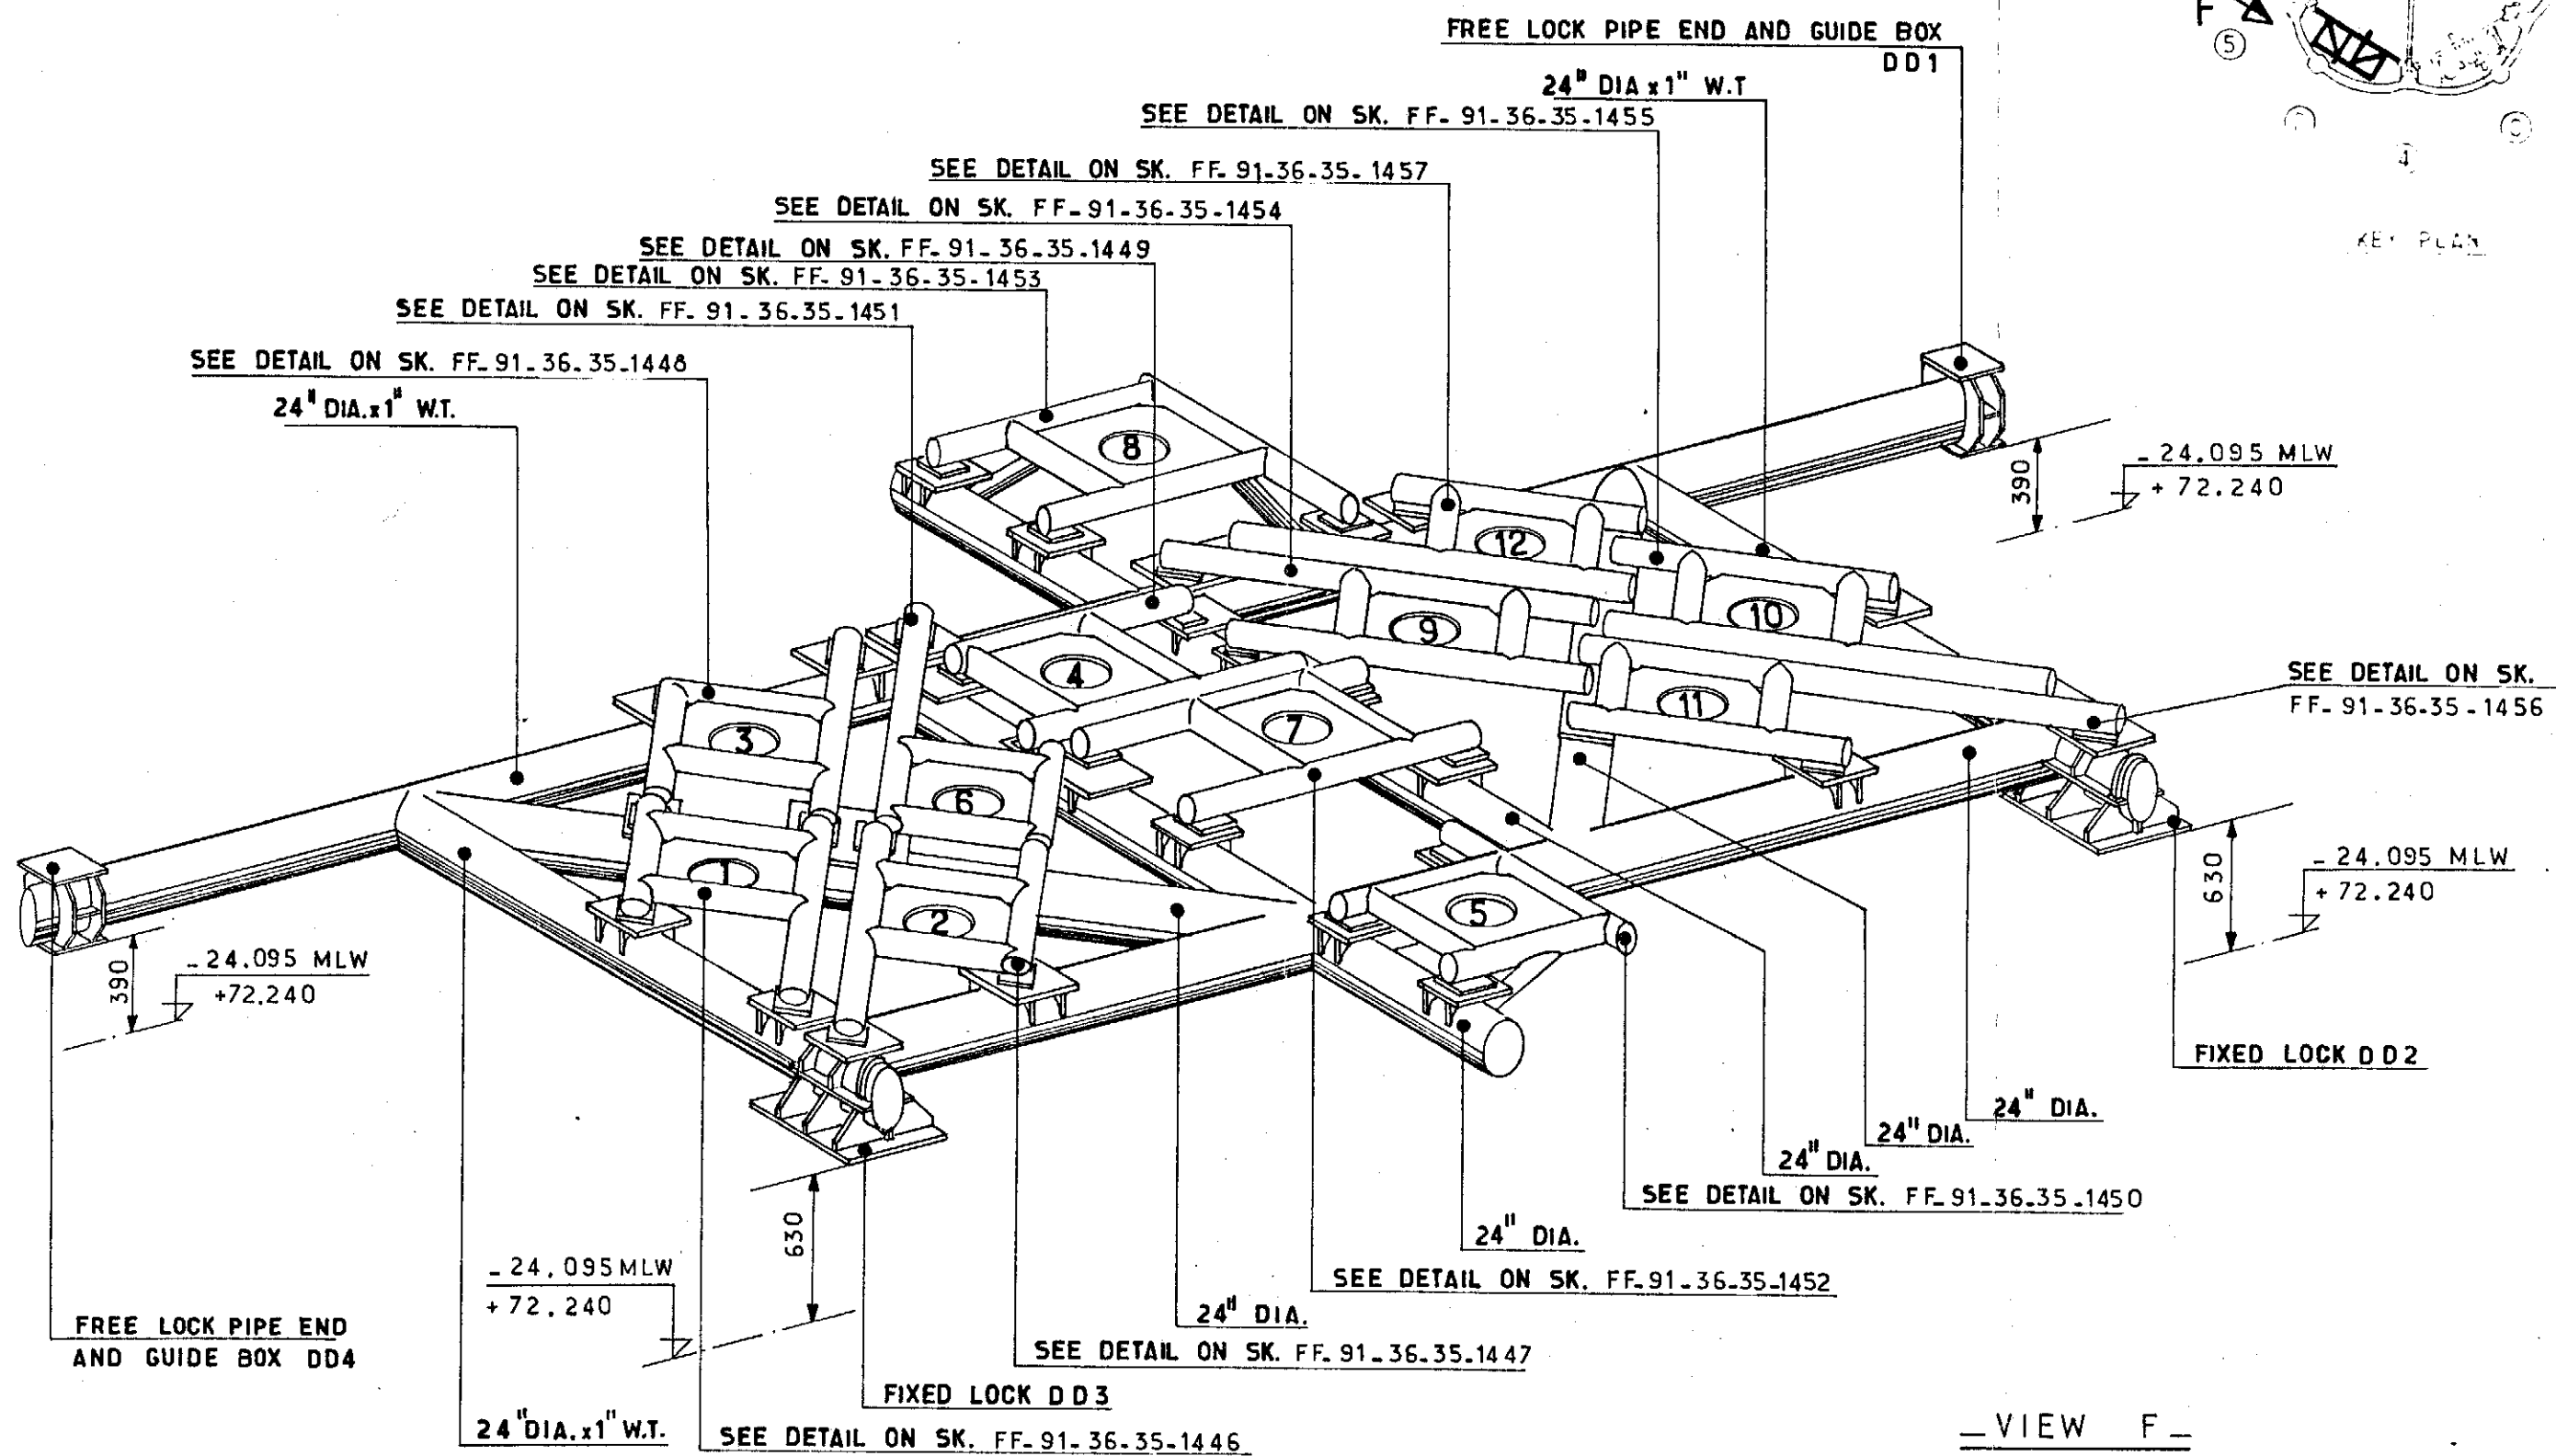

—VIEW F—

NOTES

FOR FREE LOCK PIPE ENDS AND GUIDE BOXES SEE SK FF.91.36.35.1458/1459/1460/1461.



elf aquitaine norge a/s p.o. box 168 4001 Stavanger				Job no.	Installation CDP 1	System UNDERWATER
1	1283	UP DATED	BV.H	Scale	GENERAL VIEW OF CONDUCTOR GUIDE FRAME CELL D LEVEL D	
Rev.	Date	DESCRIPTION	by	Dwgr. no	FF-91-36-35-1444	Rev 1
Contractor	JVD_1029_40.114			FRIGG FIELD		Sheet

CDP 1 AS BUILT DRAWINGS

REFERENCE DRAWING LIST FOR: CONDUCTOR GUIDE FRAME

[illegible]

					elf	Job no.	Installation CDP 1	System UNDERWATER	
Rev. Date DESCRIPTION by app.						Scale			
Contractor					4001 Stavanger	FRIGG FIELD	Dwgr. no. FF — — 1444	Rev.	Sheet /

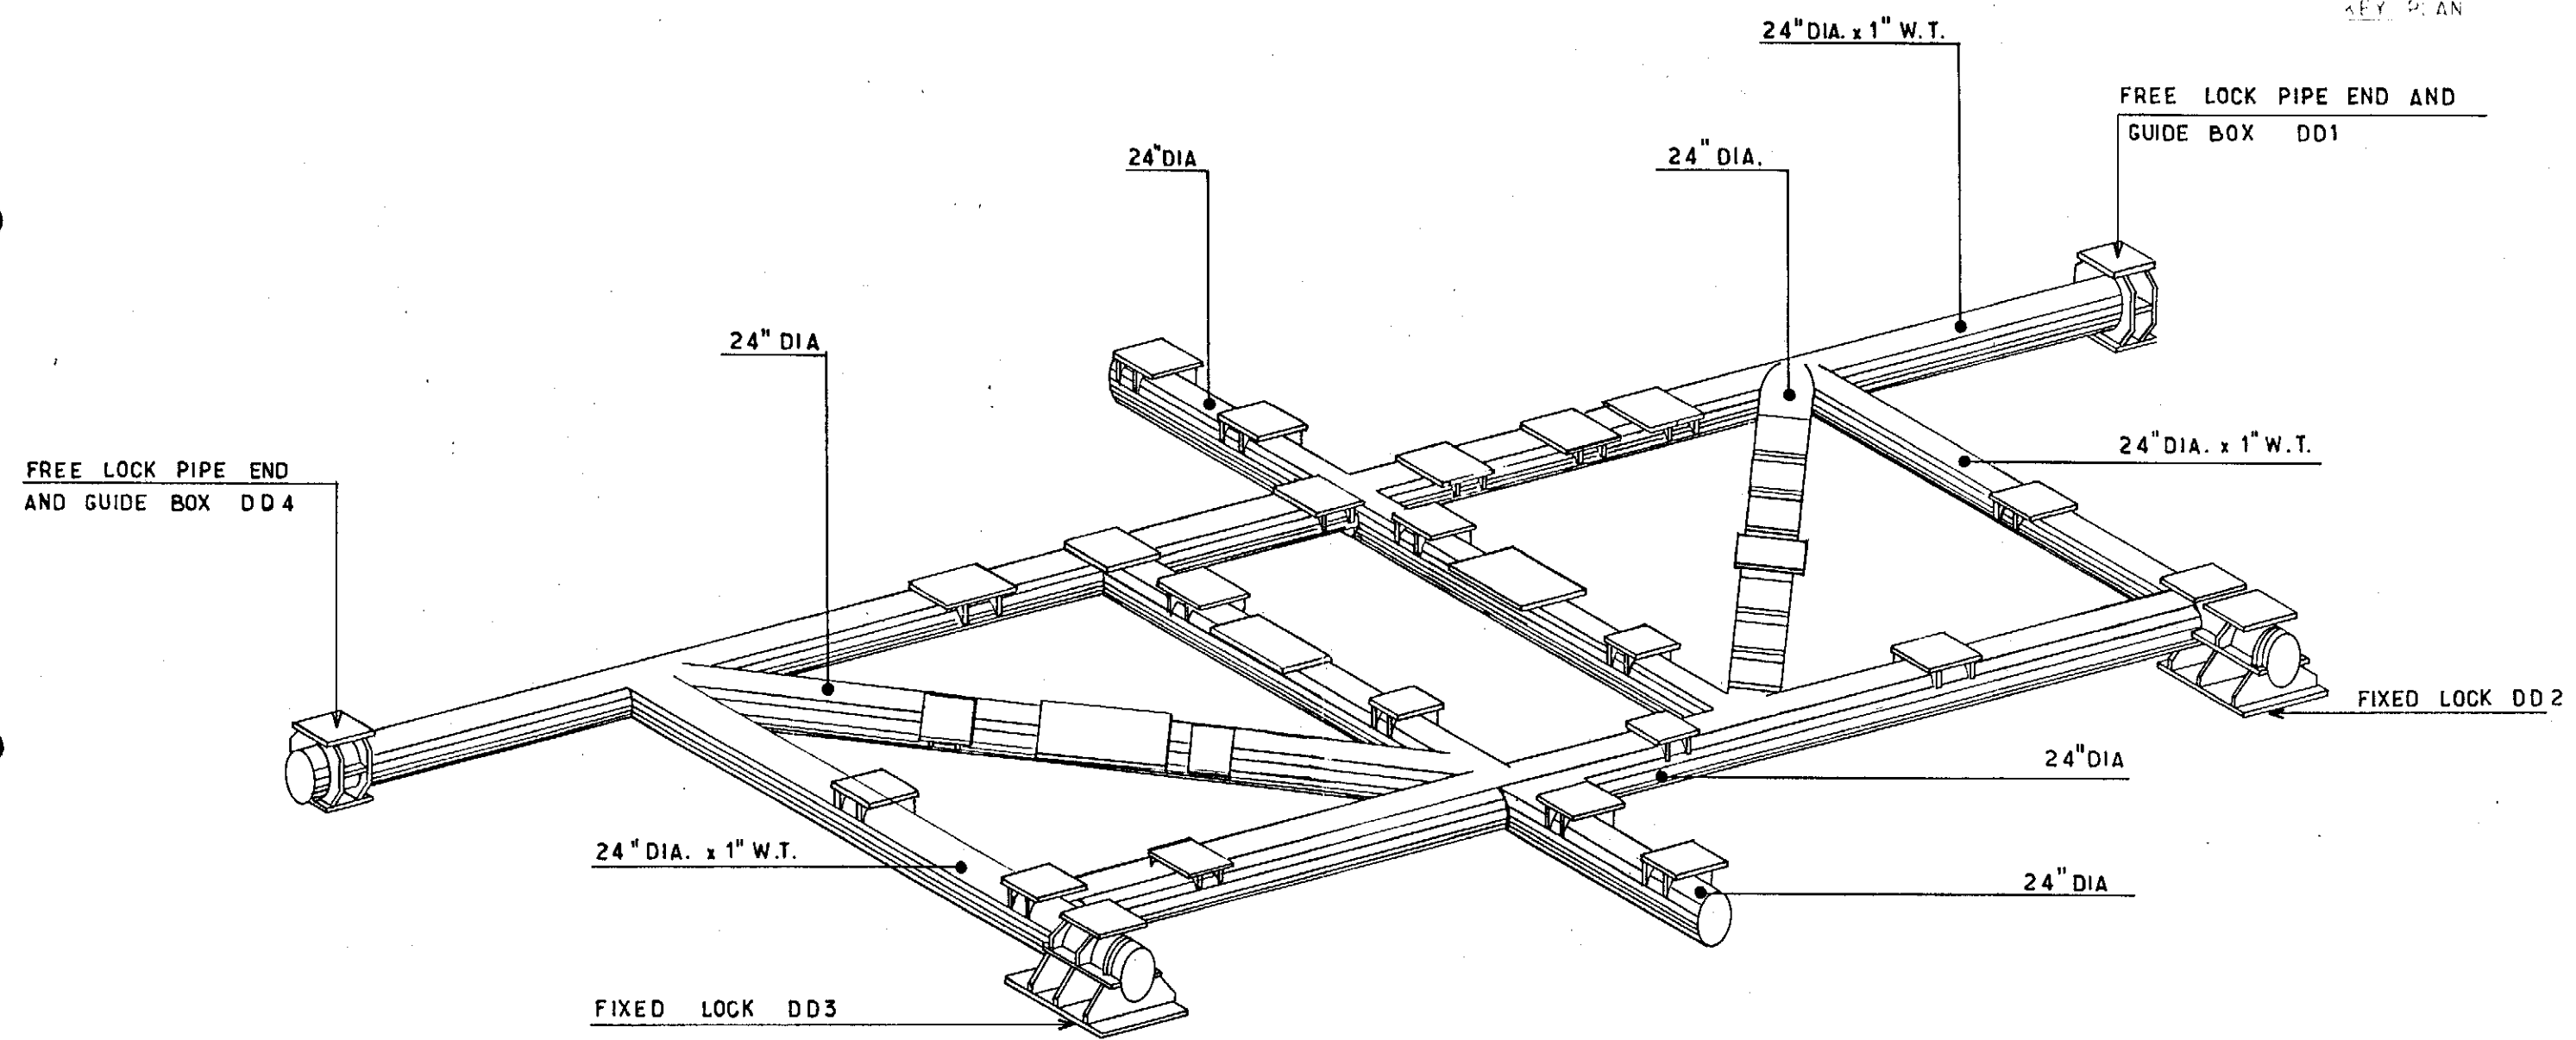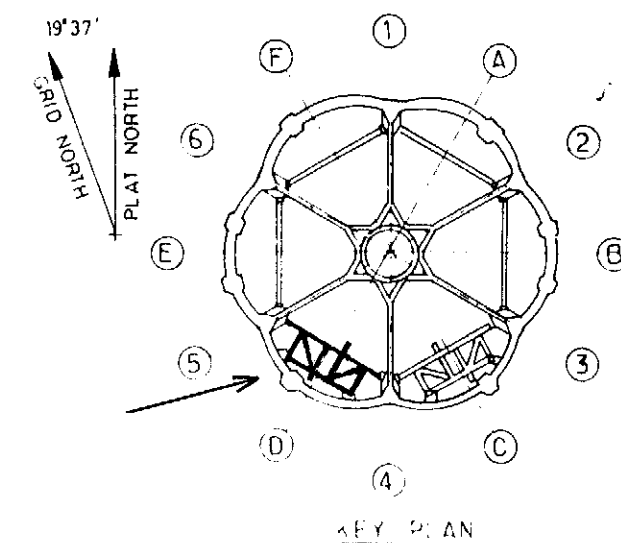

NOTES
 SECONDARY FRAME DETAILS SEE SK FF.91.36.35.1446. TO FF.91.36.35.1457.
 FOR FREE LOCK PIPE ENDS AND GUIDE BOXES SEE SK FF. 91.36.35.1458/ 1459/ 1460/ 1461.







						 elf	Job no.	Installation CDP 1	System UNDERWATER
1	12.83	UP DATED	BVH	LLC			Scale —	GENERAL VIEW OF FRAME SUPPORT	SECONDARY CELL D LEVEL D
Rev.	Date	DESCRIPTION	by	app.			Dwgr. no	FF 91-36-35-1445.	1
Contractor JVD 1029.40.115.						4001 Stavanger	FRIGG FIELD		

CDP 1 AS BUILT DRAWINGS

REFERENCE DRAWING LIST FOR:

[illegible][illegible]

				Job no. Scale	Installation CDP 1	System UNDERWATER
Rev. Date DESCRIPTION by app.				Dwgr. no. FF — — 1445		
Contractor				Rev. Sheet /		

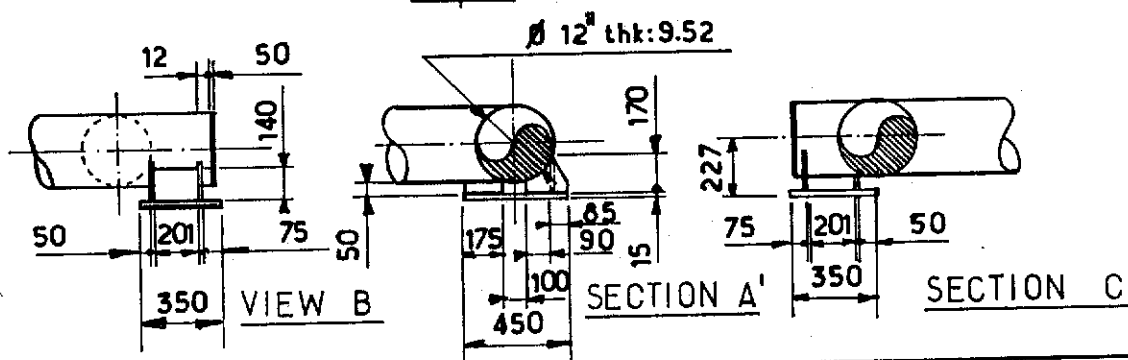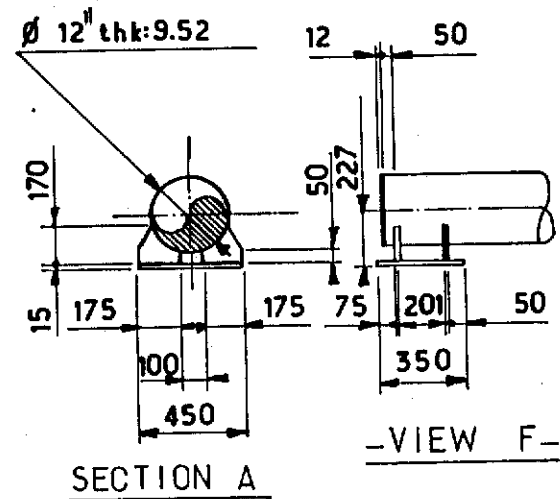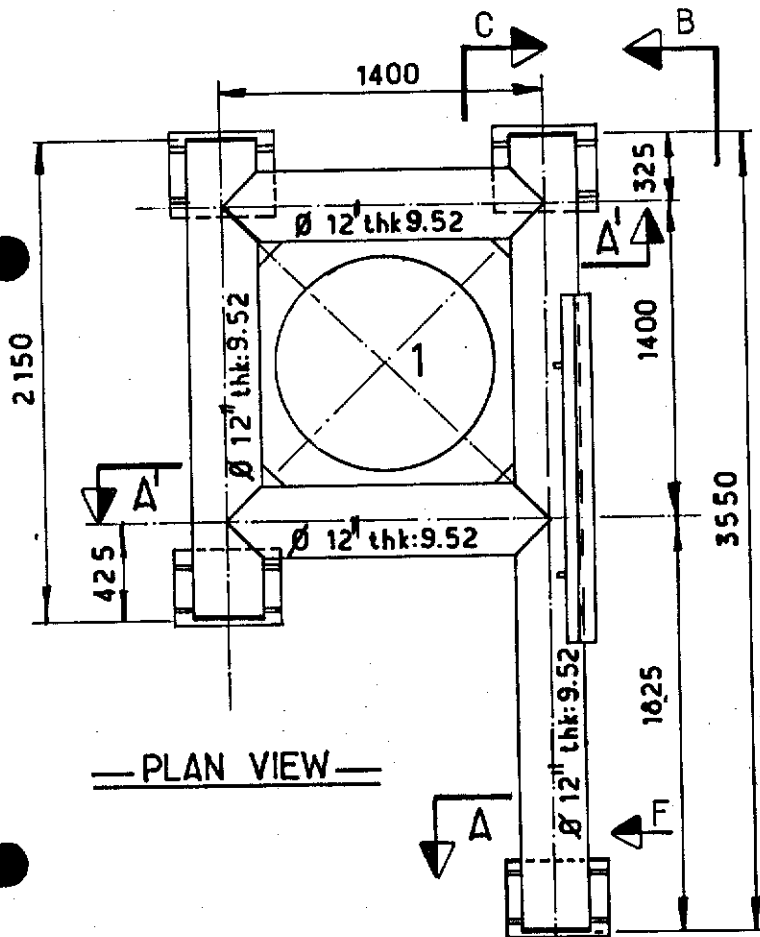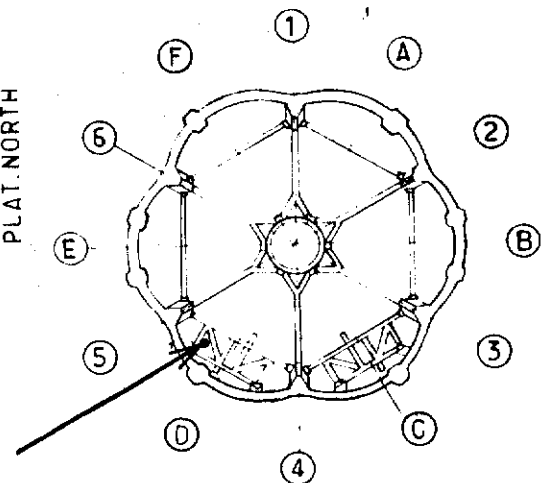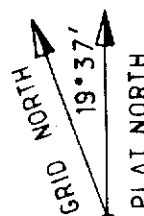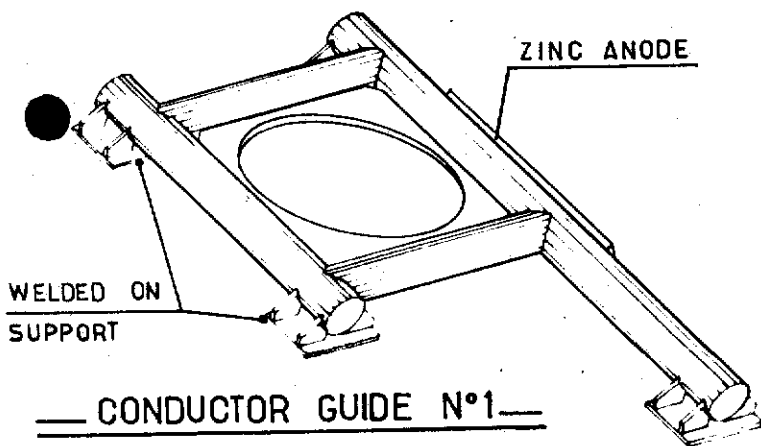

NOTES:

FOR LOCATION SEE SK FF. 91.36.35.1444

FOR CONDUCTOR SLEEVE SEE SK FF. 91.36.35.1491.

FOR ZINC ANODE SEE SK FF 91-36-35-1587




				elf aquitaine norge a/s		 elf	Job no.	Installation CDP 1	System UNDERWATER	
1	12.83	UP DATED	BY: JLC	p.o. box 168			Scale 1:33	CONDUCTOR GUIDE N°1 CELL D SECONDARY FRAME LEVEL D		
Rev.	Date	DESCRIPTION	by	app.	4001 Stavanger		Dwgr. no.	FF 91.36.35.1446	1	
Contractor JVD 1029_40.116.					FRIGG FIELD					

CDP 1 AS BUILT DRAWINGS

REFERENCE DRAWING LIST FOR:



[illegible][illegible]

elf aquitaine norge a/s p.o.box 168 4001 Stavanger		elf FRIGG FIELD		Job no. Scale	Installation CDP 1	System UNDERWATER		
Rev.	Date	DESCRIPTION	by	app.	Dwgr. no.		Rev	Sheet
Contractor					FF <u>1446</u>			

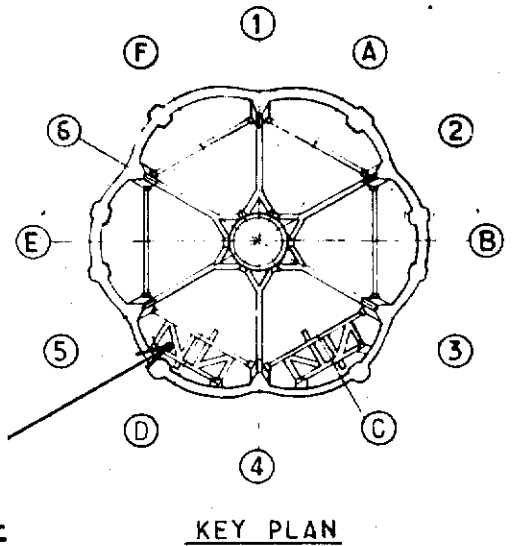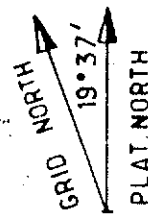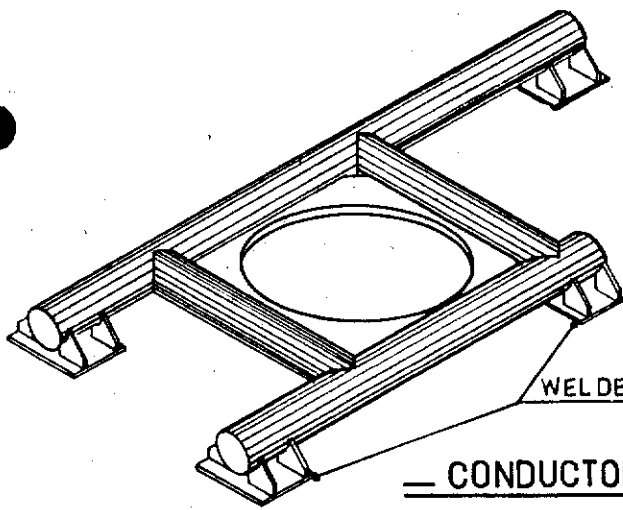


— CONDUCTOR GUIDE N°2 —

KEY PLAN

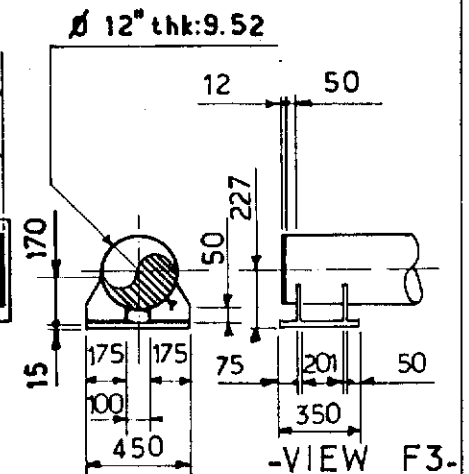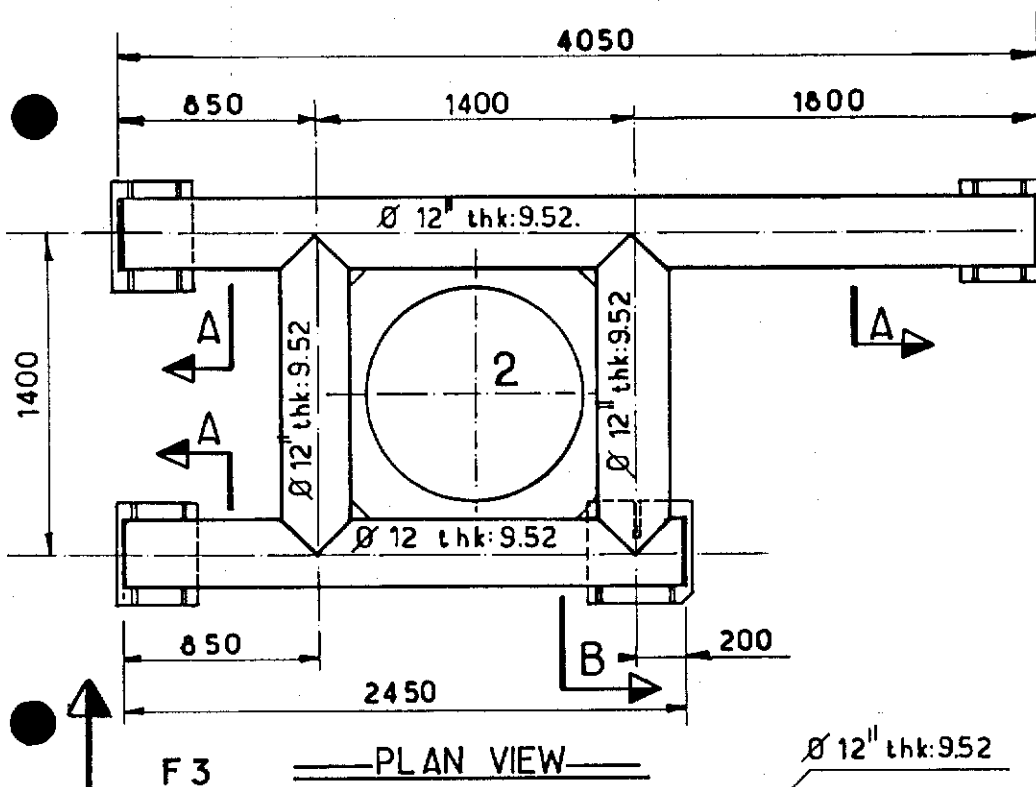

— SECTION A —

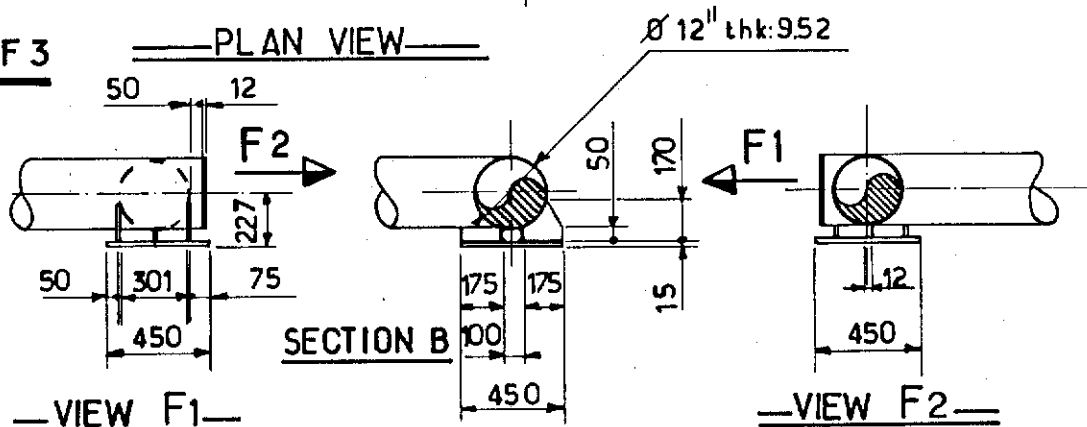

— VIEW F1 —

— VIEW F2 —

NOTES

FOR LOCATION SEE SK FF.91.36.35.1444.
FOR CONDUCTOR SLEEVE SEE SK FF.91.36.35.1491.




						elf aquitaine norge a/s p.o.box 168 4001 Stavanger	 elf	Job no.	Installation CDP 1	System UNDERWATER	
1	12.83	UP DATED	BVH	JLC	Scale 1:33			CONDUCTOR GUIDE N°2 CELL D SECONDARY FRAME LEVEL D			
Rev.	Date	DESCRIPTION	by	app.	Dwgr. no.			FF 91.36.35.14 47.		Rev. 1	Sheet /
Contractor JVD 1029_40_117.							FRIGG FIELD				

CDP 1 AS BUILT DRAWINGS


REFERENCE DRAWING LIST FOR:

[illegible][illegible]


					elf aquitaine norge a/s p.o.box 168 4001 Stavanger	 elf	Job no.	Installation CDP 1	System UNDERWATER		
							Scale				
Rev.	Date	DESCRIPTION	by	app.	Contractor	FRIGG FIELD	Dwgr. no.	FF — — 1447		Rev.	Sheet /

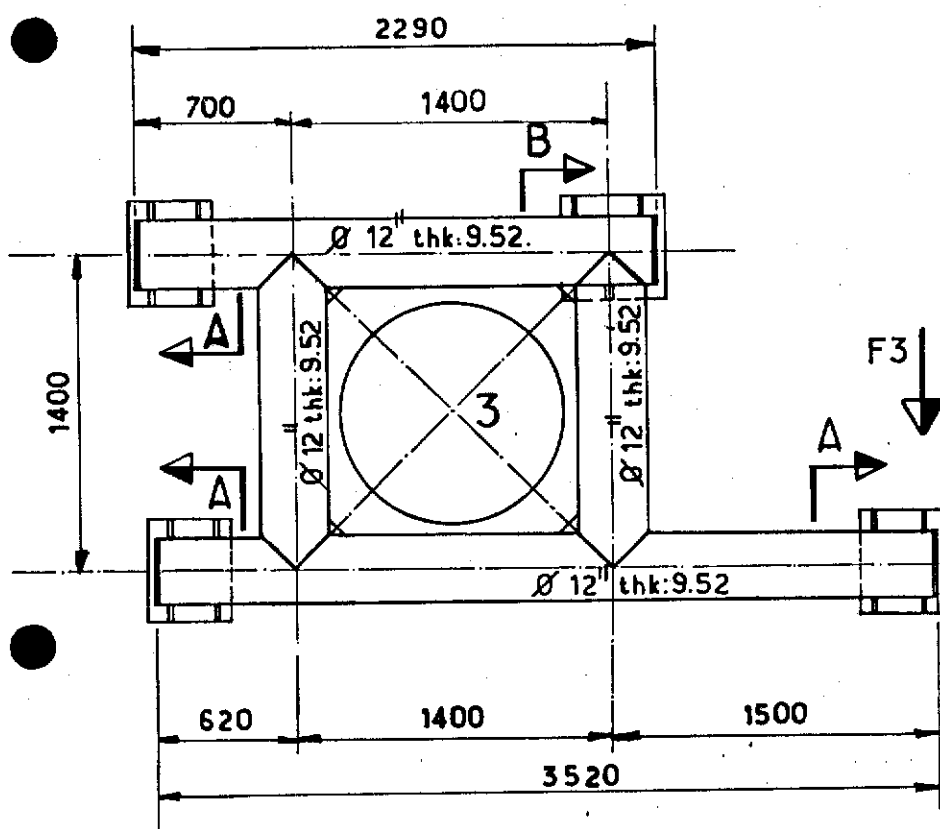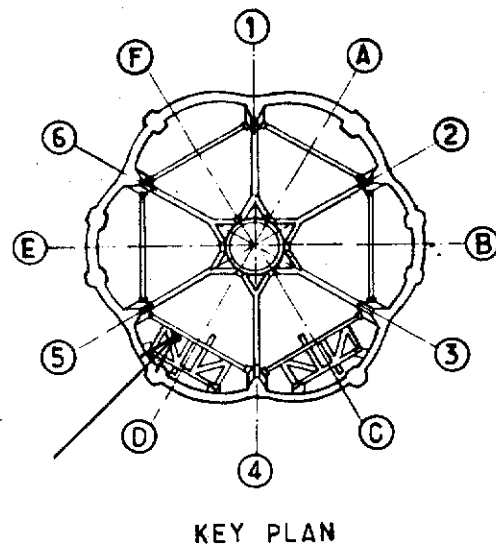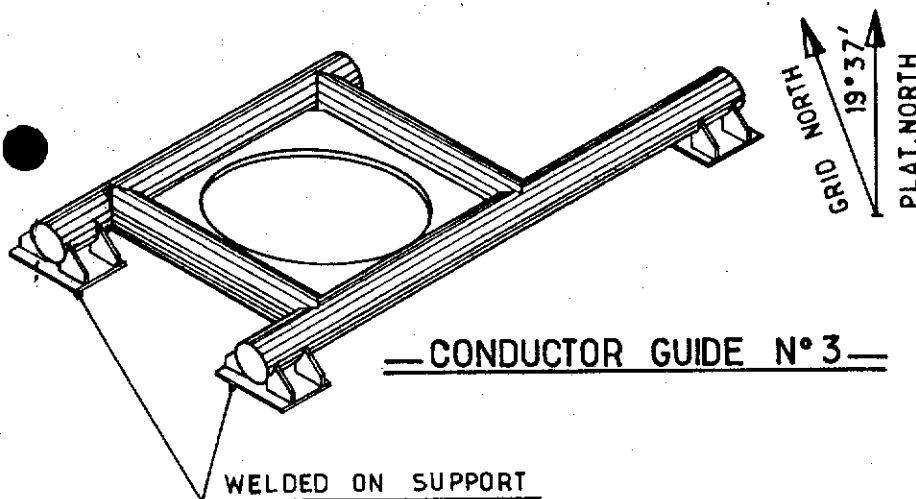

—SECTION A—

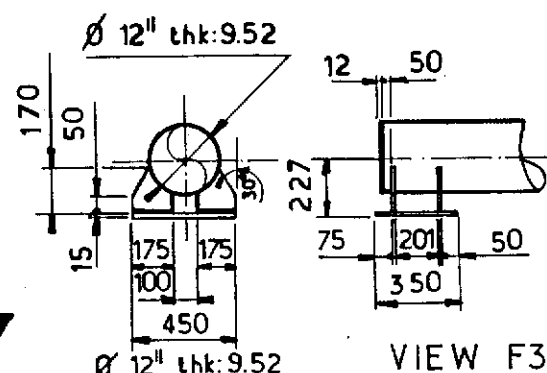

—SECTION B—

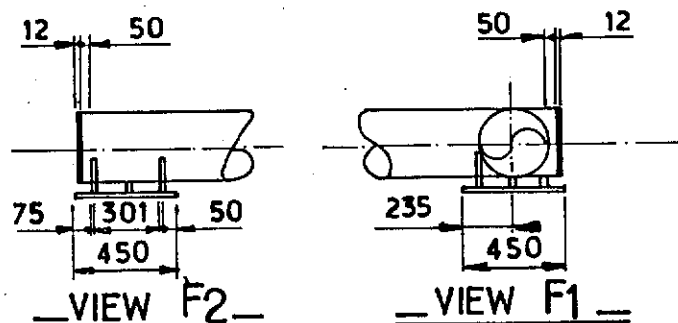

NOTES

FOR LOCATION SEE SK FF. 91.36.35. 1444
FOR CONDUCTOR SLEEVE SEE SK FF. 91.36.35.1491.

						 elf	Job no.	Installation CDP 1	System UNDERWATER	
1	1283	UP DATED	b.v.h	JLC			Scale 1:33	CONDUCTOR GUIDE N°3 CELL D SECONDARY FRAME LEVEL D		
Rev.	Date	DESCRIPTION	by	app.			Dwgr. no.		Rev.	Sheet
Contractor JVD 1029_40_118.					4001 Stavanger		FRIGG FIELD	FF. 91.36.35.1448	1	/




CDP 1 AS BUILT DRAWINGS

REFERENCE DRAWING LIST FOR:


[illegible][illegible]

					elf aquitaine norge a/s p.o.box 168 4001 Stavanger	 elf	Job no.	Installation CDP 1	System UNDERWATER		
							Scale				
Rev.	Date	DESCRIPTION	by	app.			Dwgr. no.	FF 1448		Rev	Sheet /
Contractor											


— CONDUCTOR GUIDE N°4 —

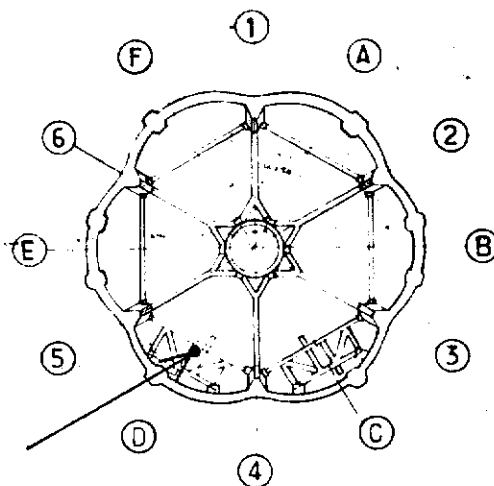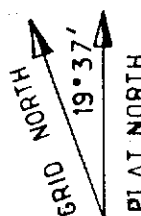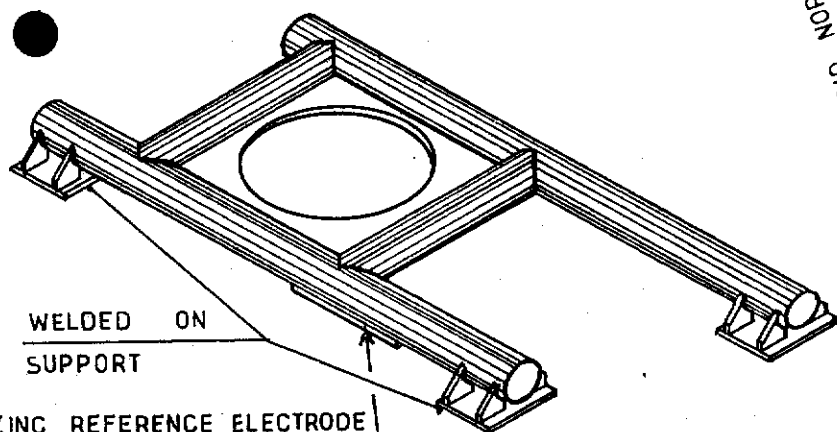


KEY PLAN

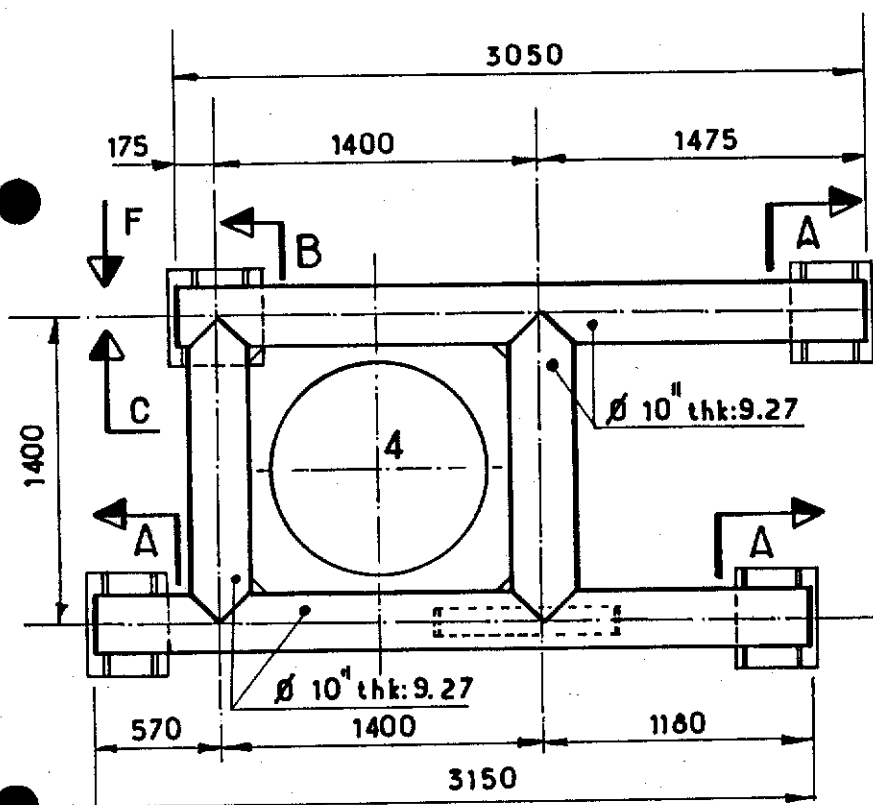


— PLAN VIEW —

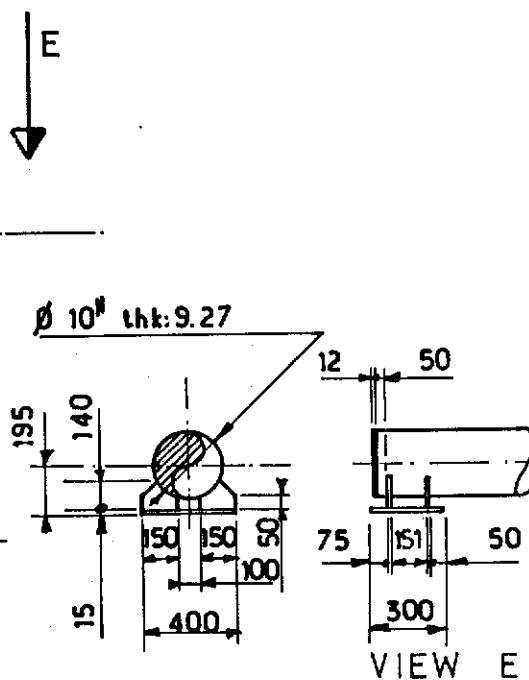


— SECTION A —

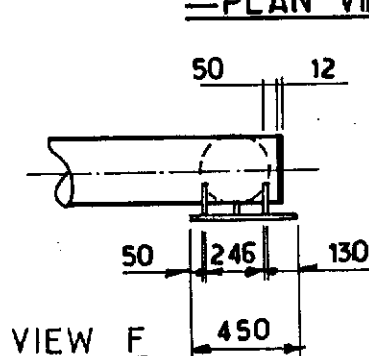

VIEW F

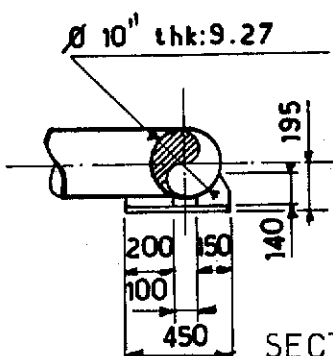

SECTION B

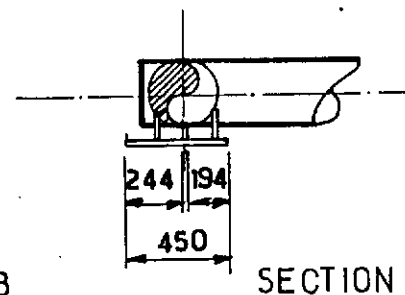

SECTION C

NOTES

FOR LOCATION SEE SK FF.91.36.35.1444
FOR CONDUCTOR SLEEVE SEE SK FF.91.36.35.1491

FOR ZINC REFERENCE ELECTRODE SEE
SK FF 91-36-35-1588

							Job no.	Installation CDP 1	System UNDERWATER
1	12.83	UP DATED	BV.H	L.C			Scale 1:33	CONDUCTOR GUIDE N°4 CELL D SECONDARY FRAME LEVEL D	
Rev.	Date	DESCRIPTION	by	app.			Dwgr. no.	FF. 91. 36. 35. 1449.	1
Contractor JVD 1029_40_119.							FRIGG FIELD		


CDP 1 AS BUILT DRAWINGS

REFERENCE DRAWING LIST FOR:

[illegible][illegible]


	Job no.	Installation	System	
	Scale	CDP 1	UNDERWATER	
	Dwgr. no.	Rev		Sheet
	FF	1449		/

WELDED ON
SUPPORT

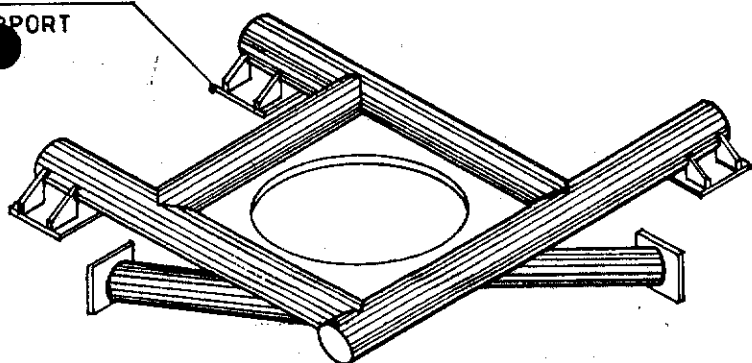


— CONDUCTOR GUIDE N°5 —


GRID NORTH
19°37'
PLAT NORTH

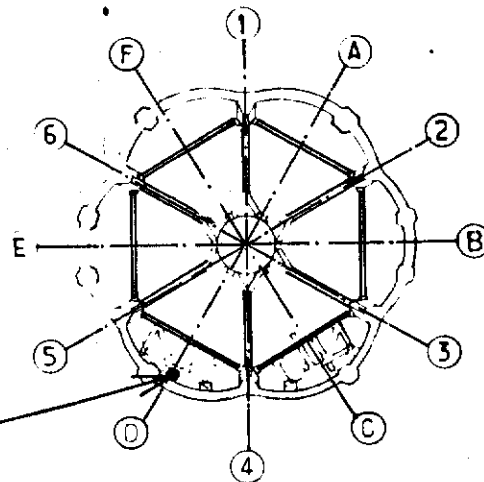

KEY PLAN

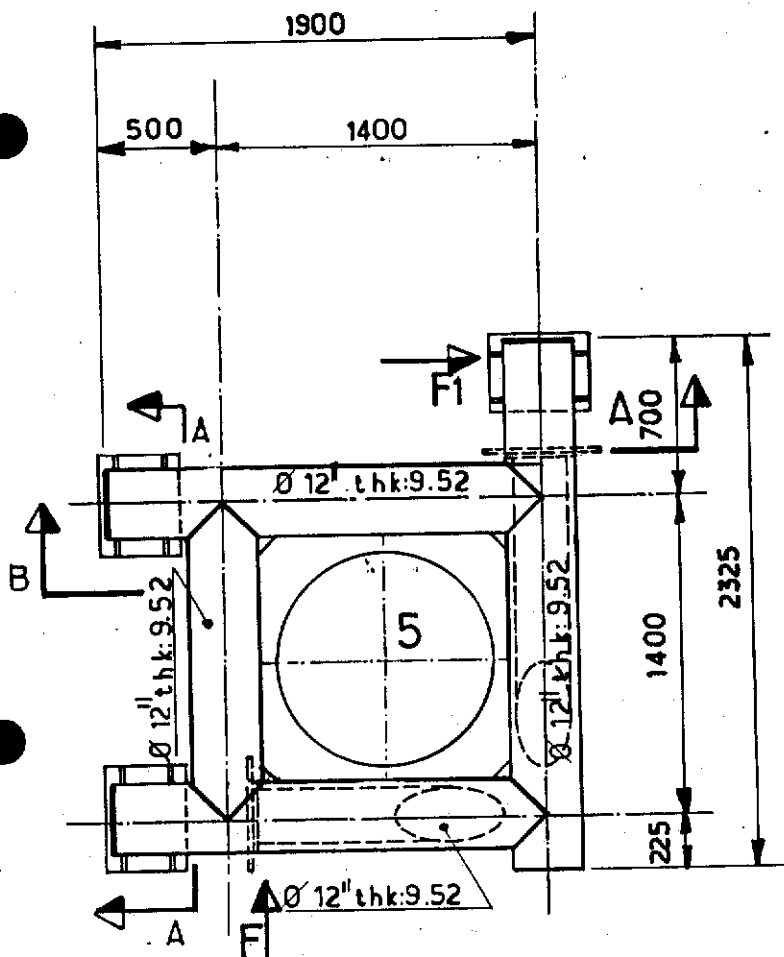

— PLAN VIEW —

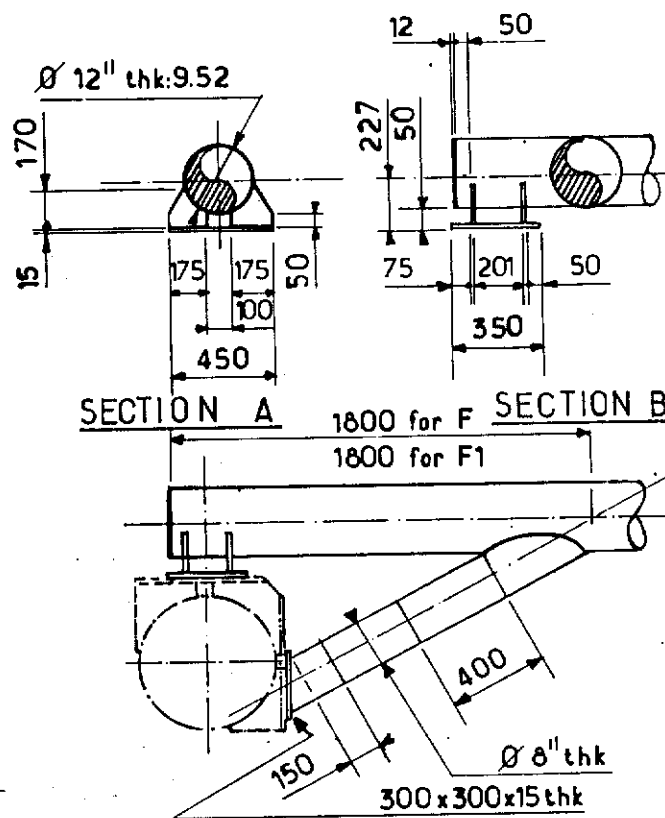

— VIEW F AND F1 —

NOTES

FOR LOCATION SEE SK FF. 91.36.35.1444
FOR CONDUCTOR SLEEVE SEE SK FF. 91.36.35.1491

					elf aquitaine norge a/s p.o. box 168 4001 Stavanger	 elf	Job no.	Installation CDP 1	System UNDERWATER
1	12.83	UP DATED	BVH	LLC			Scale 1:33	CONDUCTOR GUIDE N°5 CELL D SECONDARY FRAME LEVEL D	
Rev.	Date	DESCRIPTION	by	app.		Dwgr. no	FF_91_36_35_1450	Rev. 1	Sheet /
Contractor JVD 1029_40_120.					FRIGG FIELD				

CDP 1 AS BUILT DRAWINGS

REFERENCE DRAWING LIST FOR:

[illegible][illegible]


				elf aquitaine norge a/s p.o.box 168 4001 Stavanger		 elf		Job no.		Installation CDP 1		System UNDERWATER	
								Scale					
Rev.		Date		DESCRIPTION		by		app.		Dwgr. no.		Rev.	
										FF — — 1450		Sheet /	
Contractor								FRIGG FIELD					

ZINC ANODE


WELDED ON
SUPPORT

— CONDUCTOR GUIDE N°6 —

GRID NORTH
19°37'
PLAT NORTH

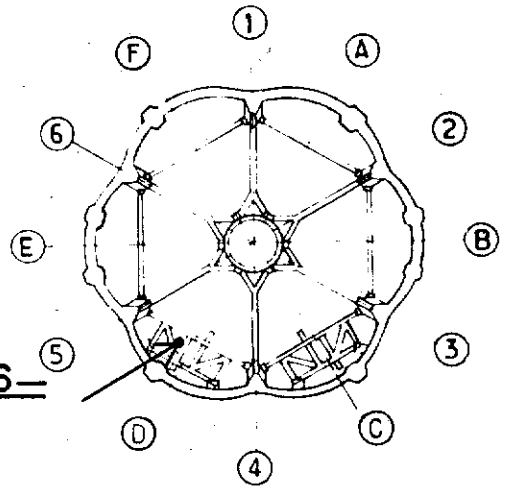

KEY PLAN

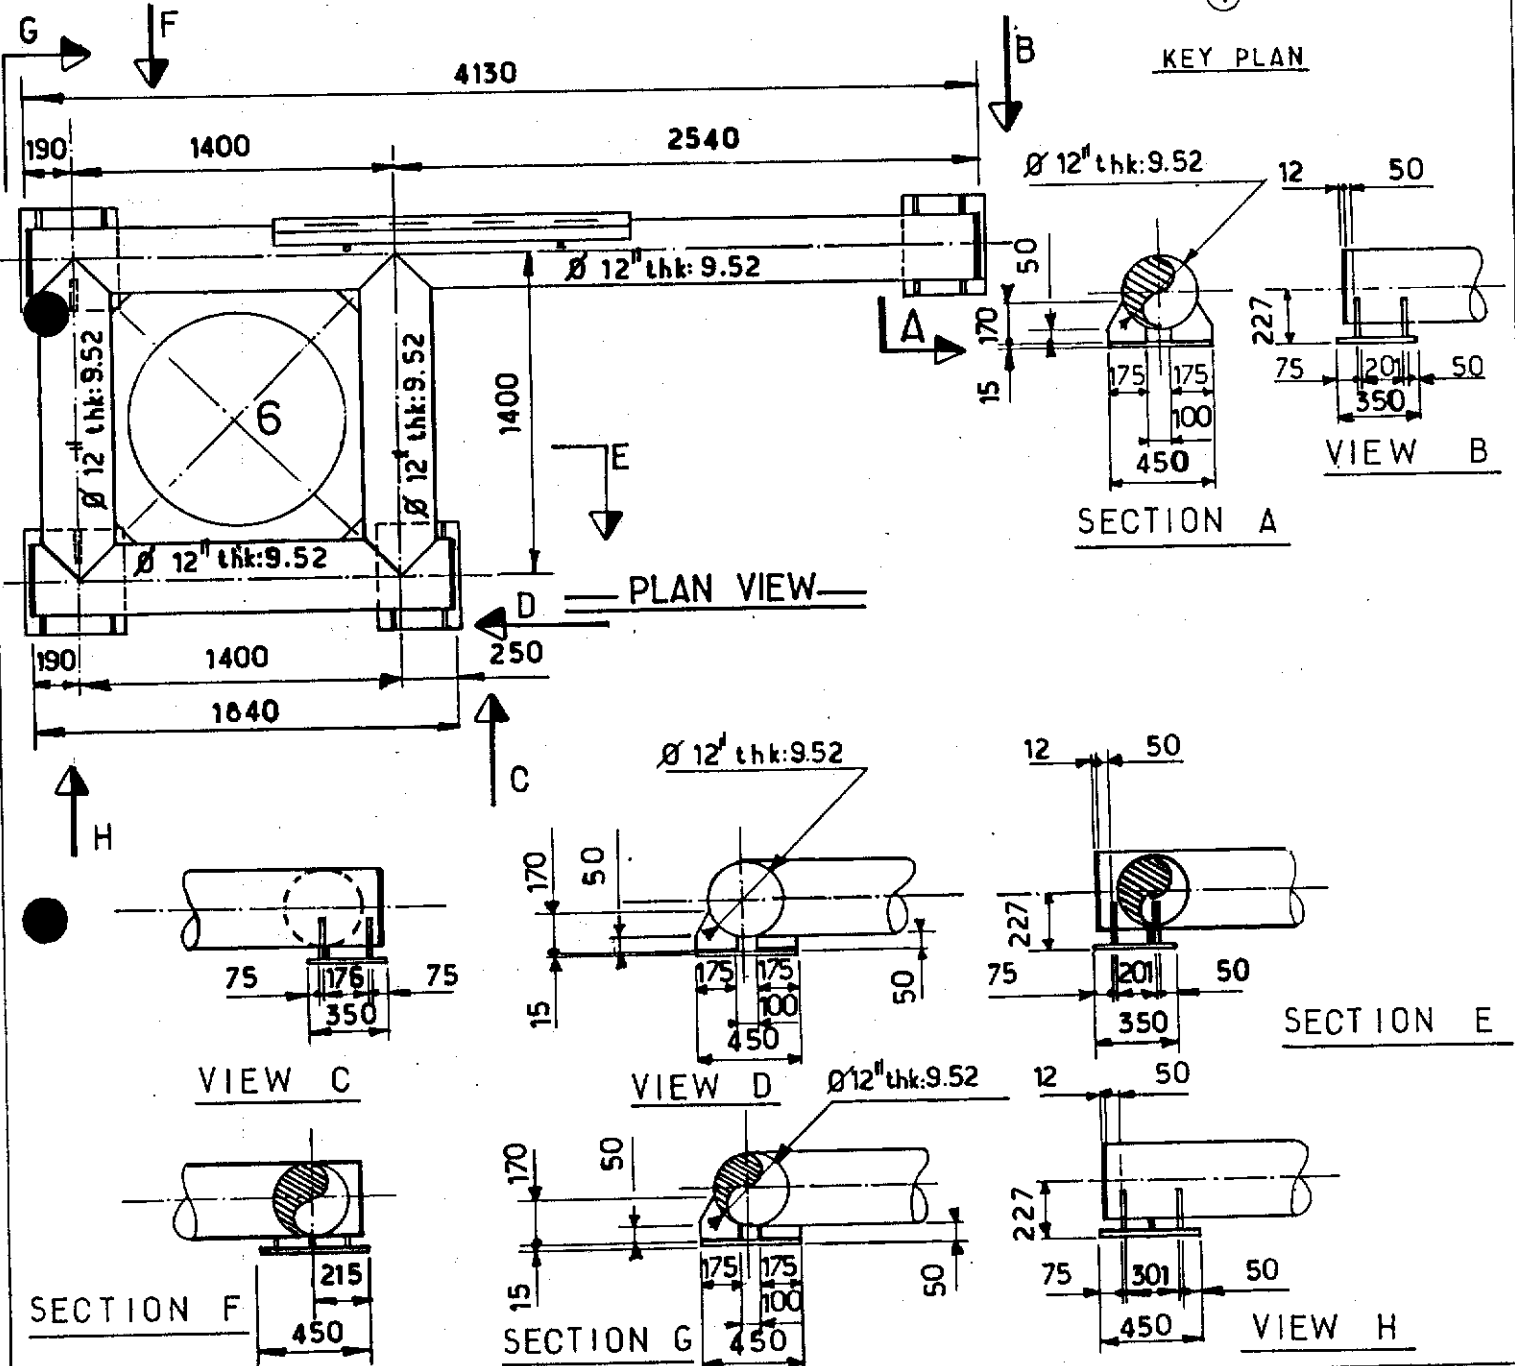

NOTES

FOR LOCATION SEE SK FF. 91. 36. 35. 1444
FOR CONDUCTOR SLEEVE SEE SK FF. 91. 36. 35. 1491

FOR ZINC ANODE SEE SK. FF 91-36-35-1587



FOR CONDUCTOR SLEEVE SEE SK PROJECT DOCUMENTS																																		
<table><tr><td> </td><td> </td><td> </td><td> </td><td> </td></tr><tr><td>1</td><td>1283</td><td>UP DATED</td><td>BY/H</td><td>FLC</td></tr><tr><td>Rev.</td><td>Date</td><td>DESCRIPTION</td><td>by</td><td>app.</td></tr><tr><td colspan="5">Contractor JVD 1029_40_121.</td></tr></table>										1	1283	UP DATED	BY/H	FLC	Rev.	Date	DESCRIPTION	by	app.	Contractor JVD 1029_40_121.					elf aquitaine norge a/s p.o.box 168 4001 Stavanger		 elf FRIGG FIELD		Job no. Scale 1:33 Dwgr. no. FF 91_36_35_1451.		Installation CDP 1		System UNDERWATER CONDUCTOR GUIDE N°6 CELL D SECONDARY FRAME LEVEL D	
1	1283	UP DATED	BY/H	FLC																														
Rev.	Date	DESCRIPTION	by	app.																														
Contractor JVD 1029_40_121.																																		
									Rev. 1		Sheet /																							

CDP 1 AS BUILT DRAWINGS


REFERENCE DRAWING LIST FOR:

[illegible][illegible]


					elf	Job no.	Installation CDP 1	System UNDERWATER		
						Scale				
Rev.	Date	DESCRIPTION	by	app.	p.o.box 168	elf	Dwgr. no.		Rev.	Sheet
Contractor					4001 Stavanger		FRIGG FIELD	FF	1451	

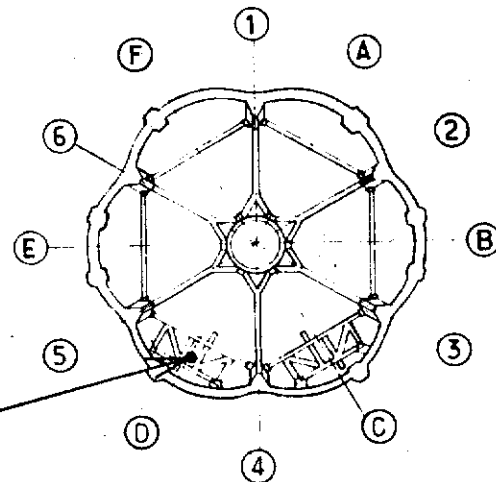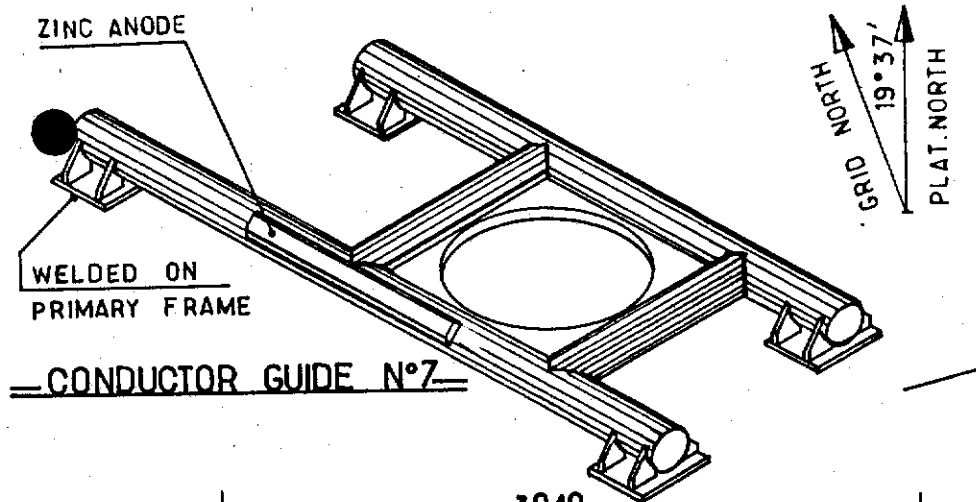


KEY PLAN

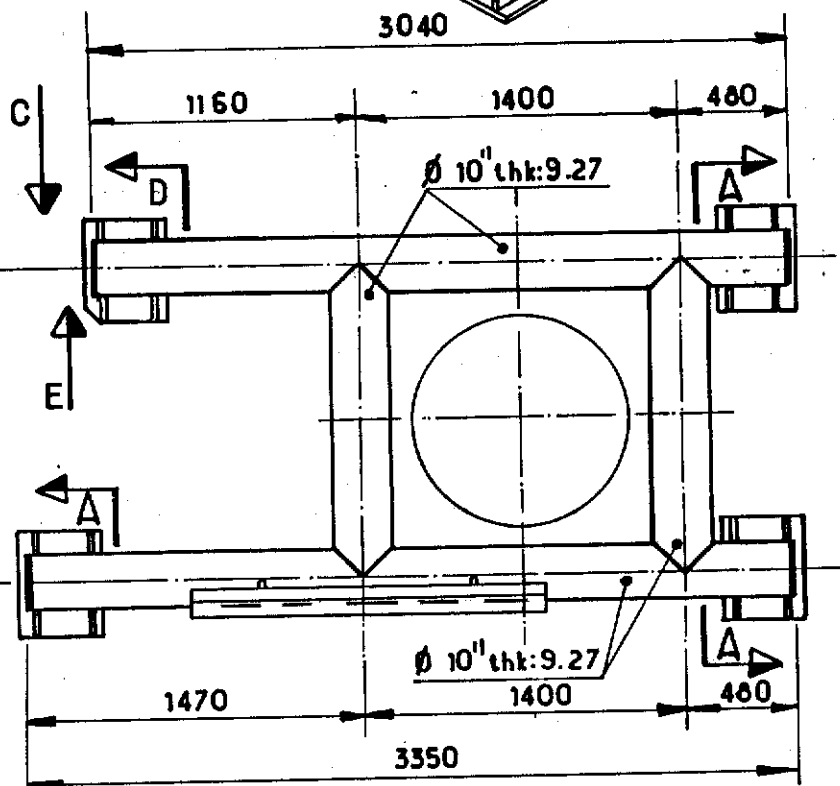


PLAN VIEW

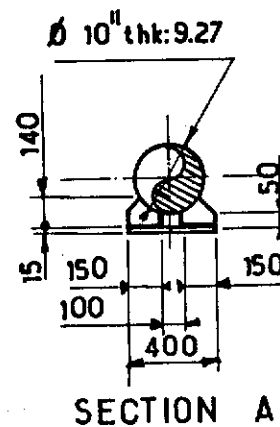


SECTION A

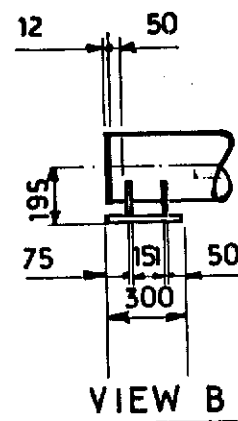


VIEW B

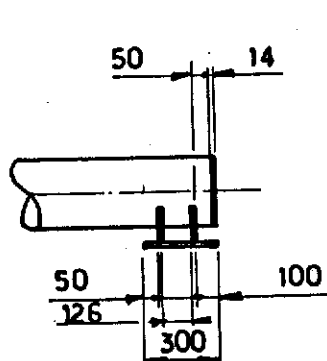

VIEW C

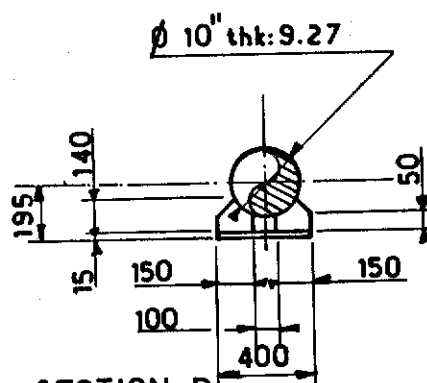

SECTION D

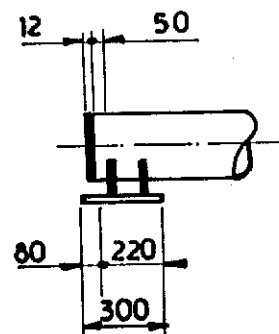

VIEW E

NOTES

FOR LOCATION SEE SK FF.91.36.35 - 1444 FOR ZINC ANODE SEE SK.FF.91.36.35-1587
FOR CONDUCTOR SLEEVE SEE SK FF. 91-36-35-1491

					 elf	Job no.	Installation CDP 1	System UNDERWATER			
1	12.83	UP DATED	BVH	JLC		Scale 1:33	CONDUCTOR GUIDE N°7 CELL D SECONDARY FRAME LEVEL D				
Rev.	Date	DESCRIPTION	by	app.		Dwgr. no.			Rev.	Sheet	
Contractor JVD 1029_40_122					4001 Stavanger	FRIGG FIELD		FF_91_36_35_1452		1	/

CDP 1 AS BUILT DRAWINGS

REFERENCE DRAWING LIST FOR:

[illegible][illegible]


						elf aquitaine norge a/s p.o.box 168 4001 Stavanger	 elf	Job no.	Installation CDP 1	System UNDERWATER
								Scale		
Rev.	Date	DESCRIPTION	by	app.		Dwgr. no. FF — — 1452	Rev	Sheet /		
Contractor						FRIGG FIELD				

WELDED ON SUPPORT


ZINC REFERENCE
ELECTRODE

— CONDUCTOR GUIDE N°8 —

GRID NORTH
19°37'
PLAT. NORTH

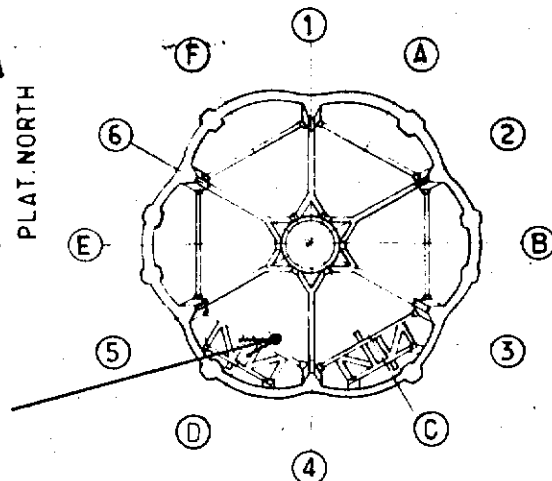


KEY PLAN

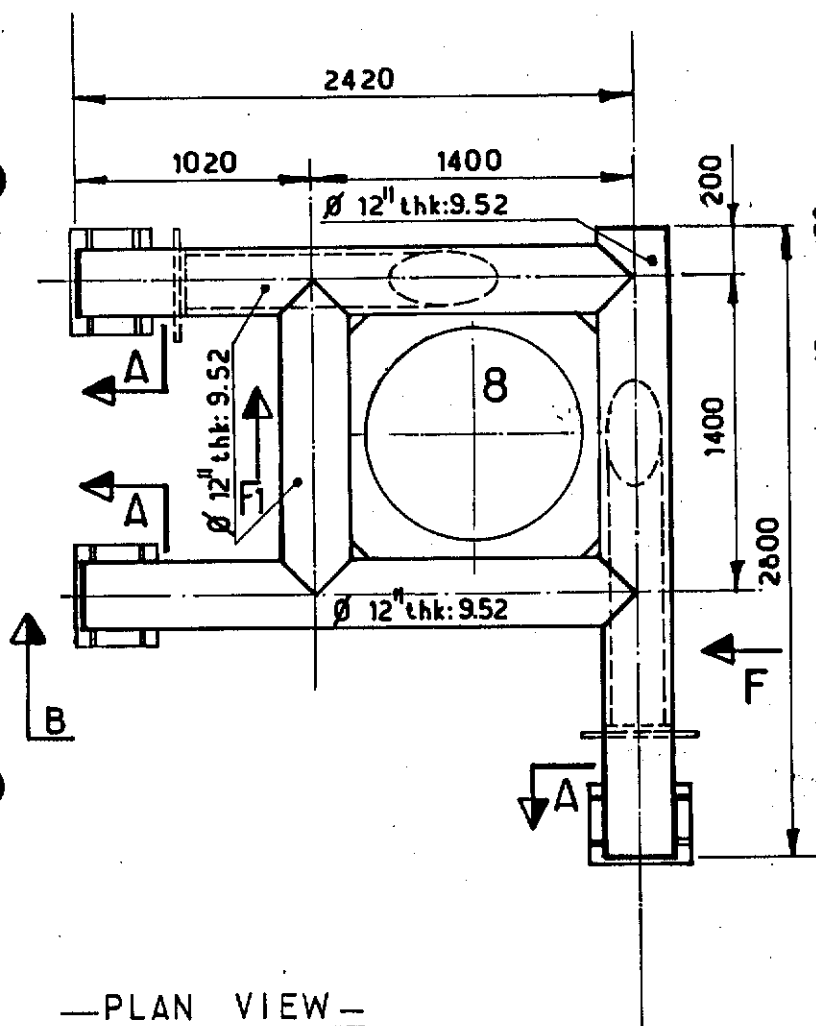

— PLAN VIEW —

SECTION A

VIEW B

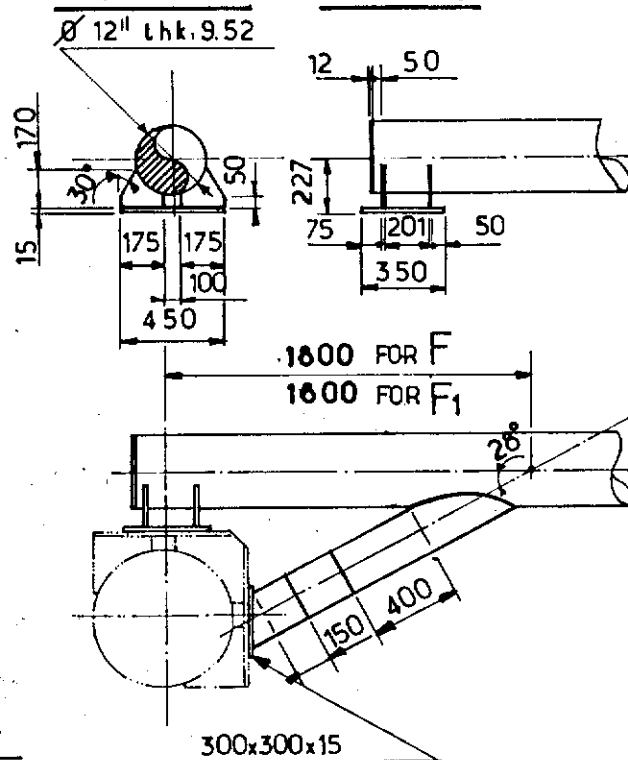

— VIEW F AND F1 —

NOTES

FOR LOCATION SEE SK. FF. 91.36.35.1444
FOR CONDUCTOR SLEEVE SEE SK. FF. 91.36.35.1491.



					elf aquitaine norge a/s p.o.box 168 4001 Stavanger	 elf	Job no.	Installation CDP 1	System UNDERWATER		
1	12.83	UP DATED	BVH	JLC			Scale 1:33	CONDUCTOR GUIDE N°8 CELL D SECONDARY FRAME LEVEL D			
Rev.	Date	DESCRIPTION	by	app.			Dwgr. no.	FF. 91.36.35.1453.		Rev. 1	Sheet /
Contractor JVD 1029_40.123											

CDP 1 AS BUILT DRAWINGS

REFERENCE DRAWING LIST FOR:

[illegible][illegible]

					 elf		Job no.		Installation CDP 1		System UNDERWATER	
Scale												
Rev.	Date	DESCRIPTION	by	app.	 elf		Dwgr. no.		Rev.	Sheet		
Contractor							p.o.box 168 4001 Stavanger				FF _____ 1453	
					FRIGG FIELD							

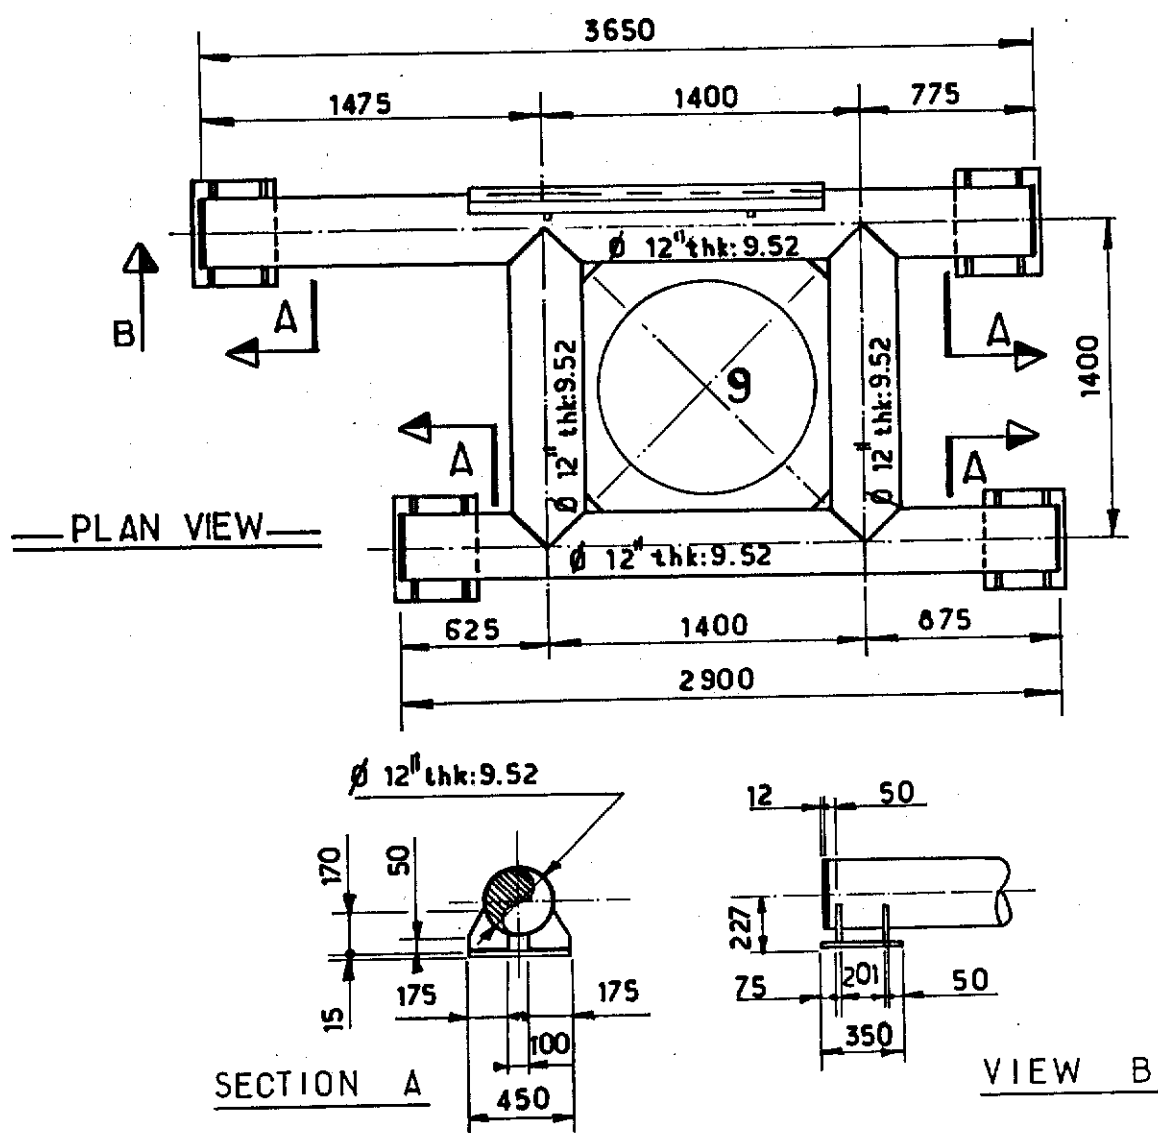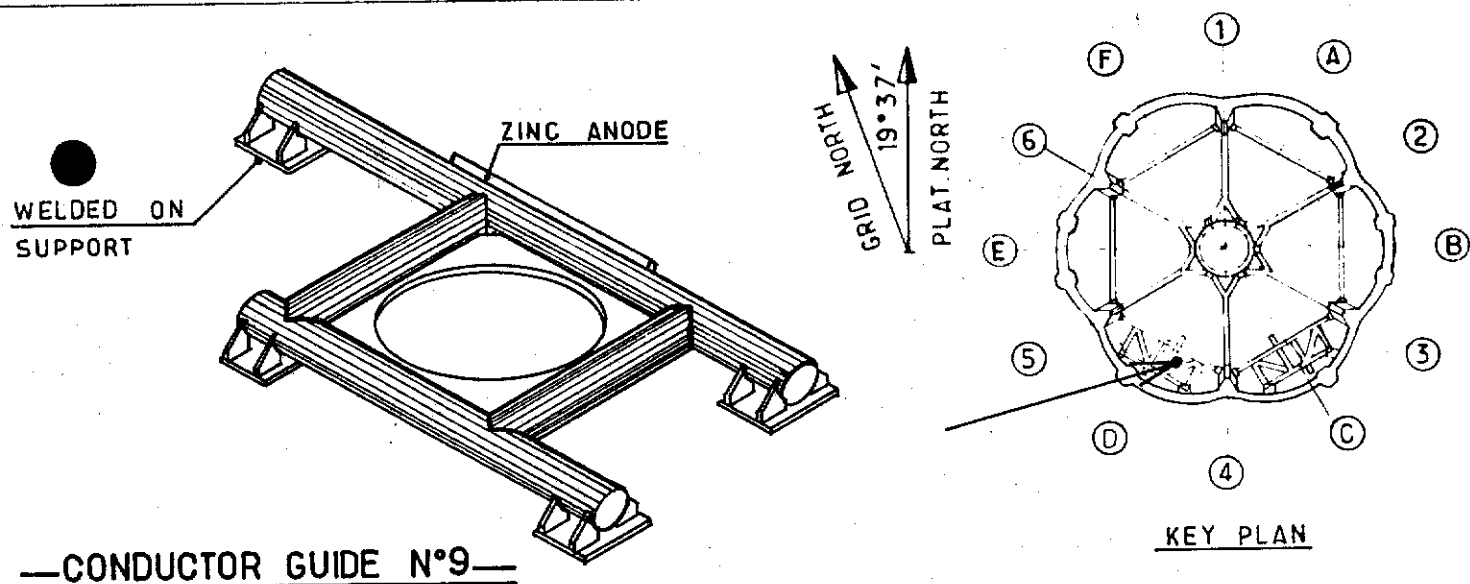

NOTES

FOR LOCATION SEE SK FF.91.36.35.1444 .
 FOR CONDUCTOR SLEEVE SEE SK FF.91.36.35.1491 .

FOR ZINC ANODE SEE SK. FF 91-36-35-1587

FOR CONDUCTOR SLEEVE SEE SK FF.91.36.35.1454.


				elf aquitaine norge a/s p.o.box 168 4001 Stavanger	 elf FRIGG FIELD	Job no.	Installation CDP 1	System UNDERWATER	
1	12.83	UP DATED	BVH			Scale 1:33	CONDUCTOR GUIDE N°9 CELL D SECONDARY FRAME LEVEL D		
Rev.	Date	DESCRIPTION	by			app.	Dwgr. no.	FF_91_36_35_1454_	
Contractor JVD 1029_40_124.									

CDP 1 AS BUILT DRAWINGS



REFERENCE DRAWING LIST FOR:

[illegible][illegible]


<table><tr><td>●</td><td></td><td></td><td></td><td></td></tr><tr><td></td><td></td><td></td><td></td><td></td></tr><tr><td></td><td></td><td></td><td></td><td></td></tr><tr><td>Rev.</td><td>Date</td><td>DESCRIPTION</td><td>by</td><td>app.</td></tr></table>					●															Rev.	Date	DESCRIPTION	by	app.	elf aquitaine norge a/s p.o.box 168 4001 Stavanger	 elf	Job no.	Installation CDP 1	System UNDERWATER
●																													
Rev.	Date	DESCRIPTION	by	app.																									
Contractor					FRIGG FIELD	Dwgr. no. FF — — 1454	Rev.	Sheet /																					

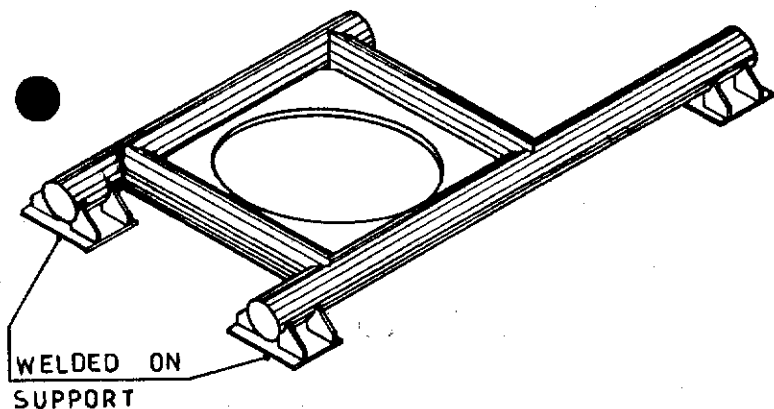

— CONDUCTOR GUIDE N°10 —

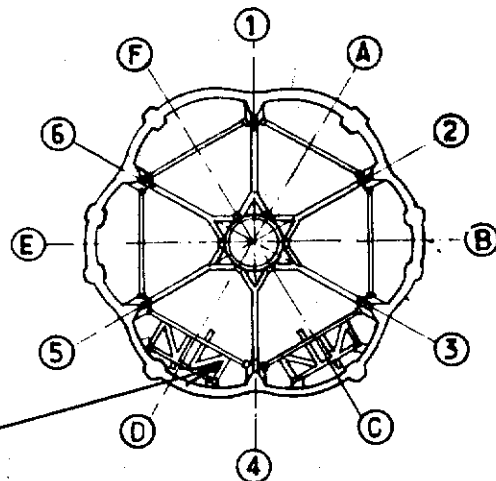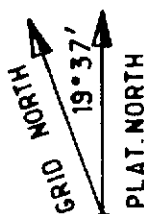


KEY PLAN

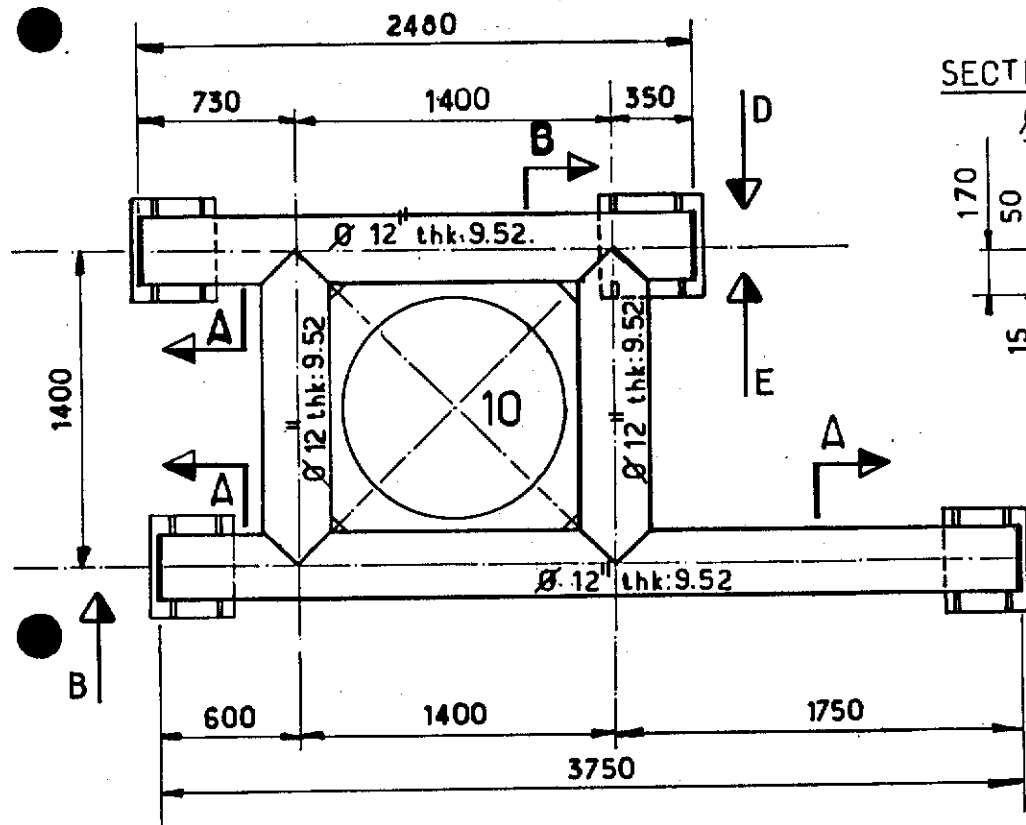


— PLAN VIEW —



SECTION A

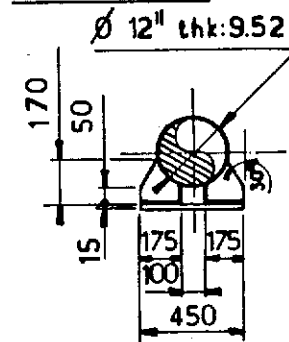


VIEW B

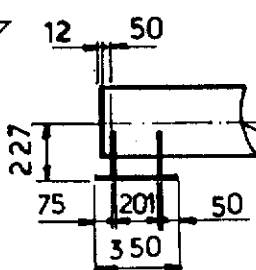

SECTION C

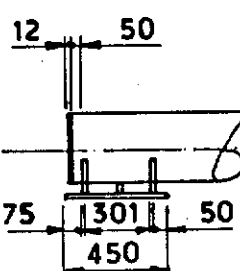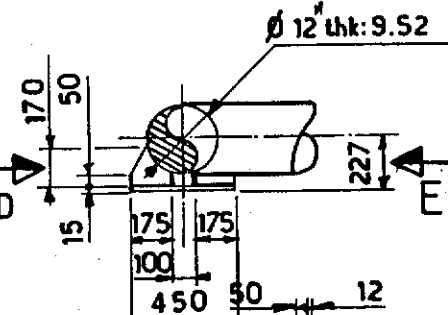

— VIEW D —

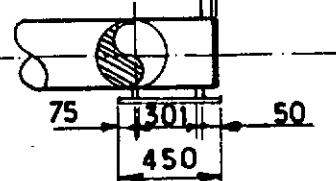

SECTION E

NOTES

FOR LOCATION SEE SK FF.91.36.35.1444.
FOR CONDUCTOR SLEEVE SEE SK FF.91.36.35.1491.

				elf aquitaine norge a/s p.o.box 168 4001 Stavanger				Job no.		Installation CDP 1		System UNDERWATER			
1	12.83	UP DATED	BVH	JLC			Scale 1:33		CONDUCTOR GUIDE N° 10 CELL D SECONDARY FRAME LEVEL D						
Rev. Date				DESCRIPTION		by		app.		Dwgr. no.		Rev.		Sheet	
Contractor				JVD 1029-40-125.		4001 Stavanger		FRIGO FIELD		FF.91.36.35.1455.		1		/	




CDP 1 AS BUILT DRAWINGS

●REFERENCE DRAWING LIST FOR:


[illegible][illegible]

					elf aquitaine norge a/s p.o.box 168 4001 Stavanger	 elf	Job no.	Installation	System	
							Scale	CDP 1	UNDERWATER	
Rev.	Date	DESCRIPTION	by	app.			Dwgr. no.		Rev.	Sheet
Contractor					FRIGG FIELD	FF	1455			/


— CONDUCTOR GUIDE N°11 —

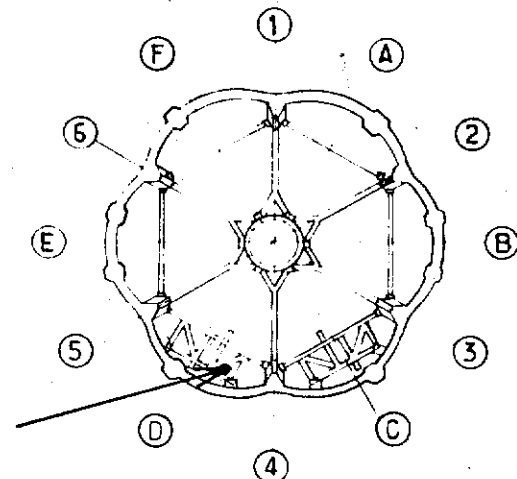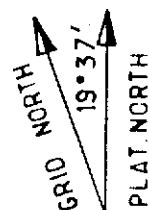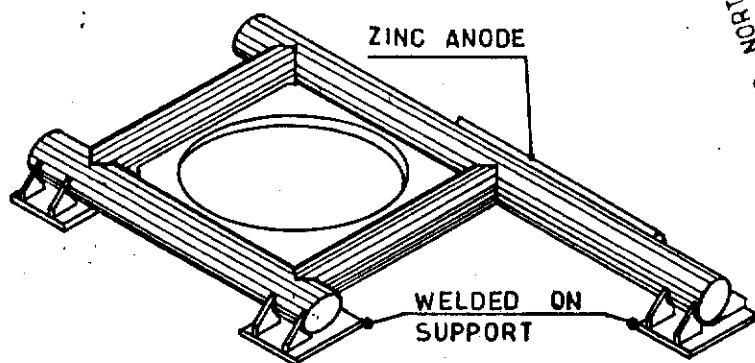


KEY PLAN

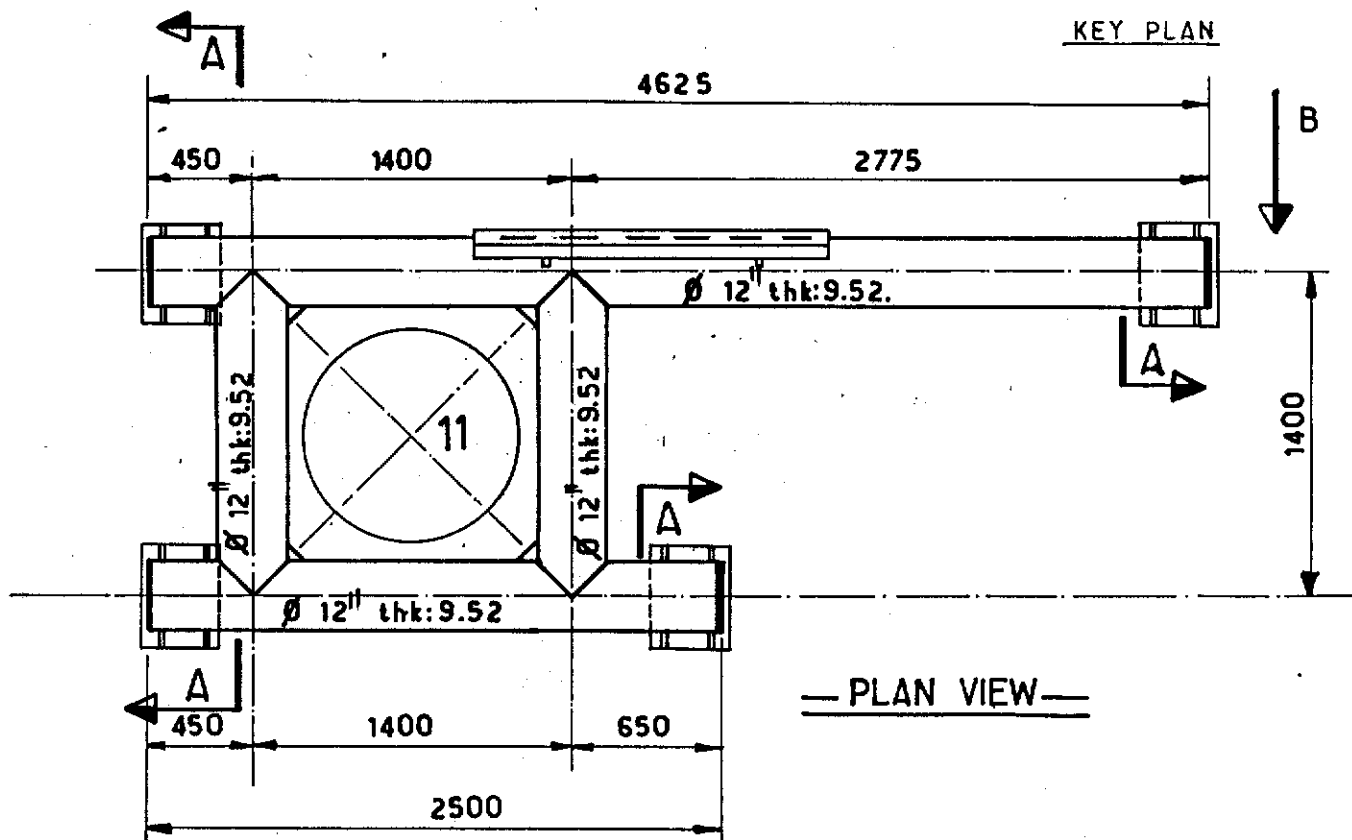

— PLAN VIEW —

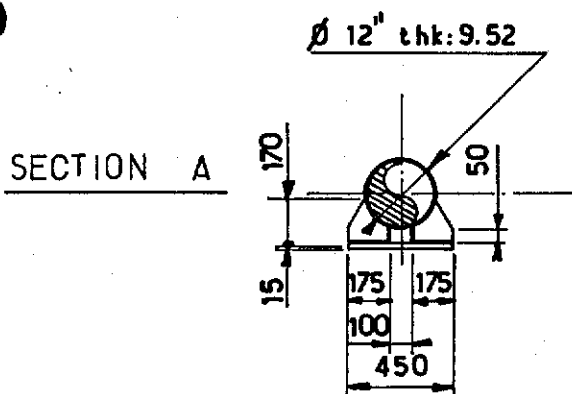

SECTION A

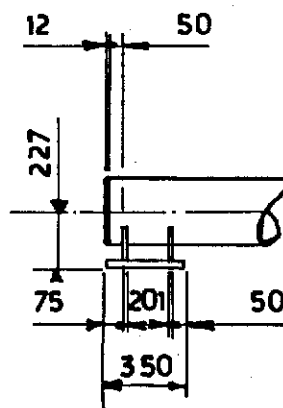

VIEW B

NOTES

FOR LOCATION SEE SK FF-91.36.35-1444

FOR ZINC ANODE SEE SK. FF 91-36-35-1587

FOR CONDUCTOR SLEEVE SEE SK FF-91-36-35-1491.

elf
aquitaine
norge a/s
p.o.box 168



FRIGG FIELD

Job no.

Installation
CDP 1

System
UNDERWATER

Scale

1:33

CONDUCTOR GUIDE N°11 CELL D
SECONDARY FRAME LEVEL D

Dwgr. no.

FF 91 36 35 1456

Rev.

1

Sheet

1

1 12.83 UP DATED B.VH JLC
Rev. Date DESCRIPTION by app.

Contractor JVD 1029_40_126_


4001 Stavanger

CDP 1 AS BUILT DRAWINGS


REFERENCE DRAWING LIST FOR:

[illegible][illegible]


				elf		 elf	Job no.	Installation CDP 1		System UNDERWATER			
				aquitaine			Scale						
				norge a/s		 elf	Dwgr. no.	FF — — 1456				Rev.	Sheet
				p.o.box 168									
Rev.	Date	DESCRIPTION	by	app.	p.o.box 168								
Contractor					4001 Stavanger		FRIGG FIELD						

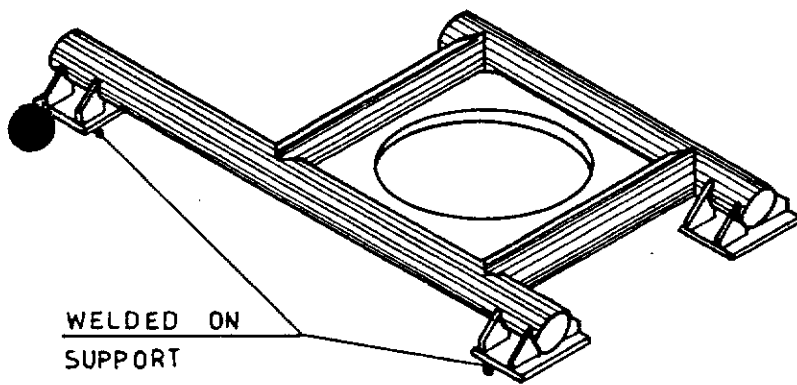


GRD. NORTH
19° 37'
PLAT. NORTH

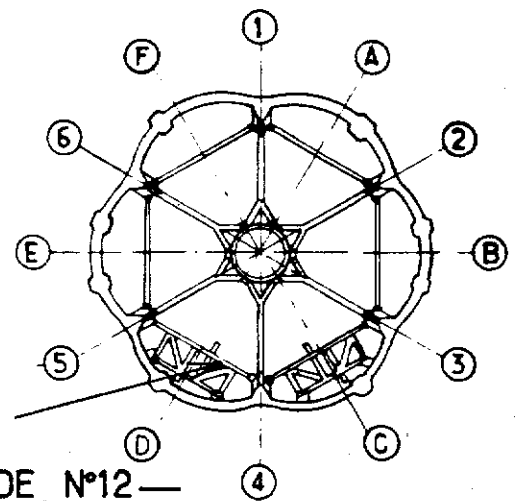



KEY PLAN

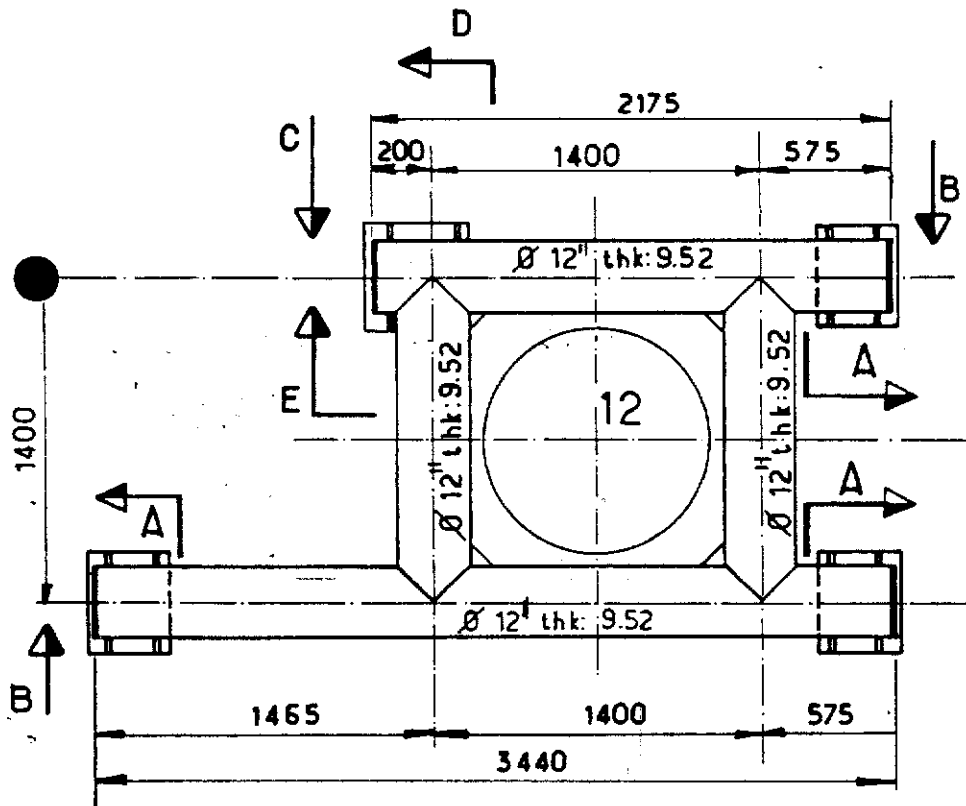

—PLAN VIEW—

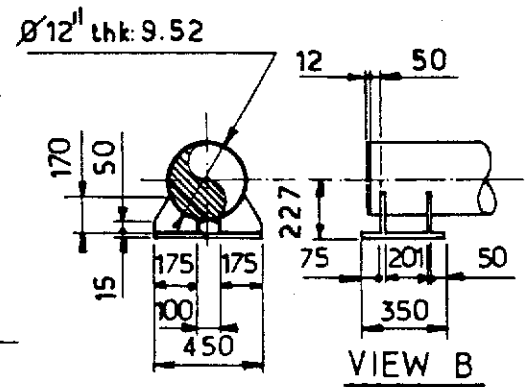

SECTION A

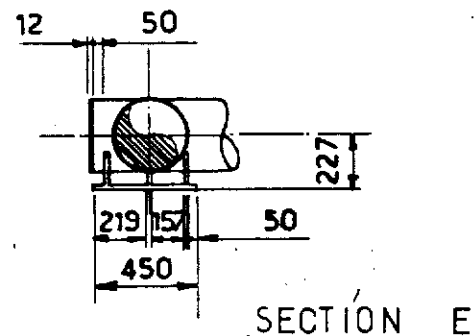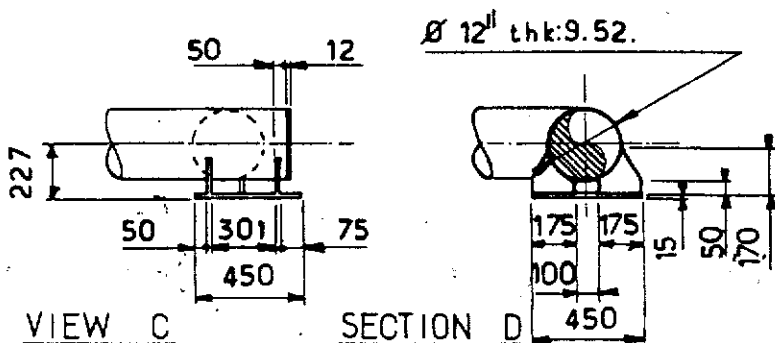

NOTES

FOR LOCATION SEE SK FF. 91.36.35.1422
FOR CONDUCTOR SLEEVE SEE SK FF. 91.36.35.1491.


				elf aquitaine norge a/s p.o. box 168 4001 Stavanger	 elf	Job no.	Installation CDP 1	System UNDERWATER
1	1283	UP DATED	BVH/LLC			Scale 1:33	CONDUCTOR GUIDE N°12 CELL D	
Rev.	Date	DESCRIPTION	by	app.		Dwgr. no.	FF 91.36.35.1457	Rev 1
Contractor JVD 1029_40.127.				FRIGG FIELD				Sheet /

CDP 1 AS BUILT DRAWINGS


● REFERENCE DRAWING LIST FOR:

[illegible][illegible]



						elf aquitaine norge a/s p.o.box 168 4001 Stavanger	 elf	Job no.	Installation CDP 1	System UNDERWATER
								Scale		
Rev.	Date	DESCRIPTION	by	app.				Dwgr. no. FF — — 1457	Rev	Sheet /
Contractor						FRIGG FIELD				

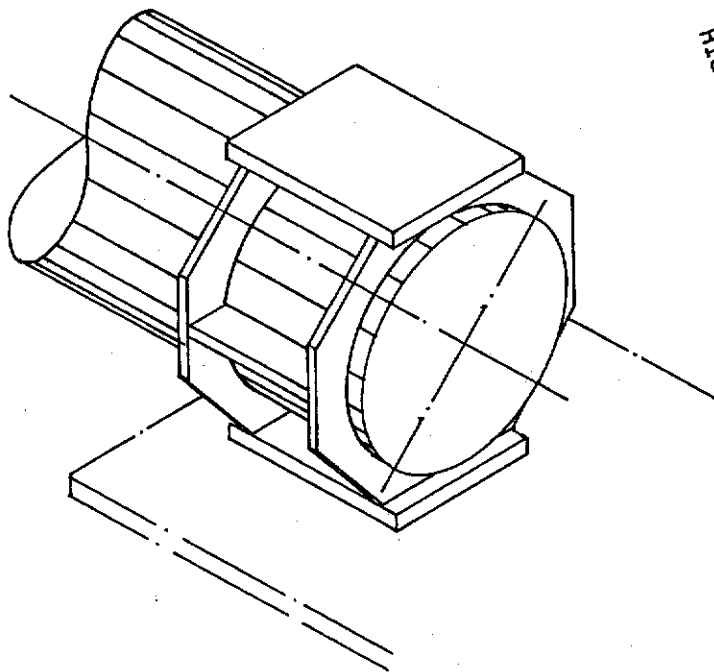

GRID NORTH
19°37'
PLAT. NORTH

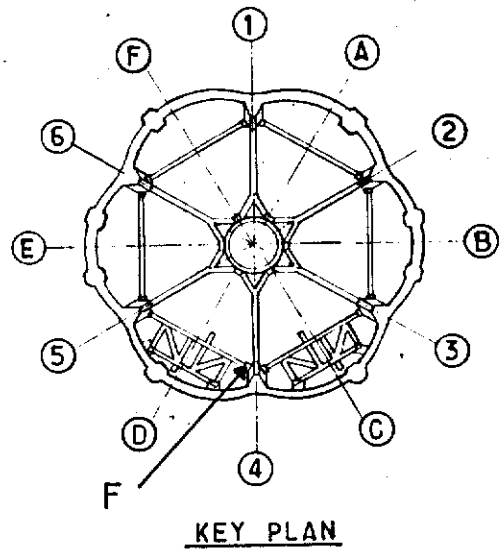

VIEW F

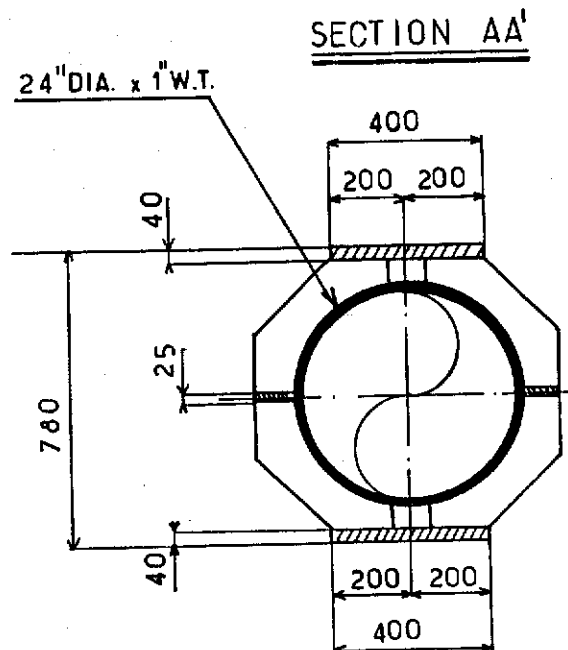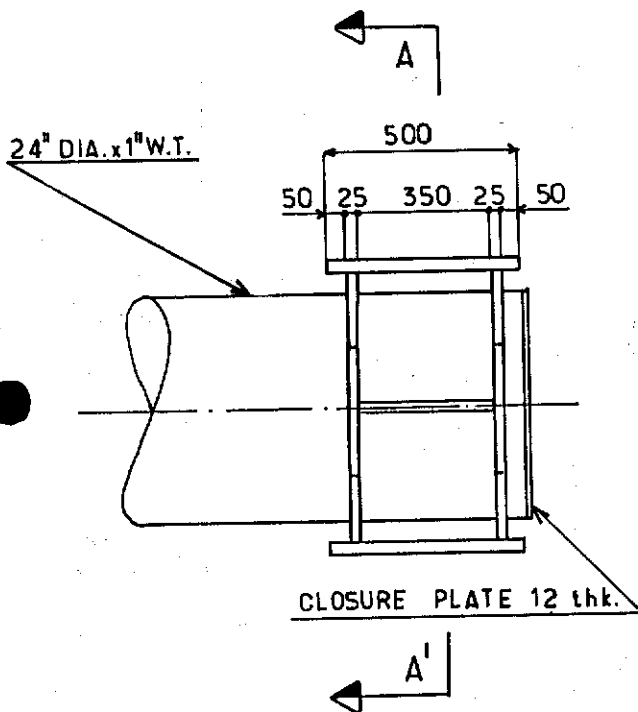

NOTES

FOR LOCATION SEE SK FF_91_36_35_1444
FOR BOX FOR FREE LOCK SEE SK FF_91_36_35_1458


				elf aquitaine norge a/s p.o.box 168 4001 Stavanger	 elf	Job no.	Installation CDP 1	System UNDERWATER
1	1283	UP DATED	BVH JJC			Scale 1:20	FREE LOCK PIPE END DD1 CELL D LEVEL 0	
Rev.	Date	DESCRIPTION	by	app.		Dwgr. no.	FF 91-36-35-1458	Rev 1
Contractor JVD 1029. 40.128.				FRIGG FIELD		Sheet /		

CDP 1 AS BUILT DRAWINGS



REFERENCE DRAWING LIST FOR:

[illegible][illegible]


						elf aquitaine norge a/s p.o.box 168 4001 Stavanger	 elf	Job no.	Installation CDP 1	System UNDERWATER	
								Scale			
Rev.	Date	DESCRIPTION	by	app.				Dwgr. no.		Rev.	Sheet
Contractor					4001 Stavanger	FRIGG FIELD	FF	— — 1458		/	

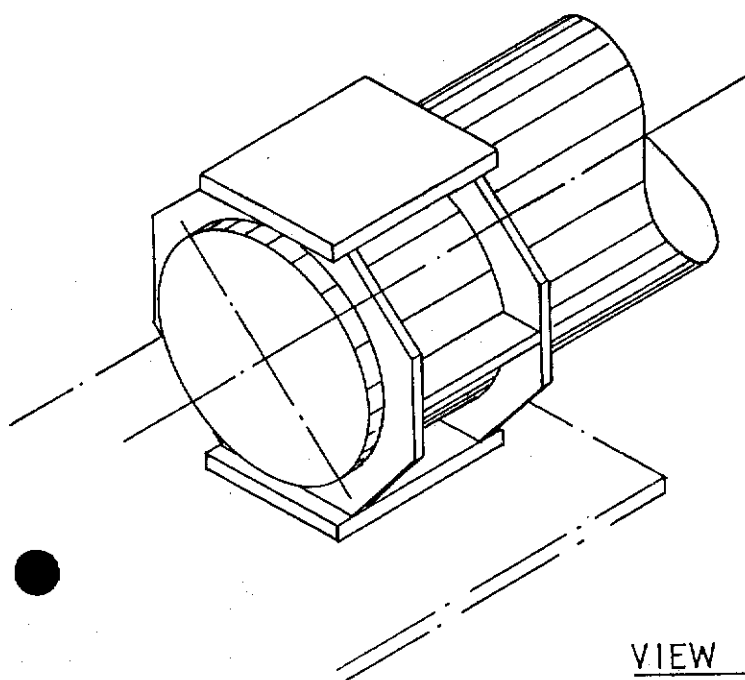

GRID NORTH
19° 37'
PLAT. NORTH

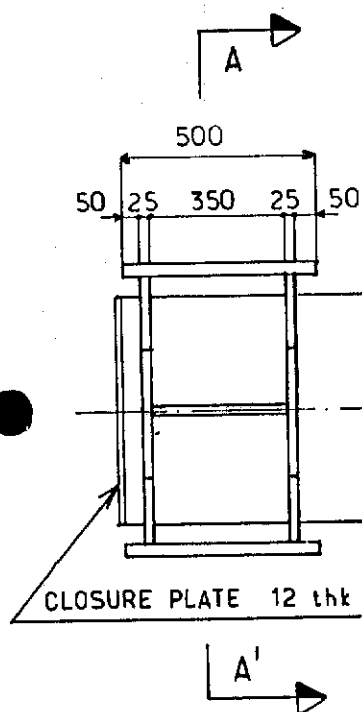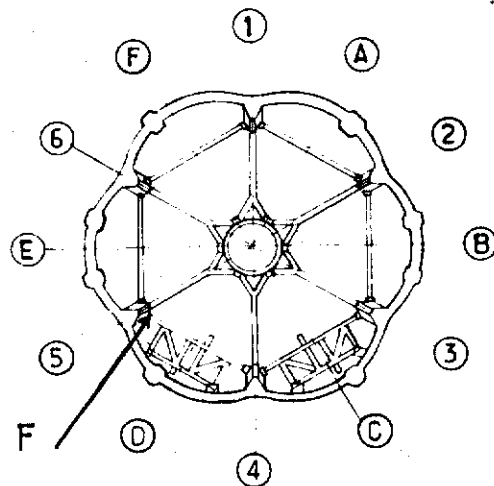

24" DIA. x 1" WT.

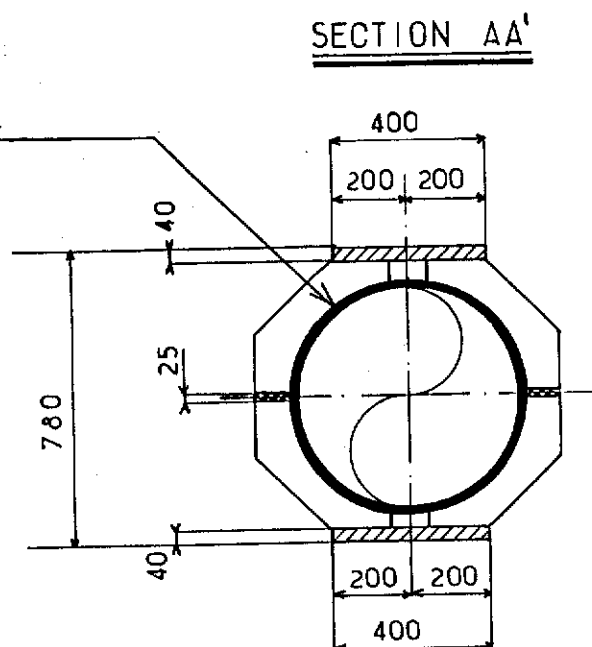

NOTES

FOR LOCATION SEE SK FF_91_36_35_1444
FOR BOX FOR FREE LOCK SEE SK FF_91_36_35_1461.


						elf aquitaine norge a/s p.o.box 168 4001 Stavanger	 elf FRIGG FIELD	Job no.	Installation CDP 1	System UNDERWATER	
1	12.83	UP DATED	BVH	12.83	Scale 1:20			FREE LOCK PIPE END		DD 4	
Rev.	Date	DESCRIPTION	by	app.				CELL D		LEVEL D	
Contractor JVD 1029_40.12.9.								Dwgr. no FF 91-36-35-1459		Doc. 1	Sheet /

CDP 1 AS BUILT DRAWINGS

REFERENCE DRAWING LIST FOR:


[illegible][illegible]

				elf aquitaine norge a/s p.o.box 168 4001 Stavanger		 elf		Job no.		Installation CDP 1		System UNDERWATER	
								Scale					
Rev.		Date		DESCRIPTION		by		app.		Dwgr. no.		Rev	
Contractor				4001 Stavanger		FRIGG FIELD		FF		1459		Sheet	

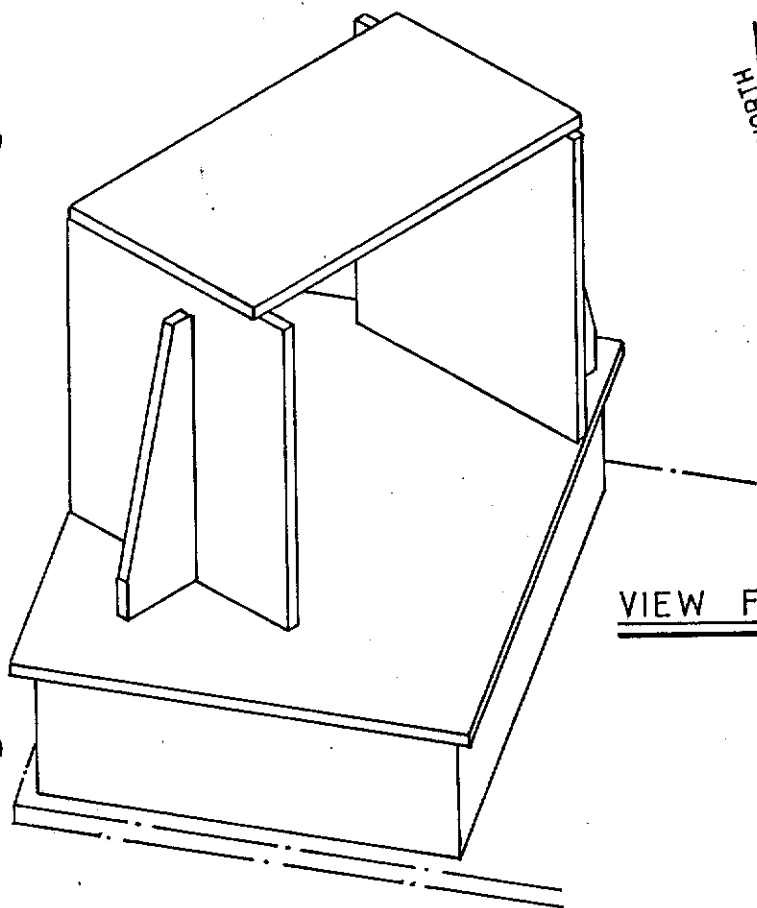

VIEW F



GRID NORTH
19° 37'
PLAT. NORTH

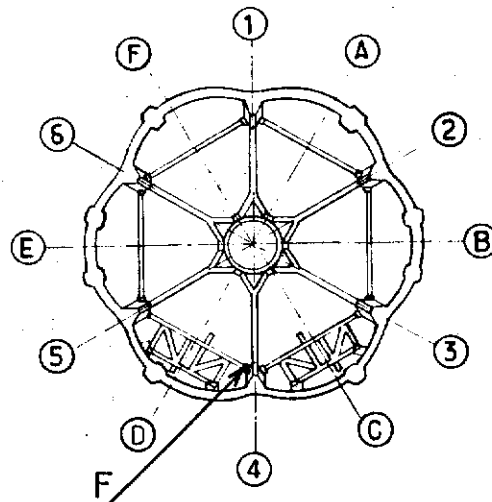

KEY PLAN



SECTION AA'

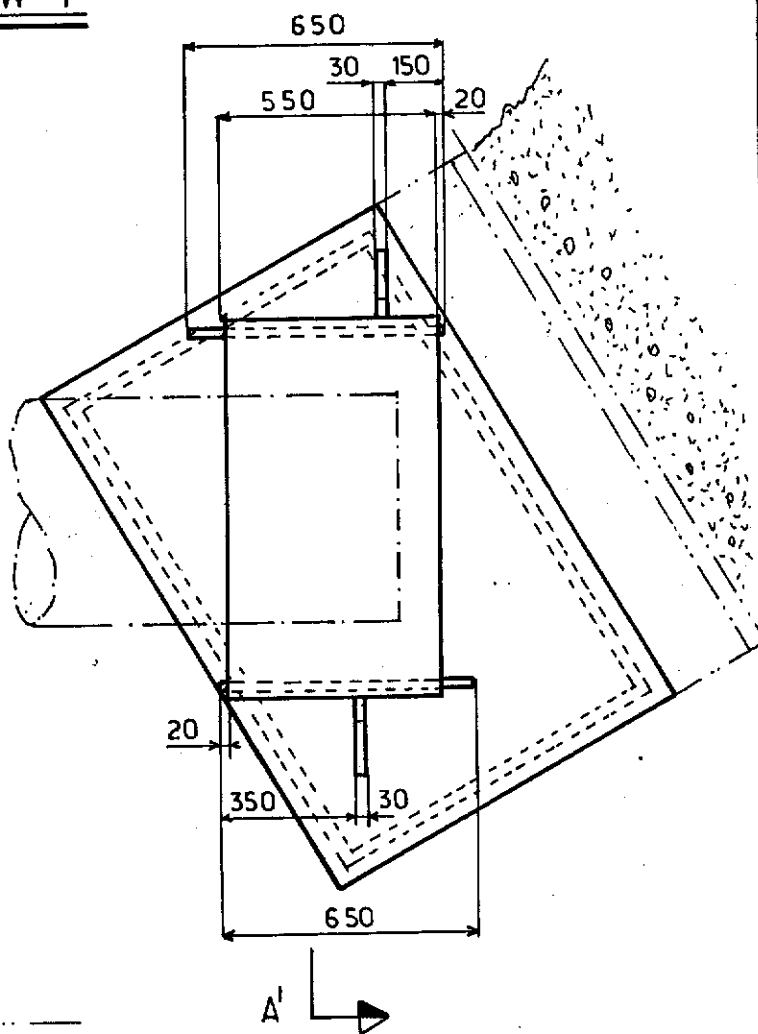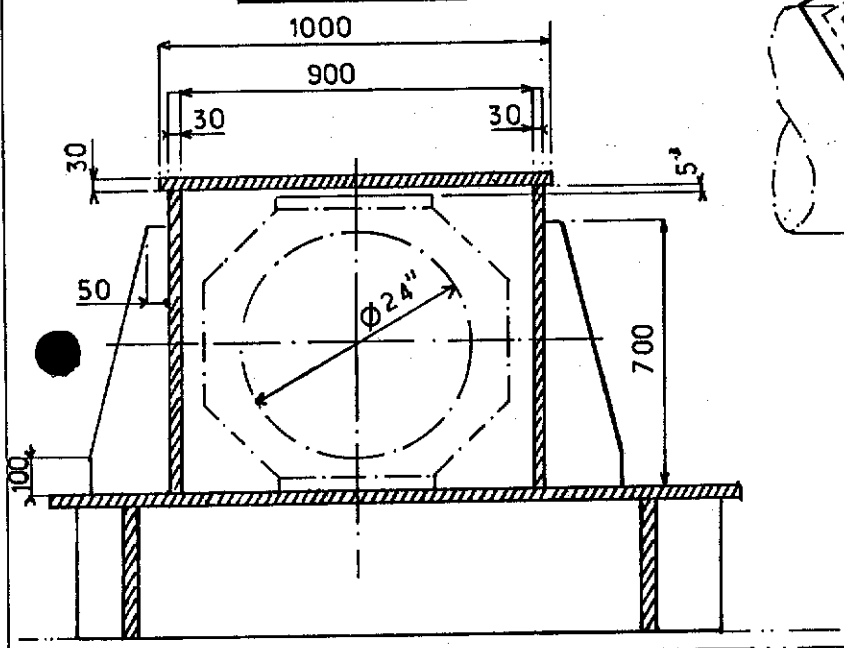

NOTES

FOR LOCATION SEE SK FF 91.36.35.1444.

FOR DETAIL OF FREE LOCK PIPE END SEE SK FF 91.36.35.1458.

Rev.	Date	DESCRIPTION	by	app.
1	12.83	UP DATED	B.V.H.	J.C.
Contractor JVD 1029.40.130				

elf
aquitaine
norge a/s
p.o. box 168

4001 Stavanger



FRIGG FIELD

Job no.	Installation	System
	CDP 1	UNDERWATER
Scale	BOX FOR FREE LOCK	DD 1
1:20	CELL D	LEVEL D
Dwgr. no.	FF 91.36.35.1460	Rev 1
		Sheet


CDP 1 AS BUILT DRAWINGS

REFERENCE DRAWING LIST FOR:

[illegible][illegible]



					elf aquitaine norge a/s p.o.box 168 4001 Stavanger	 elf	Job no.	Installation CDP 1	System UNDERWATER		
							Scale	BOXE FOR FREE Lock DD1			
Rev.	Date	DESCRIPTION	by	app.	Contractor 4001 Stavanger	FRIGG FIELD	Dwgr. no.	FF — — <u>1460</u>		Rev.	Sheet /

GRID NORTH
19° 37'
PLAT. NORTH

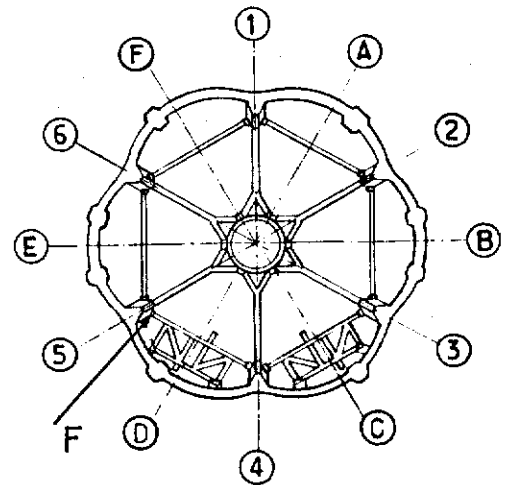

KEY PLAN

VIEW F

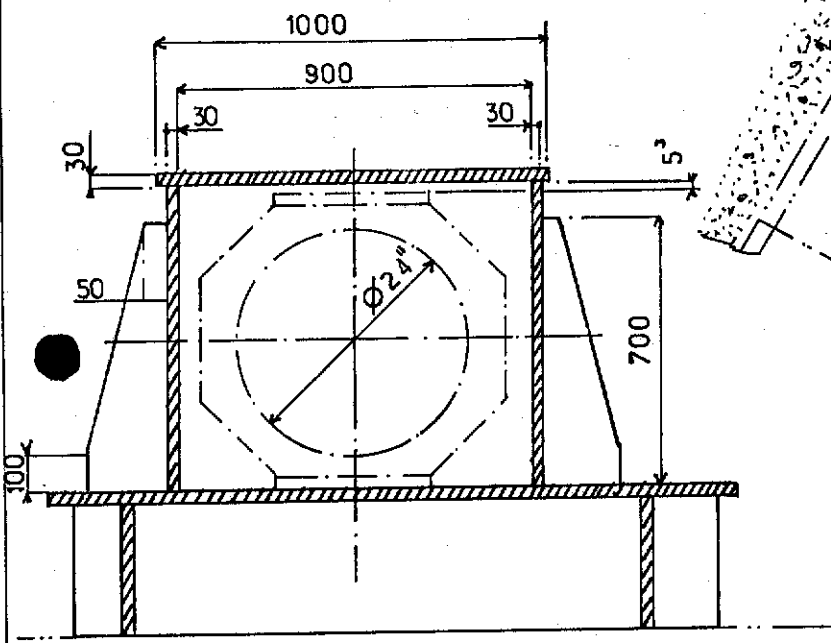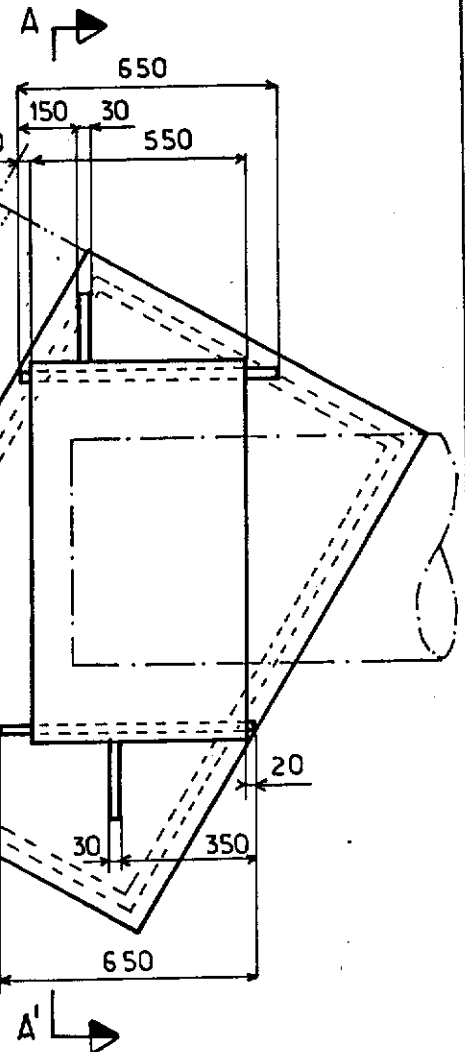

SECTION AA'

NOTES

FOR LOCATION SEE SK FF_91.36.35.1444.

FOR DETAIL OF FREE LOCK PIPE END SEE SK FF_91.36.35.1459.

				elf aquitaine norge a/s		Job no.	Installation CDP 1	System UNDERWATER
1	1283	UP DATED	BYVH J.L.C.	p.o.box 168 4001 Stavanger		Scale 1:20	BOX FOR FREE LOCK DD4 CELL D LEVEL D	
Rev.	Date	DESCRIPTION	by	app.		Dwgr. no.	Rev	Sheet
Contractor JVD 1029.40.131.				FRIGG FIELD		FF 91.36.35.1461		1


CDP 1 AS BUILT DRAWINGS

REFERENCE DRAWING LIST FOR:


[illegible][illegible]

						 elf	Job no.	Installation CDP 1	System UNDERWATER	
							Scale	BOXE FOR FREE LOCK DD4		
Rev.	Date	DESCRIPTION	by	app.			Dwgr. no.	FF — — 1461	Rev.	Sheet /
Contractor						4001 Stavanger	FRIGG FIELD			

GRID NORTH
19°37'
PLAT. NORTH

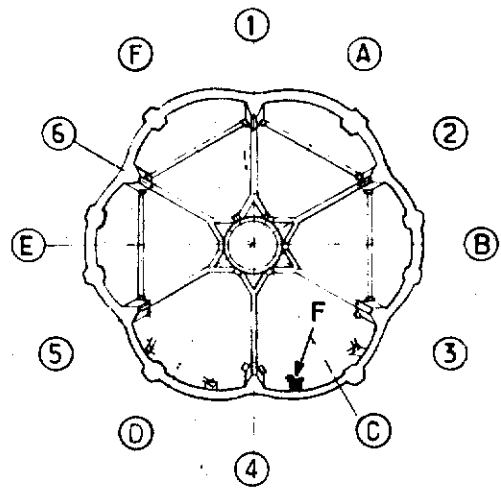

KEY PLAN

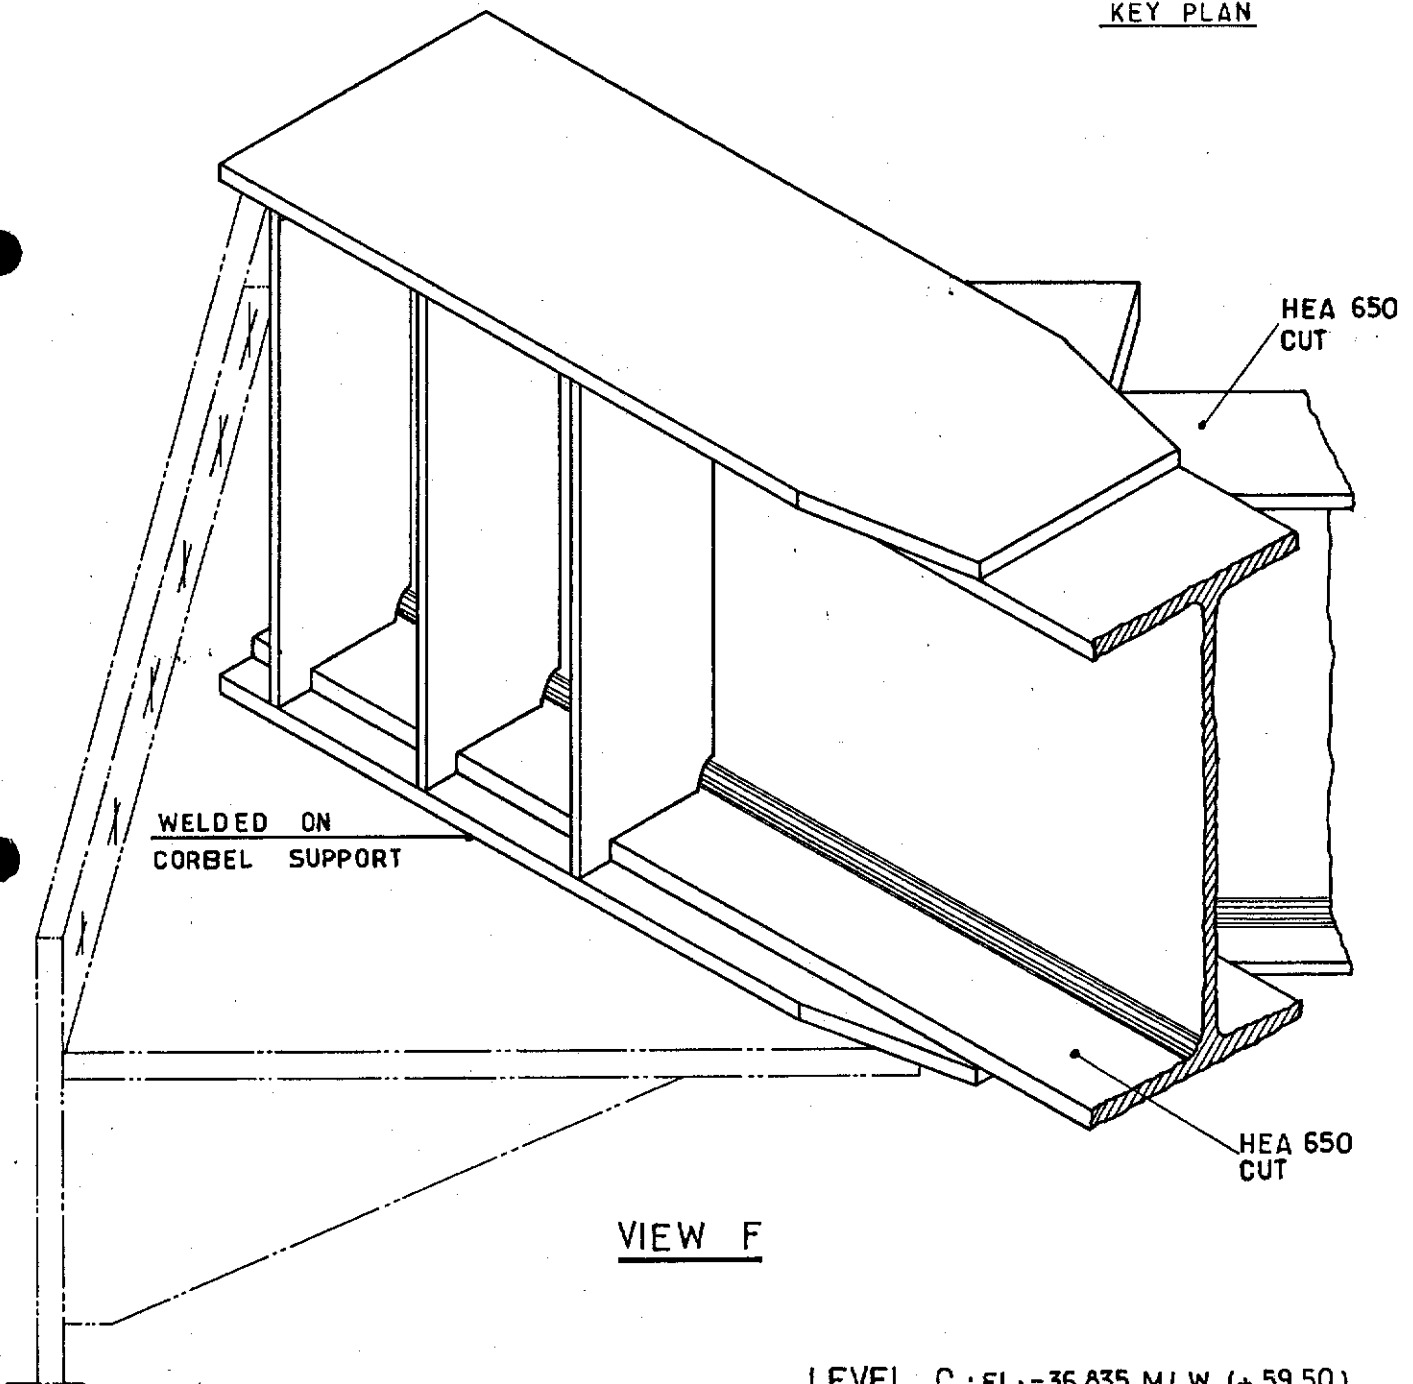

LEVEL C : EL: -36.835 MLW (+ 59.50)

						elf aquitaine norge a/s p.o.box 168 4001 Stavanger	 elf	Job no.	Installation CDP 1	System UNDERWATER	
1	12.83	UP DATED	BYH	LLC				Scale —	REMAINING PART OF CONDUCTOR GUIDE FRAME ON CORBEL C2 IN CELL C		
Rev.	Date	DESCRIPTION	by	app.				Dwgr. no.		1	Sheet —
Contractor JVD 1029 40_136						4001 Stavanger	FRIGG FIELD	FF_91_36_35_1466.			


CDP 1 AS BUILT DRAWINGS

REFERENCE DRAWING LIST FOR: CONDUCTOR GUIDE FRAME


[illegible][illegible]

				elf		Job no.		Installation		System	
				aquitaine				CDP 1		UNDERWATER	
				norge a/s				Scale			
				p.o.box 168		Dwgr. no.				Rev.	
Rev.	Date	DESCRIPTION	by	app.	4001 Stavanger		FF		1466		Sheet
Contractor					FRIGG FIELD						

19°37'
 PLAT. NORTH
 68°10' NORTH

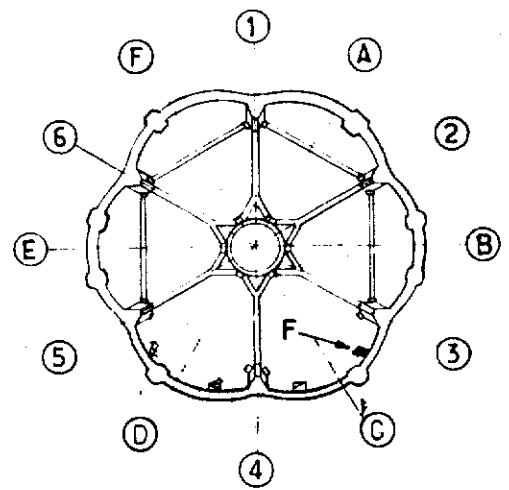

KEY PLAN

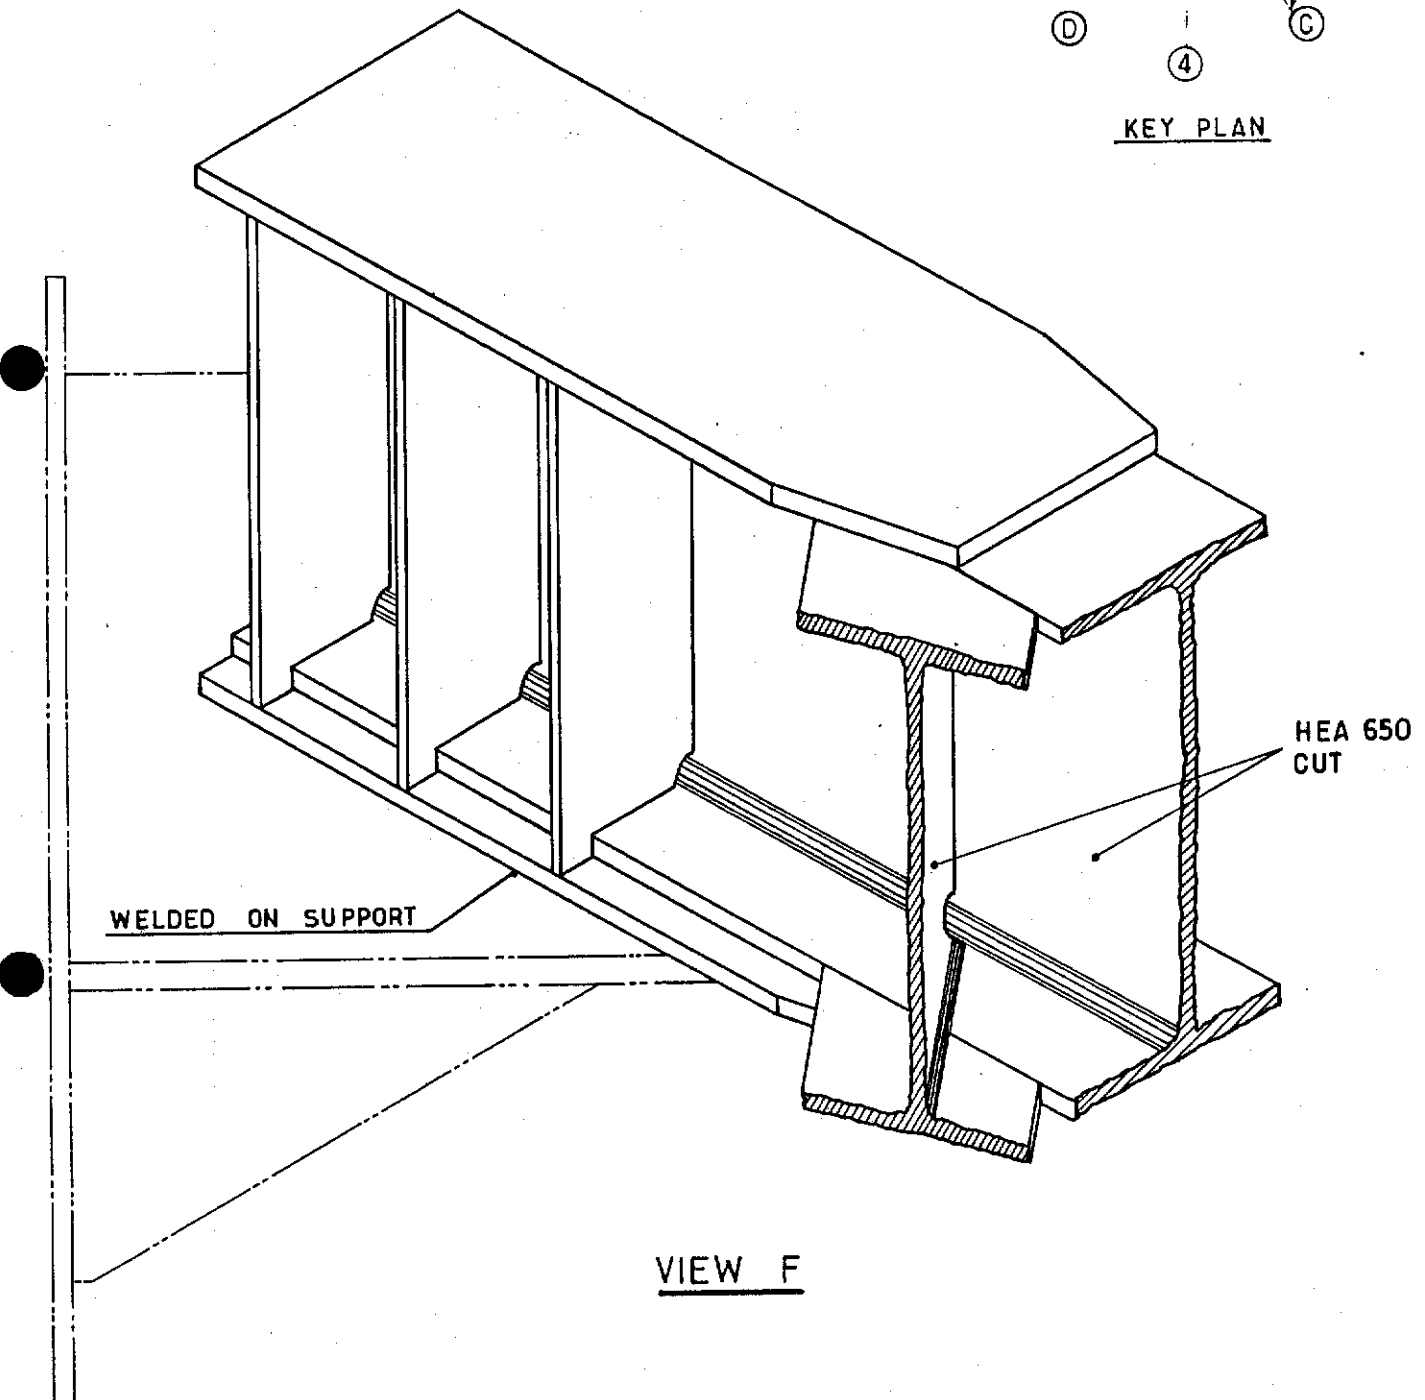

VIEW F

LEVEL C : EL: -36.835 MLW (+59.50)

				elf aquitaine norge a/s			Job no.	Installation CDP 1	System UNDERWATER
1	12.83	UP DATED	BYVH	J-L	p.o.box 168		Scale	REMAINING PART OF CONDUCTOR GUIDE FRAME ON CORBEL C3 IN CELL C	
Rev. Date		DESCRIPTION	by	app.	4001 Stavanger		Dwgr. no.	FF. 91.36.35.1467.	
Contractor		JYD 1029	40_137			FRIGG FIELD		1	


CDP 1 AS BUILT DRAWINGS

REFERENCE DRAWING LIST FOR: CONDUCTOR GUIDE FRAME


[illegible][illegible]

				elf aquitaine norge a/s p.o.box 168 4001 Stavanger		 elf		Job no.		Installation CDP 1		System UNDERWATER	
								Scale					
Rev.		Date		DESCRIPTION		by		app.		Dwgr. no.		Rev.	
Contractor										FF — — 1467		Sheet /	

GRID NORTH
19° 37'
PLAT. NORTH

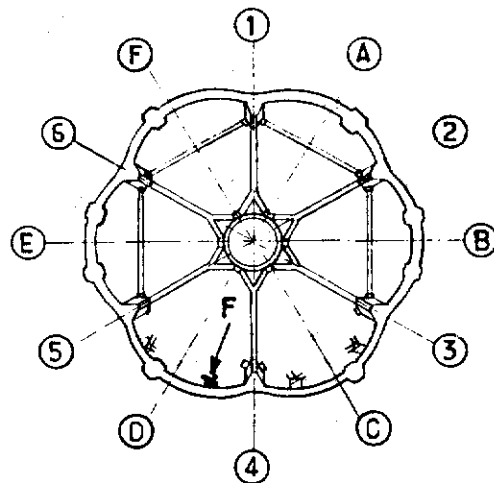

KEY PLAN

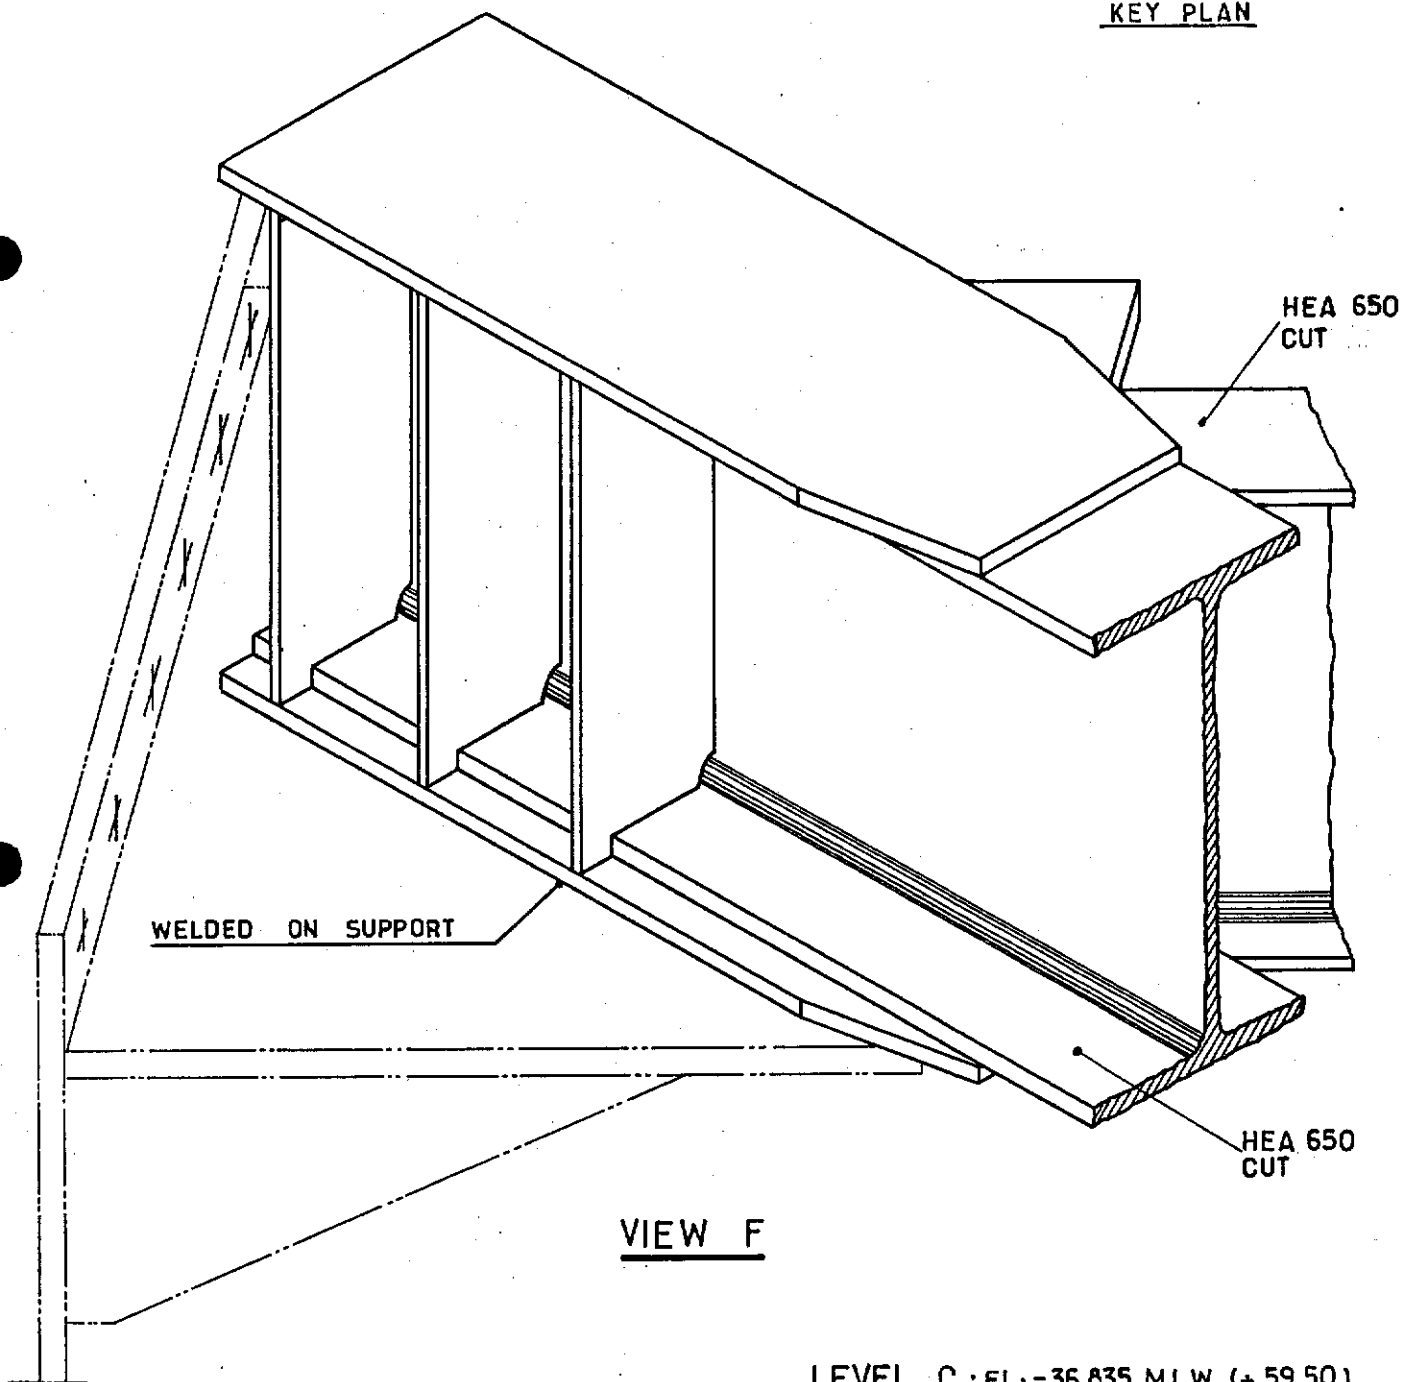

VIEW F

LEVEL C : EL: -36.835 MLW (+ 59.50)

					elf aquitaine norge a/s p.o.box 168 4001 Stavanger	 elf	Job no.	Installation CDP 1	System UNDERWATER	
1	1283	UP DATED	BY	H/LL			Scale /	REMAINING PART OF CONDUCTOR GUIDE FRAME ON CORBEL D2 IN CELL C		
Rev.	Date	DESCRIPTION	by	app.			Dwgr. no.		Rev	Sheet /
Contractor JVD 1029 40_138					4001 Stavanger	FRIGG FIELD	FF. 91.36.35.1468.		1	


CDP 1 AS BUILT DRAWINGS

REFERENCE DRAWING LIST FOR: CONDUCTOR GUIDE FRAME


[illegible][illegible]

					elf aquitaine norge a/s p.o.box 168 4001 Stavanger	 elf	Job no.	Installation CDP 1	System UNDERWATER		
							Scale				
Rev.	Date	DESCRIPTION	by	app.			Dwgr. no.				
Contractor							FF	1458		Rev.	Sheet

NORTH
 19° 37'
 PLAT. NORTH

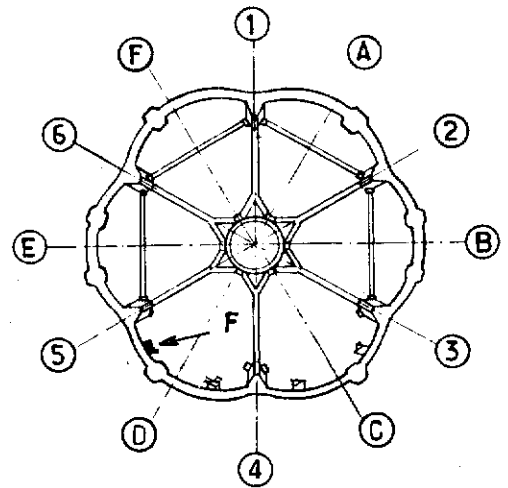

KEY PLAN

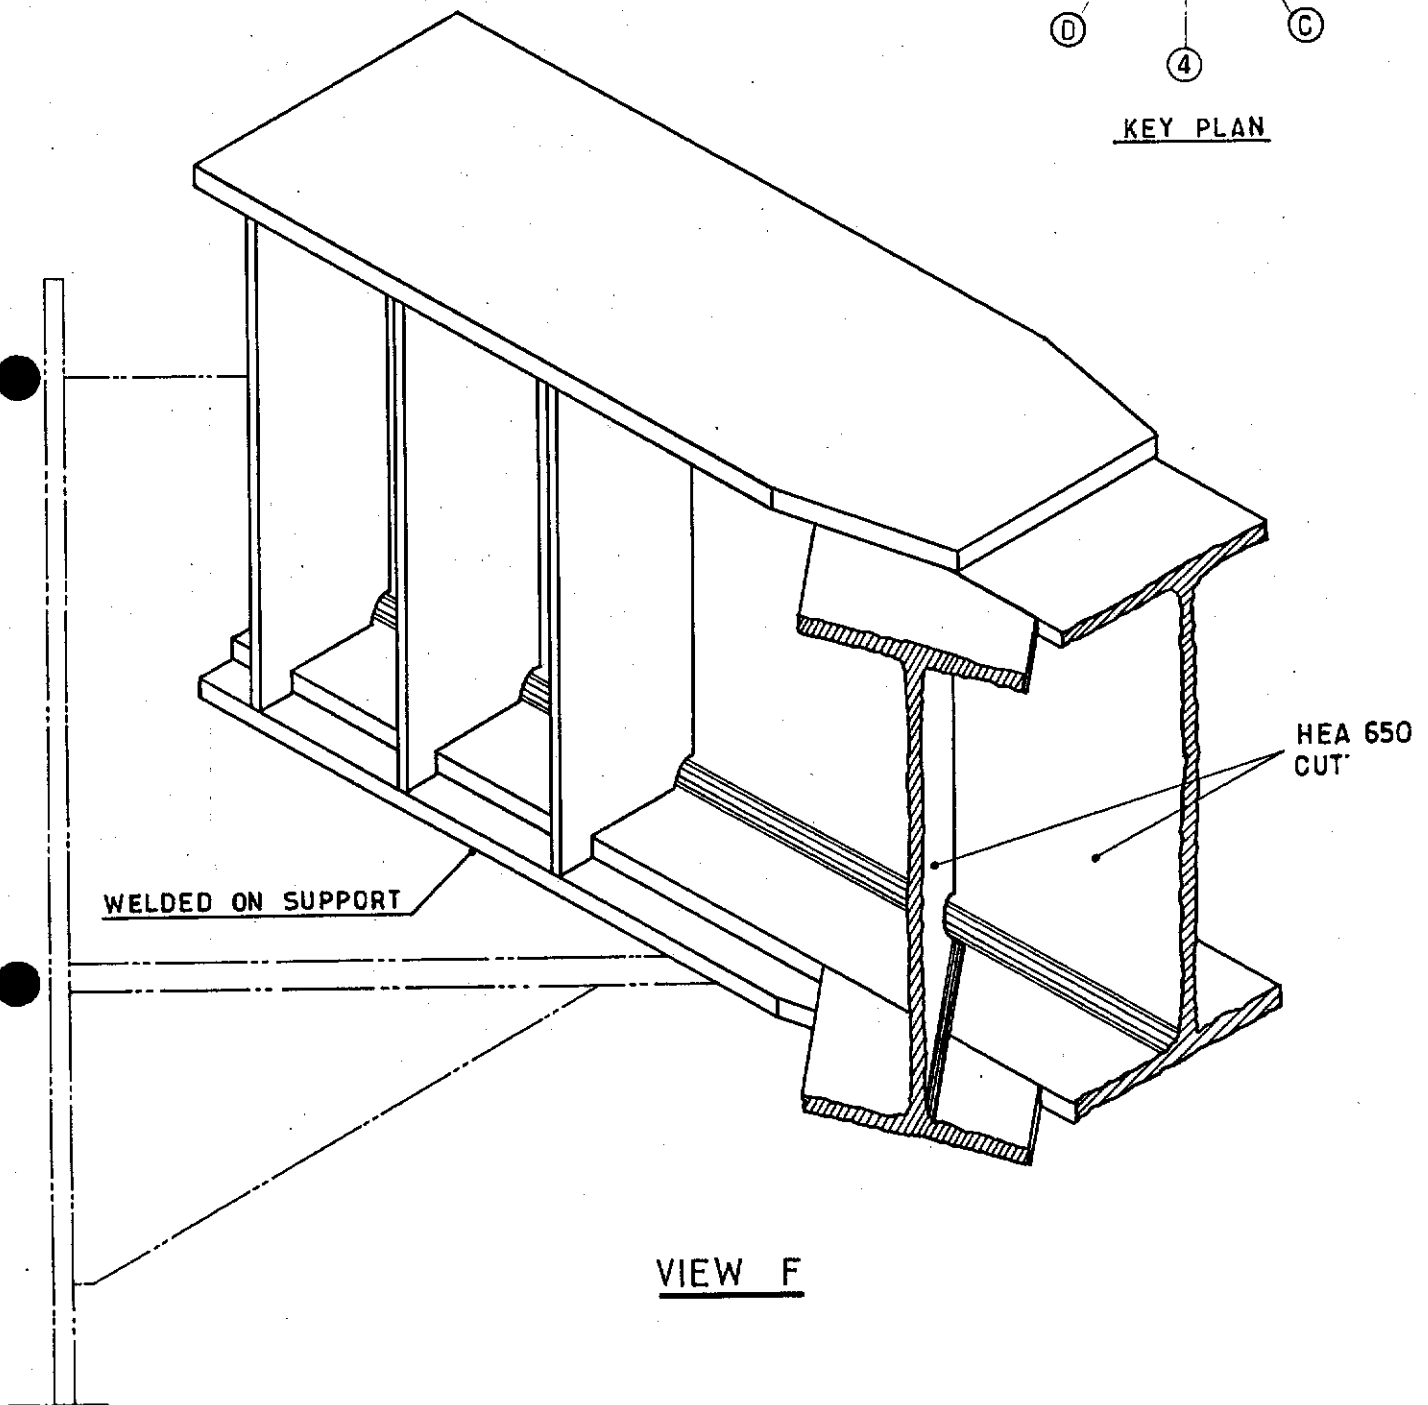

VIEW F

LEVEL C : EL: -36.635 MLW (+ 59.50)

1		12.83		UP DATED		BVH		J.L.C.		elf aquitaine norge a/s		 p.o.box 168 4001 Stavanger		Job no.		Installation CDP 1		System UNDERWATER	
Rev.		Date		DESCRIPTION		by		app.		REMAINING PART OF CONDUCTOR GUIDE FRAME ON CORBEL D3 IN CELL C		Dwgr. no.		FF-91-36-35-1469-		Rev		Sheet	
Contractor JVD 1029 - 40_139										FRIGG FIELD		1							


CDP 1 AS BUILT DRAWINGS

REFERENCE DRAWING LIST FOR: CONDUCTOR GUIDE FRAME


[illegible][illegible]

	Job no.	Installation CDP 1	System UNDERWATER	
	Scale			
elf aquitaine norge a/s p.o.box 168 4001 Stavanger	Dw gr. no. FF	1469		Rev.
Contractor 	FRIGG FIELD		Sheet 	

GRID NORTH
19° 37'
PLAT. NORTH

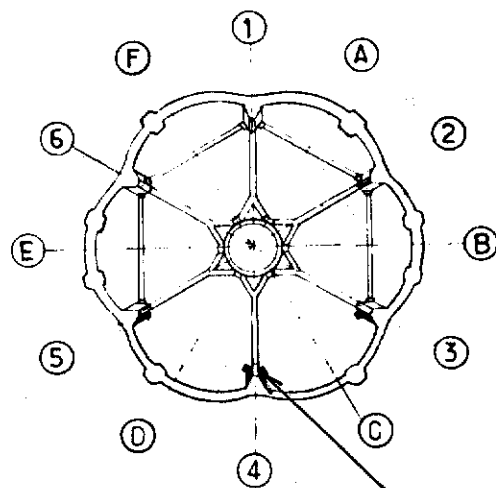

KEY PLAN

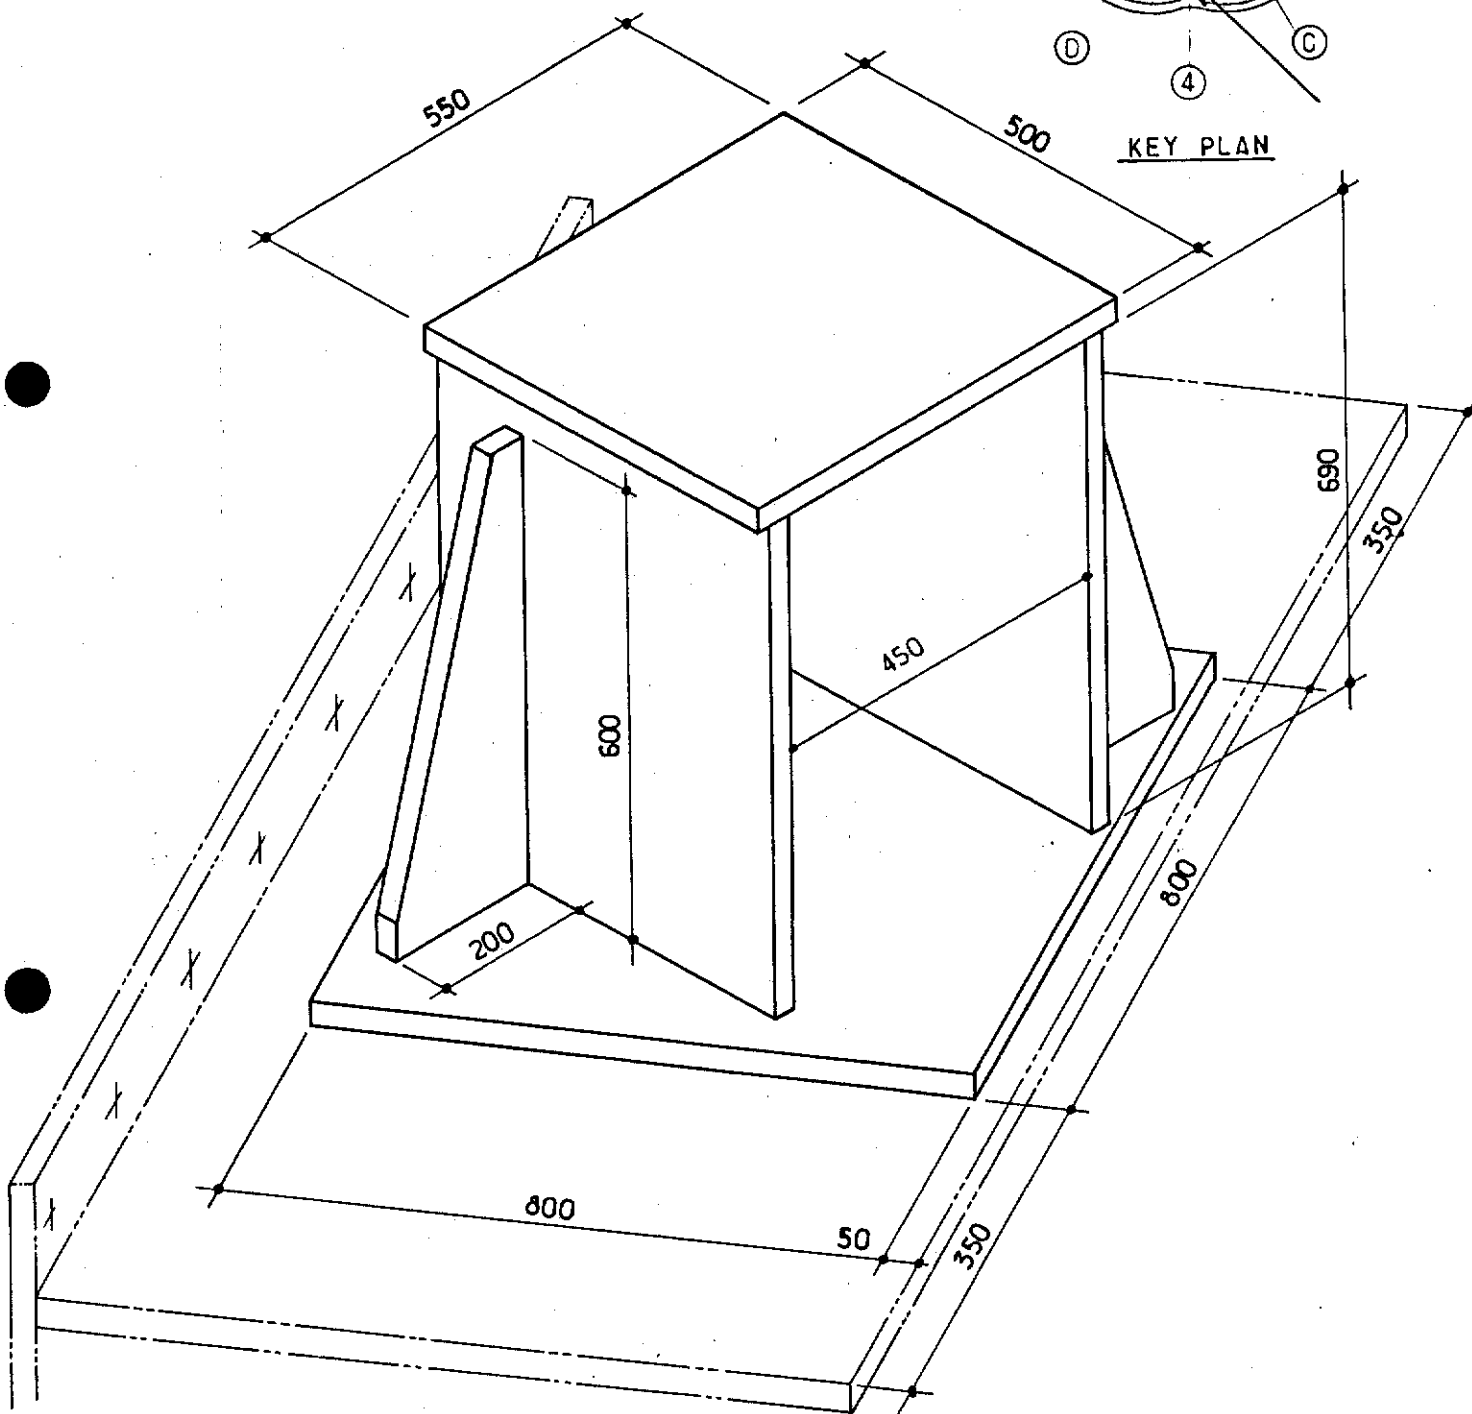

NOTES

ALL PLATES 30 mm thk.

LEVEL C : EL : -36,835 MLW (+59,500)




				elf aquitaine norge a/s p.o.box 168 4001 Stavanger	 elf	Job no.	Installation CDP 1	System UNDERWATER
1	12.83	UP DATED	BYH J.LC			Scale 1/10°	REMAINING PART OF GUIDE BOX CELL C C C 1 LEVEL C	
Rev.	Date	DESCRIPTION	by	app.		Dwgr. no.	FF. 91. 36. 35. 1470	1
Contractor JVD 1029. 40.140.				FRIGG FIELD				

CDP 1 AS BUILT DRAWINGS

REFERENCE DRAWING LIST FOR: CONDUCTOR GUIDE FRAMES

[illegible][illegible]

				elf aquitaine norge a/s p.o.box 168 4001 Stavanger	 elf	Job no.	Installation CDP 1	System UNDERWATER			
						Scale					
Rev.	Date	DESCRIPTION	by			app.	Dwgr. no.	1470		Rev.	Sheet
Contractor					4001 Stavanger	FRIGG FIELD	EE				/

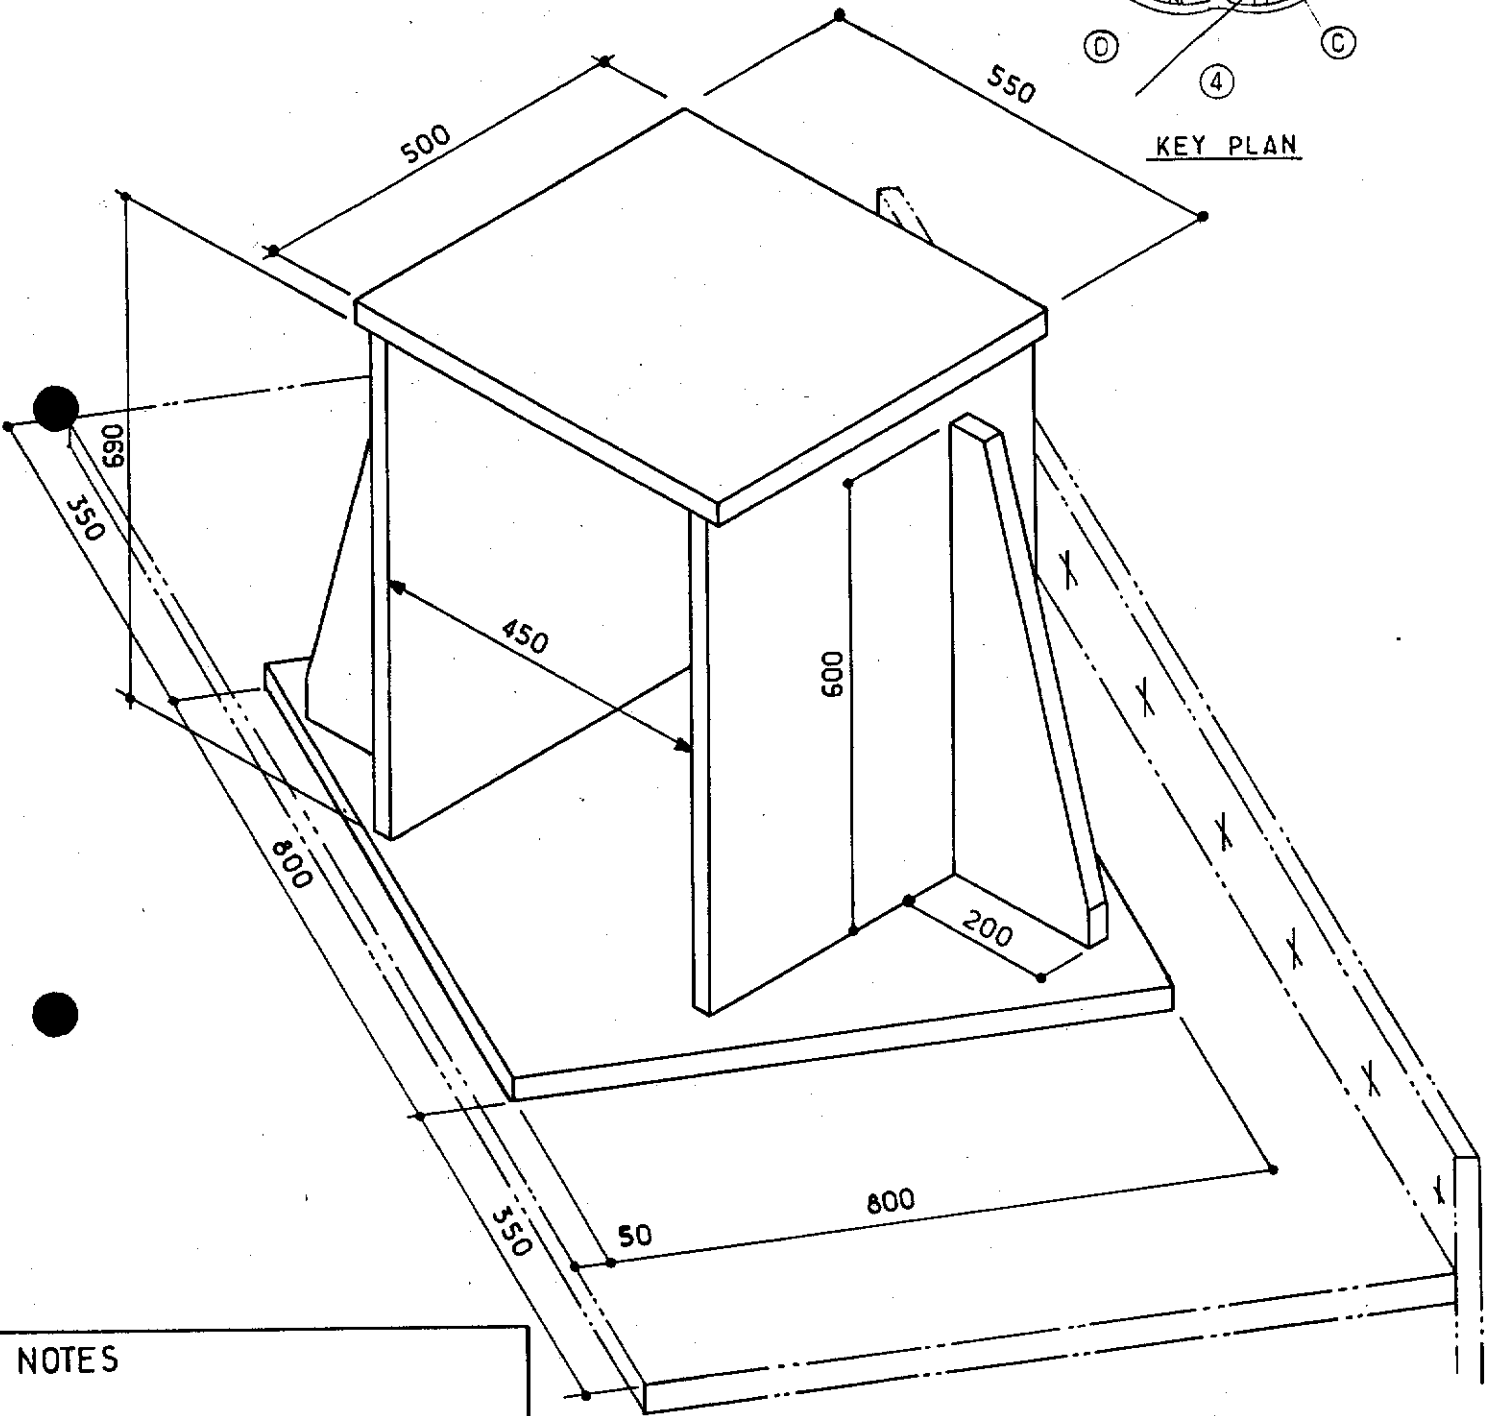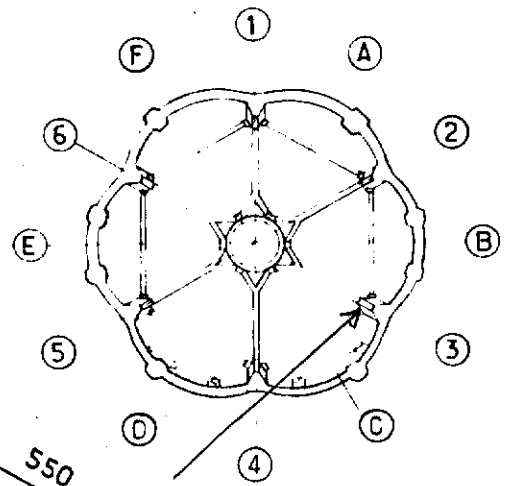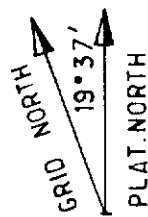

NOTES

ALL PLATES 30 mm thk.

LEVEL C . EL.: 36.835 MLW (+ 59.500)

				 elf FRIGG FIELD	Job no.	Installation CDP 1	System UNDERWATER
1	12.83	UP DATED	BY VH JLC		Scale 1/10°	REMAINING PART OF GUIDE BOX CELL C CC4 LEVEL C	
Rev.	Date	DESCRIPTION	by	app.	Dwgr. no	FF 91.36.35.1471	1
Contractor JVD 1029.40.141				p.o.box 168 4001 Stavanger			


CDP 1 AS BUILT DRAWINGS

REFERENCE DRAWING LIST FOR: CONDUCTOR GUIDE FRAMES


[illegible][illegible]

					elf aquitaine norge a/s p.o.box 168 4001 Stavanger	 elf	Job no.	Installation CDP 1	System UNDERWATER	
							Scale			
Rev.	Date	DESCRIPTION	by	app.	FRIGG FIELD	Dwgr. no. FF	1471		Rev.	Sheet
Contractor										

HIRON
DIR 19° 37'
PLAT NORTH

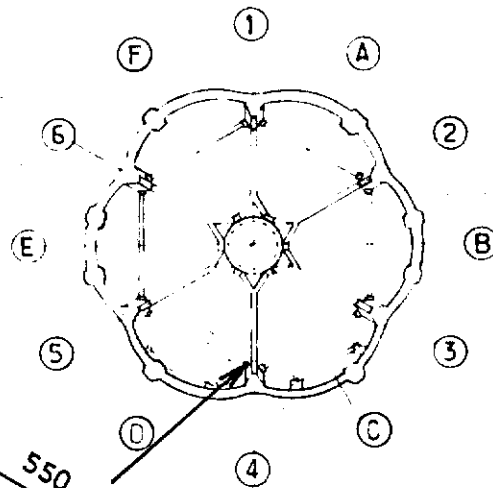

KEY PLAN

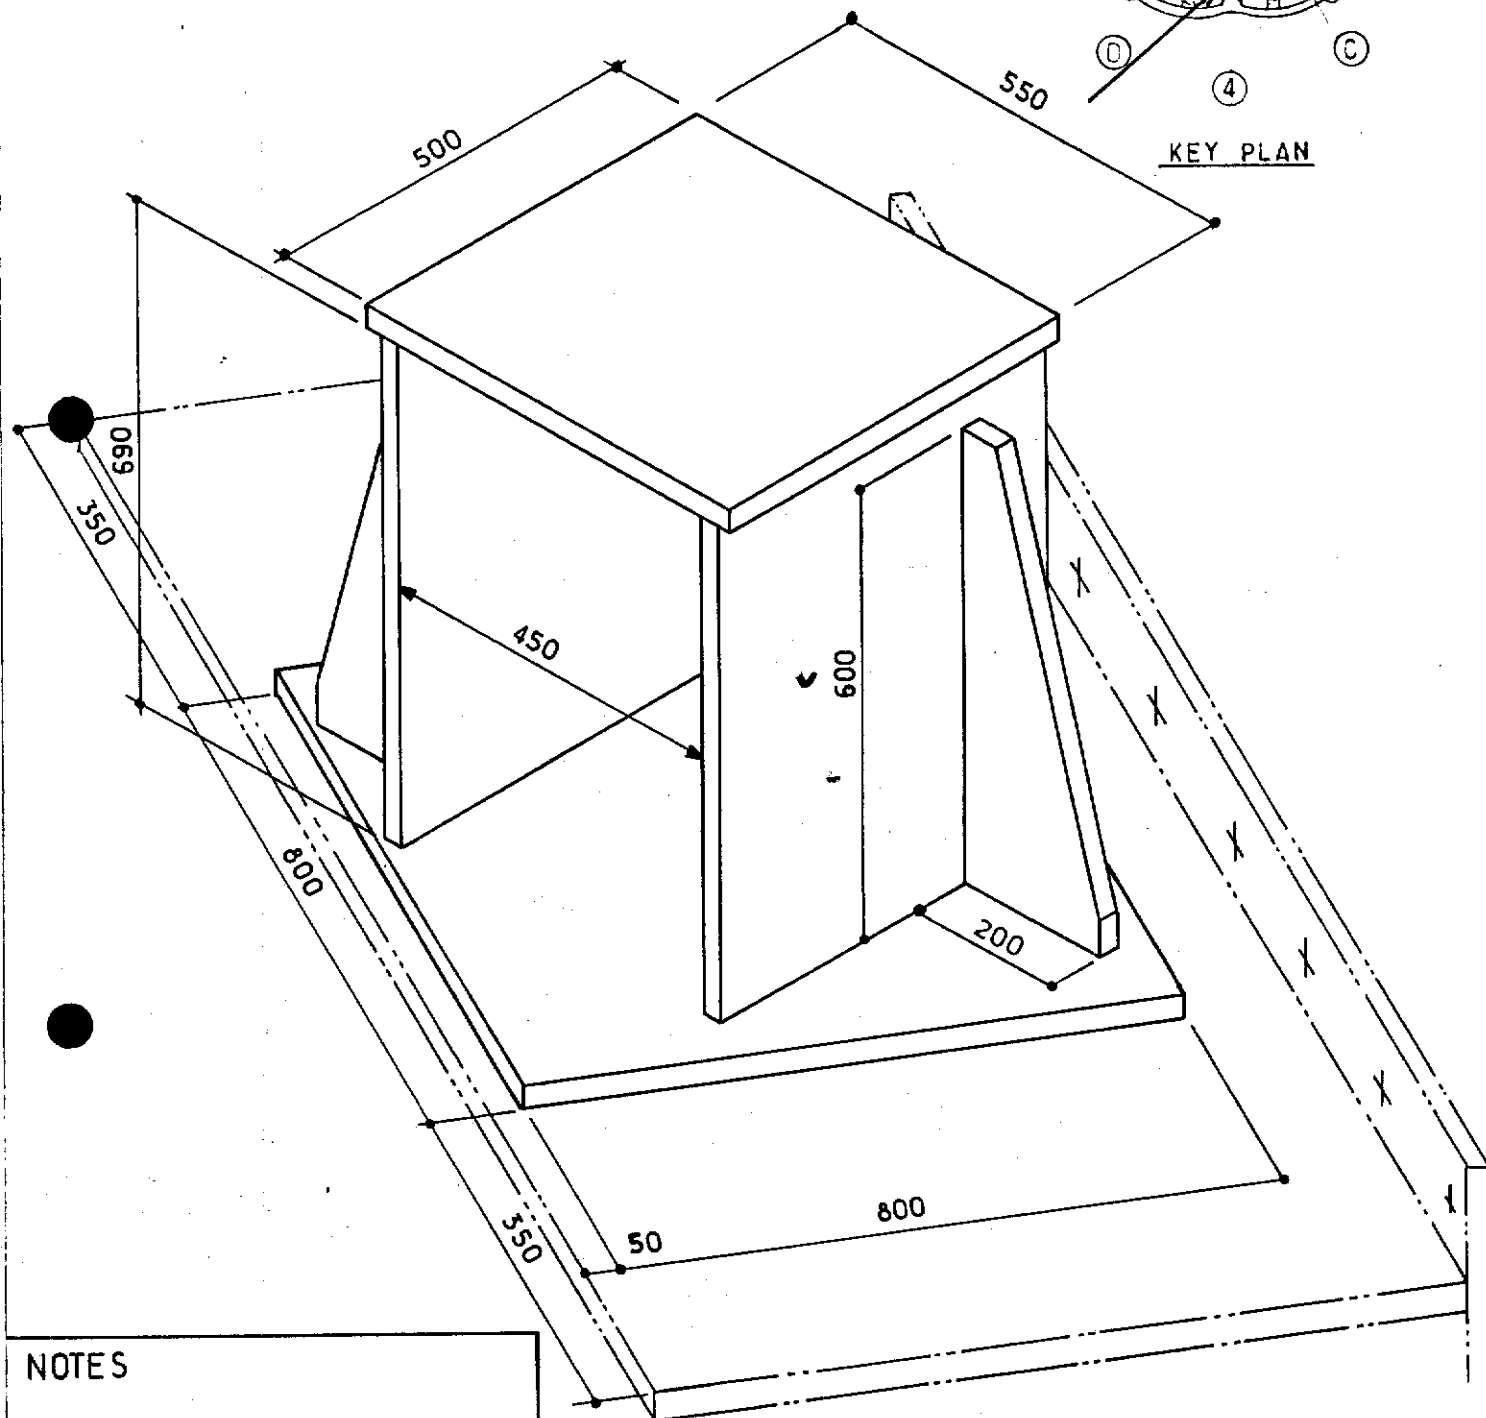

NOTES

ALL PLATES 30 mm thk.

LEVEL C . EL: 36.835 MLW (+ 59.500)

				elf		Job no.	Installation	System
				aquitaine			CDP 1	UNDERWATER
				norge a/s		Scale	REMAINING PART OF GUIDE BOX	
				p.o.box 168		1/10°	CELL D	CD 1
				4001 Stavanger		Dwgr. no	LEVEL C	
Contractor JVD 1029.40.142				FRIGG FIELD		FF 91.36.35.1472	1	


CDP 1 AS BUILT DRAWINGS

REFERENCE DRAWING LIST FOR: CONDUCTOR GUIDE FRAMES


[illegible][illegible]

					elf aquitaine norge a/s p.o.box 168 4001 Stavanger	 elf	Job no.	Installation CDP 1	System UNDERWATER		
							Scale				
Rev.	Date	DESCRIPTION	by	app.			Dwgr. no.	FF — — 1472	Rev.	Sheet /	
Contractor						FRIGG FIELD					

GRID NORTH
19° 37' PLAT. NORTH

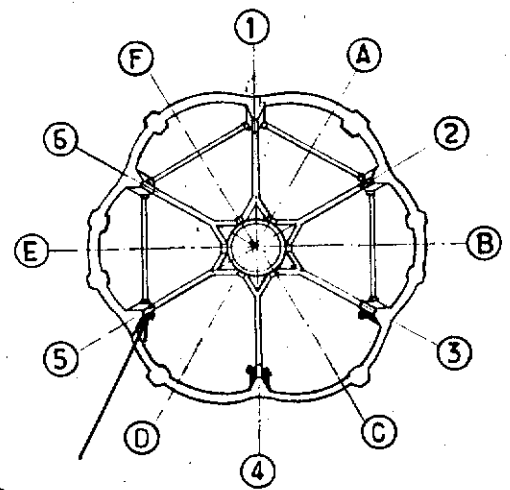

KEY PLAN

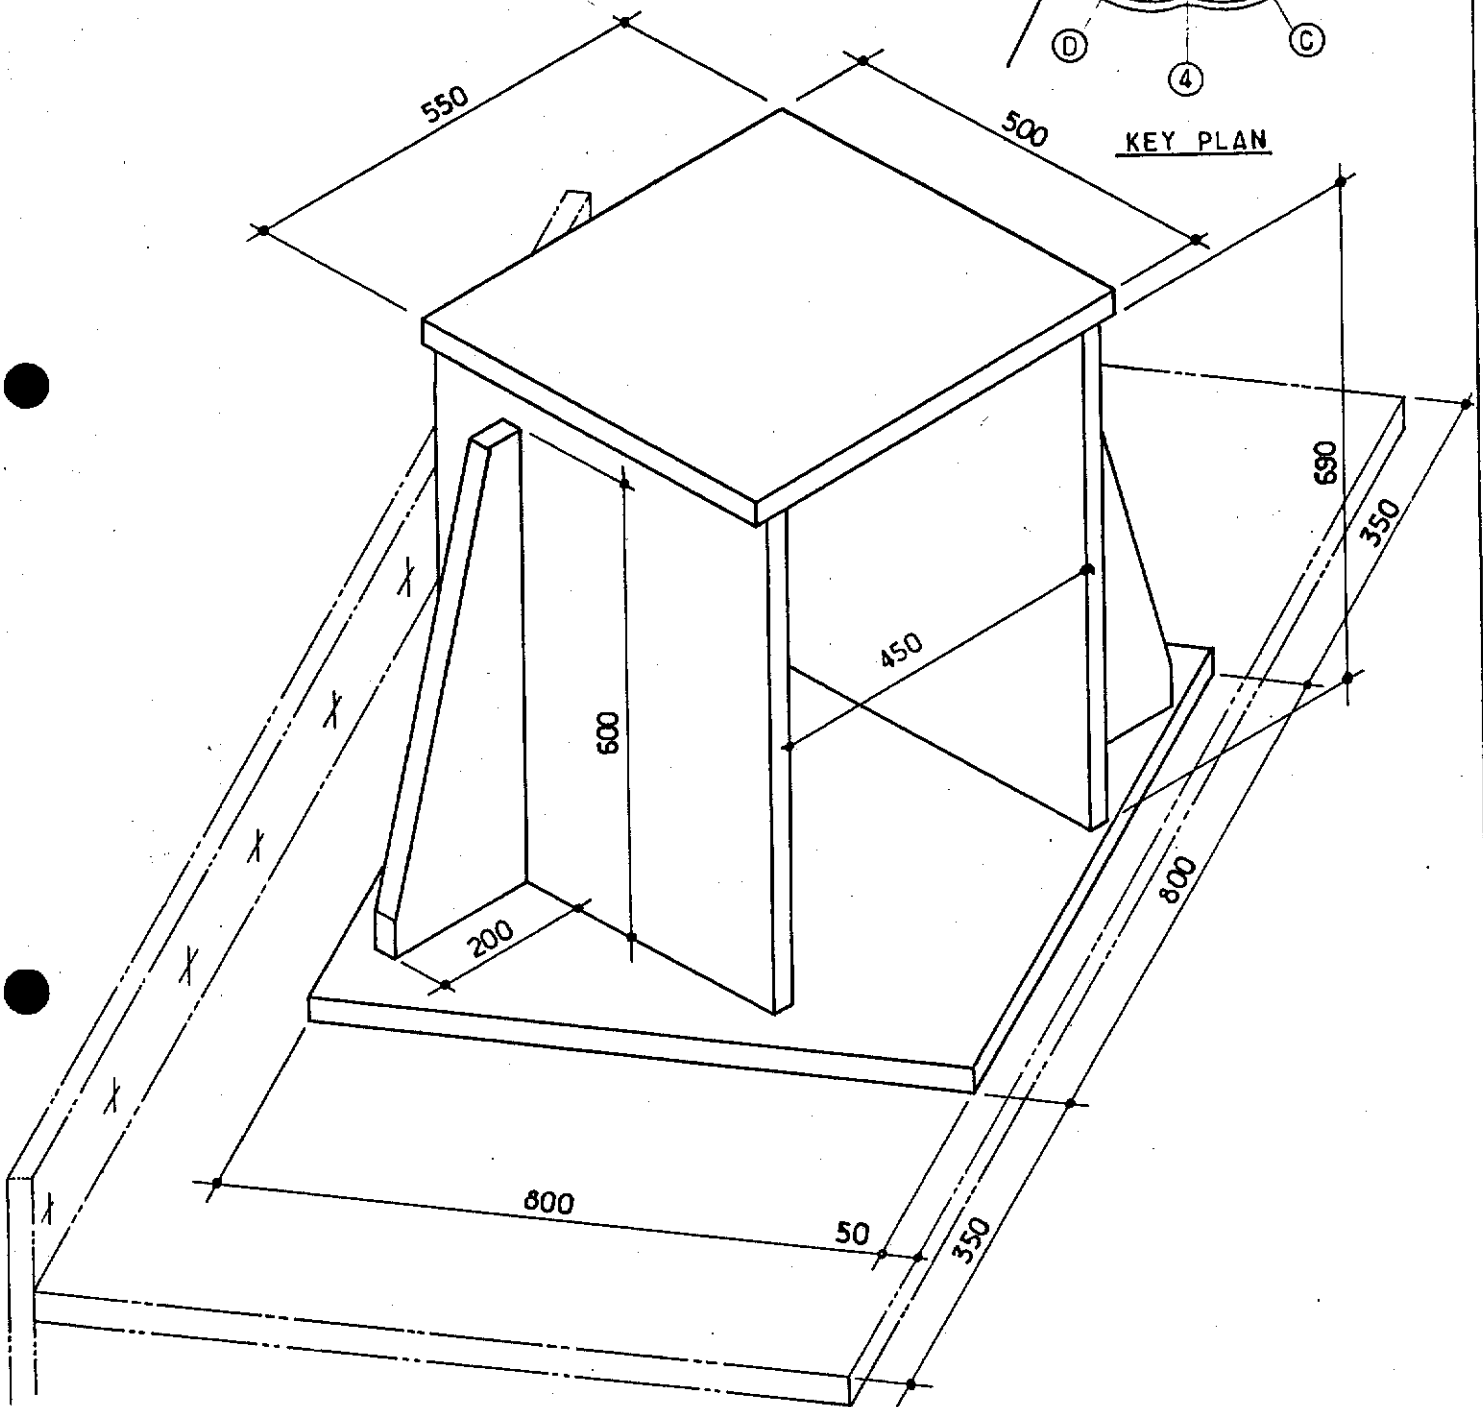

NOTES

ALL PLATES 30 mm thk.

LEVEL C : EL. - 36.835 MLW (+59.50)

				elf aquitaine norge a/s		Job no.	Installation CDP 1	System UNDERWATER
1	12.83	UP DATED	BY H. L. C.	p.o. box 168 4001 Stavanger		Scale 1/10°	REMAINING PART OF GUIDE BOX C D 4	
Rev.	Date	DESCRIPTION	by	app.		Dwgr. no.	CELL D	LEVEL C
Contractor JVD 1029. 40. 143.				FRIGG FIELD		FF. 91. 36. 35. 1473	Rev 1	Sheet /


CDP 1 AS BUILT DRAWINGS

REFERENCE DRAWING LIST FOR: CONDUCTOR GUIDE FRAMES


[illegible][illegible]

				elf aquitaine norge a/s p.o.box 168 4001 Stavanger	 elf	Job no.	Installation CDP 1	System UNDERWATER		
						Scale				
Rev.	Date	DESCRIPTION	by			app.	Dwgr. no.	1473		Rev.
Contractor					FRIGG FIELD	EE				/

GRID NORTH
19° 37'
PLAT NORTH

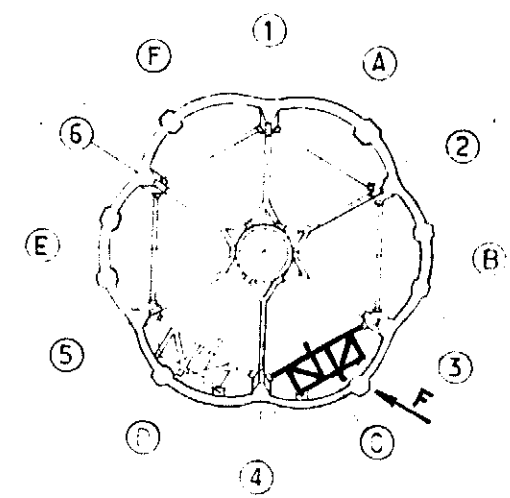

KEY PLAN

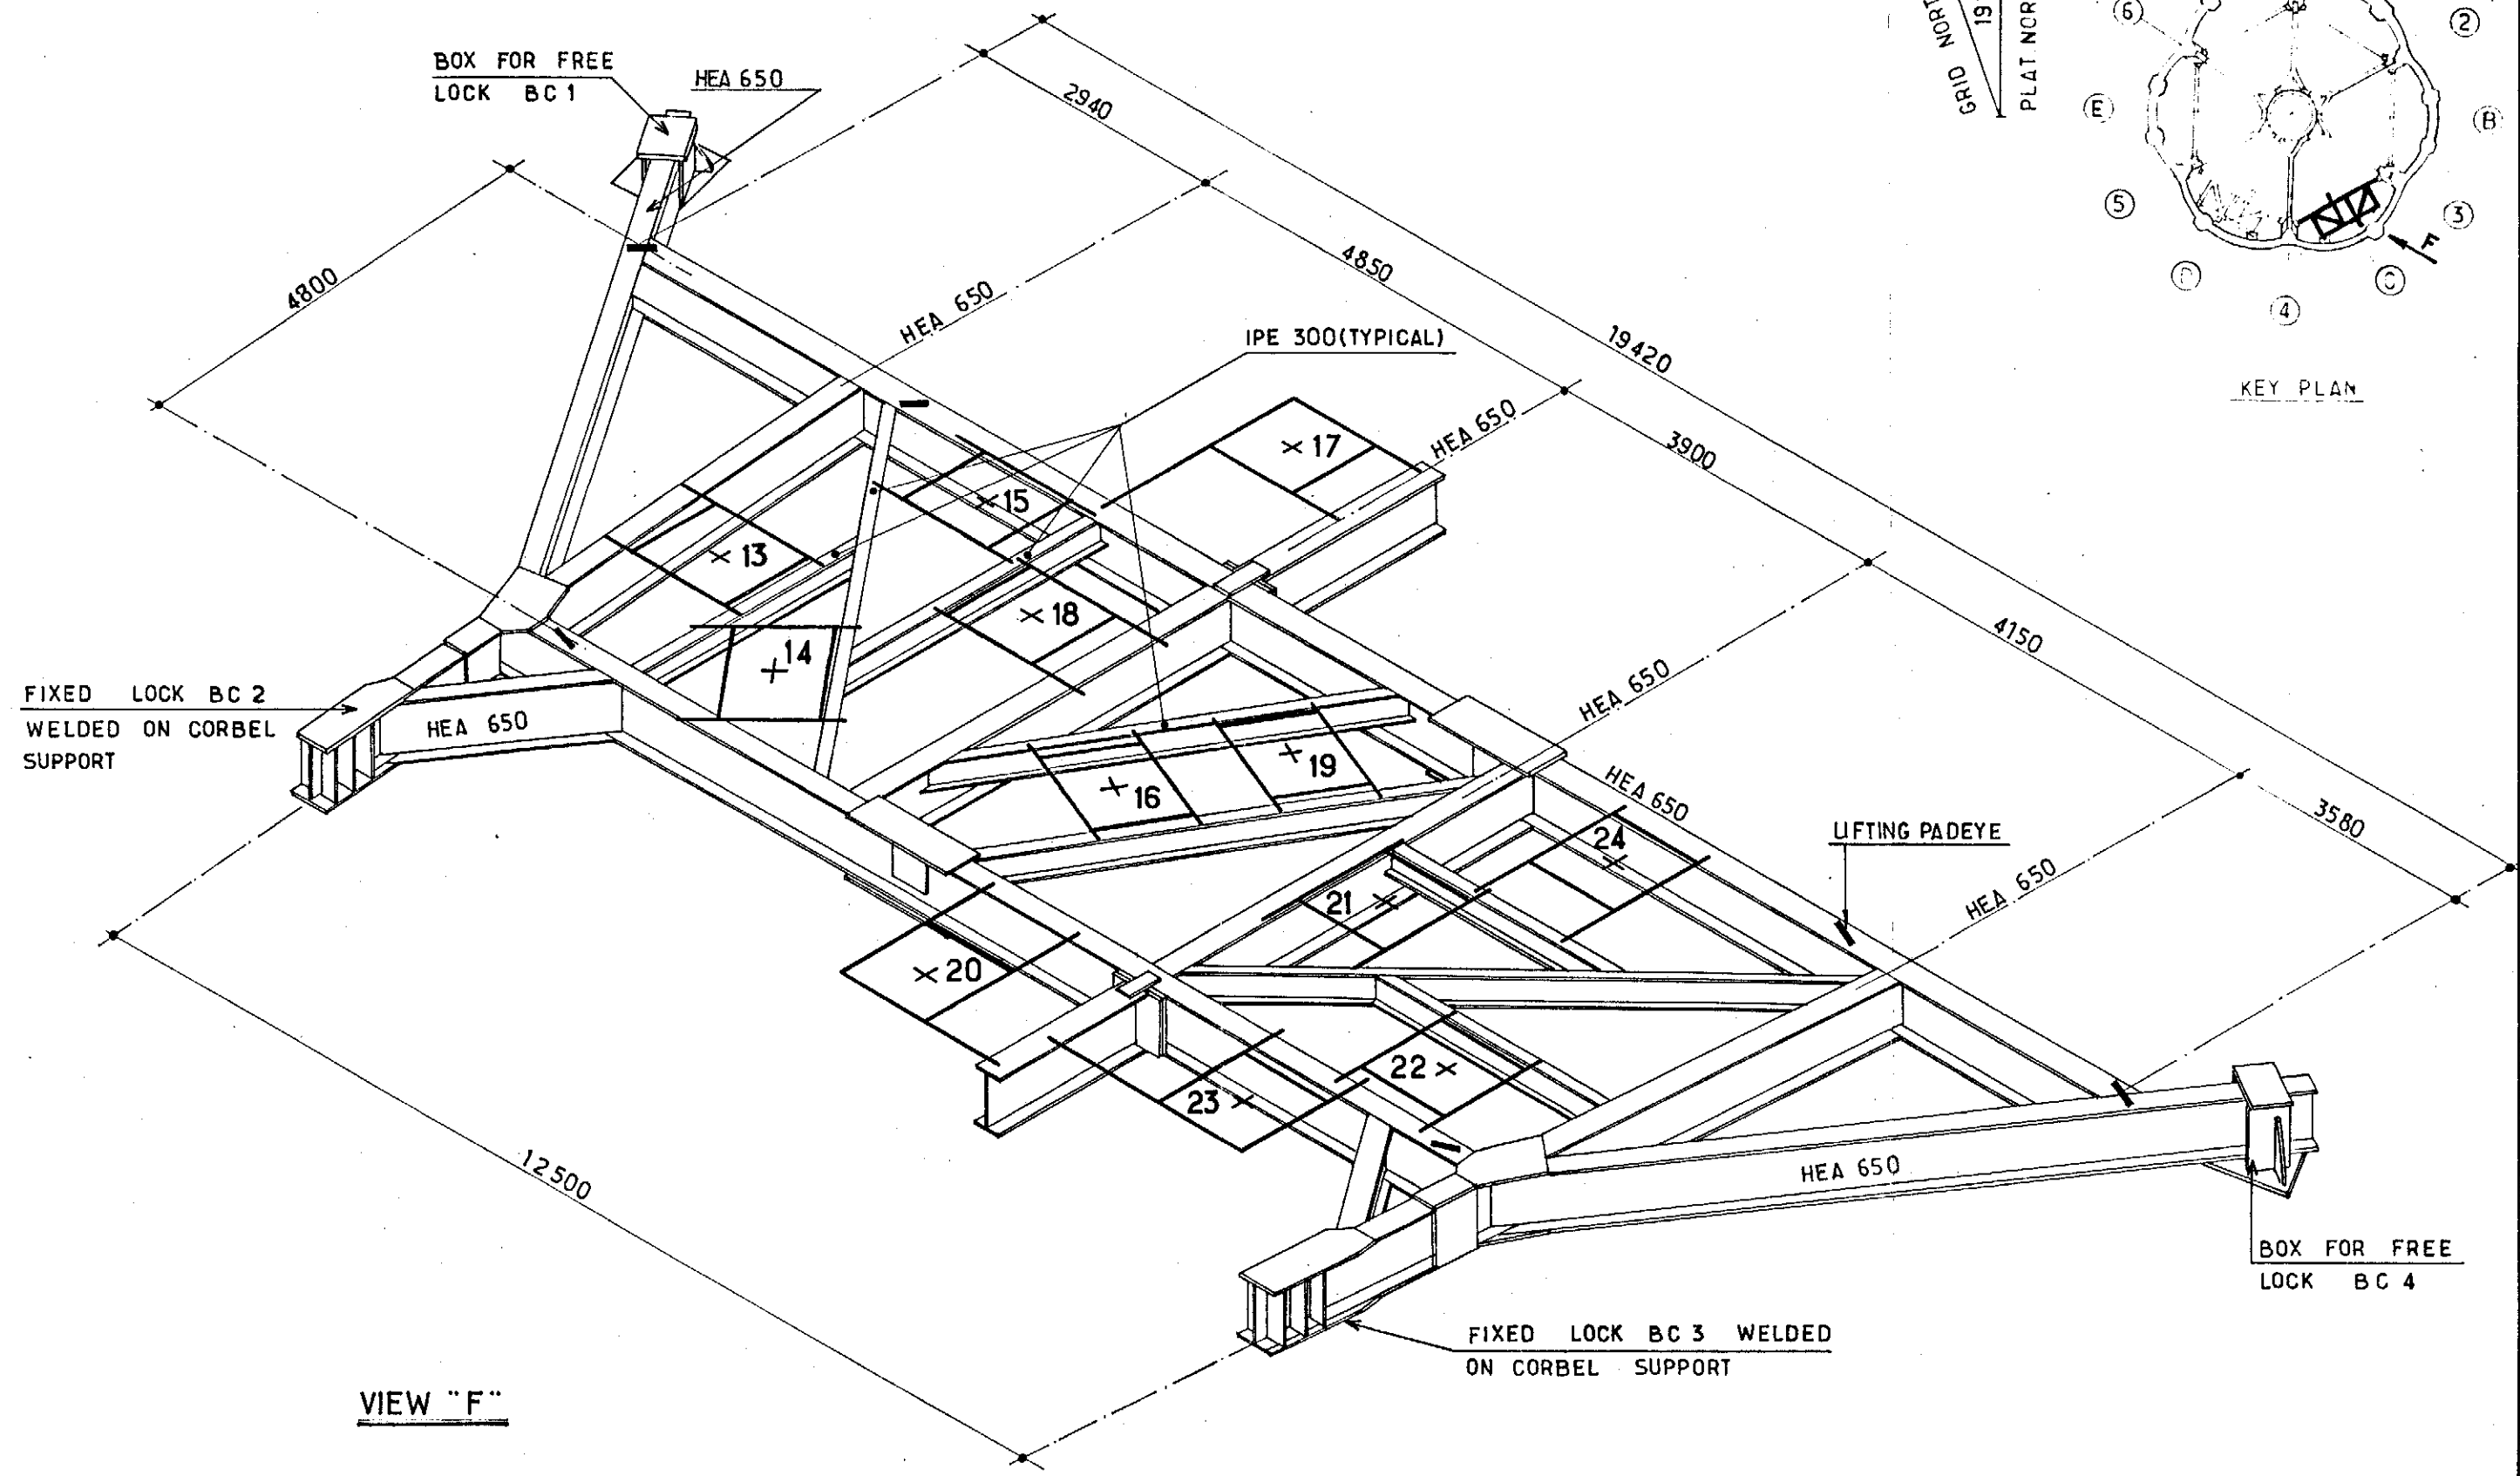

VIEW "F"

LEVEL B: EL.: ~ 59.835 (+36.500)

NOTES
FOR SECONDARY FRAME SEE SK FF_91.36.35.1480./ 1481./ 1482.
FOR BOX FOR FREE LOCK SEE SK FF_91.36.35.1483. TO FF_91.36.35.1486.

					elf aquitaine norge a/s p.o.box 168 4001 Stavanger
1	12.83	UP DATED	BVH	JAC	
Rev.	Date	DESCRIPTION	by	app.	
Contractor JVD1029.40.148					

elf
aquitaine
norge a/s
p.o.box 168
4001 Stavanger




Job no.	Installation CDP 1	System UNDERWATER
Scale 1/75	GENERAL VIEW OF GUIDE FRAME CELL "C" - LEVEL "B"	
Dwgr. no	FF_91.36.35.1478.	1

CDP 1 AS BUILT DRAWINGS

REFERENCE DRAWING LIST FOR: CONDUCTOR GUIDE FRAME

[illegible][illegible]

				elf aquitaine norge a/s p.o.box 168 4001 Stavanger		 elf		Job no.		Installation CDP 1		System UNDERWATER	
Rev. Date		DESCRIPTION		by				app.		Scale			
Contractor JVD 1029 4041				FRIGG FIELD		Dwgr. no. FF ____ 1478		Rev.		Sheet /			

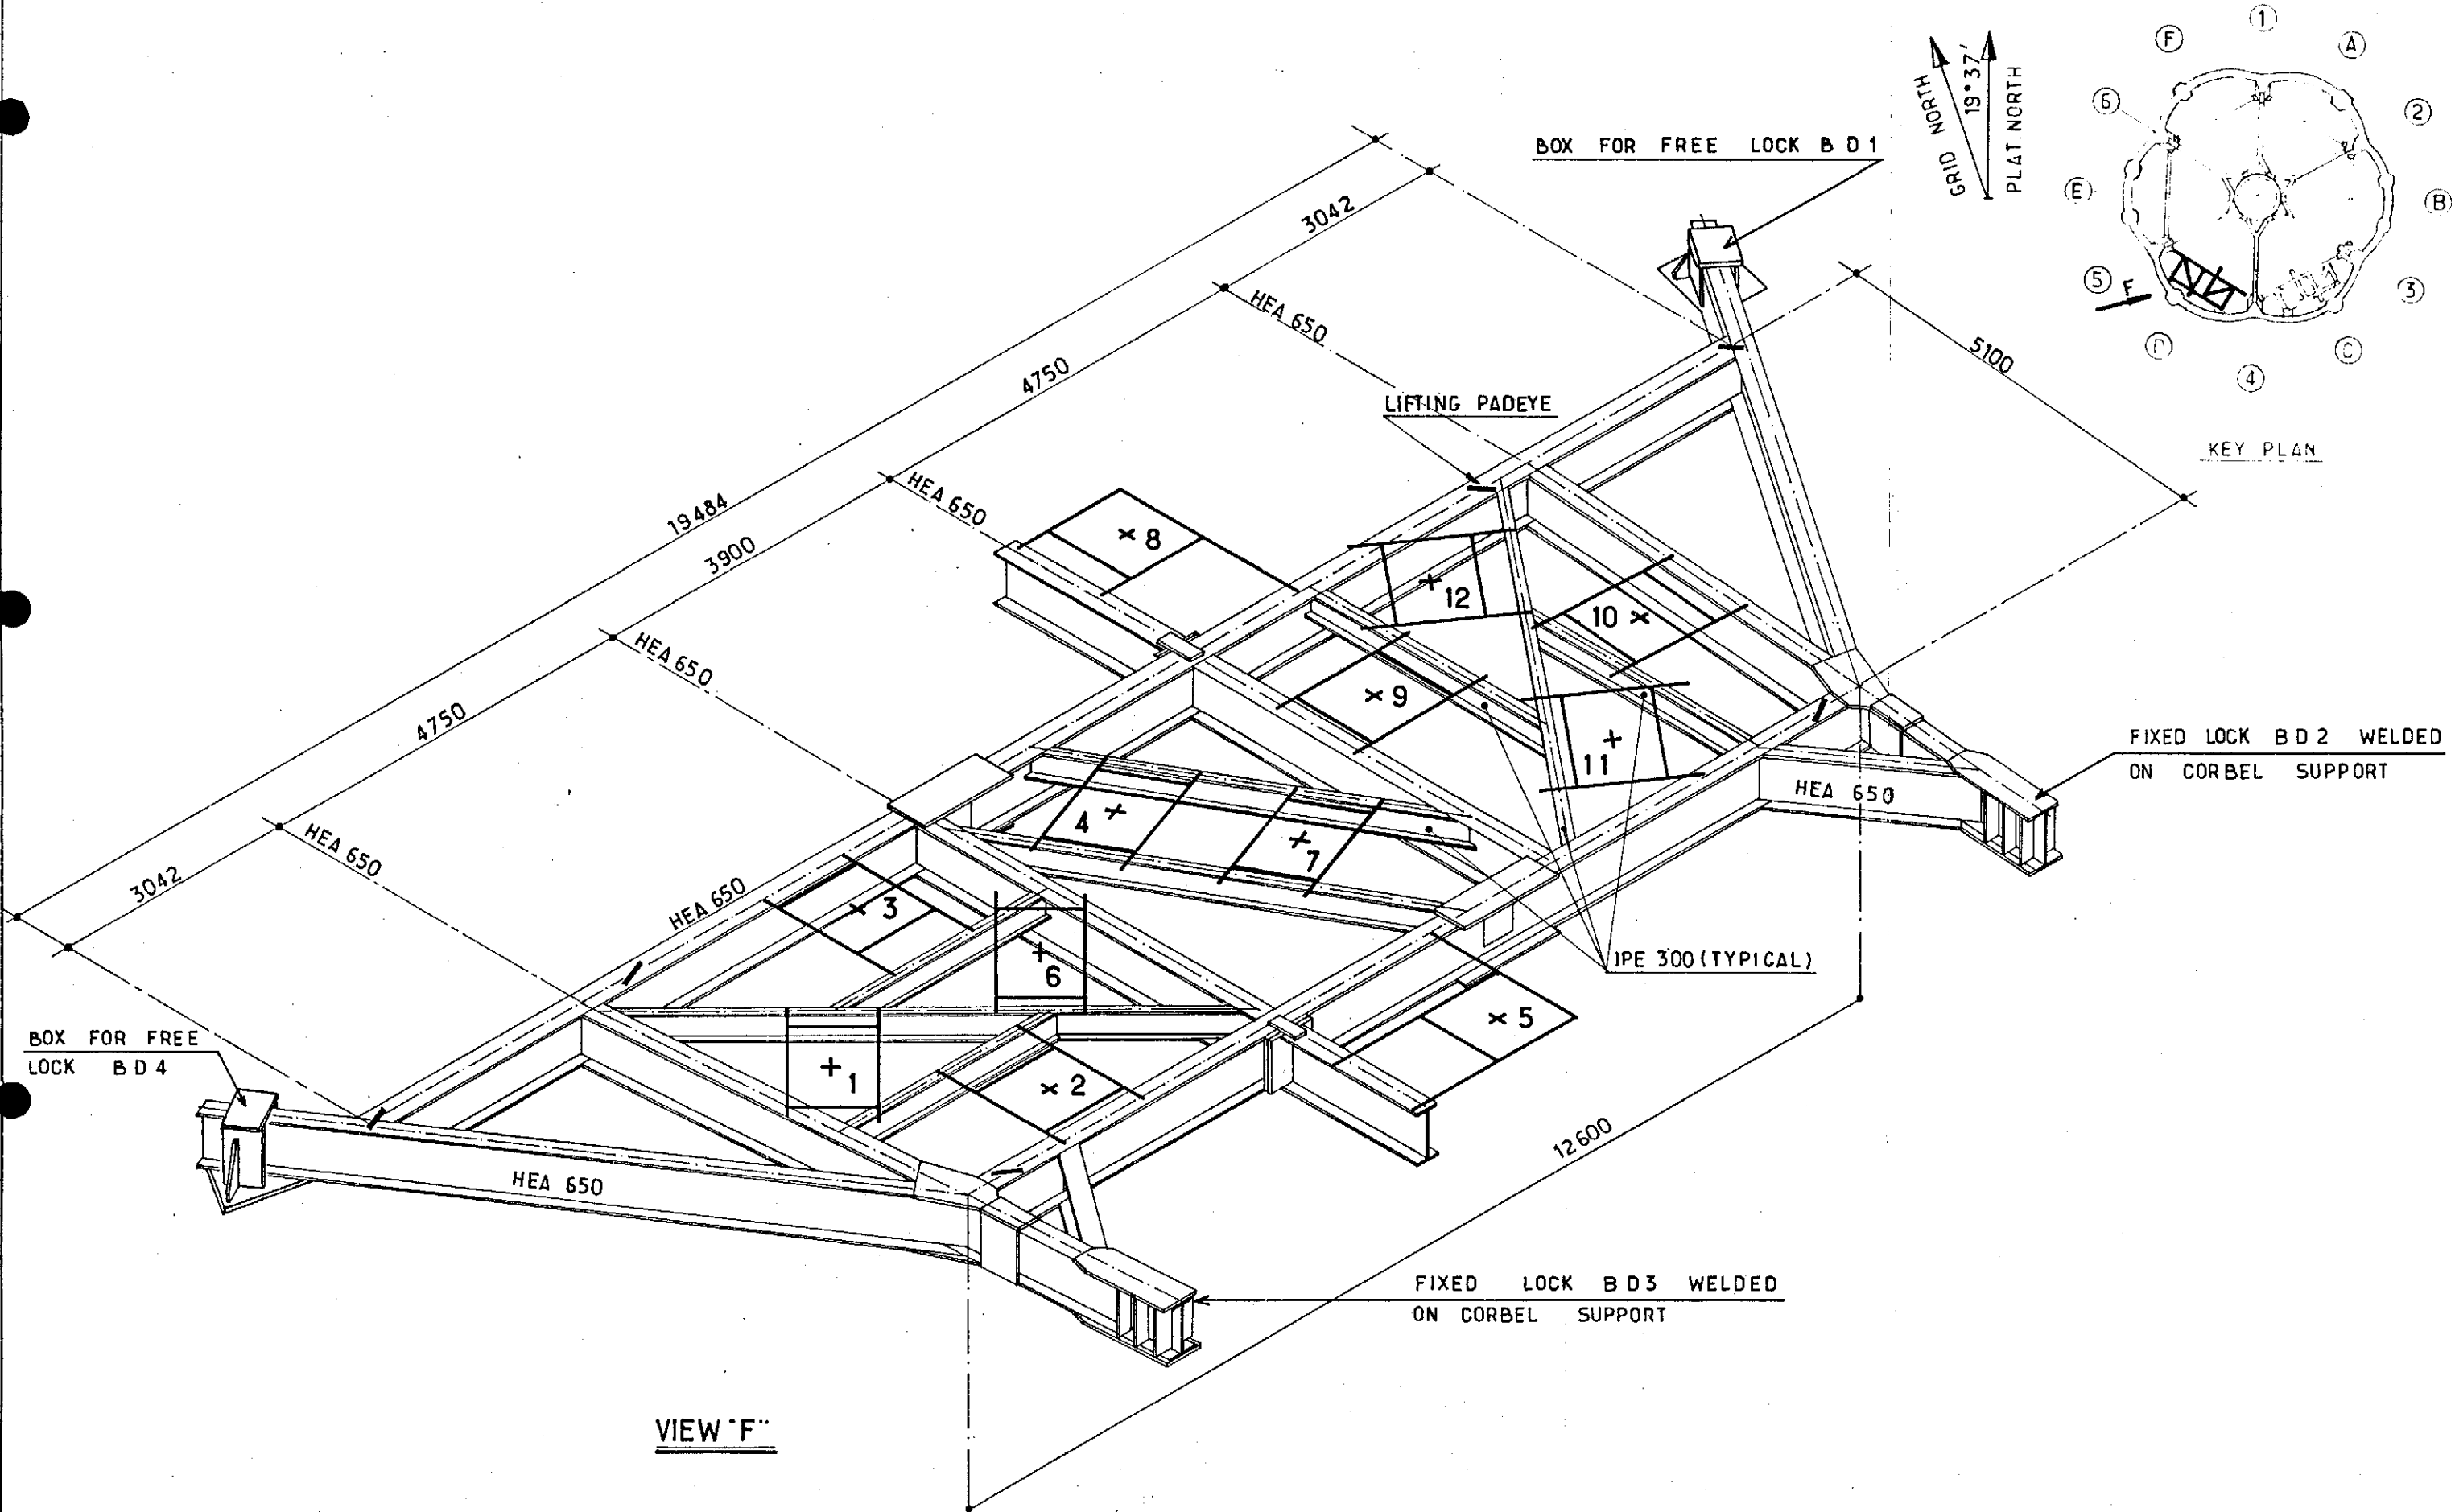

LEVEL B: EL: - 59.835 (+ 36.500)

NOTES

FOR SECONDARY FRAME SEE SK FF. 91.36.35.1480./1481 / 1482.
FOR BOX FOR FREE LOCK SEE SK FF. 91.36.35.1483. TO FF. 91.36.35.1486.

1	12.83	UP DATED	BVH	l/c
Rev.	Date	DESCRIPTION	by	app
Contractor JVD 1029.40.149				

elf
aquitaine
norge a/s
p.o. box 168
4001 Stavanger



FRIGG FIELD


Job no.	Installation CDP 1	System UNDERWATER
Scale 1/75°	GENERAL VIEW OF GUIDE FRAME CELL "D" - LEVEL "B"	
Dwgr. no.	FF. 91.36.35.1479.	1

CDP 1 AS BUILT DRAWINGS

REFERENCE DRAWING LIST FOR: CONDUCTOR GUIDE FRAME

[illegible][illegible]


				 elf	Job no.	Installation CDP 1	System UNDERWATER		
					Scale				
Rev.	Date	DESCRIPTION	by	app.	 elf	Dwgr. no.		Rev.	Sheet
Contractor J/D 1029-40-42						FF — — 1479			/
elf aquitaine norge a/s p.o.box 168 4001 Stavanger					FRIGG FIELD				

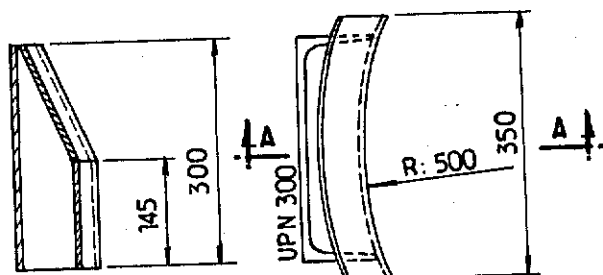


SECTION A . A

TYPICAL PLAN VIEW

CGRD NORTH
19° 37'
PLAT. NORTH

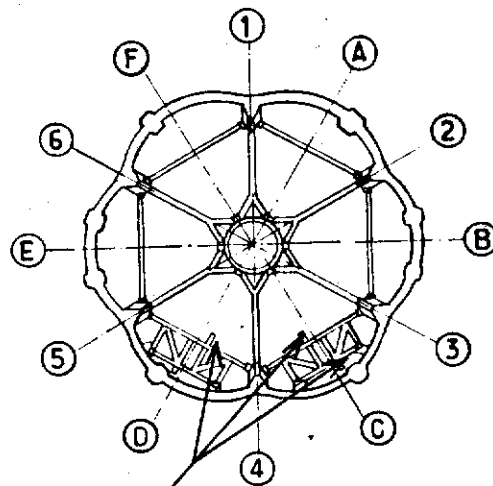

KEY PLAN

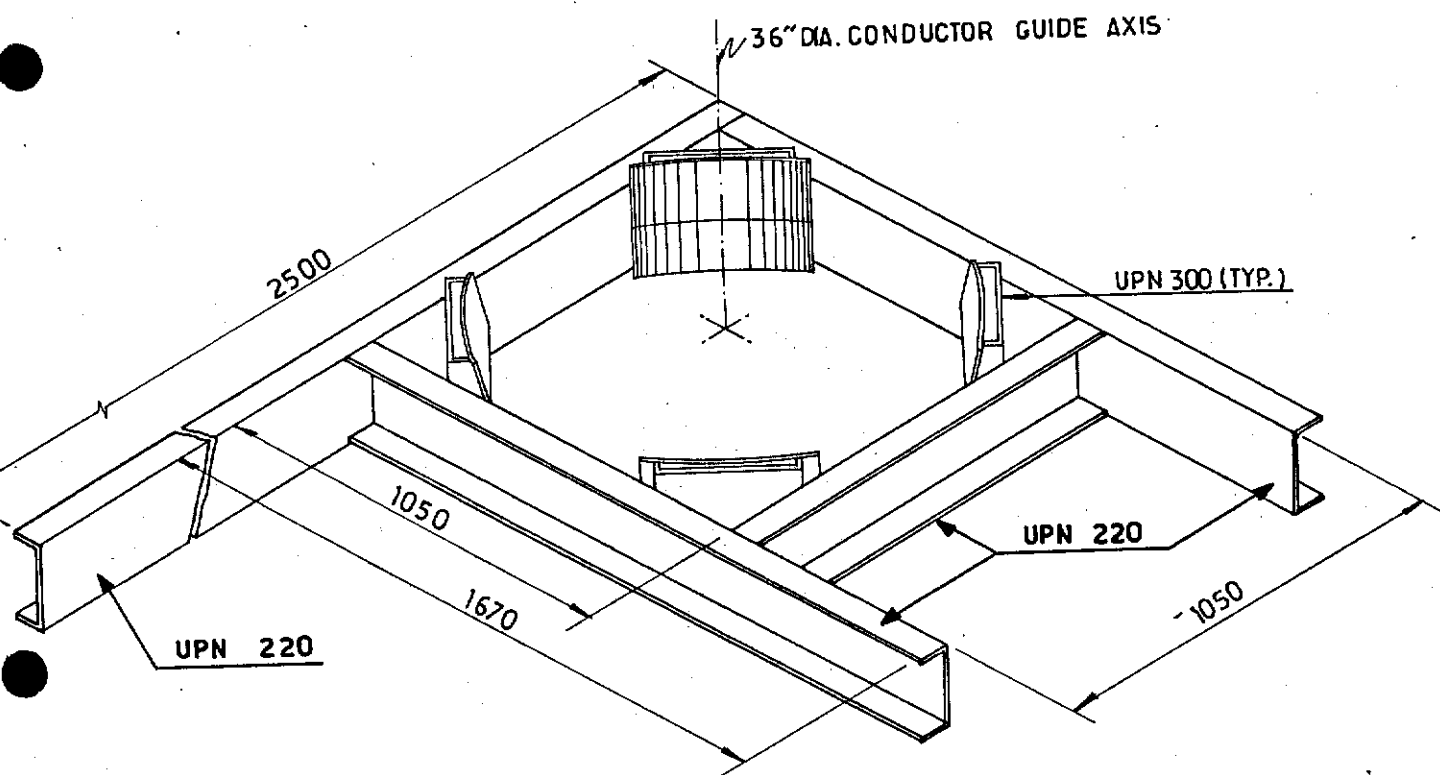

NOTES

FOR LOCATION SEE SK FF. 91.36.35 .1478. AND FF. 91. 36. 35 .1479.

1 IDENTICAL ITEMS AS DRAWN FOR CONDUCTORS "17"

2 SYMMETRICAL ITEM FOR CONDUCTORS "23" AND "8"


					elf aquitaine norge a/s p.o.box 168 4001 Stavanger	 elf FRIGG FIELD	Job no.	Installation CDP 1	System UNDERWATER	
1	12.83	UP DATED	BYH JLC	Scale 1/20°			SECONDARY FRAME - TYPE 1 - LEVEL "B" CELL "C" AND "D"			
Rev.	Date	DESCRIPTION	by	app.			Dwgr. no.	FF. 91.36.35. 1480.	Rev 1	Sheet /
Contractor JVD.1029_40.150										

CDP 1 AS BUILT DRAWINGS


REFERENCE DRAWING LIST FOR: CONDUCTOR GUIDE FRAME

[illegible][illegible]



					elf aquitaine norge a/s p.o.box 168 4001 Stavanger	 elf	Job no.	Installation CDP 1	System UNDERWATER		
							Scale				
Rev.	Date	DESCRIPTION	by	app.			Dwgr. no.	1480		Rev.	Sheet
Contractor					FRIGG FIELD		FF				/

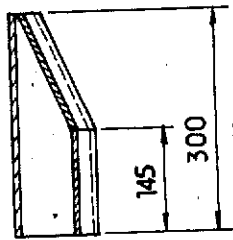


SECTION A-A

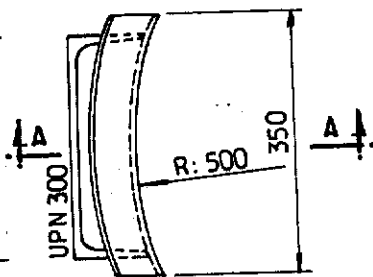

TYPICAL PLAN VIEW

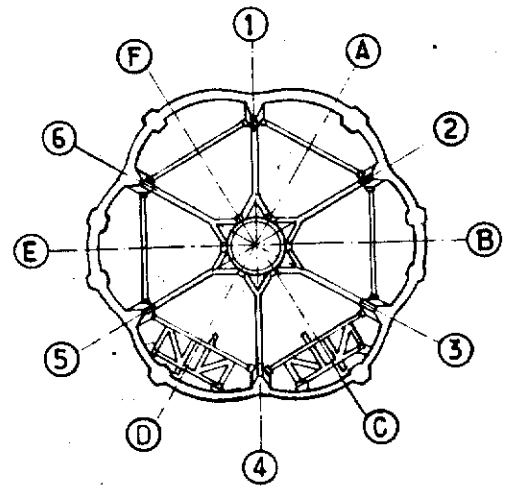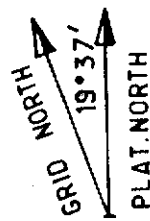

KEY PLAN

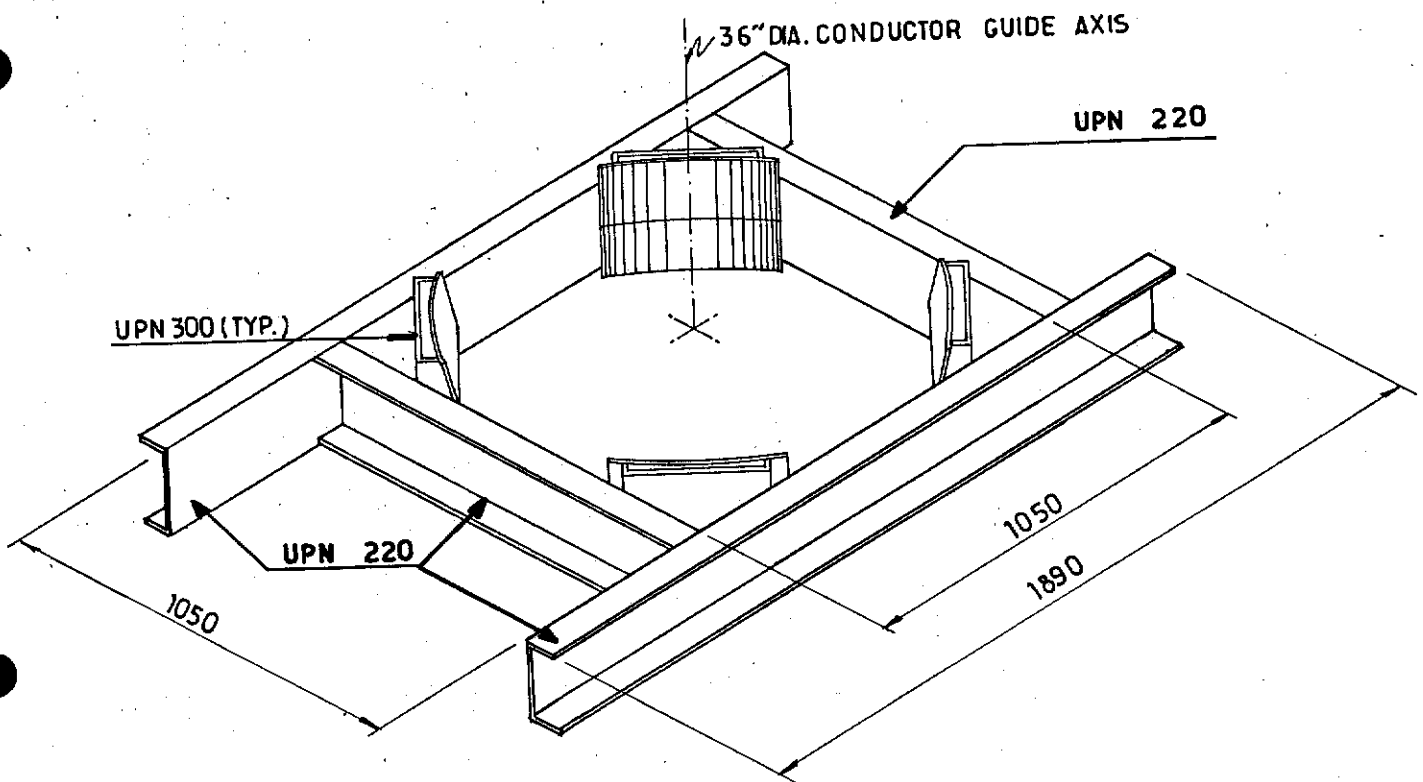

NOTES

FOR LOCATION SEE SK FF. 91.36.35.1478. AND FF. 91.36.35.1479.
 19 IDENTICAL ITEMS AS DRAWN FOR CONDUCTORS "1, 2, 3, 4, 6, 7, 9, 10, 11, 12, 13, 14, 15, 16, 18, 19, 21, 22, 24."

15 IDENTICAL WELLS AS

21, 22, 24 ."


						 elf	Job no.	Installation CDP 1	System UNDERWATER	
1	12.83	UP DATED	BVH	JLC	p.o. box 168		Scale 1/20"	SECONDARY FRAME - TYPE 2 - LEVEL "B"	CELL "C" AND "D"	
Rev.	Date	DESCRIPTION	by	app.	4001 Stavanger		Dwgr. no.	FF. 91.36.35.1481.	Rev 1	Sheet /
Contractor JVD 1029_40_151							FRIGG FIELD			

CDP 1 AS BUILT DRAWINGS

REFERENCE DRAWING LIST FOR: CONDUCTOR GUIDE FRAME

[illegible][illegible]


				elf aquitaine norge a/s		 elf		Job no.		Installation CDP 1		System UNDERWATER	
				p.o.box 168				Scale					
Rev.	Date	DESCRIPTION	by	app.	4001 Stavanger		Dwgr. no.		FF		Rev.		Sheet
Contractor					FRIGG FIELD				1481				

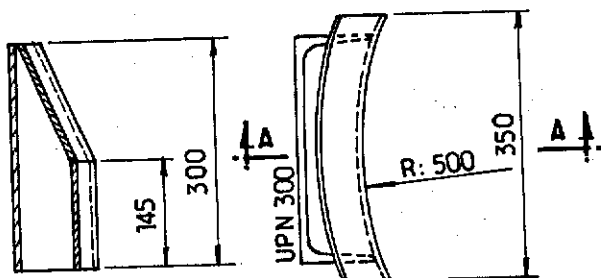


SECTION A.A

TYPICAL PLAN VIEW

GRID NORTH
19°37'
PLAT. NORTH

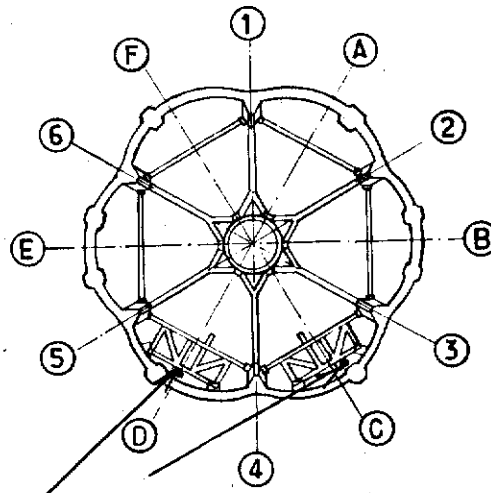

KEY PLAN

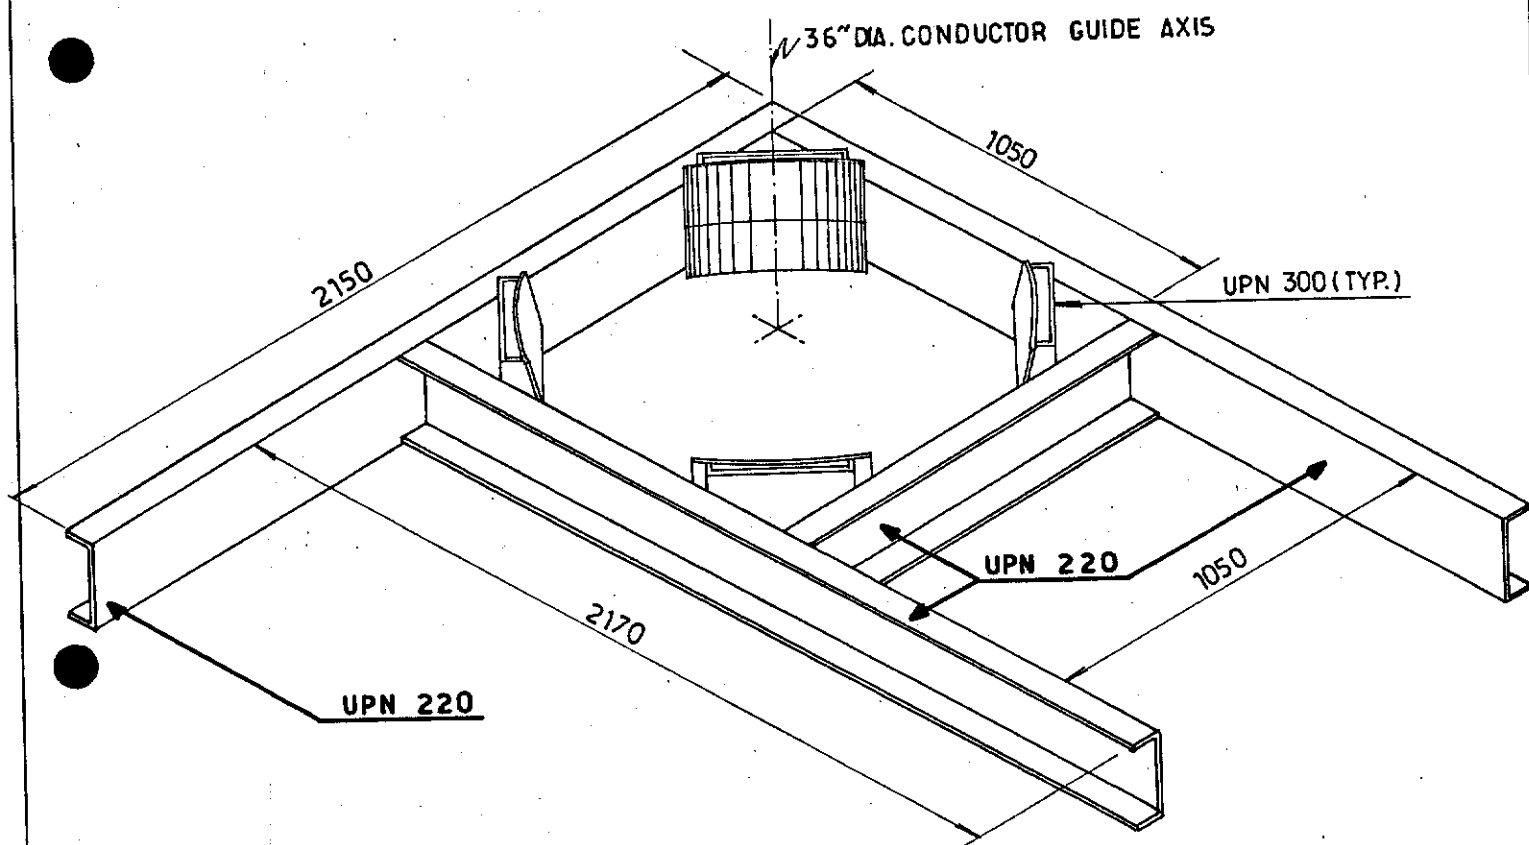


NOTES


FOR LOCATION SEE SK FF. 91.36.35.1478. AND FF. 91.36.35.1479.
2 IDENTICAL ITEMS AS DRAWN FOR CONDUCTORS "20" AND "5"

				elf aquitaine norge a/s		Job no.	Installation CDP 1	System UNDERWATER
1	12.83	UP DATED	BVH	p.o. box 168		Scale 1/20°	SECONDARY FRAME LEVEL "B" CELL "C" AND "D"	TYPE 3 -
Rev.	Date	DESCRIPTION	by	app.		Dwgr. no.	FF. 91.36.35.1482.	Rev. 1
Contractor JVD 1029.40.152				4001 Stavanger		FRIGG FIELD		Sheet

GRID NORTH
19° 37'
PLAT. NORTH

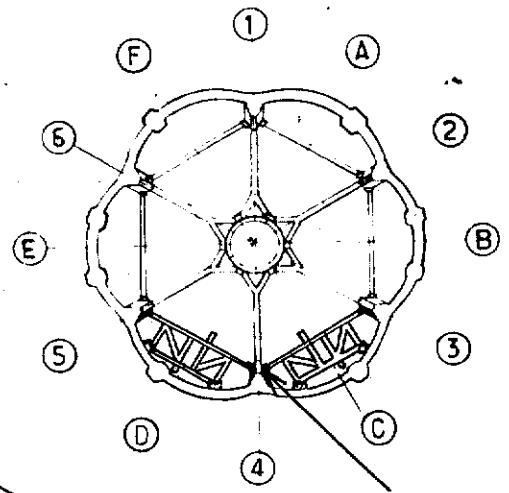

KEY PLAN

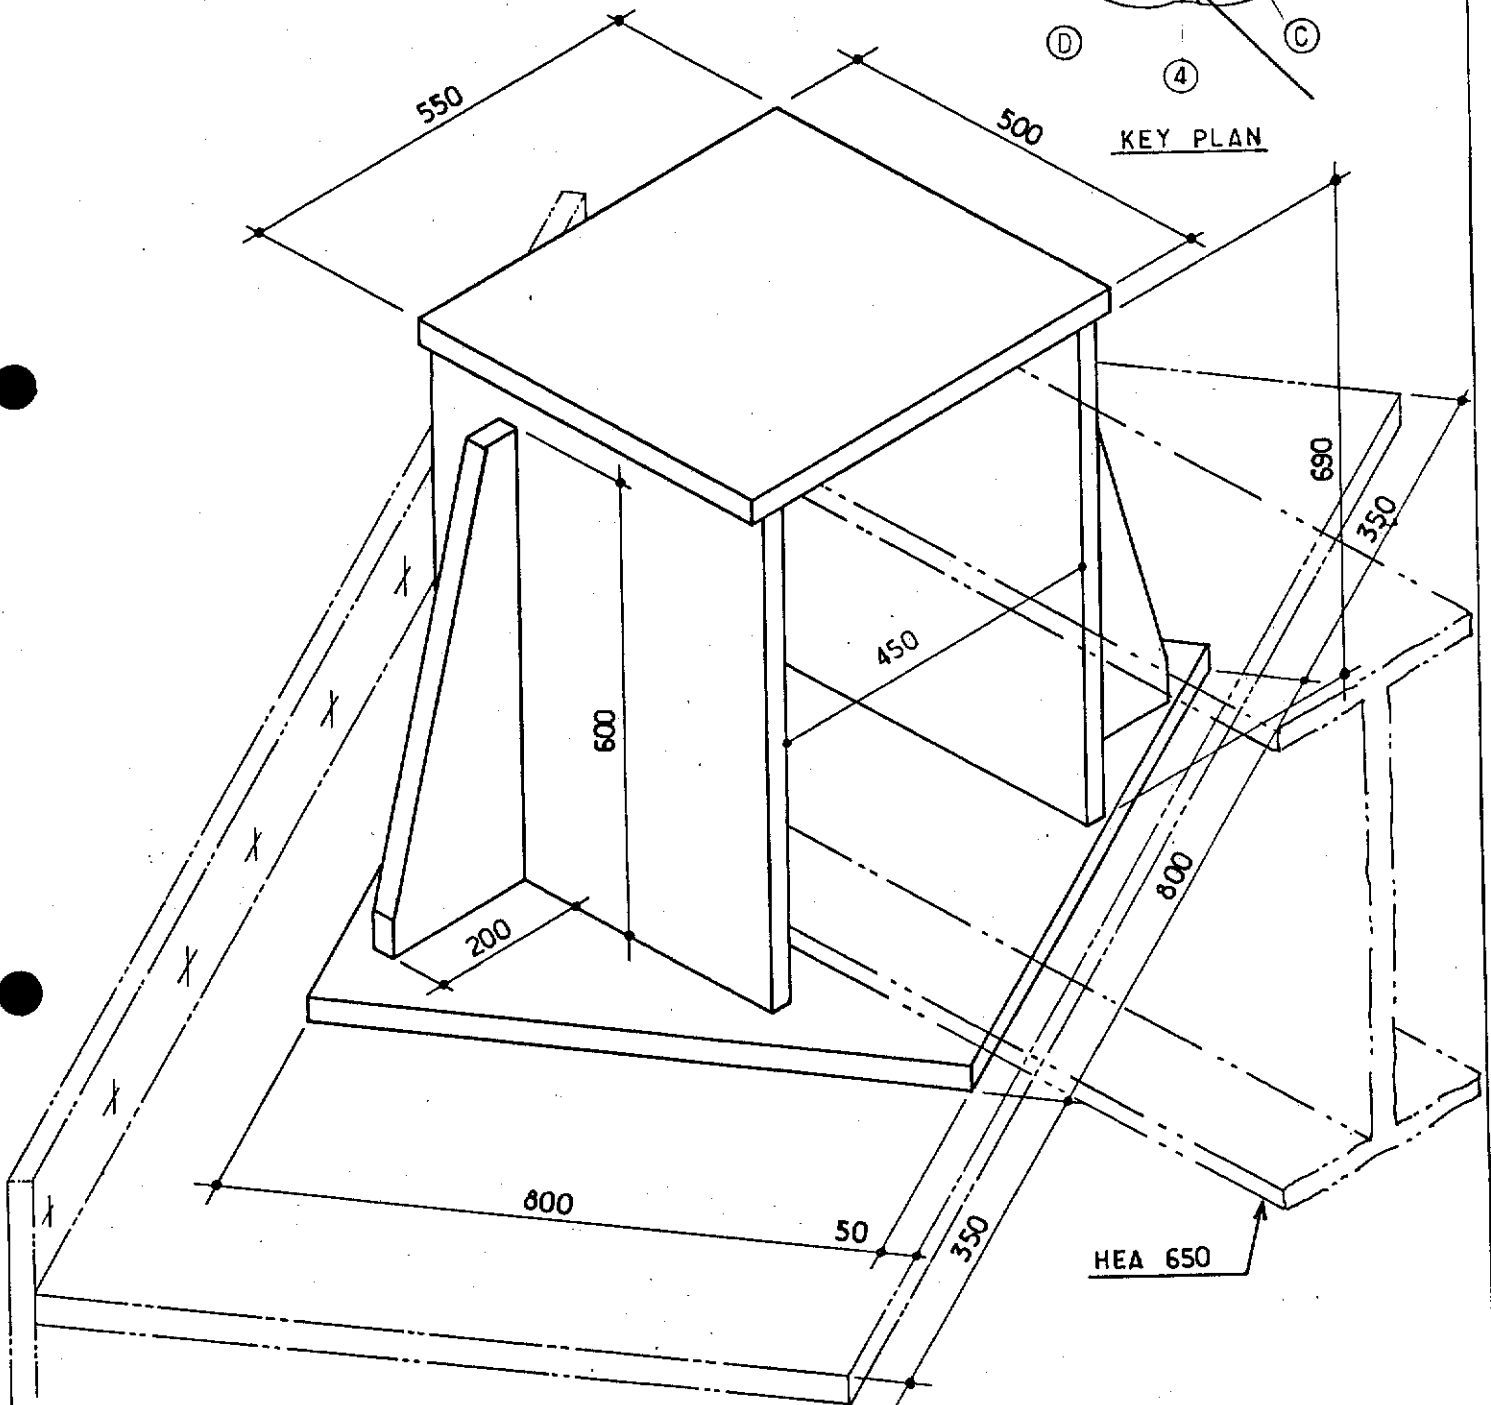

NOTES

FOR LOCATION SEE SK FF 91 36 35 1478
ALL PLATES 30mm thk.

LEVEL B: EL: - 59.835 MLW (+36.500)

Rev.	Date	DESCRIPTION	by	app.
1	12.83	UP DATED	BYH	LLC
Contractor JVD 1029. 40.153.				

elf
aquitaine
norge a/s
p.o.box 168
4001 Stavanger



FRIGG FIELD

Job no.	Installation CDP 1	System UNDERWATER
Scale 1/10°	BOX FOR FREE LOCK B C 1 LEVEL B	
Dwgr. no.	FF. 91. 36. 35. 1483	1



CDP 1 AS BUILT DRAWINGS

REFERENCE DRAWING LIST FOR: CONDUCTOR GUIDE FRAMES

[illegible][illegible]

					elf aquitaine norge a/s p.o.box 168 4001 Stavanger	 elf	Job no.	Installation CDP 1	System UNDERWATER		
							Scale				
Rev.	Date	DESCRIPTION	by	app.			Dwgr. no.	FF _____ 1483		Rev.	Sheet /
Contractor					FRIGG FIELD						

GRID NORTH
19° 37'
PLAT. NORTH

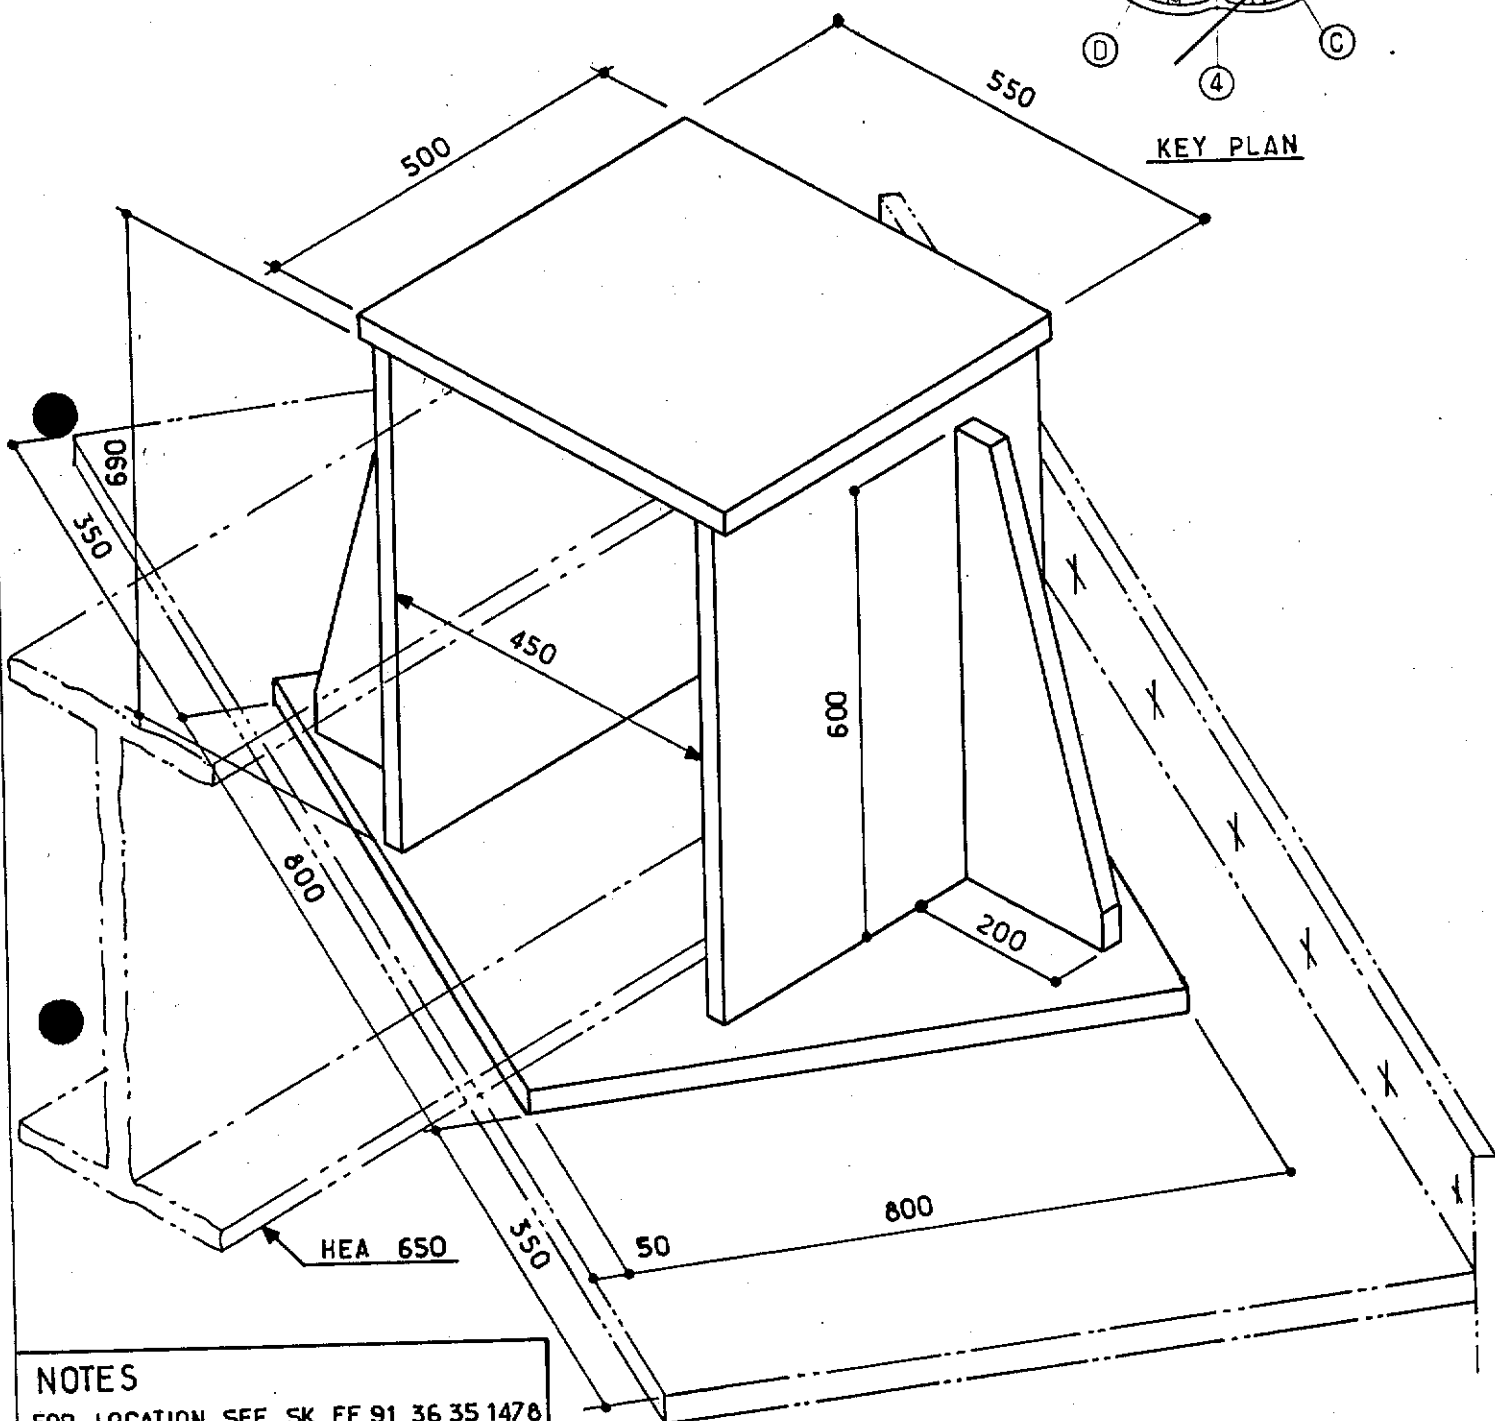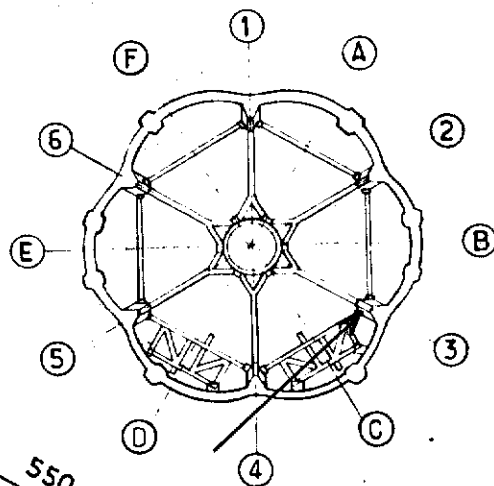

NOTES

FOR LOCATION SEE SK FF 91 36 35 1478
ALL PLATES 30 mm thk.

LEVEL B . EL:- 59.835 MLW (+ 36.500)

				elf aquitaine norge a/s p.o.box 168 400.1 Stavanger		 elf		Job no.		Installation CDP 1		System UNDERWATER			
1		12.83		UP DATED		BVH/Hc		Scale 1/10°		BOX FOR FREE LOCK BC 4 CELL C LEVEL B					
Rev.		Date		DESCRIPTION		by app.		Dwgr. no.		FF 91.36.35.1484		Rev. 1		Sheet /	
Contractor JVD 1029.40.154						400.1 Stavanger		FRIGG FIELD							



CDP 1 AS BUILT DRAWINGS

REFERENCE DRAWING LIST FOR: CONDUCTOR GUIDE FRAMES

[illegible][illegible]

					elf aquitaine norge a/s p.o.box 168 4001 Stavanger	 elf	Job no.	Installation CDP 1	System UNDERWATER		
							Scale				
Rev.	Date	DESCRIPTION	by	app.	4001 Stavanger	FRIGG FIELD	Dwgr. no.	1484		Rev.	Sheet
Contractor								FF			

DIRTY NORTH
19° 37'
PLAT NORTH

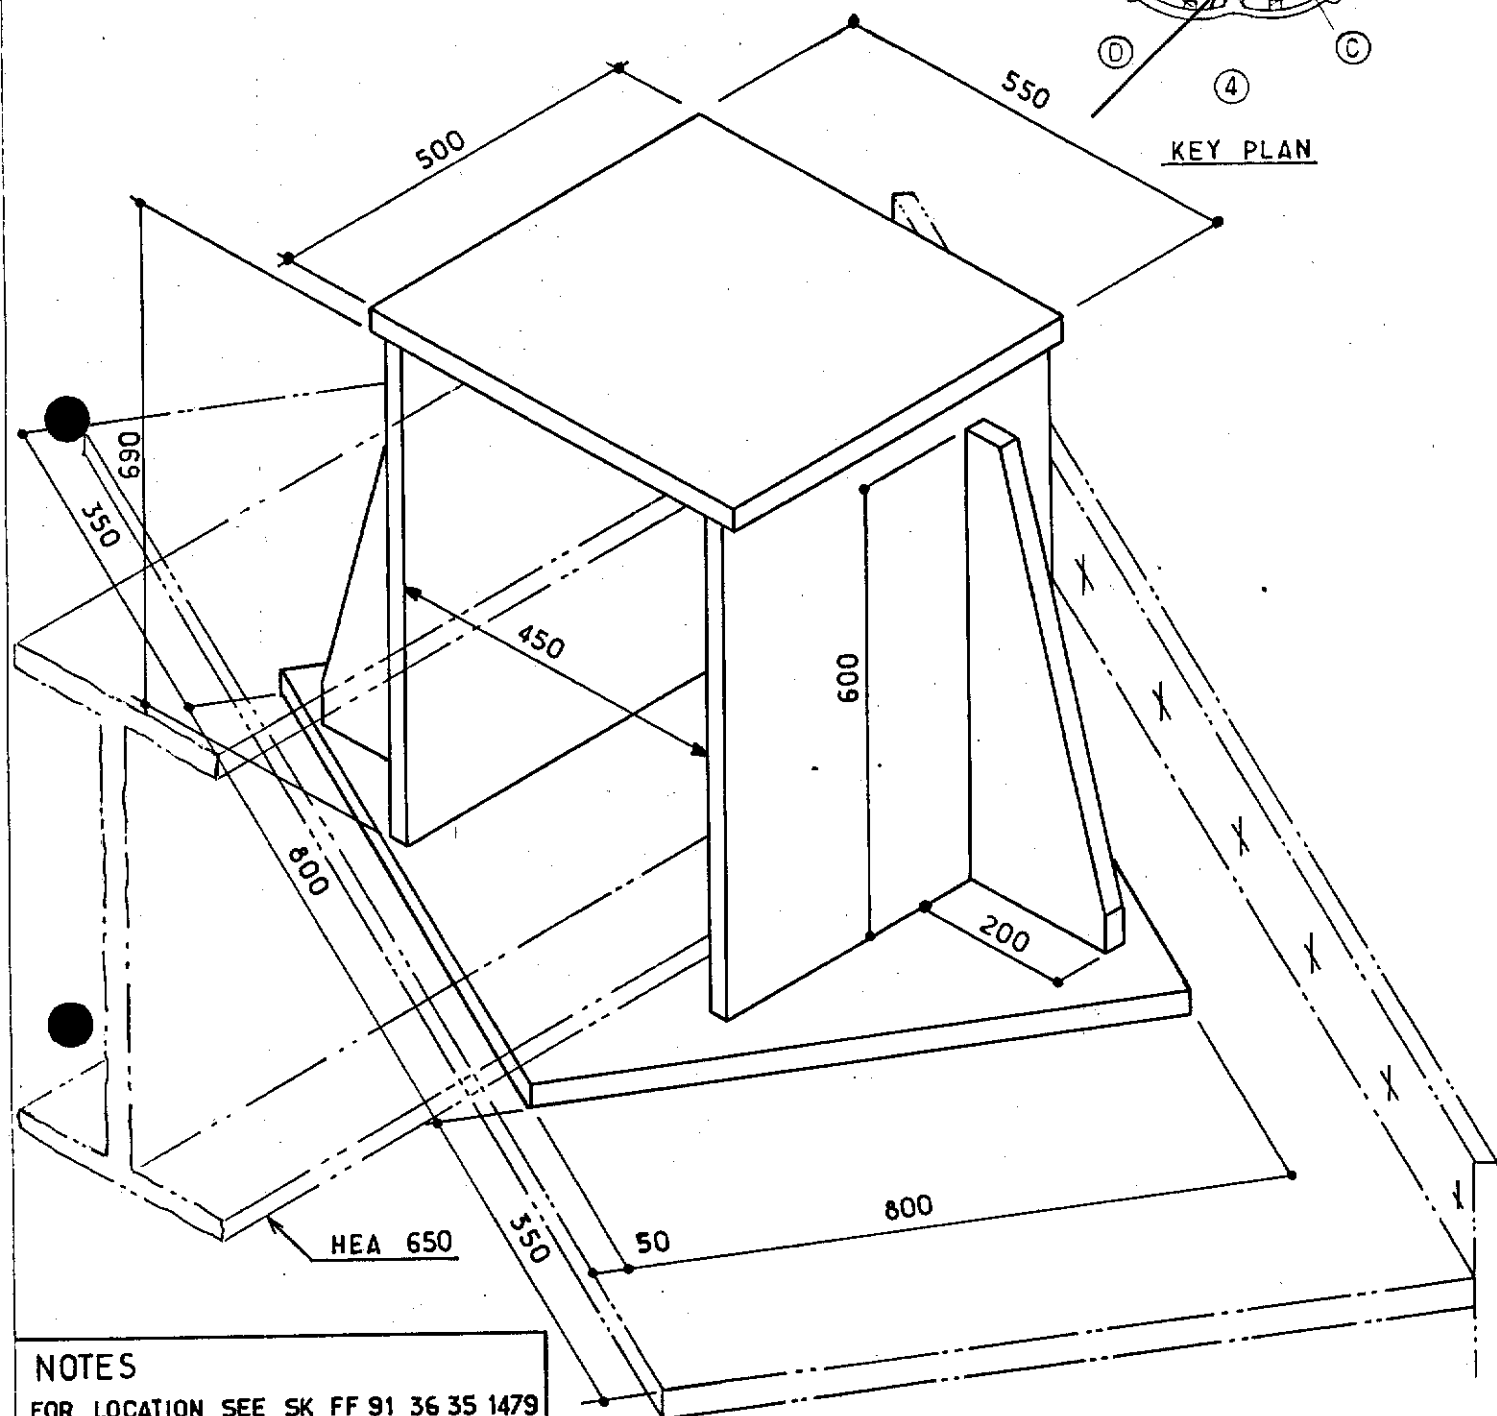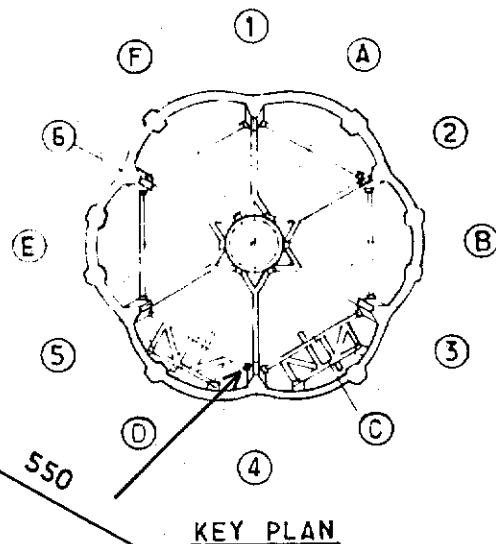

NOTES

FOR LOCATION SEE SK FF 91 36 35 1479
ALL PLATES 30 mm thk.

LEVEL B . EL: - 59.835 MLW (+ 36.500)

				elf aquitaine norge a/s p.o.box 168 4001 Stavanger	 elf	Job no.	Installation CDP 1	System UNDERWATER
1	12.83	UP DATED	BVH/lc			Scale 1/10°	BOX FOR FREE LOCK BD1	
Rev.	Date	DESCRIPTION	by	app.		Dwgr. no	CELL D	LEVEL B
Contractor JVD 1029.40.155				FRIGG FIELD		FF 91-36-35-1485	1	


CDP 1 AS BUILT DRAWINGS

REFERENCE DRAWING LIST FOR: CONDUCTOR GUIDE FRAMES


[illegible][illegible]

					elf aquitaine norge a/s p.o.box 168 4001 Stavanger	 elf	Job no.	Installation CDP 1	System UNDERWATER		
							Scale				
Rev.	Date	DESCRIPTION	by	app.			Dwgr. no.	FF ___ ___ 1485		Rev.	Sheet /
Contractor						FRIGG FIELD					

GRID NORTH
19° 37'
PLAT. NORTH

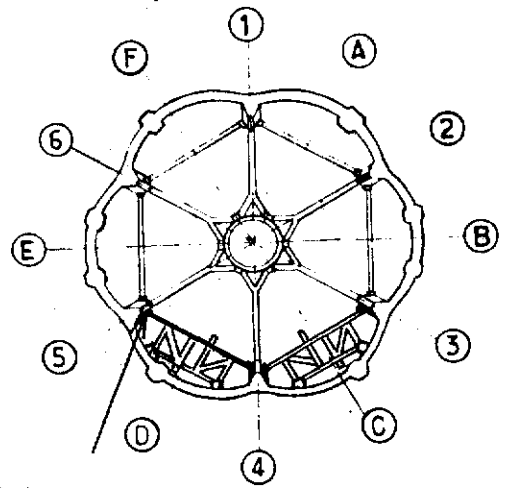

KEY PLAN

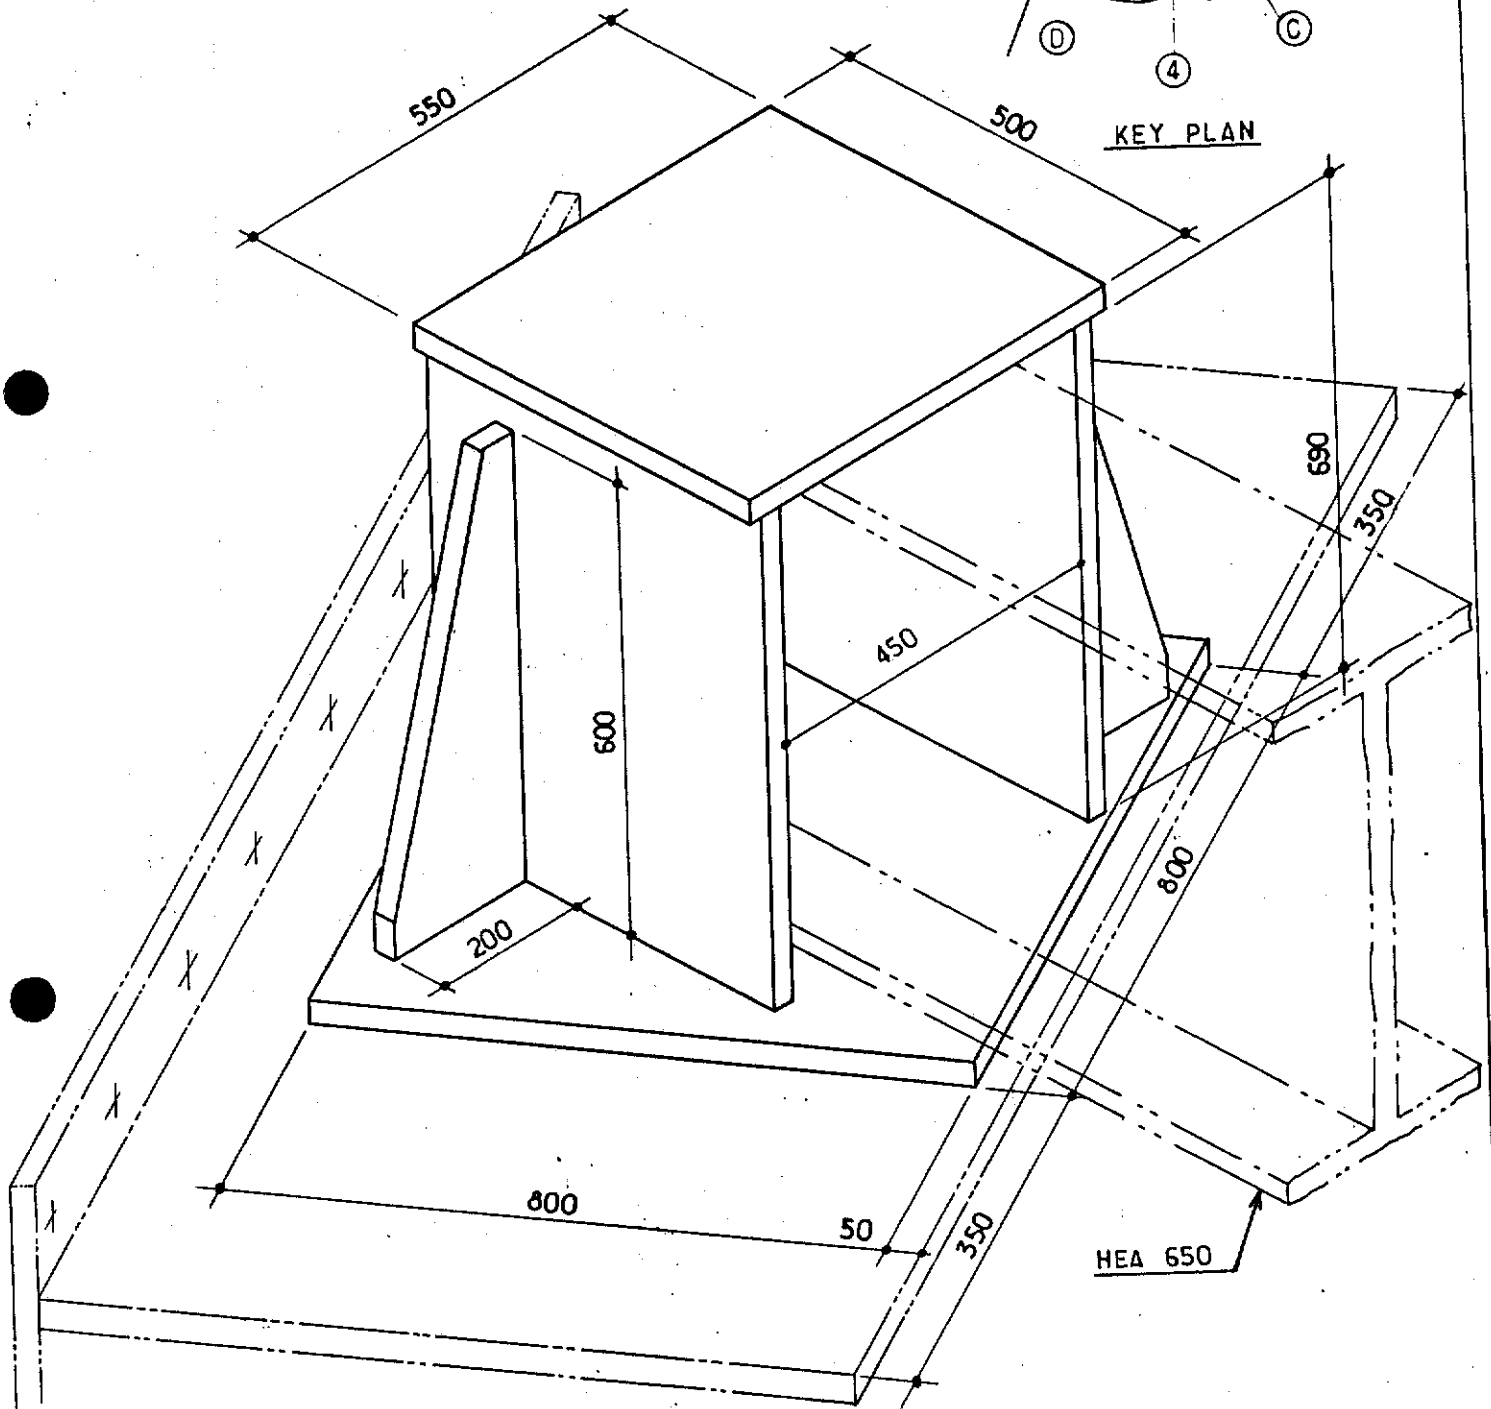

NOTES

FOR LOCATION SEE SK FF 91 36 35 1479
ALL PLATES 30 mm thk.

LEVEL B: EL: -59.835 MLW (+36.500)


Job no.		Installation CDP 1		System UNDERWATER	
Scale 1/10°		BOX FOR FREE LOCK BD 4		LEVEL B	
Dwgr. no.		FF. 91. 36. 35. 1486		Rev 1	Sheet /
Contractor JVD 1029. 40. 156.		elf aquitaine norge a/s p.o. box 168 4001 Stavanger		FRIGG FIELD	

CDP 1 AS BUILT DRAWINGS

REFERENCE DRAWING LIST FOR: CONDUCTOR GUIDE FRAMES

[illegible]

					elf aquitaine norge a/s p.o.box 168 4001 Stavanger	 elf	Job no.	Installation CDP 1	System UNDERWATER	
							Scale			
Rev.	Date	DESCRIPTION	by	app.			Dwgr. no.		Rev.	Sheet
Contractor					FRIGG FIELD	FF	1486			

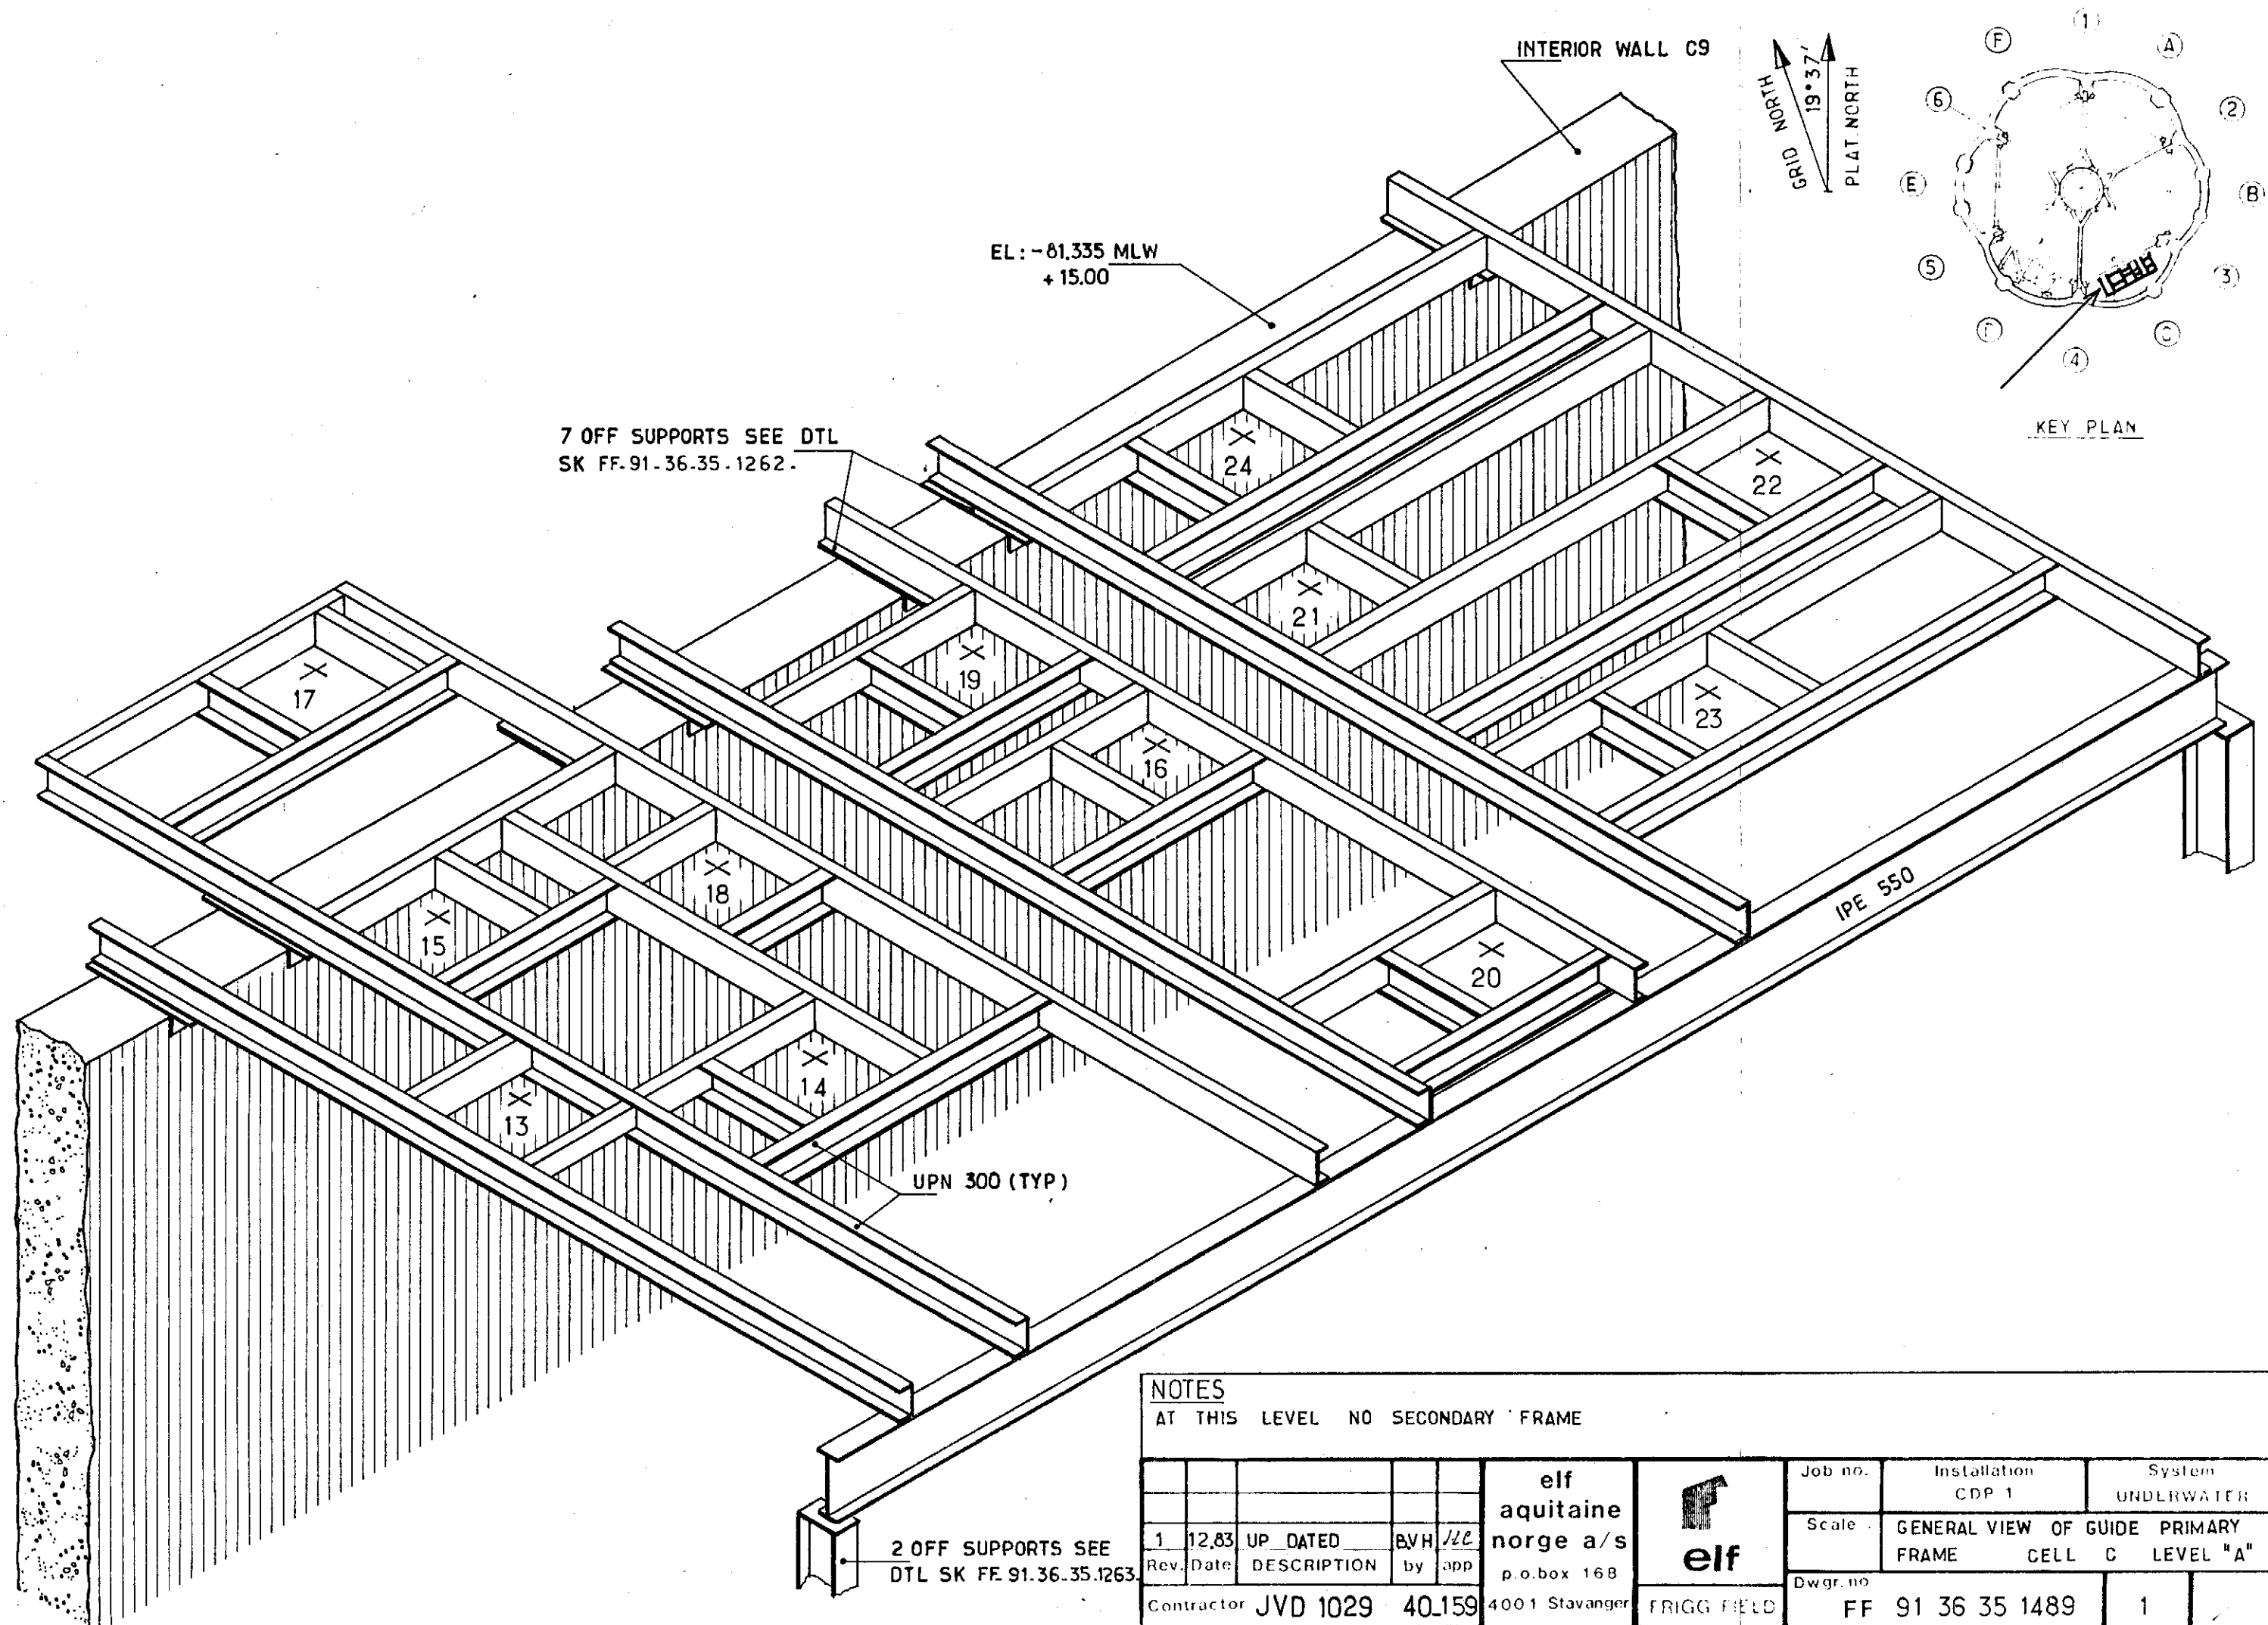

NOTES

AT THIS LEVEL NO SECONDARY FRAME

				elf aquitaine norge a/s		 elf	Job no.	Installation CDP 1	System UNDERWATER
1	12.83	UP DATED	BVH	ML	p.o. box 168		Scale	GENERAL VIEW OF GUIDE PRIMARY FRAME CELL C LEVEL "A"	
Rev. Date		DESCRIPTION		by app		Dwgr. no		FF 91 36 35 1489	
Contractor		JVD 1029		40.159		4001 Stavanger		FRIGG FIELD	
								1	

CDP 1 AS BUILT DRAWINGS

REFERENCE DRAWING LIST FOR: CONDUCTOR GUIDE FRAME


[illegible][illegible]

					elf aquitaine norge a/s p.o.box 168 4001 Stavanger	 elf	Job no.	Installation CDP 1	System UNDERWATER	
							Scale			
Rev.	Date	DESCRIPTION	by	app.			Dwgr. no.		Rev.	Sheet
Contractor					4001 Stavanger	FRIGG FIELD	EE	1489		/

EL: -61.335 MLW
+15.000

INTERIOR WALL D 9

GRID NORTH
19°37'
PLAT. NORTH

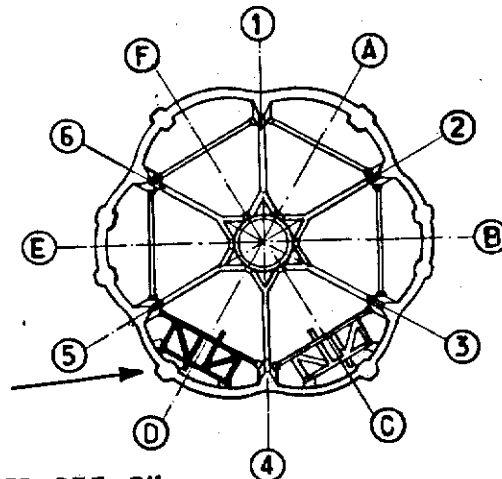


KEY PLAN

7 SUPPORTS SEE SK.
FF 91-36-35-1262

2 SUPPORTS SEE SK.
FF 91-36-35-1263

INTERIOR WALL D 9

LOBED WALL

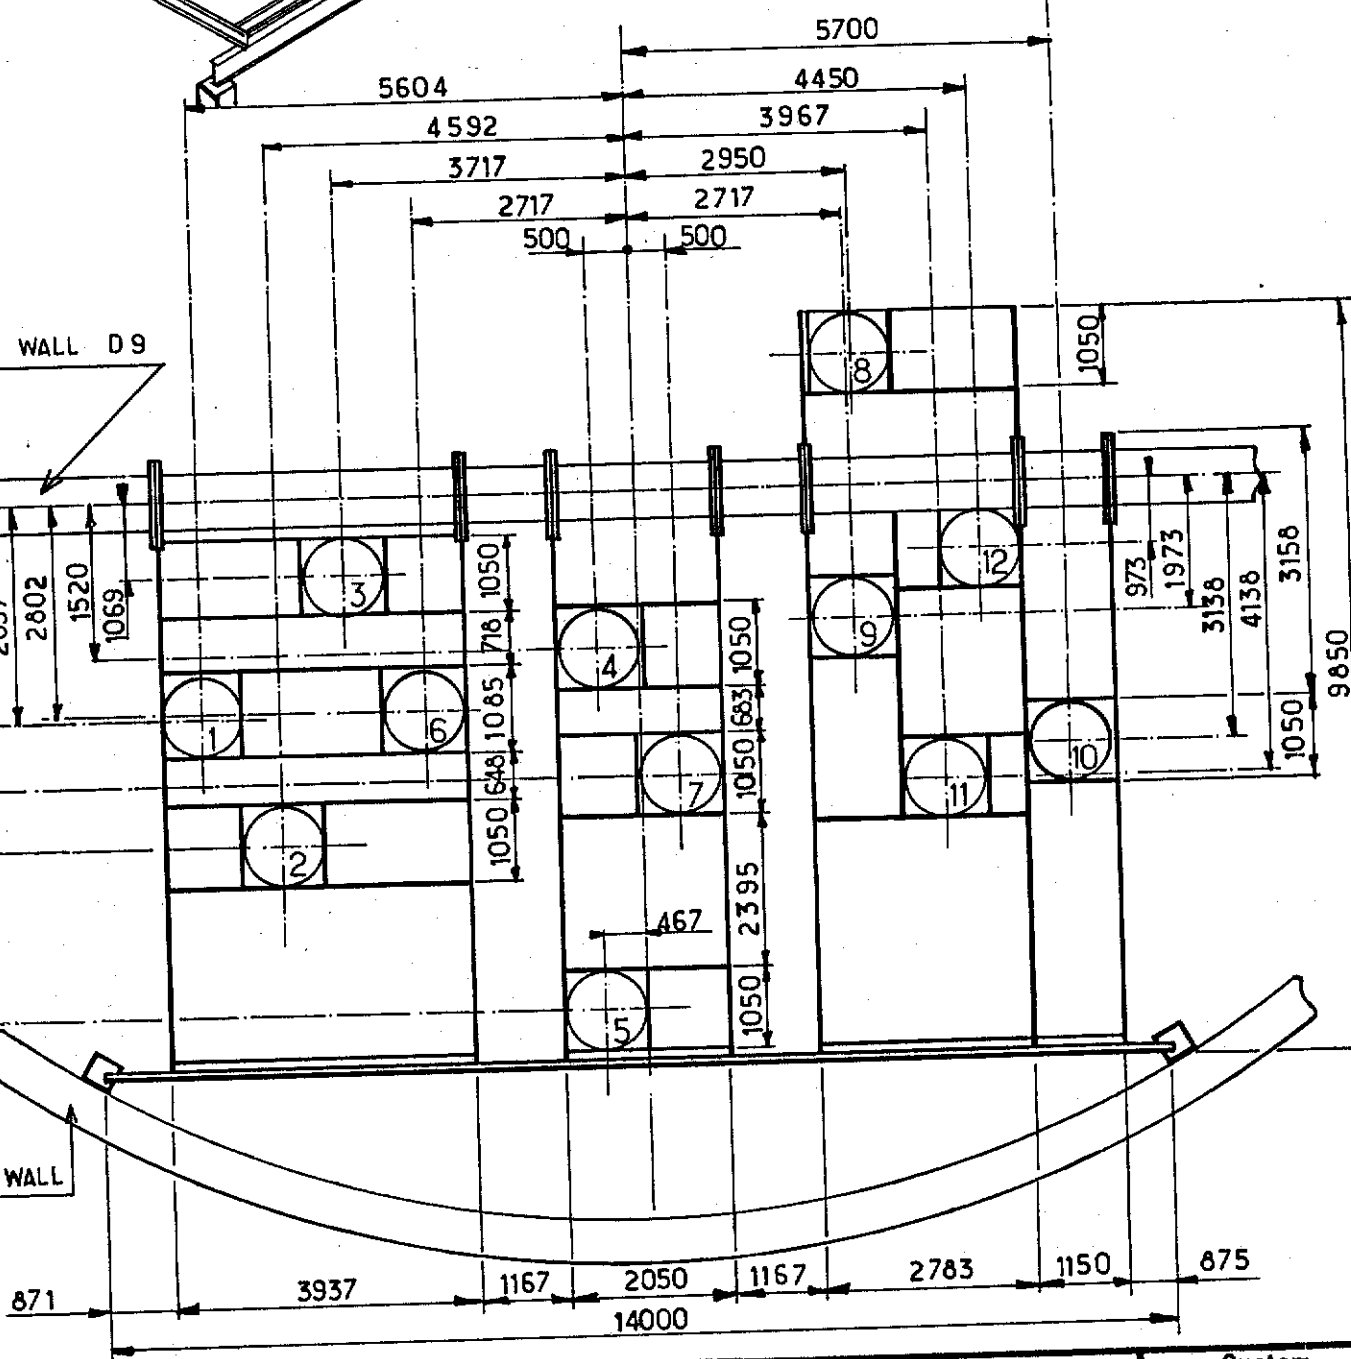


elf aquitaine norge a/s p.o. box 168 4001 Stavanger FRIGG FIELD				Job no. Scale 1:100 Dwgr. no.	Installation CDP 1 GENERAL VIEW OF GUIDE PRIMARY FRAME CELL D LEVEL "A"	System UNDERWATER Rev. 1 Sheet
1	12.83	UP DATED	B.VH / LC			
Rev.	Date	DESCRIPTION	by app.			
Contractor JVD 1029.40.160.						
FF_91_36.35.1490.						

CDP 1 AS BUILT DRAWINGS


REFERENCE DRAWING LIST FOR: CONDUCTOR GUIDE FRAME

[illegible]



					 elf	Job no.	Installation CDP 1	System UNDERWATER	
						Scale			
Rev.	Date	DESCRIPTION	by	app.		Dwgr. no.	FF — — 1490		Rev.
Contractor					elf aquitaine norge a/s p.o.box 168 4001 Stavanger	FRIGG FIELD			

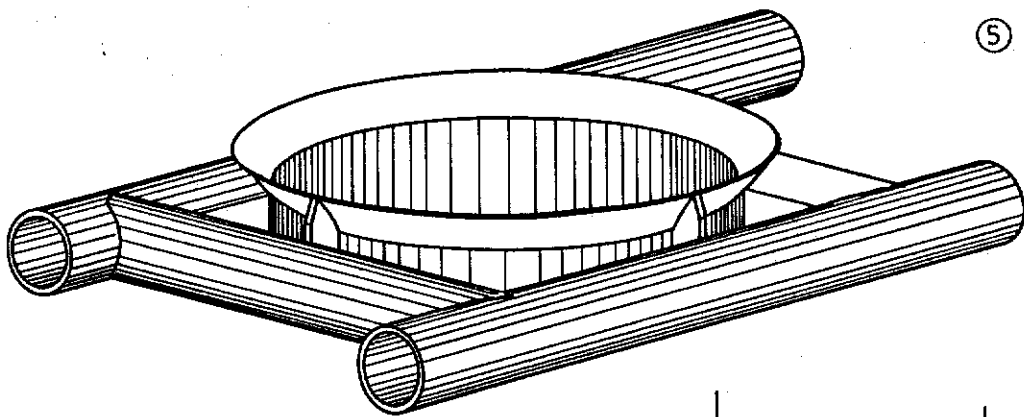

GRID NORTH
19° 37'
PLAT. NORTH

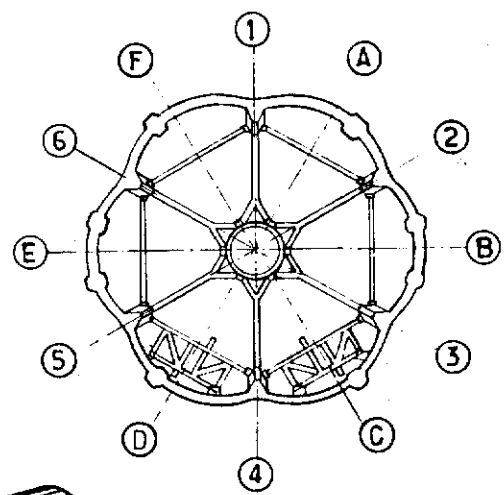

KEY PLAN

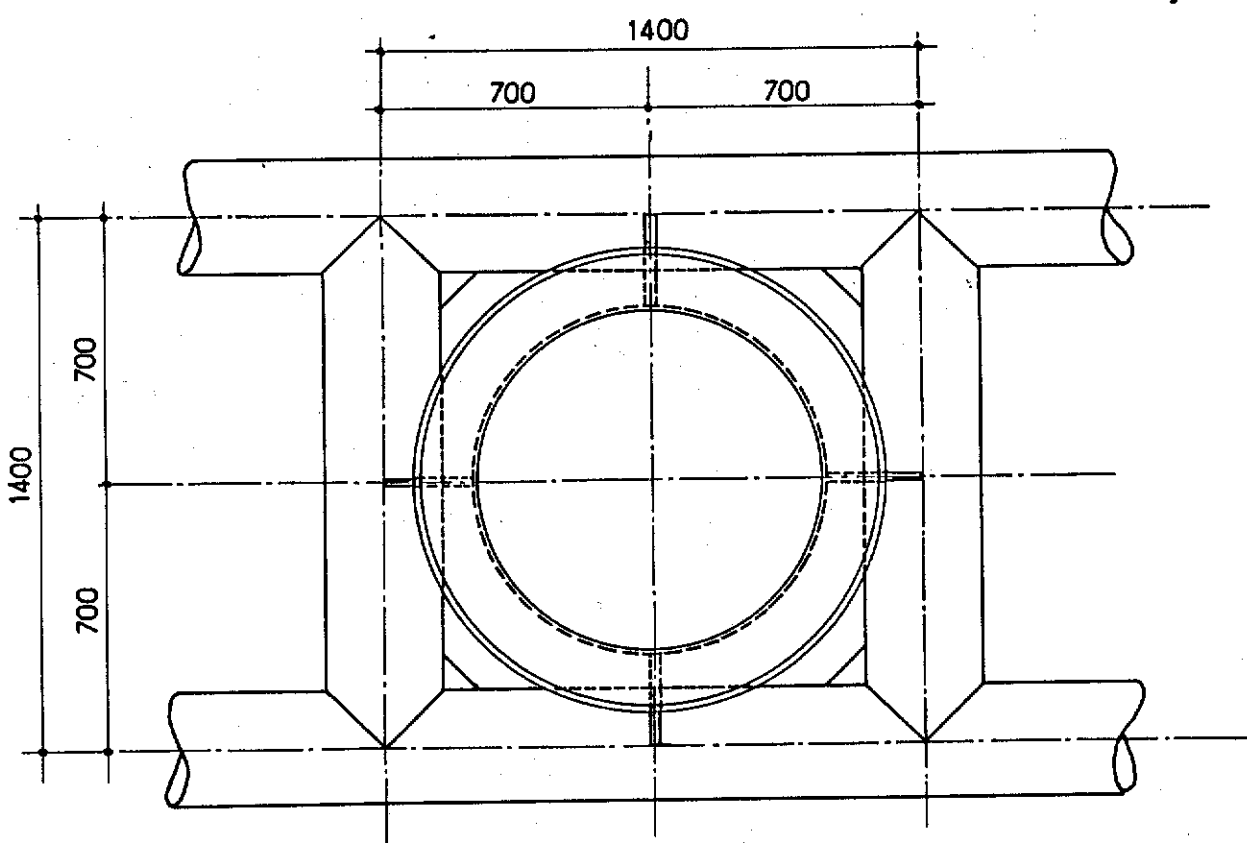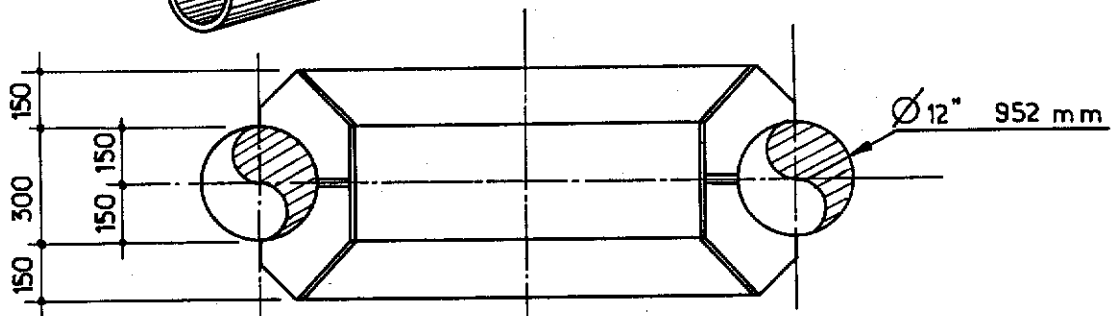

1		12,83		UP DATED		BY H JLC		elf aquitaine norge a/s		Job no.		Installation CDP 1		System UNDERWATER	
Rev.		Date		DESCRIPTION		by app.		p.o.box 168		Scale 1/20°		CONDUCTOR SLEEVE TYPICAL DETAIL			
Contractor		JVD 1029		40_161		4001 Stavanger		FRIGG FIELD		Dwgr. no.		FF 91 36 35 1491		Rev 1	
														Sheet 1	

CDP 1 AS BUILT DRAWINGS

REFERENCE DRAWING LIST FOR: CONDUCTOR GUIDE FRAME


[illegible][illegible]

					elf aquitaine norge a/s p.o.box 168 4001 Stavanger		 elf		Job no.		Installation CDP 1		System UNDERWATER	
							Scale							
Rev.	Date	DESCRIPTION	by	app.	FRIGG FIELD		Dwgr. no. FF		1491		Rev.	Sheet		
Contractor														


MAG. NORTH

19° 37'

PLAT. NORTH

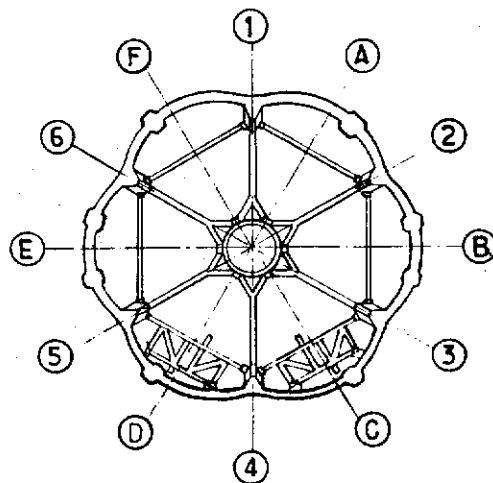

KEY PLAN

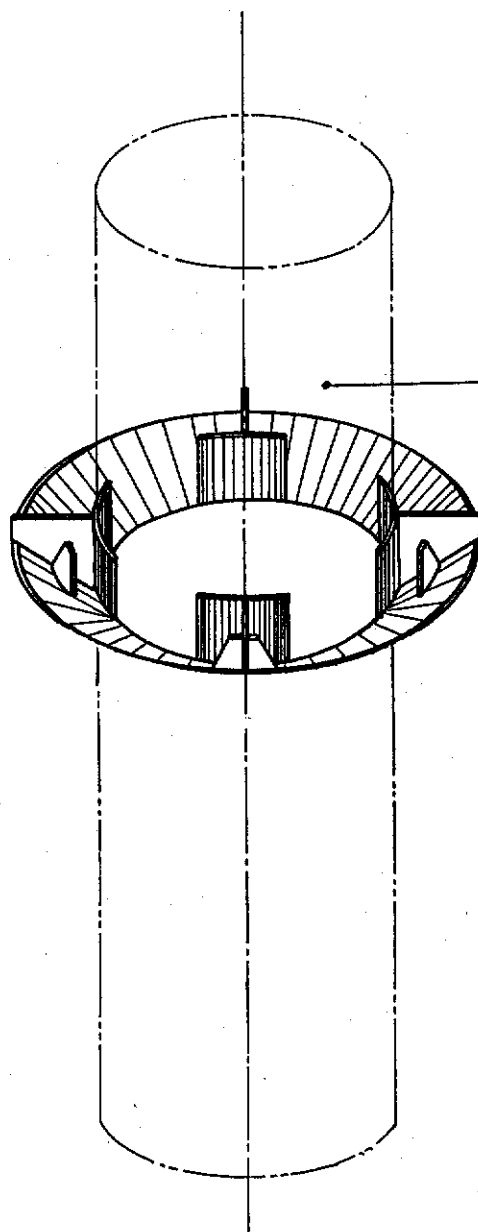

26" DIA CONDUCTOR
 PIPE CASING
 AT LEVEL "G" ONLY

NOTES

SEE ALSO GENERAL COMMENTS CHAPTER IV

1		1283		UP DATED		BVH JLC		elf aquitaine norge a/s		 Job no. Installation CDP 1 System UNDERWATER Scale CONDUCTOR PIPE CASING TYPICAL LOCKING DEVICE Dwgr. no. FF. 91.36.35.1492. Rev 1 Sheet 1	
Rev.		Date		DESCRIPTION		by app.		p.o. box 168			
Contractor		JVD 1029		40_162		4001 Stavanger		FRIGG FIELD			

CDP 1 AS BUILT DRAWINGS

REFERENCE DRAWING LIST FOR: CONDUCTOR GUIDE FRAME

[illegible][illegible]



					elf aquitaine norge a/s p.o.box 168 4001 Stavanger	 elf	Job no.	Installation CDP 1	System UNDERWATER		
Rev.	Date	DESCRIPTION	by	app.			Scale				
Contractor							Dwgr. no.	FF	1492	Rev.	Sheet
							FRIGG FIELD				

—CONDUCTOR SLEEVES— (AT SLAB LEVEL)

TYPE 1 : 1. 2. 3. 6. 8. 9. 10. 11. 12. 13. 14. 15. 17. 18. 21 AND 24. (SK. FF 91 36 35 1496)

TYPE 2 : 4. 5. 7. 16. 19 AND 20. (SK. FF 91 36 35 1499)

TYPE 3 : 22 AND 23. (SK. FF 91 36 35 1500)

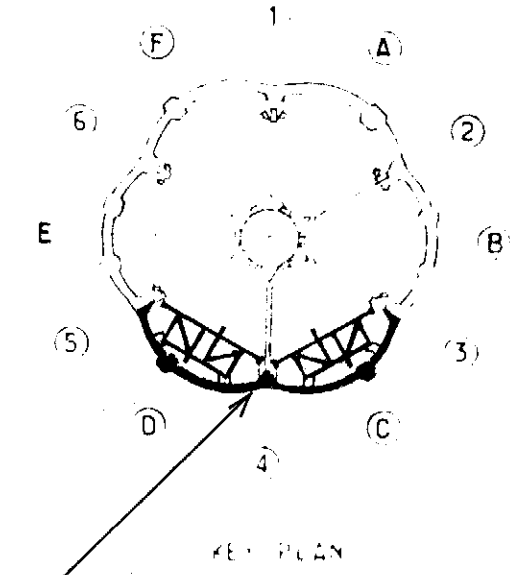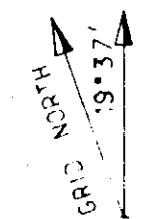

TUNNEL D

TUNNEL C

CELL D

CELL C

ADDITIONAL
CONCRETING
(SEE NOTES)

NOTES

FOR ADDITIONAL CONCRETING SEE QR 20 32 ET QR 20 33 (rev 3).

						elf aquitaine norge a/s p o box 168 4001 Stavanger	 elf	Job no.	Installation CDP 1	System UNDERWATER	
1	12.83	UP. DATED	BVH	MC				Scale	CONDUCTOR SLEEVES GENERAL PLAN VIEW CELL C & D		
Rev.	Date	DESCRIPTION	by	app				Dwgr no.	FF 91.36.35.1497.	rev.	Sheet
Contractor JVD_1029_40.167.						4001 Stavanger	FRIGG FIELD			1	

CDP 1 AS BUILT DRAWINGS

REFERENCE DRAWING LIST FOR: CONDUCTOR GUIDE FRAME

[illegible][illegible]

elf aquitaine norge a/s p.o.box 168 4091 Stavanger  elf					Job no.	Installation CDP 1		System UNDERWATER			
					Scale						
Rev.	Date	DESCRIPTION		by	app.	Dwgr. no.	FF		1497	Rev.	Sheet
Contractor					FRIGG FIELD						

-35.035 MLW

+61.300

-36.335 MLW


+60.000

SAND
BALLAST

SAND
BALLAST

150x45°

GRID NORTH
19°37'
PLAT. NORTH

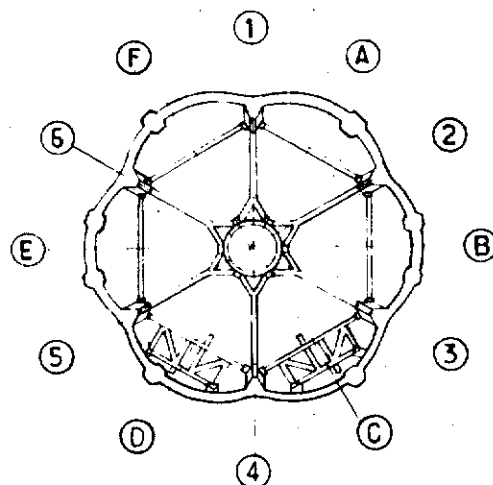

KEY PLAN

- 58.835 MLW

+ 37.500

-59.835 MLW

+ 36.500

LEVEL B

THIS SLEEVE IS IDENTICAL FOR
CONDUCTOR GUIDE N°1. 2. 3. 6. 8. 9. 10. 11.
12. 13. 14. 15. 17. 18. 21 AND 24

36" DIA. ID x 15mm THK

EL. -92.985 MLW
+3.350

-81.335 MLW

+15.000

LEVEL A

-95.035 MLW

+ 1.300

-90.835 MLW

+5.500

-92.985 MLW
+3.350


-93.535 MLW

+2.800

-95.035 MLW

+1.300

CASING 26" O.D.
UP TO -40 m.
UNDER MUD LINE

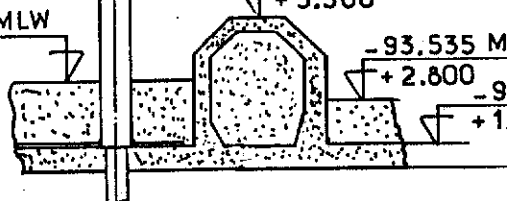


					 elf	Job no.	Installation CDP 1	System UNDERWATER	
1	12.83	UP DATED	BYH	HC		Scale 1:25	CONDUCTOR SLEEVE TYPE 1 DETAIL		
Rev.	Date	DESCRIPTION	by	app.		Dwgr. no.	FF 91_36.35.1498.	Rev.	Sheet
Contractor JVD 1029_40.168					4001 Stavanger	FRIGG FIELD		1	/

CDP 1 AS BUILT DRAWINGS

REFERENCE DRAWING LIST FOR: *CONDUCTOR GUIDE FRAME*

[illegible][illegible]

					elf aquitaine norge a/s p.o.box 168 4001 Stavanger	 elf	Job no.	Installation CDP 1	System UNDERWATER		
							Scale				
Rev.	Date	DESCRIPTION	by	app.			Dwgr. no.			Rev	Sheet
Contractor					4001 Stavanger	FRIGG FIELD	EE	1498			/

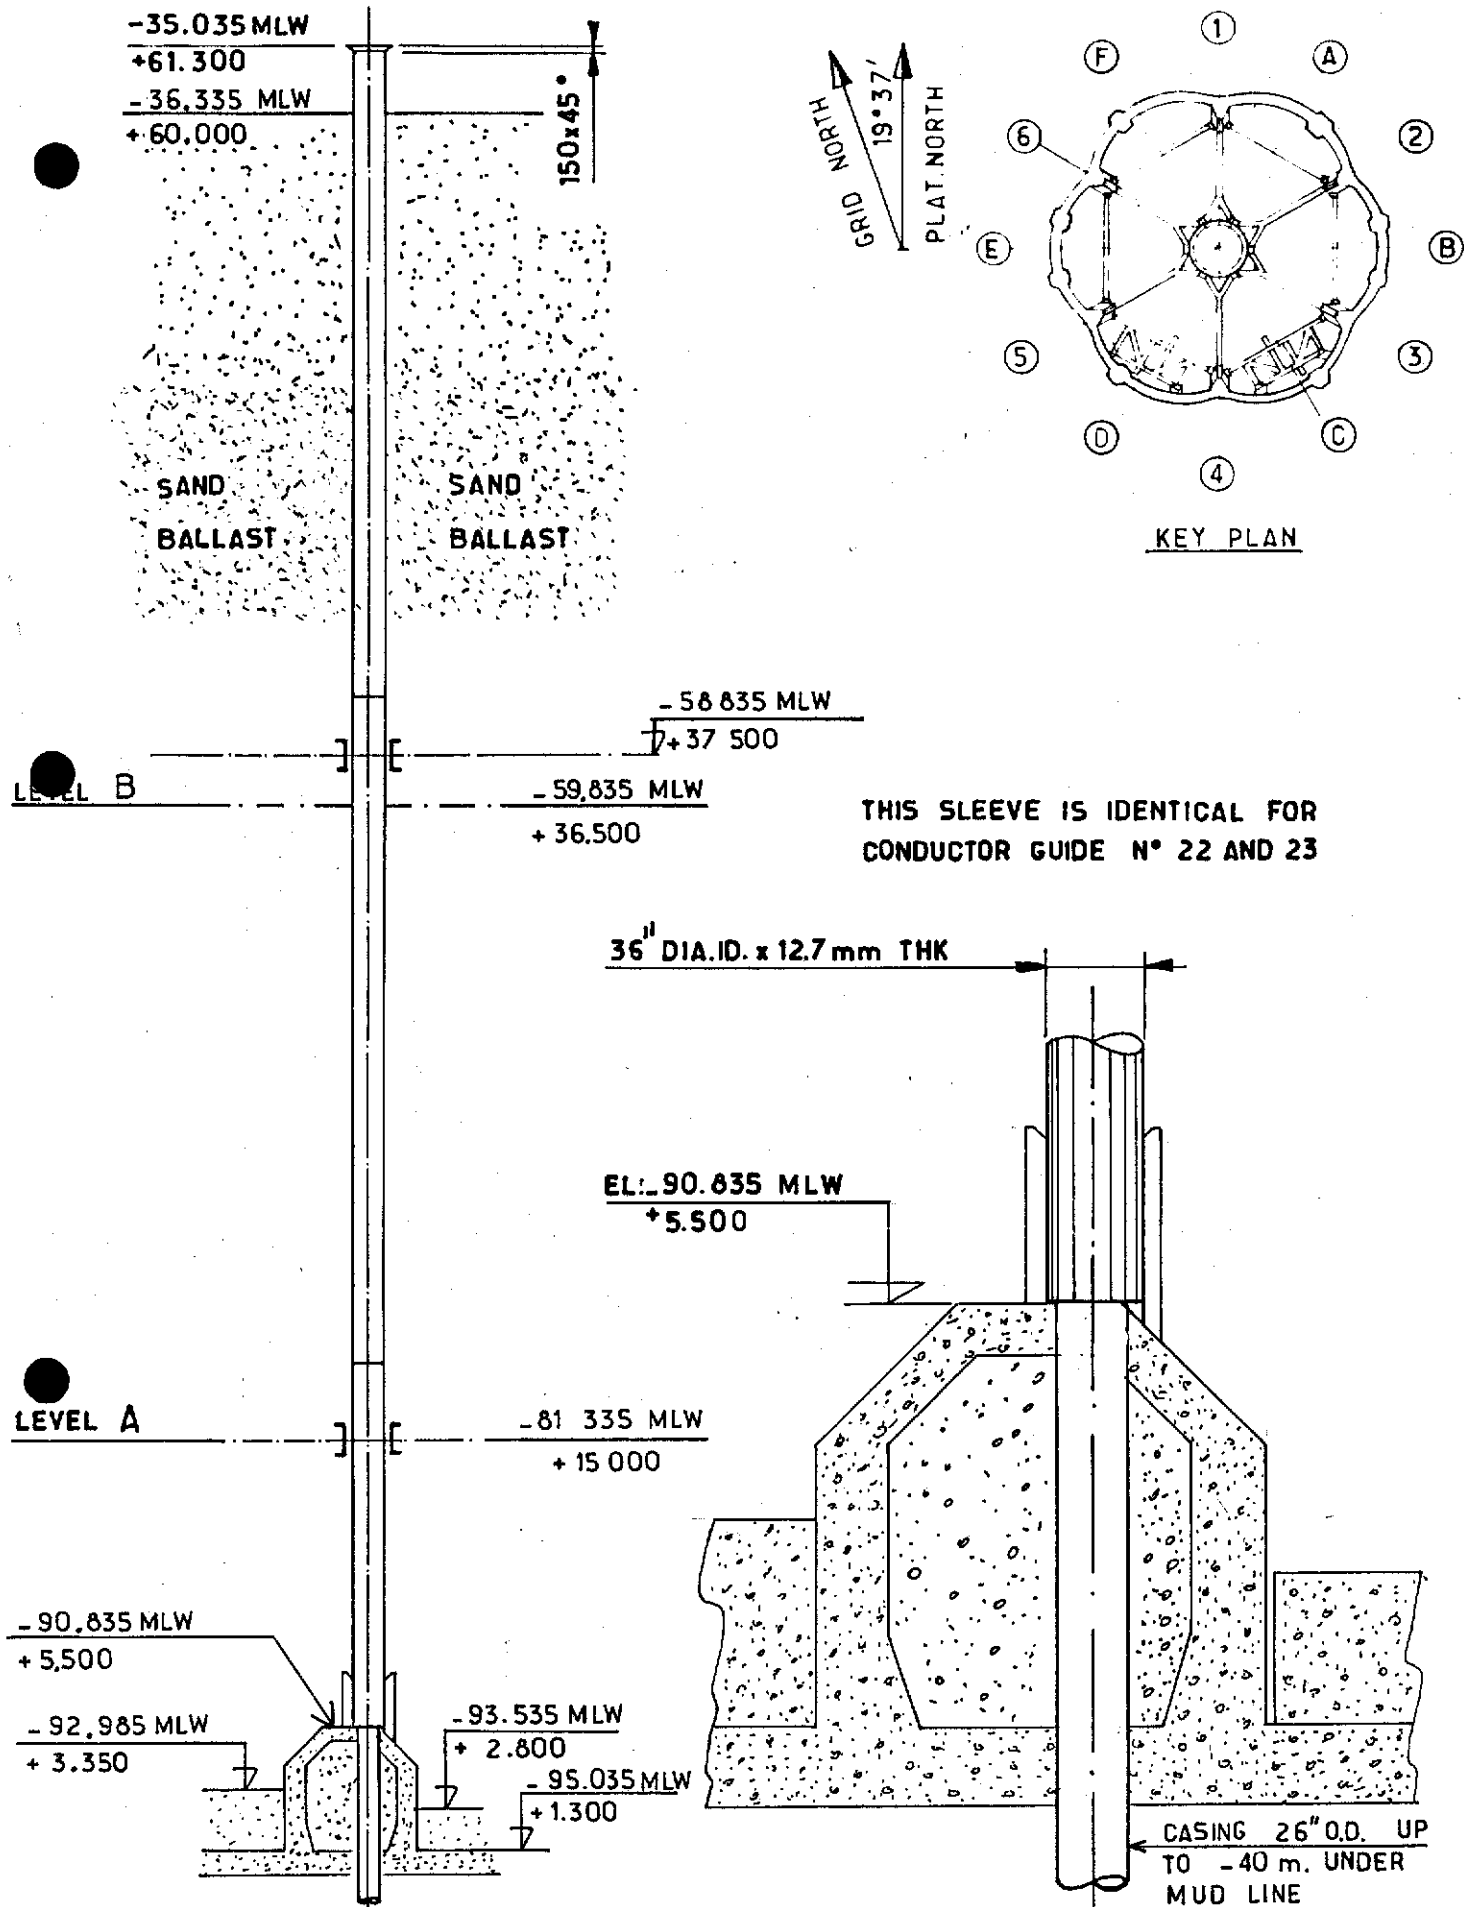

				elf aquitaine norge a/s p.o.box 168 4001 Stavanger	 elf	Job no.	Installation CDP 1	System UNDERWATER	
1	12.83	UP DATED	B.VH <i>LLC</i>			Scale 1:25	CONDUCTOR SLEEVE TYPE 2 DETAIL		
Rev.	Date	DESCRIPTION	by app.	Contractor JVD 1029_40.169	FRIGG FIELD	Dwgr. no		Rev.	Sheet
								FF_91.36.35.1499.	1

CDP 1 AS BUILT DRAWINGS

REFERENCE DRAWING LIST FOR: CONDUCTOR GUIDE FRAME

[illegible][illegible]

					elf aquitaine norge a/s p.o.box 168 4001 Stavanger	 elf	Job no.	Installation CDP 1	System UNDERWATER		
							Scale				
Rev.	Date	DESCRIPTION	by	app.			Dwgr. no.			Rev.	Sheet
Contractor					4001 Stavanger	FRIGG FIELD	EE	11.90		/	

-35.035 MLW

+61.300

-36.335 MLW


+60.000

SAND
BALLAST

SAND
BALLAST

150x45°

GRID NORTH
19°37'
PLAT. NORTH

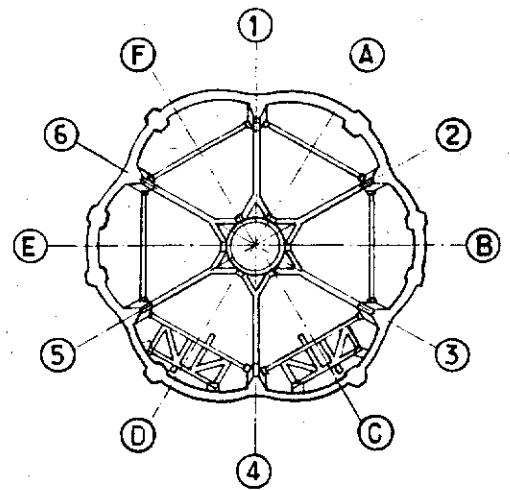

KEY PLAN

-58.835 MLW

+37.500

-59.835 MLW

+36.500

THIS SLEEVE IS IDENTICAL FOR
CONDUCTOR GUIDE N°4. 5. 7. 16.
19 AND 20.

36" DIA. ID x 15mm THK.

LEVEL A

-81.335 MLW

+15.000

-90.835 MLW

+5.500

92.985 MLW

+3.350

EL. -93.535 MLW

+2.600

CASING 26" O.D.
UP TO -40 m. UNDER
MUD LINE

1	12.83	UP DATED	BVH/IC
Rev.	Date	DESCRIPTION	by app.
Contractor JVD 1029_40.170			

elf
aquitaine
norge a/s
p.o.box 168
4001 Stavanger



FRIGG FIELD


Job no.	Installation CDP 1	System UNDERWATER
Scale 1:25	CONDUCTOR SLEEVE TYPE 3 DETAIL	
Dwgr. no.	FF_91_36_35_1500.	Rev. 1

CDP 1 AS BUILT DRAWINGS


REFERENCE DRAWING LIST FOR: CONDUCTOR GUIDE FRAME

[illegible][illegible]


				elf aquitaine norge a/s p.o.box 168 4001 Stavanger	 elf	Job no.	Installation CDP 1	System UNDERWATER		
						Scale				
Rev.	Date	DESCRIPTION	by	app.	FRIGG FIELD	Dwgr. no.	FF ——— 1500		Rev.	Sheet /
Contractor										

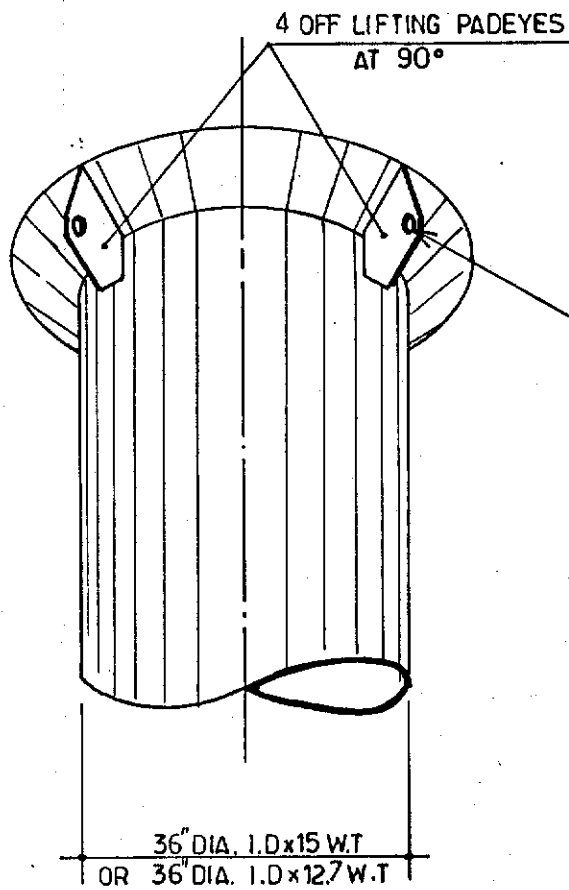

HUB NORTH
19° 37'
PLAT. NORTH

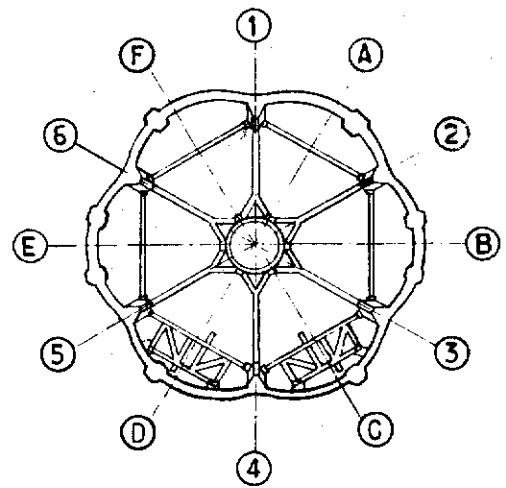

KEY PLAN

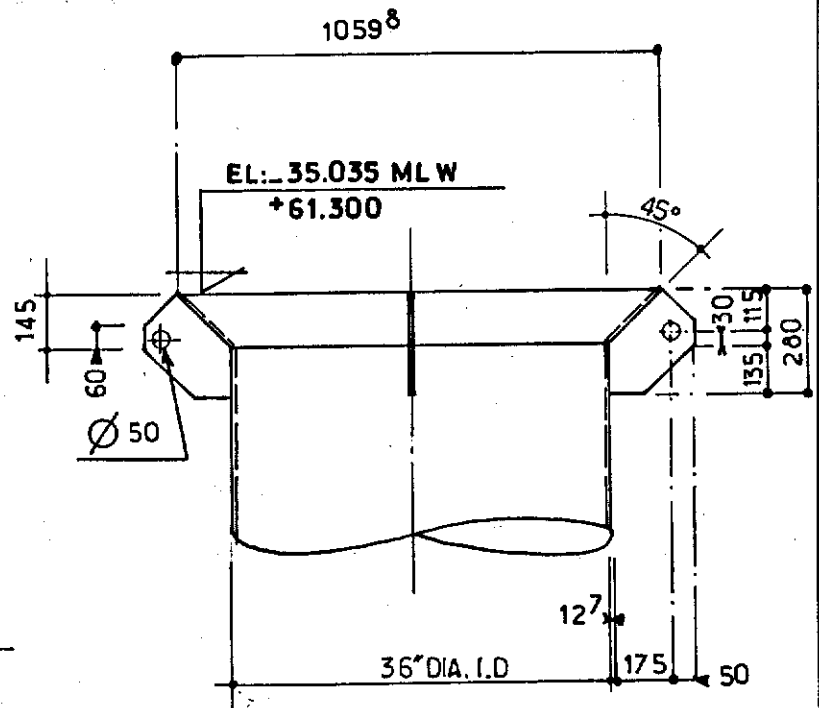

— 24 N° IDENTICAL ITEMS —

						 elf	Job no.	Installation CDP 1	System UNDERWATER
1	1283	UP DATED	BVH	LLC			Scale 1:25	CONDUCTOR SLEEVE FUNNEL	
Rev.	Date	DESCRIPTION	by	app.			Dwgr. no.		Rev
Contractor	JYD 1029_40.171.						FF. 91.36.35.1501.		1
						FRIGG FIELD			Sheet

CDP 1 AS BUILT DRAWINGS

REFERENCE DRAWING LIST FOR: CONDUCTOR GUIDE FRAME

[illegible][illegible]

					elf aquitaine norge a/s p.o.box 168 4001 Stavanger	 elf	Job no.	Installation CDP 1	System UNDERWATER	
							Scale			
Rev.	Date	DESCRIPTION	by	app.			Dwgr. no.	1501		
Contractor					4001 Stavanger	FRIGG FIELD	EE		Rev	Sheet /