
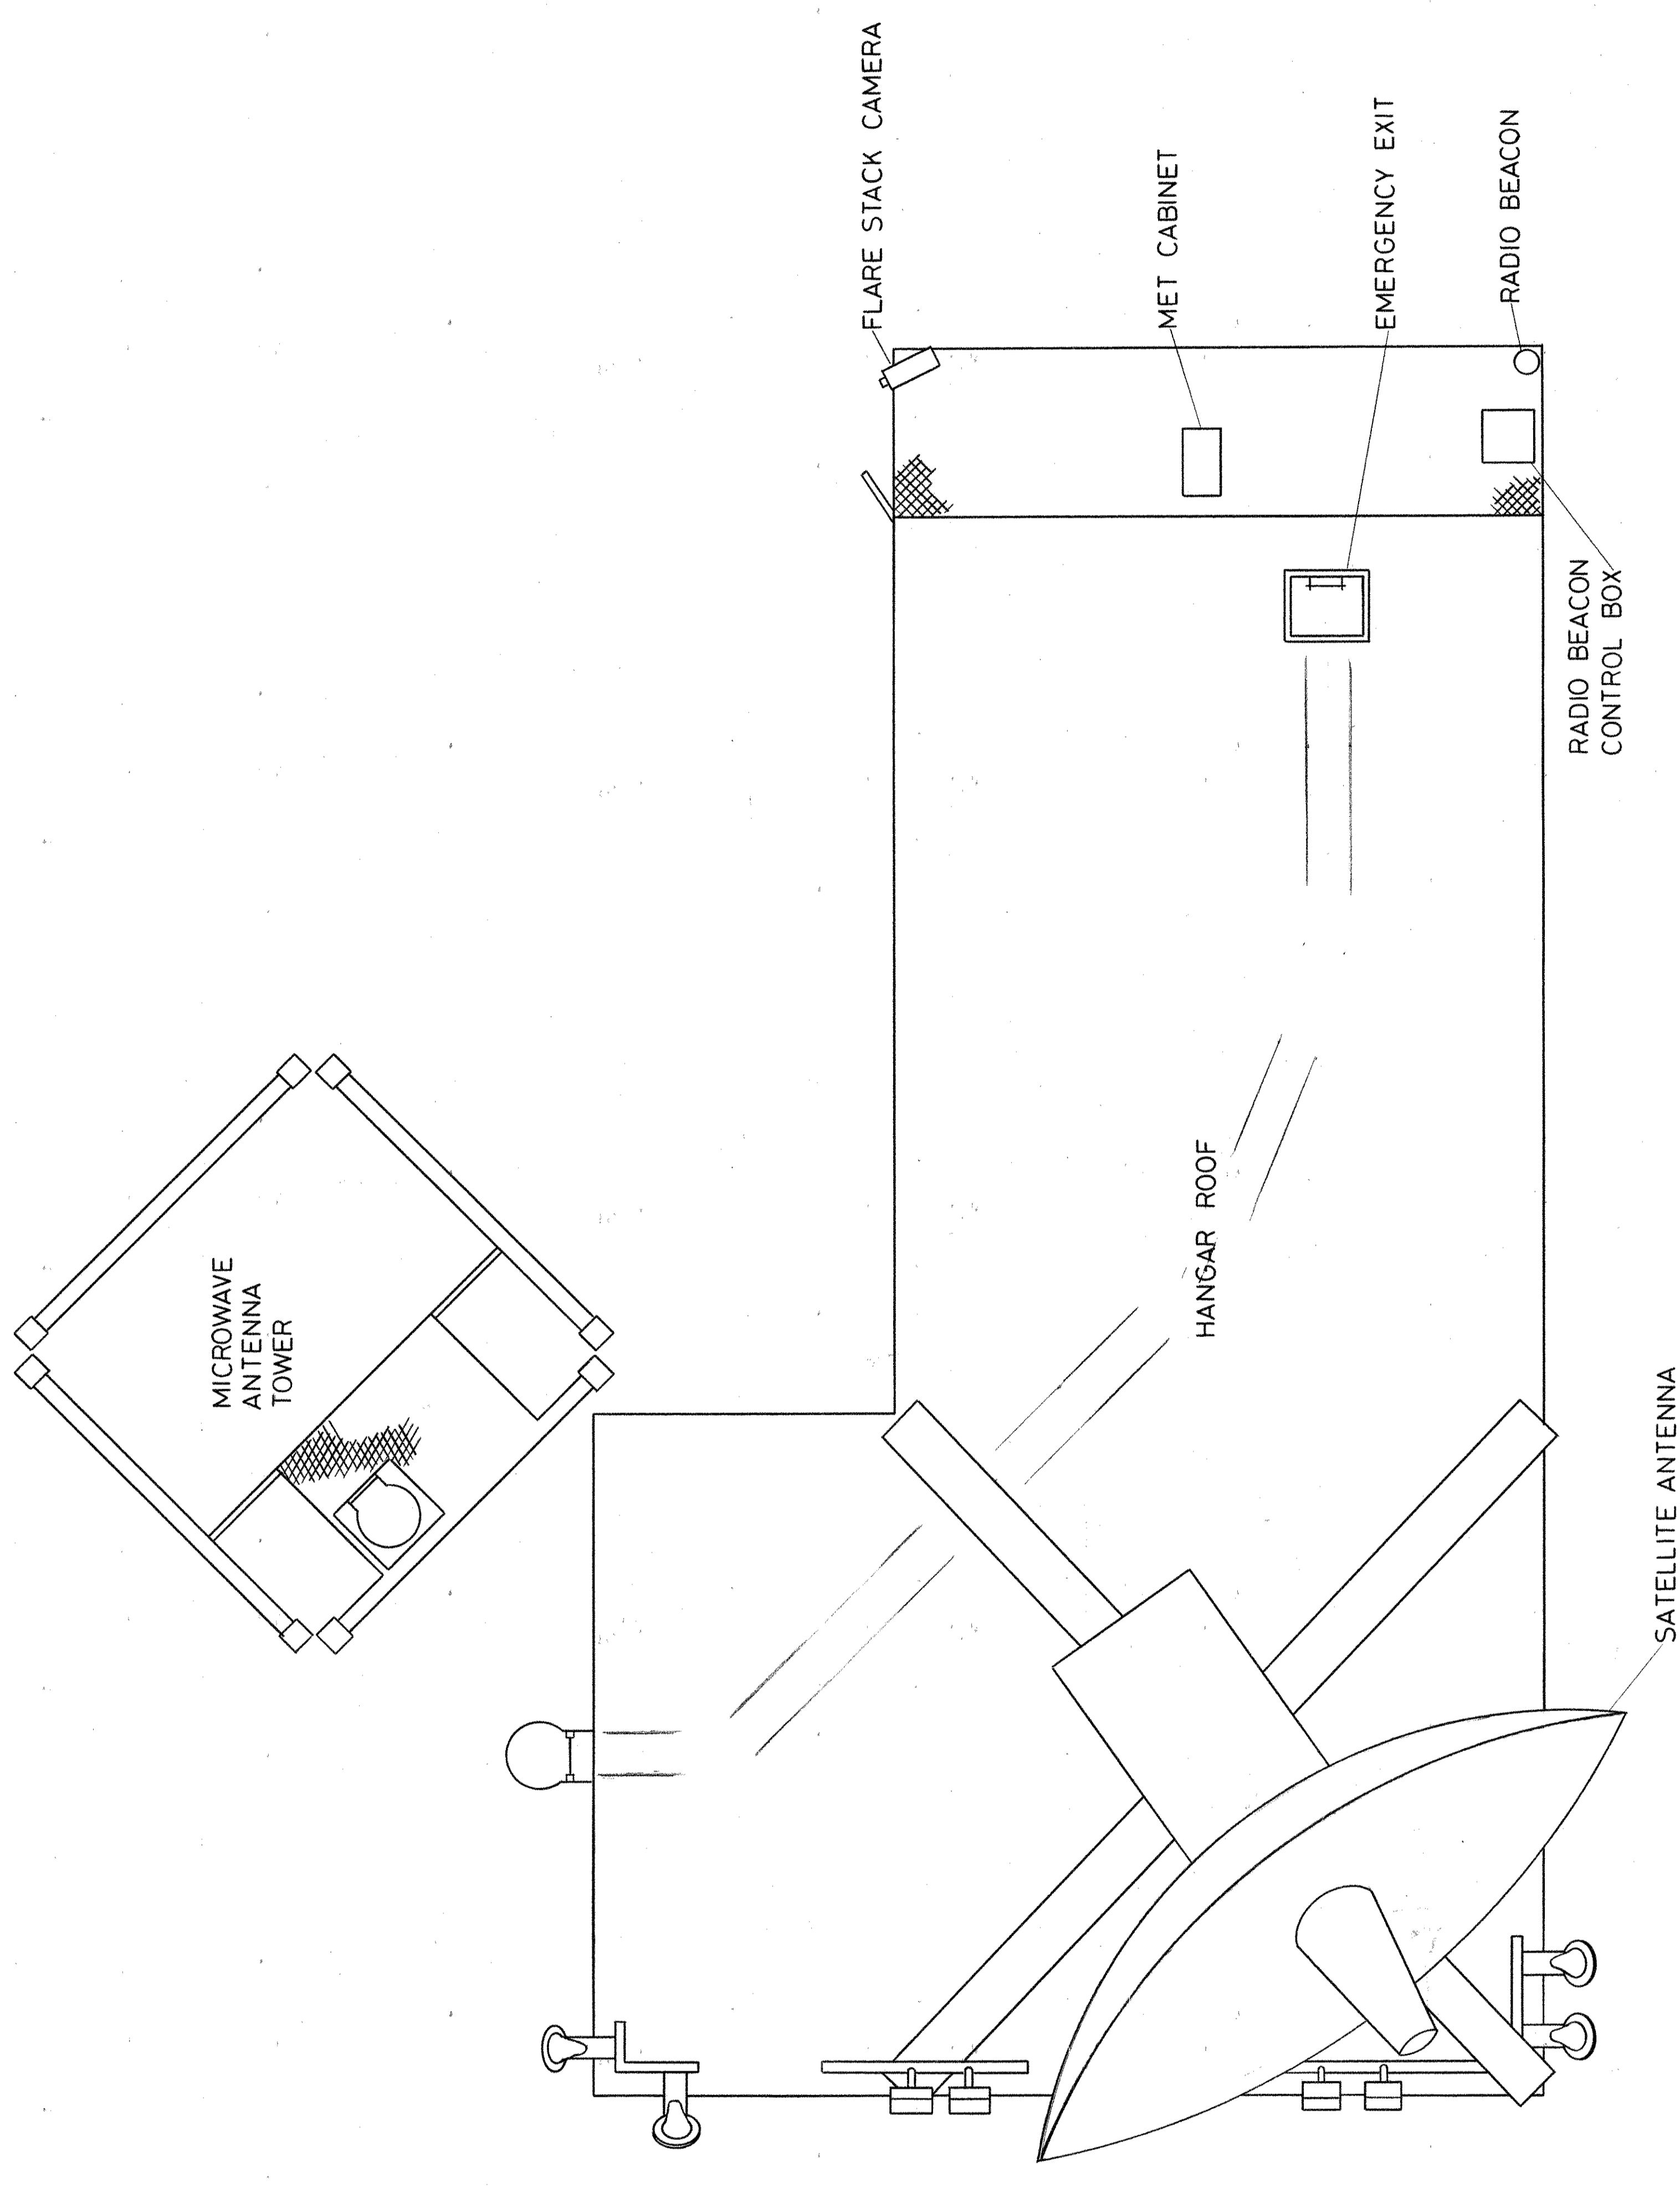


LEGEND

- [H1.4] 1.4 Kg. HALON FIRE EXTINGUISHER
- [W9] 9 Kg. WATER FIRE EXTINGUISHER
- [D4.5] 4.5Kg. DRY CHEMICAL FIRE EXTINGUISHER
- [D9] 9 Kg. DRY CHEMICAL FIRE EXTINGUISHER
- [D68] 68Kg. DRY CHEMICAL FIRE EXTINGUISHER
- [C4.5] 4.5Kg. FIRE EXTINGUISHER CO₂
- [C9] 9 Kg. FIRE EXTINGUISHER CO₂
- [C13.6] 13.6Kg. FIRE EXTINGUISHER CO₂
- ➔ FIRE WATER MONITOR
- ▨ WASHDOWN HOSE REEL
- ▨ FIRE WATER HOSE REEL
- F ▨ WATER/FOAM HOSE REEL
- C ▨ DRY CHEMICAL HOSE REEL
- ⚡ BREAK GLASS UNIT - HALON MANUAL RELEASE
- ⊠ MANUAL START STATION - WATER DELUGE (VESSEL NUMBER IN BRACKETS)
- [WFR] WATER/FOAM RELEASE LEVER FOR FIRE PUMP START
- [PR] POWER RELEASE LEVER
- [ESD] ESD BUTTON
- (FAB) FIRE ALARM BUTTON (ALARM & FIRE PUMP START)
- [FB] FIRE BLANKET
- [F] FIREMANS OUTFIT
- [BA] BREATHING APPARATUS
- (M) MUSTER ALARM
- ▭ EQUIPMENT COVERED WITH WATER DELUGE
- ▭ COMPARTMENTS COVERED WITH HALON
- ▭ ESCAPE ROUTES

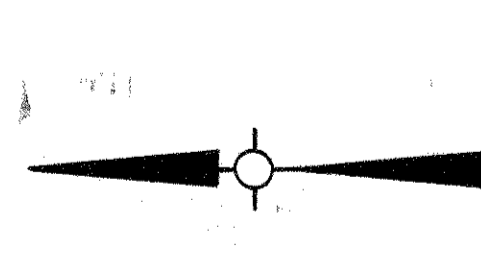

T.O.P. EL 47383

AS BUILT
TO INFORMATION RECEIVED
UP TO 31 MAY 77

DESIGN		INSTR.		PIPING		STRUCT.		NO.		BY		DATE		REVISIONS	

ENGINEERS APPROVAL		DATE	DATE

ELF - NORGE
FRIGG FIELD

QUARTERS PLATFORM
JOB 1-40-D2

NORTH SEA
McDERMOTT - HUDSON
LONDON - ENGLAND

DESIGNED BY: CMJ
CHECKED BY: CMJ
DATE: 31 MAY 77
JOB NO: ELN 2111
SHEET NO: 7027

W.D. 104 M

FIRE CONTROL PLAN - HANGER ROOF