

LEGEND

- [H1.4] 1.4 Kg. HALON FIRE EXTINGUISHER
- [W9] 9 Kg. WATER FIRE EXTINGUISHER
- [D4.5] 4.5 Kg. DRY CHEMICAL FIRE EXTINGUISHER
- [D9] 9 Kg. DRY CHEMICAL FIRE EXTINGUISHER
- [D68] 68 Kg. DRY CHEMICAL FIRE EXTINGUISHER
- [C4.5] 4.5 Kg. FIRE EXTINGUISHER CO₂
- [C9] 9 Kg. FIRE EXTINGUISHER CO₂
- [C13.6] 13.6 Kg. FIRE EXTINGUISHER CO₂
- ▲ FIRE WATER MONITOR
- ▨ WASHDOWN HOSE REEL
- ▨ FIRE WATER HOSE REEL
- ▨ WATER/FOAM HOSE REEL
- ▨ DRY CHEMICAL HOSE REEL
- ⚡ BREAK GLASS UNIT - HALON MANUAL RELEASE
- ⚡ MANUAL START STATION - WATER DELUGE (VESSEL NUMBER IN BRACKETS)
- [WFR] WATER/FOAM RELEASE LEVER FOR FIRE PUMP START
- [PR] POWER RELEASE LEVER
- [ESD] ESD BUTTON
- (FAB) FIRE ALARM BUTTON (ALARM & FIRE PUMP START)
- [FB] FIRE BLANKET
- [F] FIREMAN'S OUTFIT
- [BA] BREATHING APPARATUS
- (M) MUSTER ALARM
- ▭ EQUIPMENT COVERED WITH WATER DELUGE
- ▭ COMPARTMENTS COVERED WITH HALON
- ▭ ESCAPE ROUTES

AS BUILT
TO INFORMATION RECEIVED
UP TO 1/1/77

ELF - NORGE
FRIGG FIELD

QUARTERS PLATFORM
JOB 1-40-D2

MCDERMOTT - HUDSON
NORTH SEA

SCALE 1:50
DATE MAY '77

DRAWN BY C. PEARSON
DESIGNED BY



DATE 10/10/77

NO. 2111

NO. 7023

W.D. 10.11M

FIRE CONTROL PLAN - MIDDLE LEVEL

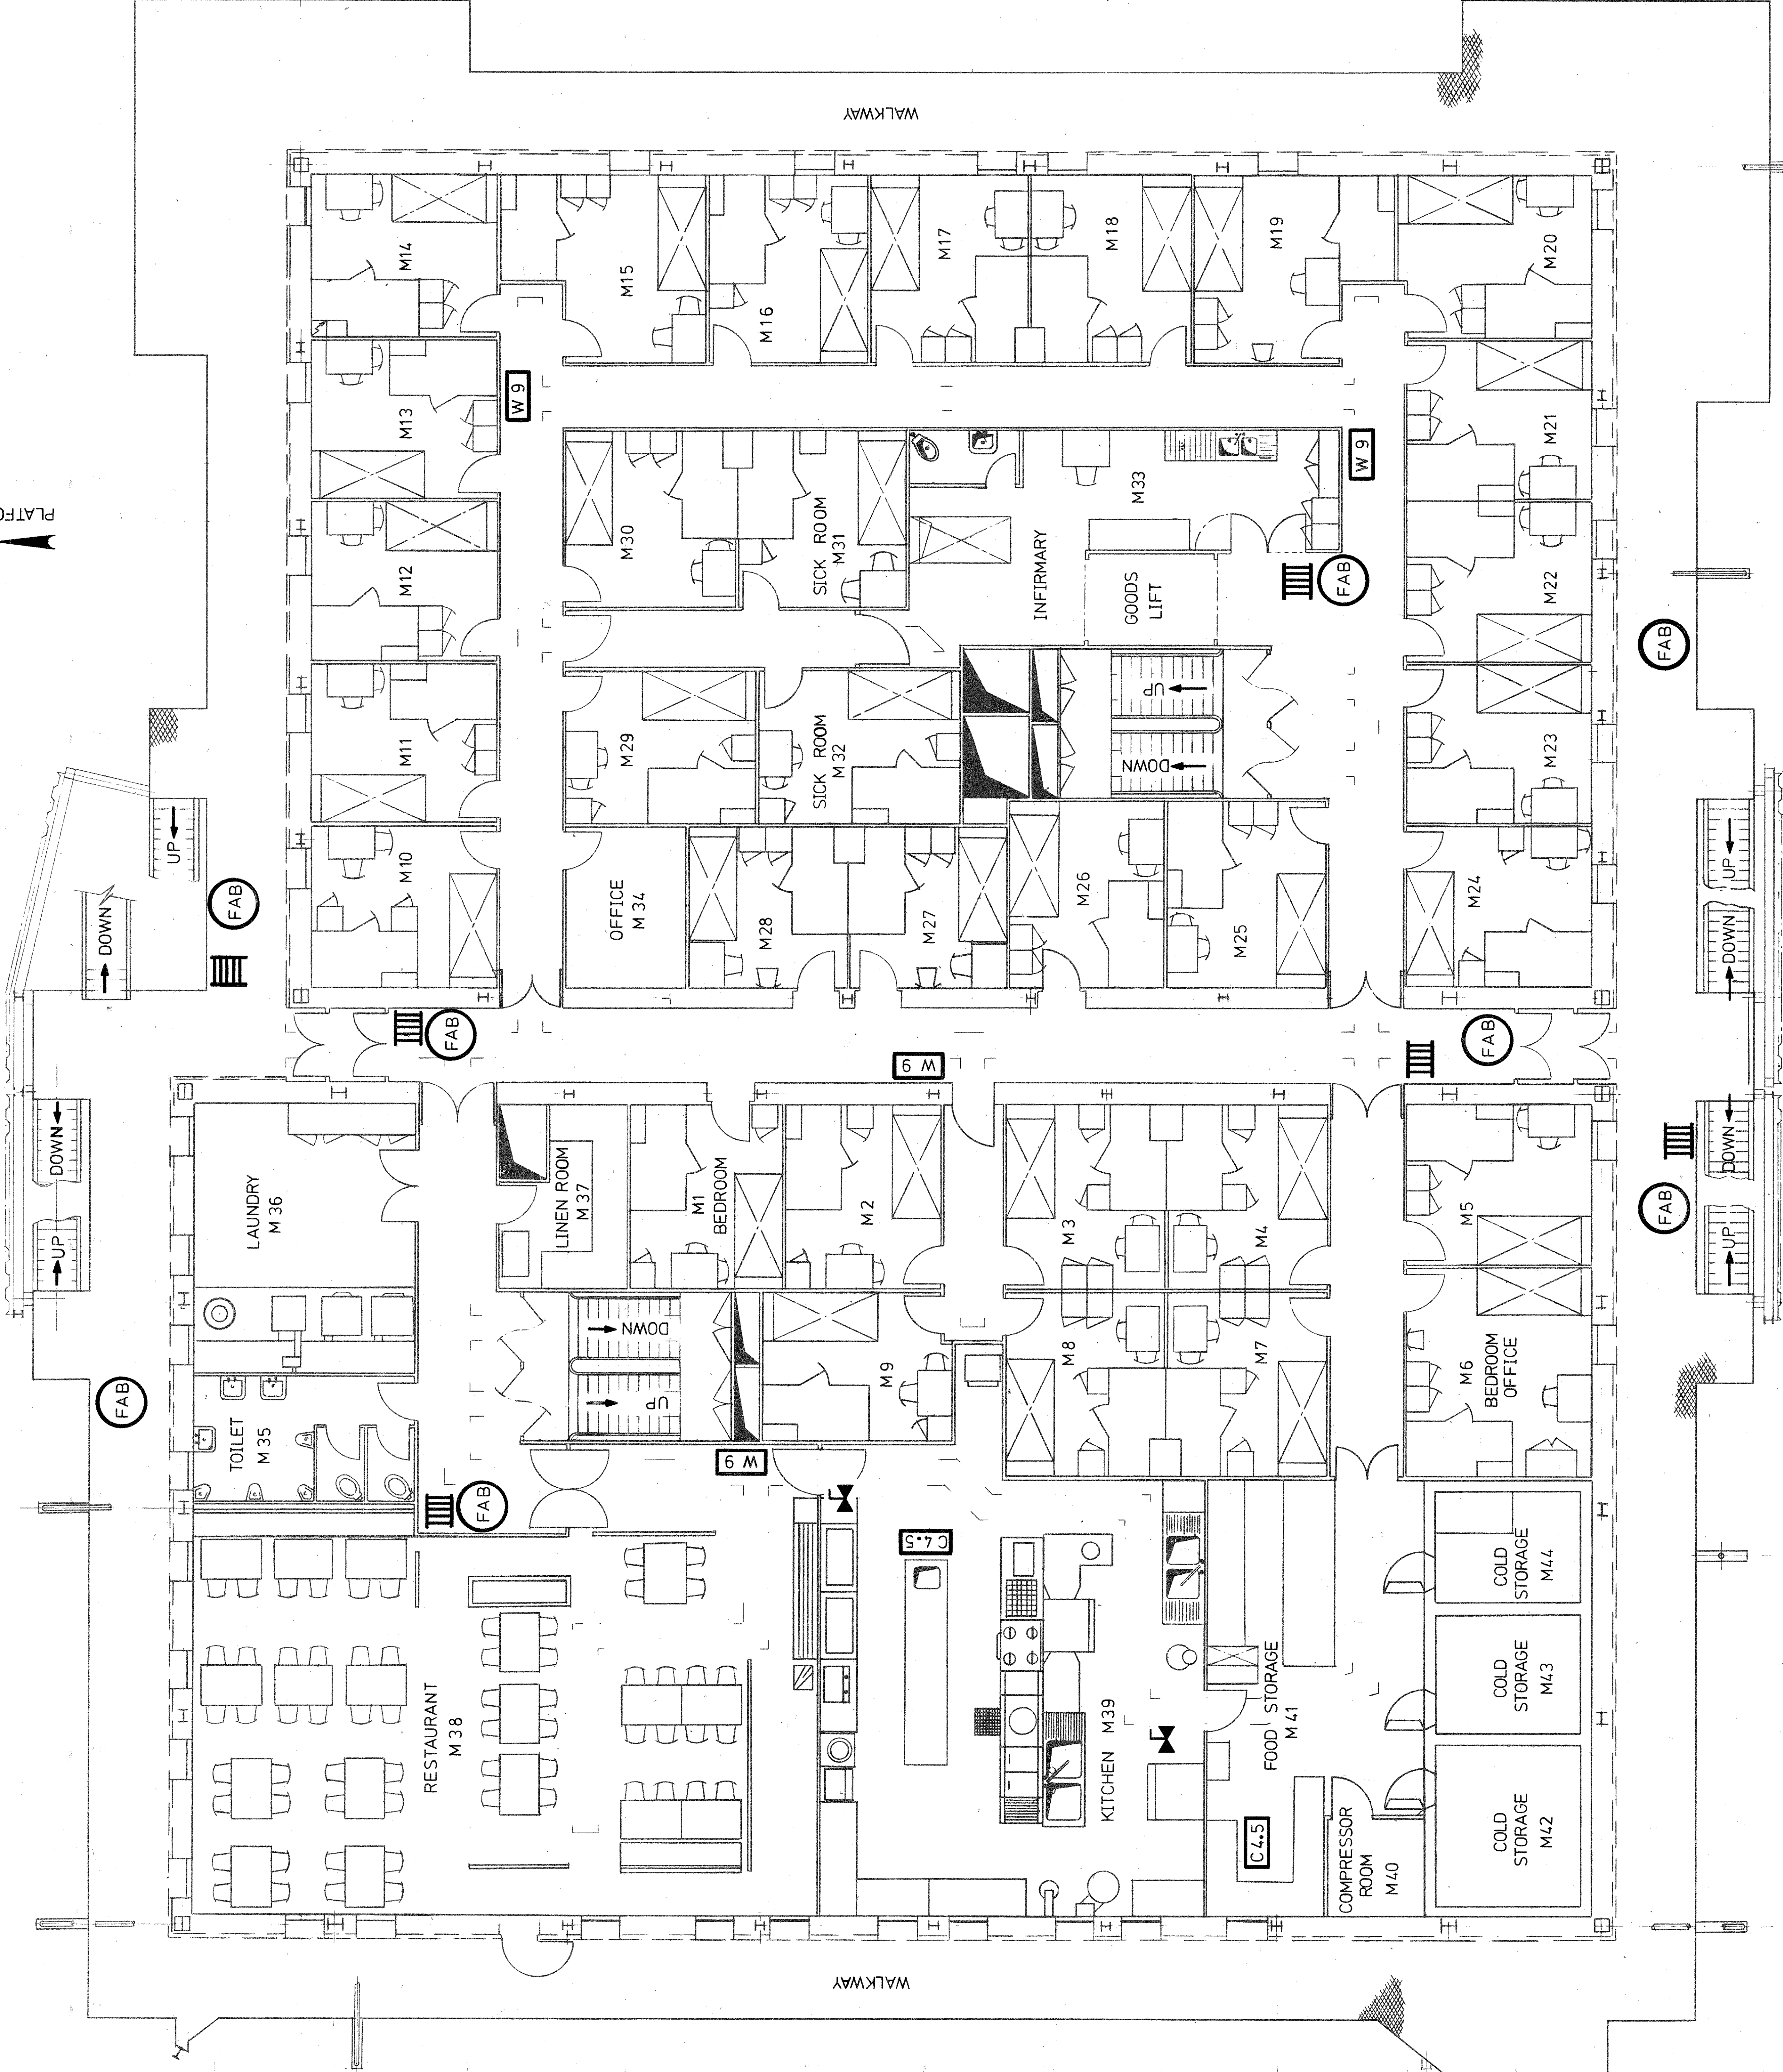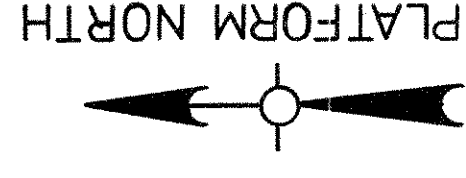

DESIGN	STRUCT	FRINGE	ELEC	ME	BY	DATE	REVISIONS	DESIGN	STRUCT	FRINGE	ELEC	ME	BY	DATE	REVISIONS

FAB STDS. REQ'D. THIS SHEET.

S & H LTD 850