

LEGEND

- [HI-4] 1.4 Kg. HALON FIRE EXTINGUISHER
- [W9] 9 Kg. WATER FIRE EXTINGUISHER
- [D4.5] 4.5 Kg. DRY CHEMICAL FIRE EXTINGUISHER
- [D9] 9 Kg. DRY CHEMICAL FIRE EXTINGUISHER
- [D68] 68 Kg. DRY CHEMICAL FIRE EXTINGUISHER
- [C4.5] 4.5 Kg. FIRE EXTINGUISHER C02
- [C9] 9 Kg. FIRE EXTINGUISHER C02
- [C13.6] 13.6 Kg. FIRE EXTINGUISHER C02
- [M] FIRE WATER MONITOR
- [H] WASHDOWN HOSE REEL
- [F] FIRE WATER HOSE REEL
- [F] WATER/FOAM HOSE REEL
- [C] DRY CHEMICAL HOSE REEL
- [B] BREAK GLASS UNIT - HALON MANUAL RELEASE
- [M] MANUAL START STATION - WATER DELUGE (VESSEL NUMBER IN BRACKETS)
- [WFR] WATER/FOAM RELEASE LEVER FOR FIRE PUMP START
- [PR] POWER RELEASE LEVER
- [ESD] ESD BUTTON
- [FAB] FIRE ALARM BUTTON (ALARM & FIRE PUMP START)
- [FB] FIRE BLANKET
- [F] FIREMANS OUTFIT
- [BA] BREATHING APPARATUS
- [M] MUSTER ALARM
- [] EQUIPMENT COVERED WITH WATER DELUGE
- [] COMPARTMENTS COVERED WITH HALON
- [] ESCAPE ROUTES

AS BUILT
 TO INFORMATION RECEIVED
 UP TO DEC 1977

ELF - NORGE
 FRIGG FIELD

QUARTERS PLATFORM
 JOB 1-40-D2


MCDERMOTT - HUDSON
 NORTH SEA
 LONDON - ENGLAND

SCALE 1:50
 DATE MAY 77

DESIGNED BY NRE
 DRAWN BY NRE

DWG. NO. ELN 2111
 SHEET NO. 7024

FIRE CONTROL PLAN - UPPER LEVEL

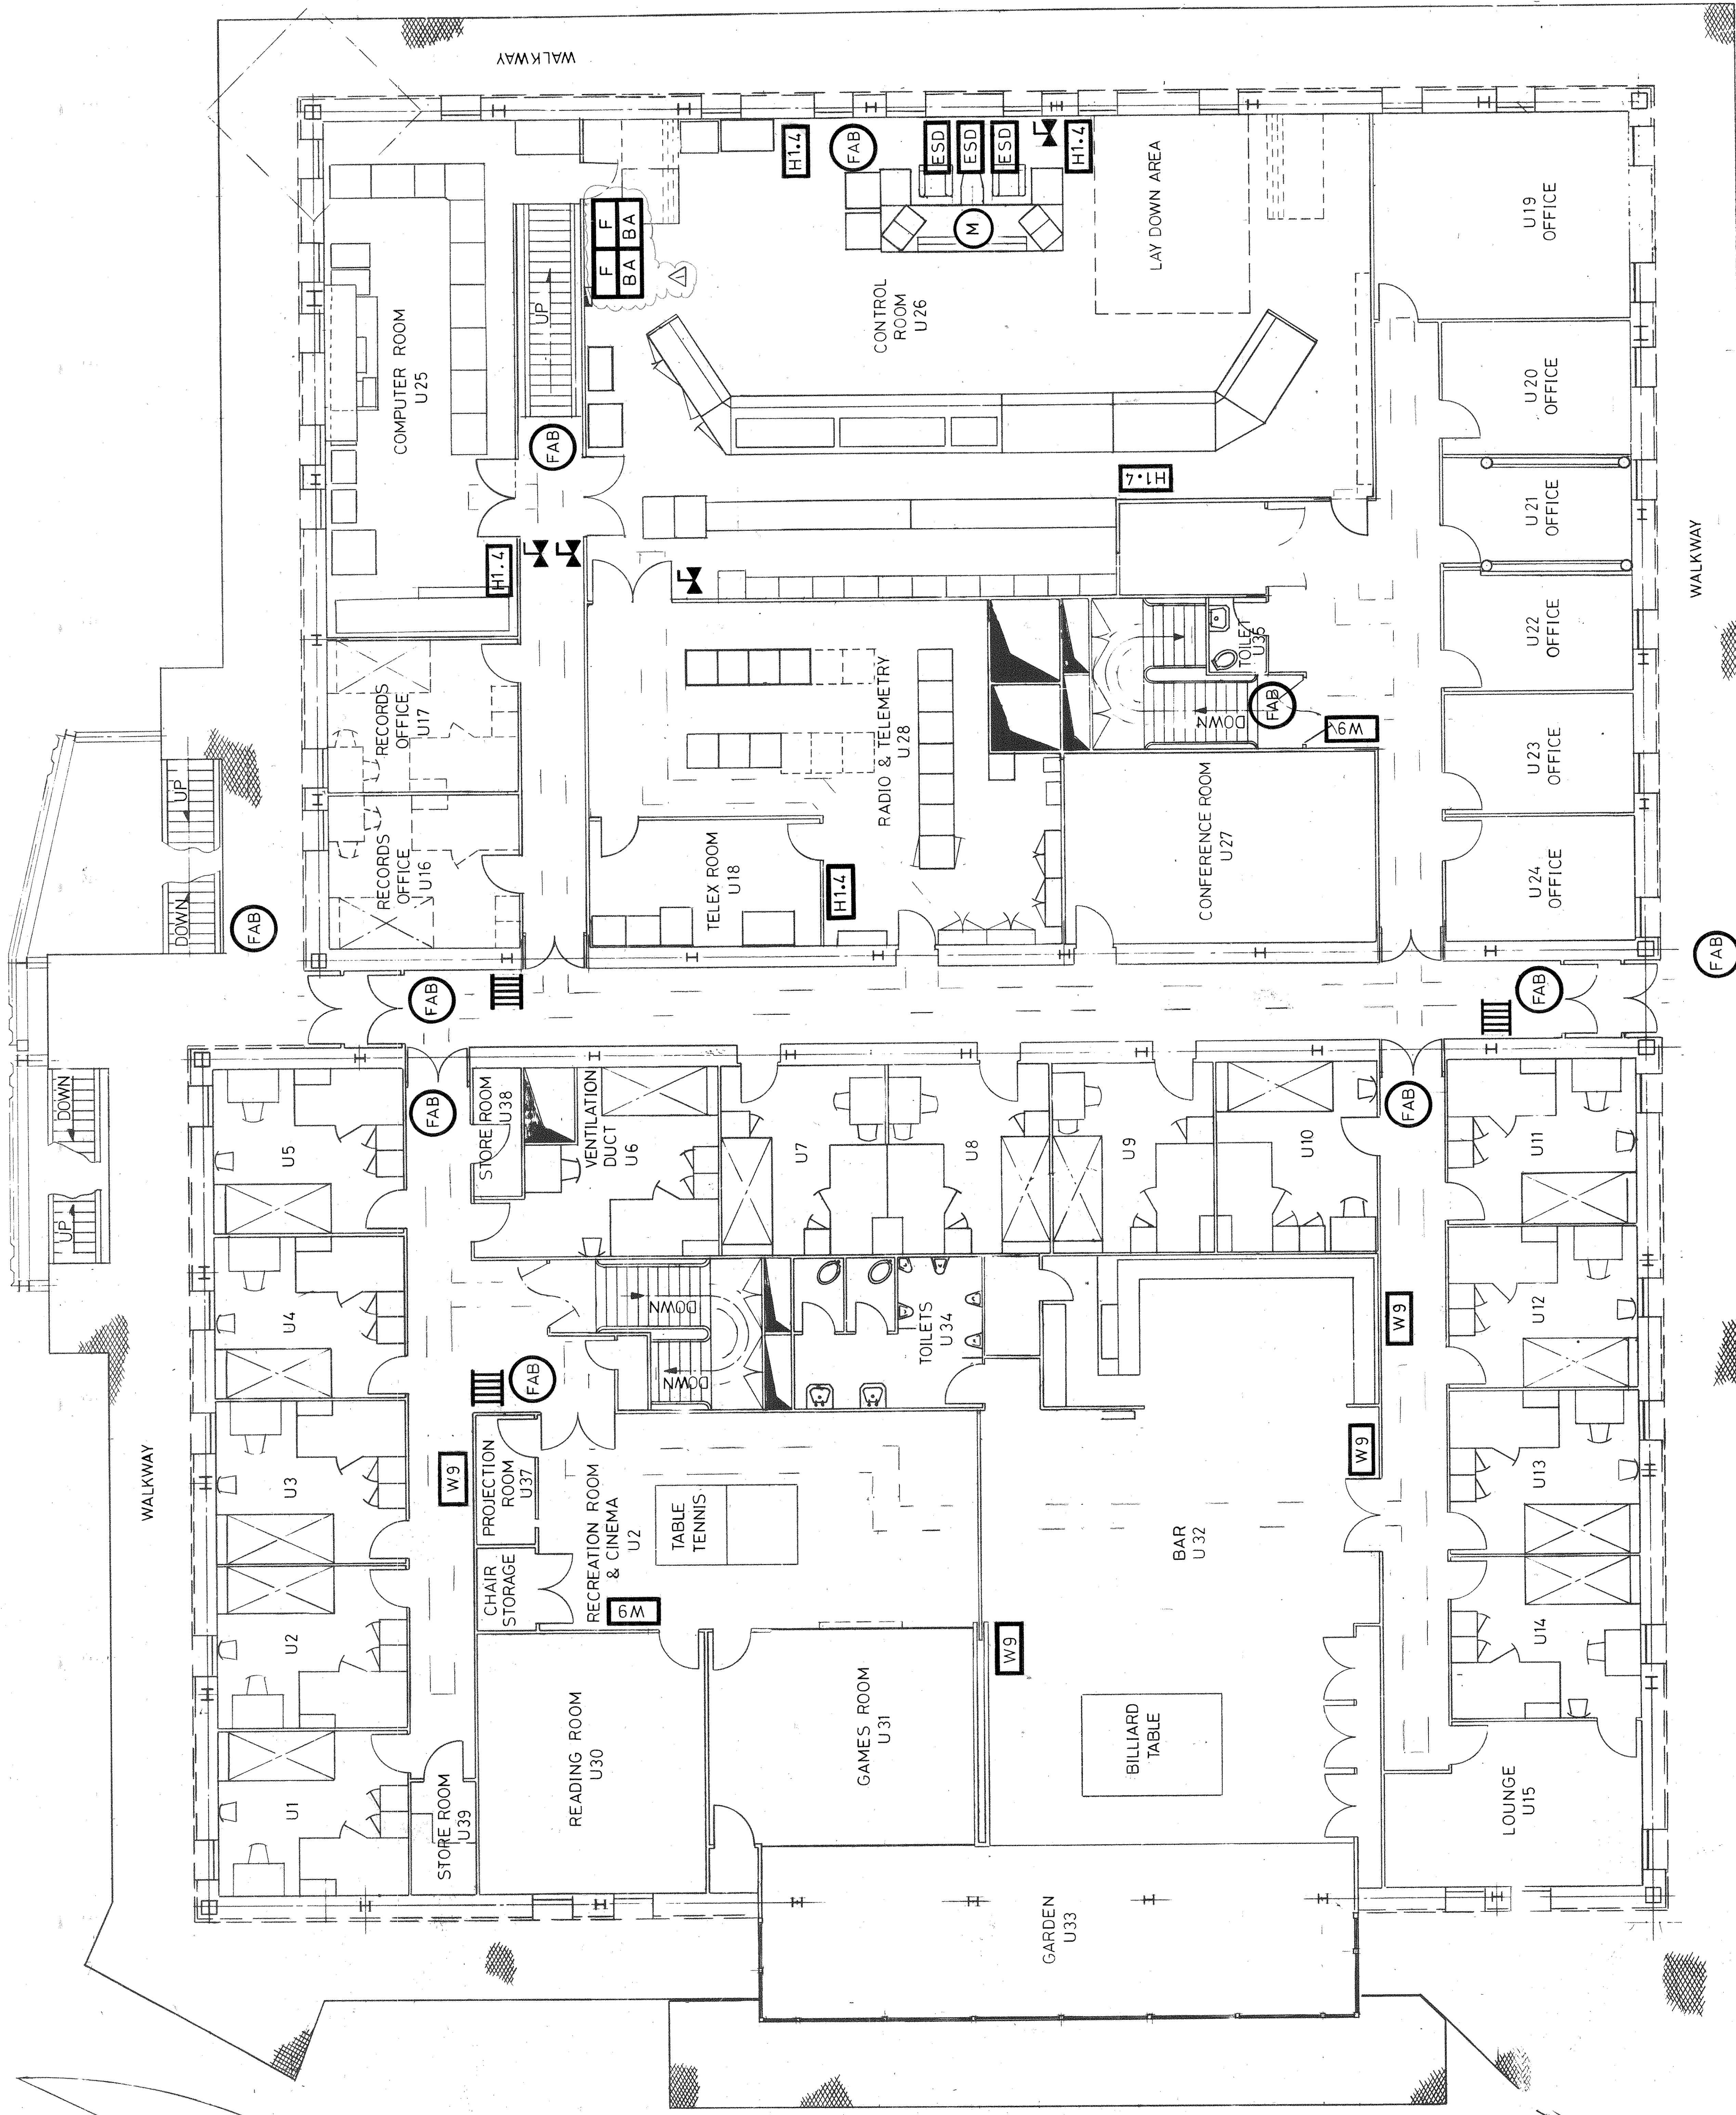

LIFEBOAT No. 2
 BOAT PLATFORM FOR
 50 MAN LIFEBOAT

NO.	REVISIONS	DATE	BY	CHK.	DATE	REVISIONS	DATE	BY	CHK.	DATE
1	CP 5/10/77	REVISED TO FIRE & SAFETY DRGS.								
2	INE (MAY 77)	NEW DRAWING								