


- ▼ EL + 42457 (139'-3 1/2") T.O. R. (HELIDECK) HI-PT
DWG. N° ELN 2111 SHT 720
- ▼ EL + 38175 (125'-2 1/4") T.O.S. ROOF
DWG. N° ELN 2111 SHT 721
- ▼ EL + 34525 (113'-3 1/4") T.O.S. UPPER LEVEL
DWG. N° ELN 2111 SHT 722
- ▼ EL + 30875 (101'-3 1/2") T.O.S. MIDDLE LEVEL
DWG. N° ELN 2111 SHT 723
- ▼ EL + 26910 (88'-3 1/2") T.O.S. LOWER LEVEL
DWG. N° ELN 2111 SHT 724
- ▼ EL + 21500 (70'-6 1/4")
DWG. N° ELN 2111 SHT 724

▼ M.L.W. 000 (0'-0")

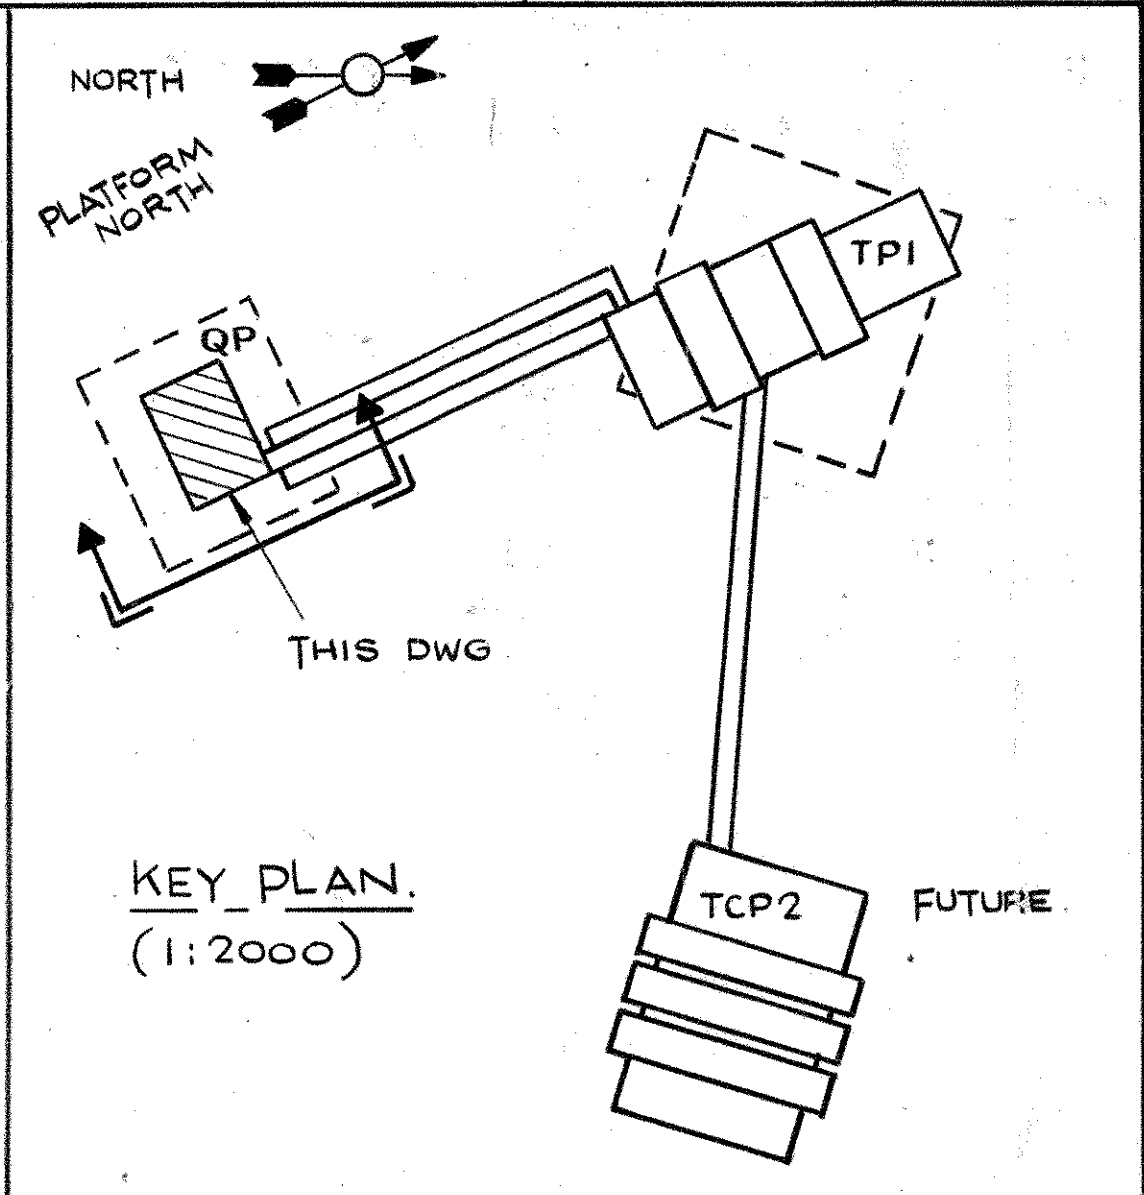

GENERAL NOTES.

REFERENCE DRAWINGS	
DRG N°	SHT N°
ELN 2111	717
ELN 2111	718
ELN 2111	720
ELN 2111	721
ELN 2111	722
ELN 2111	723
ELN 2111	724
ELN 2111	724

**ELF - NORGE
FRIGG FIELD**

QUARTERS PLATFORM
NORTH SEA
JOB 1-40-D2 W.D.104 M

MCDERMOTT - HUDSON
LONDON - ENGLAND

DRAWN BY: C.A. GRIFFITHS
SCALE: 1:150
DATE: 28 JAN 75
SHEET NO: 719

CUSTOMER APPROVAL
BY: gmd
DATE: 12.6.75

AS BUILT
TO INFORMATION RECEIVED
UP TO NOV. 77

DESIGN	STRUCT	PIPING	ELEC.	MECH.	BY	DATE	REVISIONS	DATE	APP.	DESIGN	STRUCT	PIPING	ELEC.	MECH.	BY	DATE	REVISIONS	DATE	APP.	