


WARNING! : LIMITED / PARTLY NO ACCESS IN THIS AREA DUE TO ANTENNA & MICROWAVE TOWER. EXTREME CARE MUST BE EXERCISED IF LIFTING ABOVE AND NEAR ANTENNA AND NEAR TOWER IS REQUIRED. (WORK PERMIT REQUIRED)

WARNING!!
USE OF CRANE WITH
BIDOW EXTENSION
FITTED IS NOT ALLOWED
FOR SUPPLY BOAT
SEA LIFTS

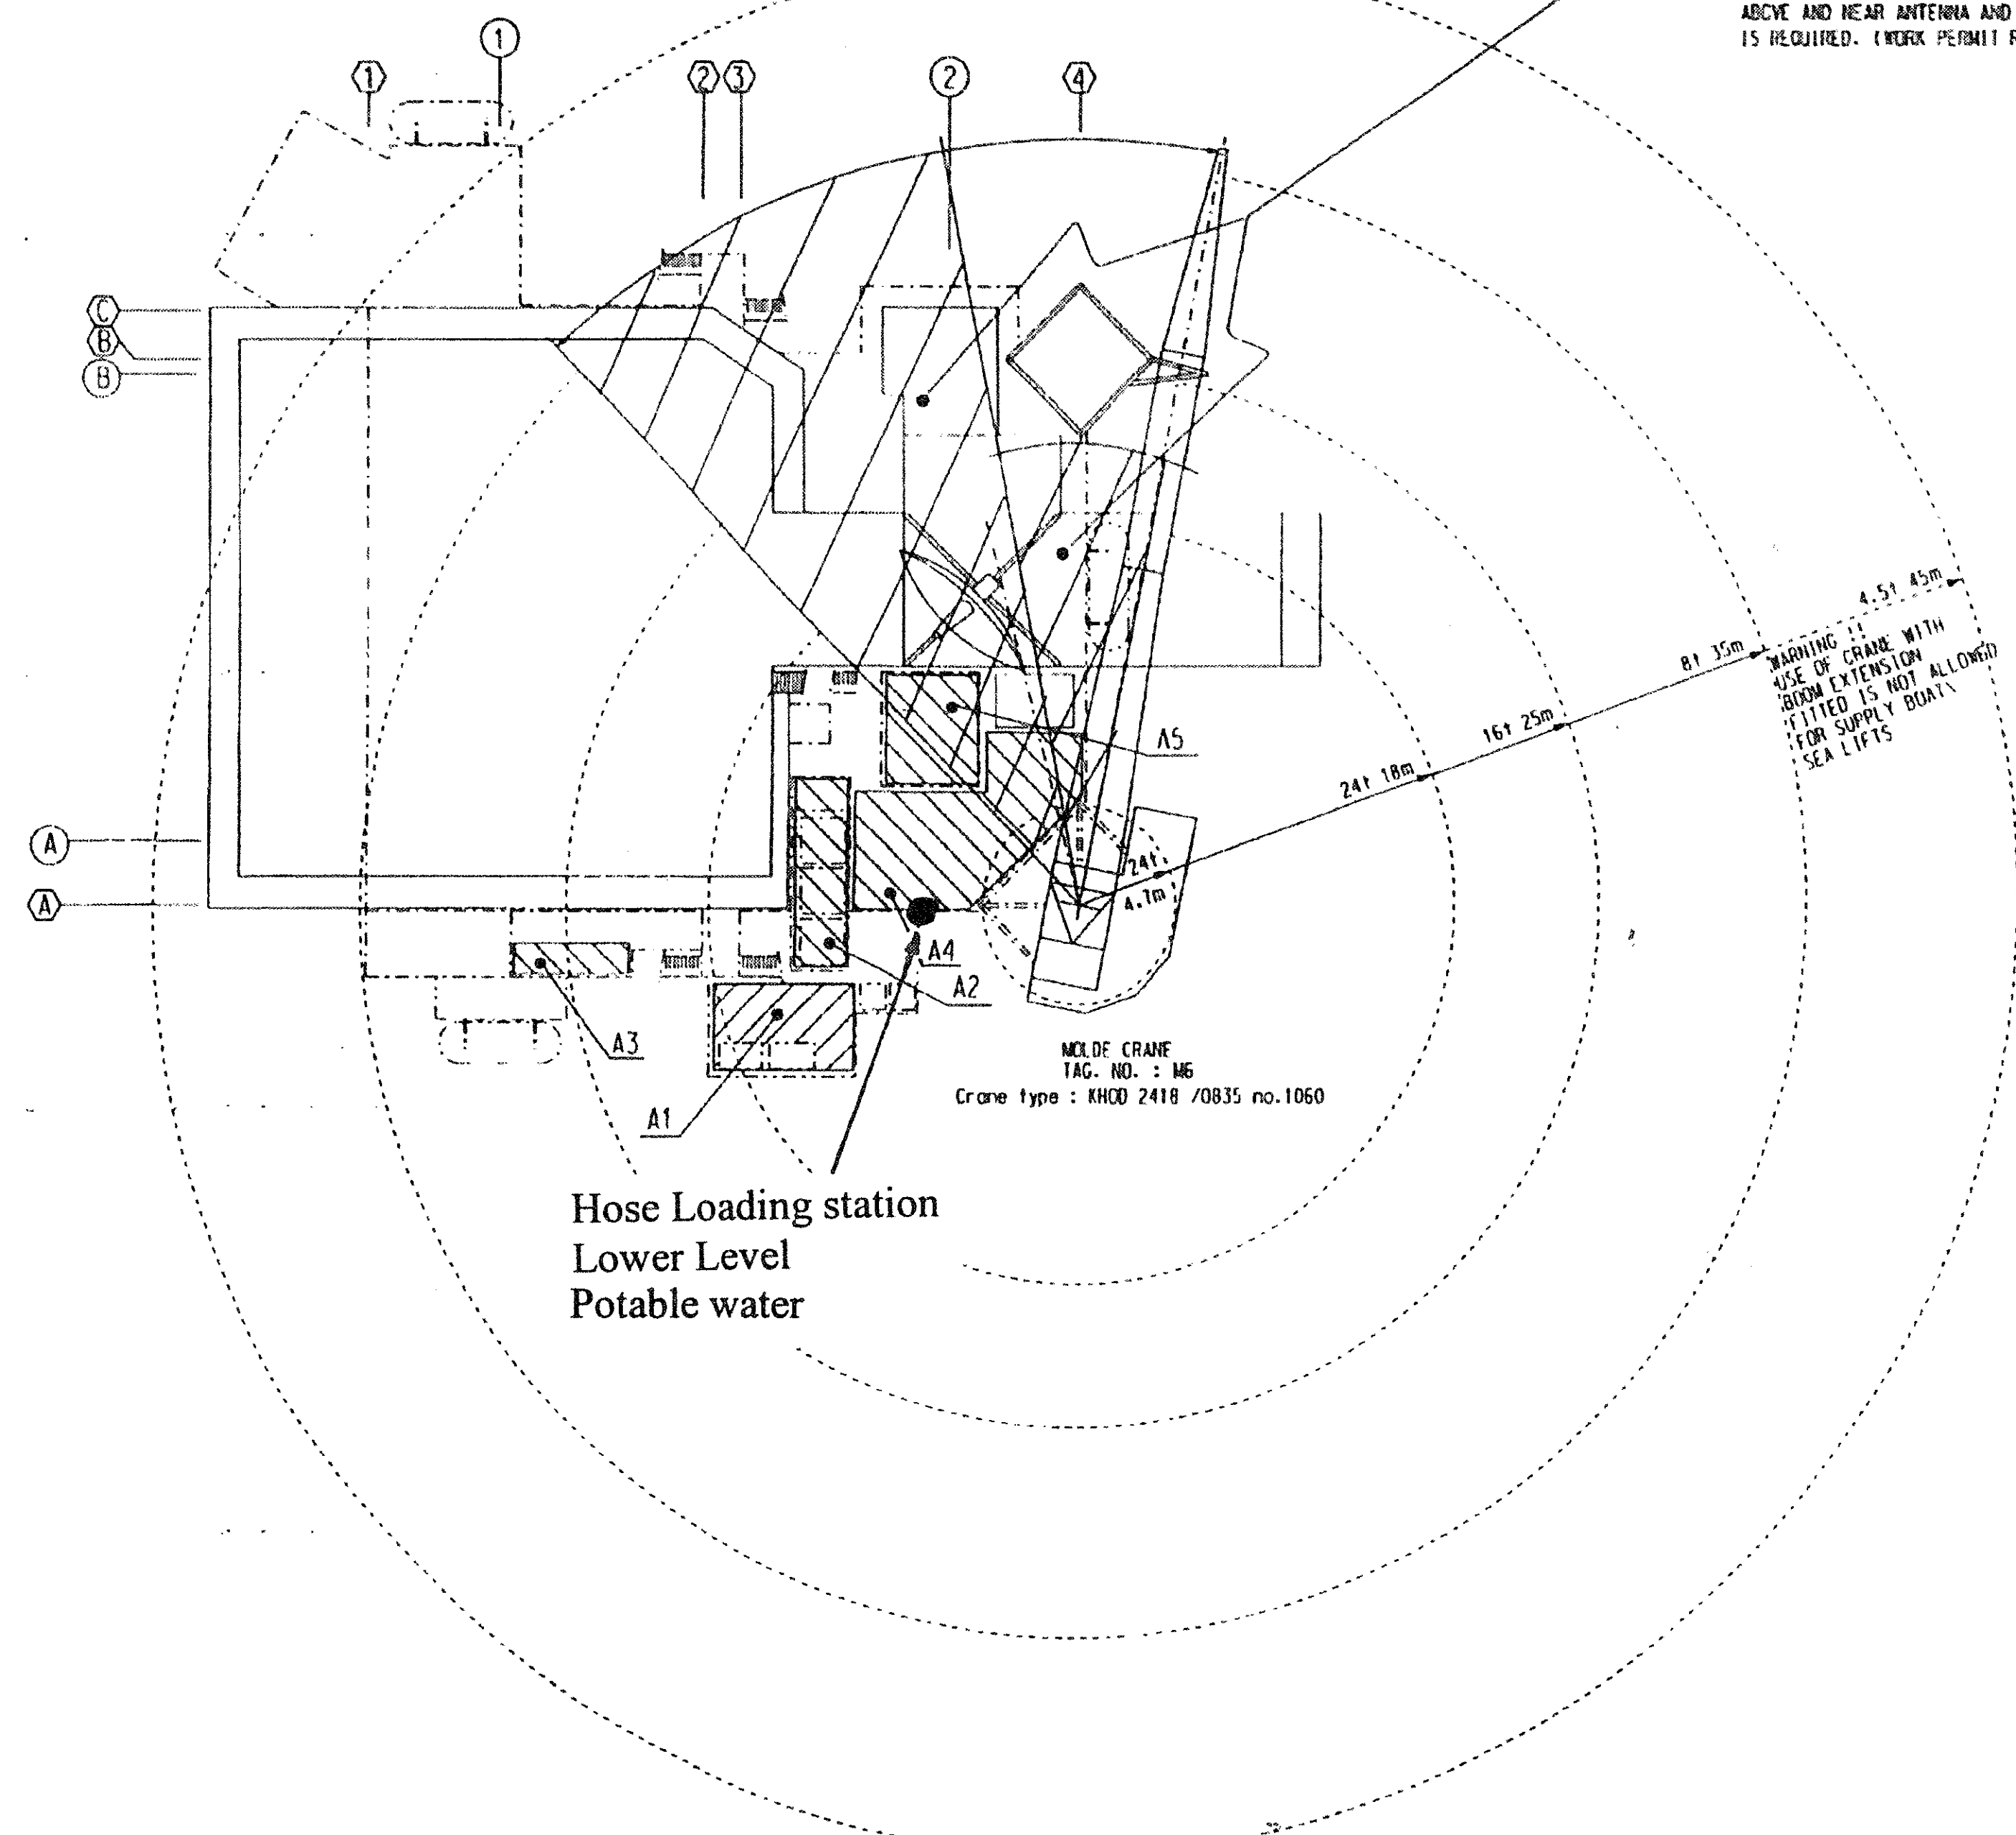

MOLDE CRANE
TAG. NO. : M6
Crane type : KH00 2418 /0835 no.1060

Hose Loading station
Lower Level
Potable water

FOR MOLDE CRANE M6 KH00 2418/0835 :
REF DYNAMIC LOAD CHART PR-FF-96-00-0130-(P24-26)

Rev.	Date	DESCRIPTION	By	Checked	Approved	Released
05F	21.01.05	REMOVED LAYDOWN TABLE	OS	BN		
04F	21.08.03	REVISED TO COMPLY WITH COP 4	EH	EPOS		
03F	27.03.95	FRIGG PROJECT AS BUILT	TDO	WJ	WJ	S-RP
02E	25.10.93	APPR. FOR OFFSHORE CONSTR.	VI	OS	VI	DHS
01E	19.10.93	APPR. FOR OFFSHORE CONSTR.	VI			
00B	02.08.93	ISSUED FOR ELF INITIAL ASB	M.N	RSV		

CAD DRAWING
Aker Offshore Partner

elf petroleum norge o/s petco 88 - 008 Steavgr

Docopen 7115
System STRUCTURAL

Job no FD080
Scale 1:200

FRIGG CRANE REPL. PRG.
CRANE COVERAGE
PLAN

