

REFERENCES
1. GENERAL COORDINATES

UTM COORDINATES DATUM: NGO 77
 ZONE 31, CENTRAL MERIDIAN 3° EAST
 HORIZONTAL SKIFFS TO ED 50
 EL: NGO 77 } - E: ED 50 NORSNET } - 0,74m
 NI: NGO 77 } - NI: ED 50 NORSNET } - 5,28m
 GEOGRAPHICAL COORDINATES DATUM: ED 50

2. WELLHEAD JACKET, PIPELINES, FLOW-LINES, CABLES.

- FROY 12" oil, 12" gas, 16" water injection and 2.5" service lines from met. compl. file: RE-PL-22-35-0517.
- FROY rigid spoils, mattresses and grout bags from Sleno Offshore a/s compl. file: SR-PL-22-35-1046.
- FROY electrical cable from ALCATEL completion file: FDD51.
- FROY rockdamping from Westminster Offshore compl. file: RE-PL-22-00-1229.


LEGEND

- Prohibited Anchoring Zones
- Safety Zones
- "Unproduct" Cable Protection
- Rock
- Grout Support bag
- SLP-Pipeform Stabilization mattress
- Unburied line
- Buried line or line in trench
- Trench start or end

WHP-PLATFORM CO-ORDINATES

CENTER OF WHP-PLATFORM IN ED50 - NGO 77.

PLATFORM	UTM			GEOGRAPHICAL		
	EASTING	NORTHING	ORIENTATION	LATITUDE	LONGITUDE	ORIENTATION
FROY-WHP	475333.2	6022063.0	312.4°	59°44'03.80"	2°33'27.91"	312.0°

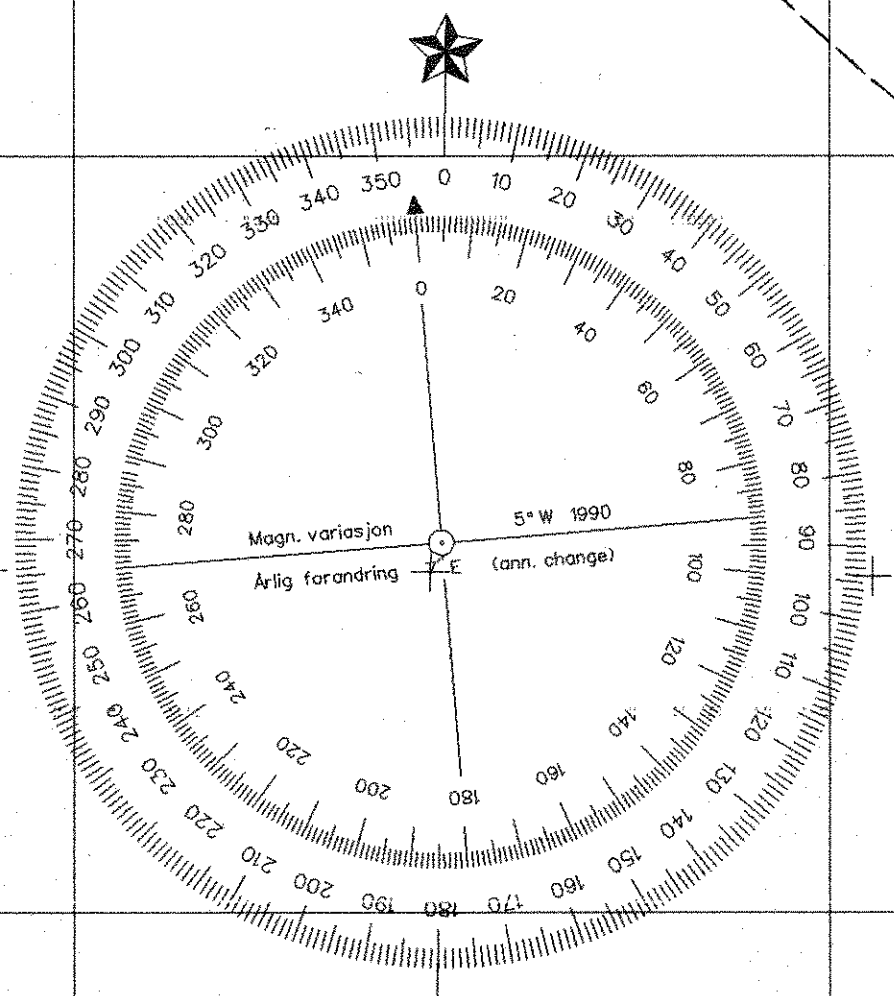

Rev.	date	DESCRIPTION	by	chkd	appd
02F	14.3.95	ADDED SAFETY ZONES / PROHIBITED ANCHORING ZONES	O.G.	B.G.	B.G.
01F	17.2.95	ADDED ROCKDAMPING 12" OIL & 2.5" SERVICE LINES	O.G.	B.G.	B.G.
00F	14.11.94	"AS-BUILT"	O.G.	B.G.	B.G.
00B	16.05.94	FORMED FOR APPROVAL	O.G.	B.G.	B.G.

CAD DRAWING
 CAD FILE NR: 100068/Froy_2.dgn
 REFERENCE FILE: Froygrid.dgn
 Froy_01.dgn
 Froypl12.dgn
 Froy.dgn

elf petroleum norge a/s p.o.box 168 4001 Stavanger

Installation System

FROY FIELD
PLATFORM AND LINES
GENERAL LAYOUT
PROHIBITED ANCHORING ZONES
AND SAFETY ZONES

Scale: 1:2000

Draw no: FR 22 00 00 0006 02F 1/2