



PLAN VIEW EL 131510 TOS

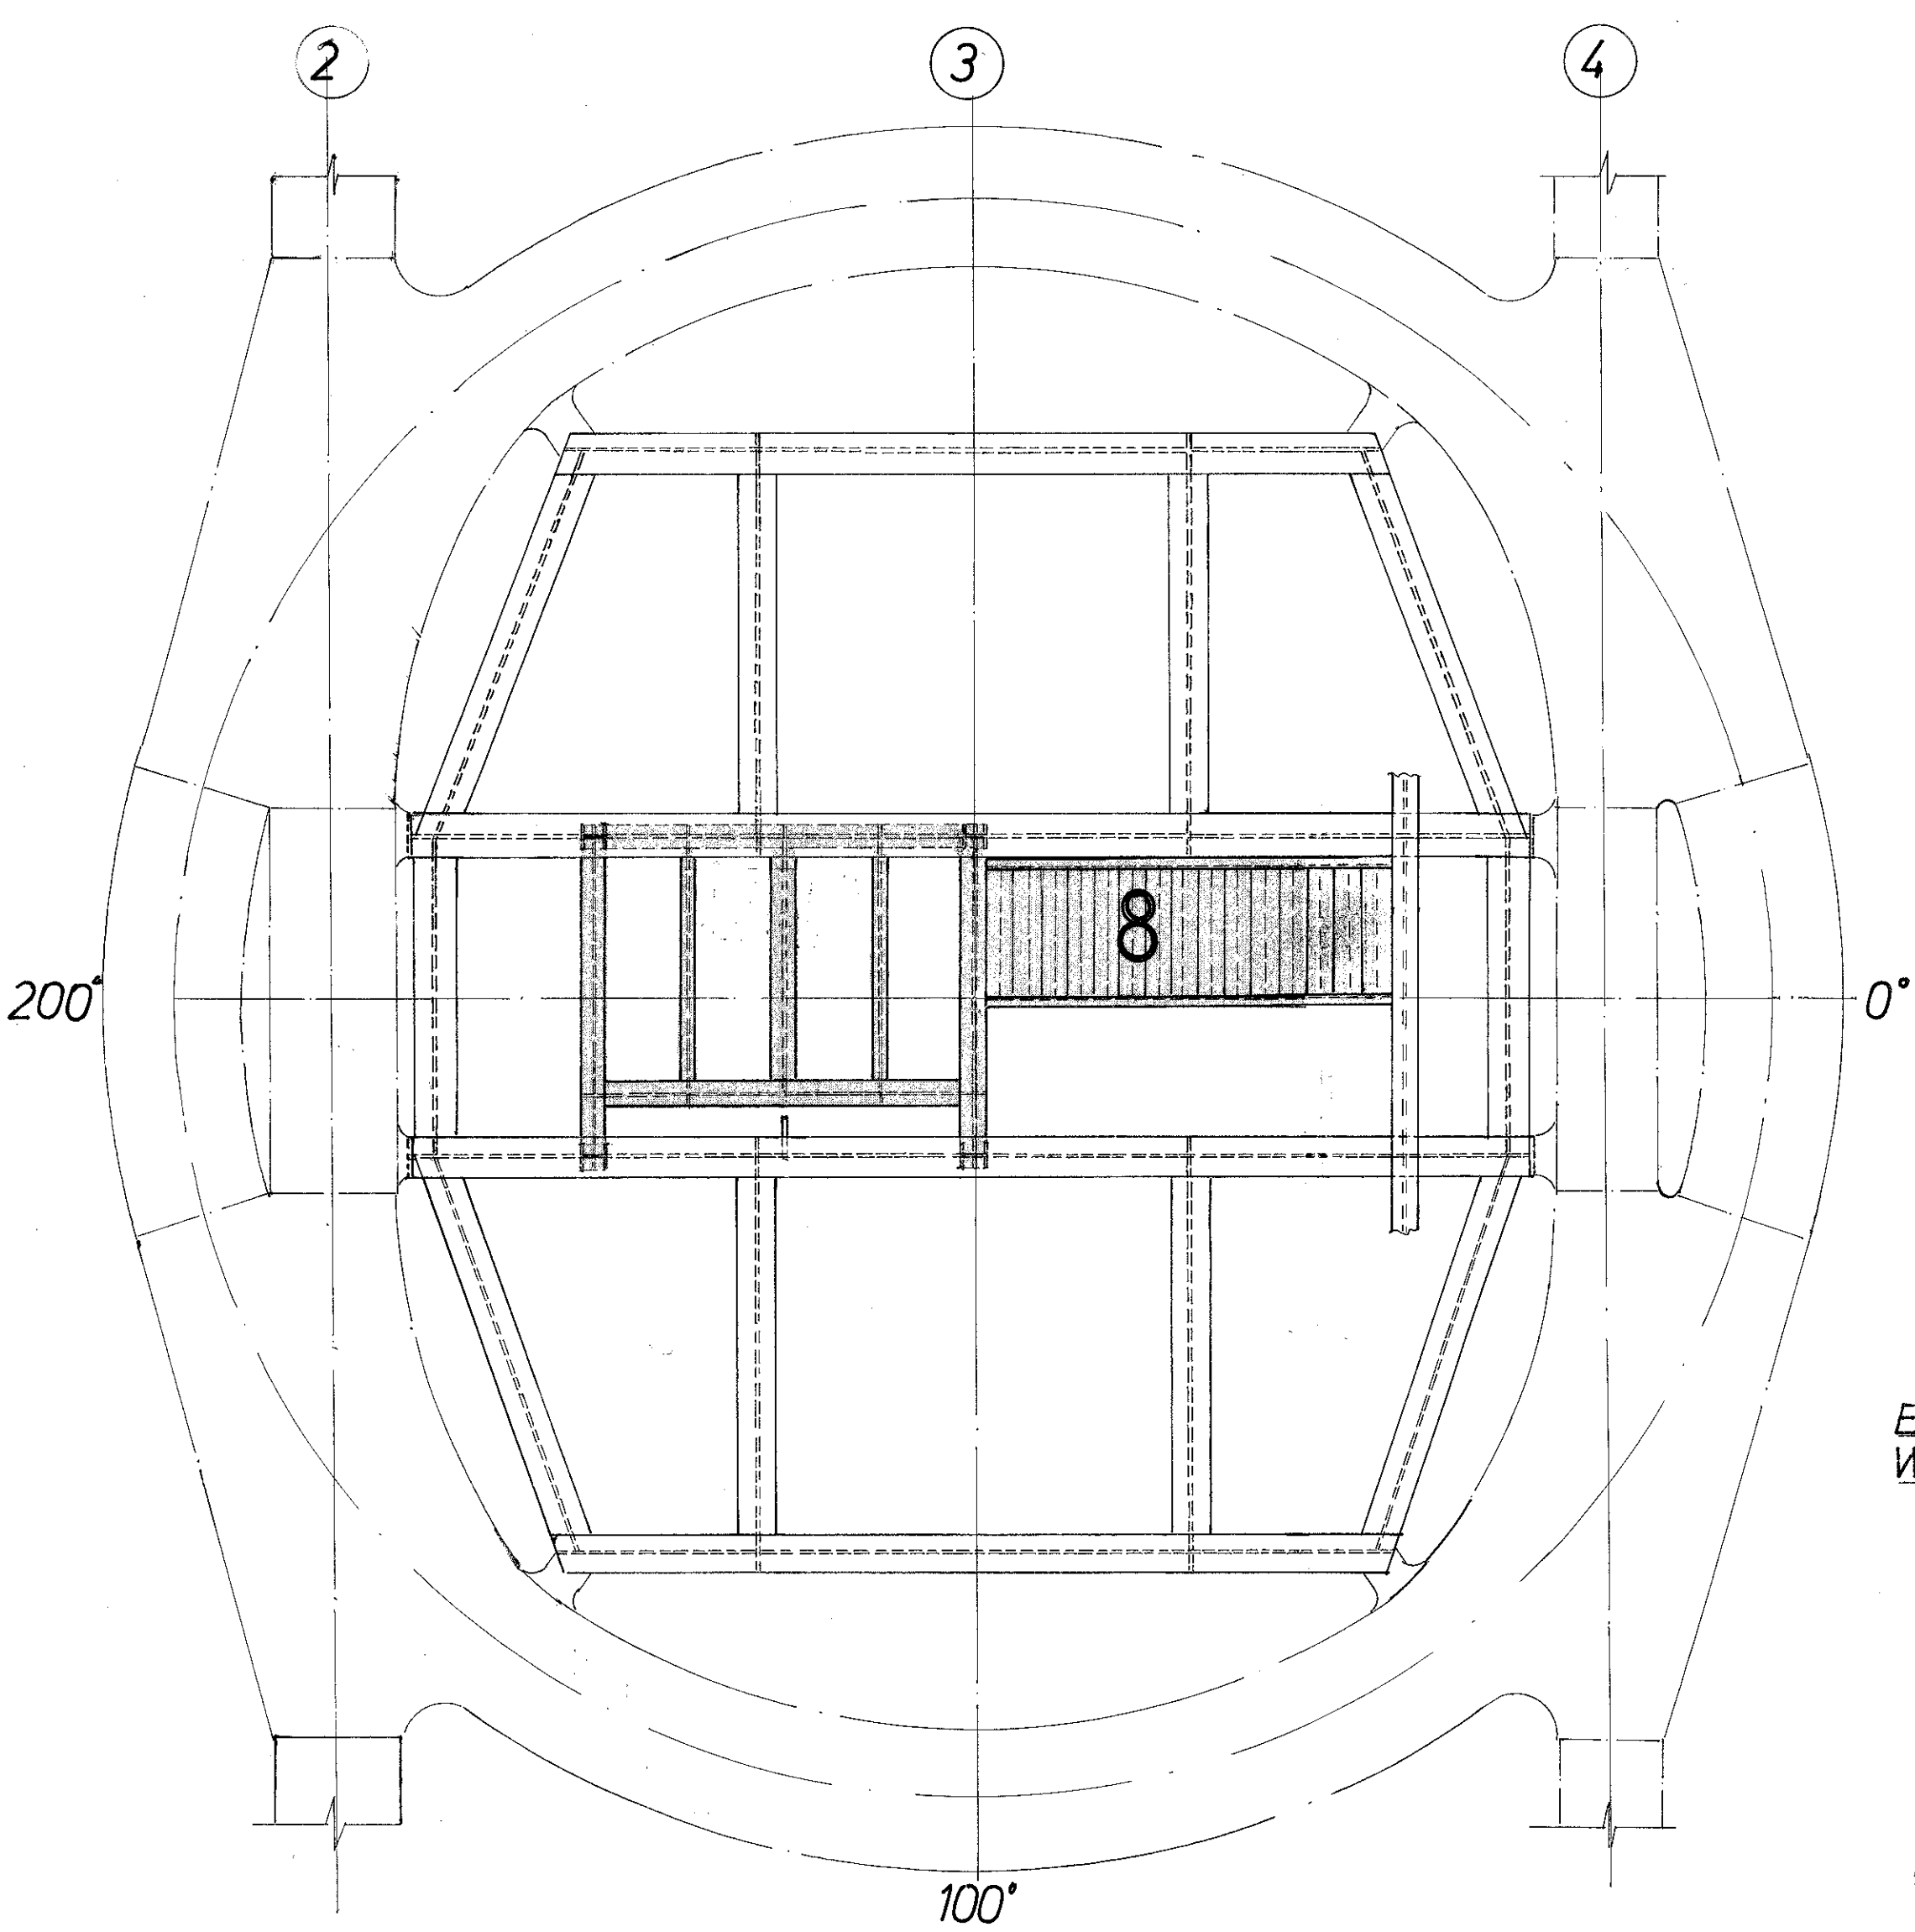

PLAN VIEW EL 127720 TOS

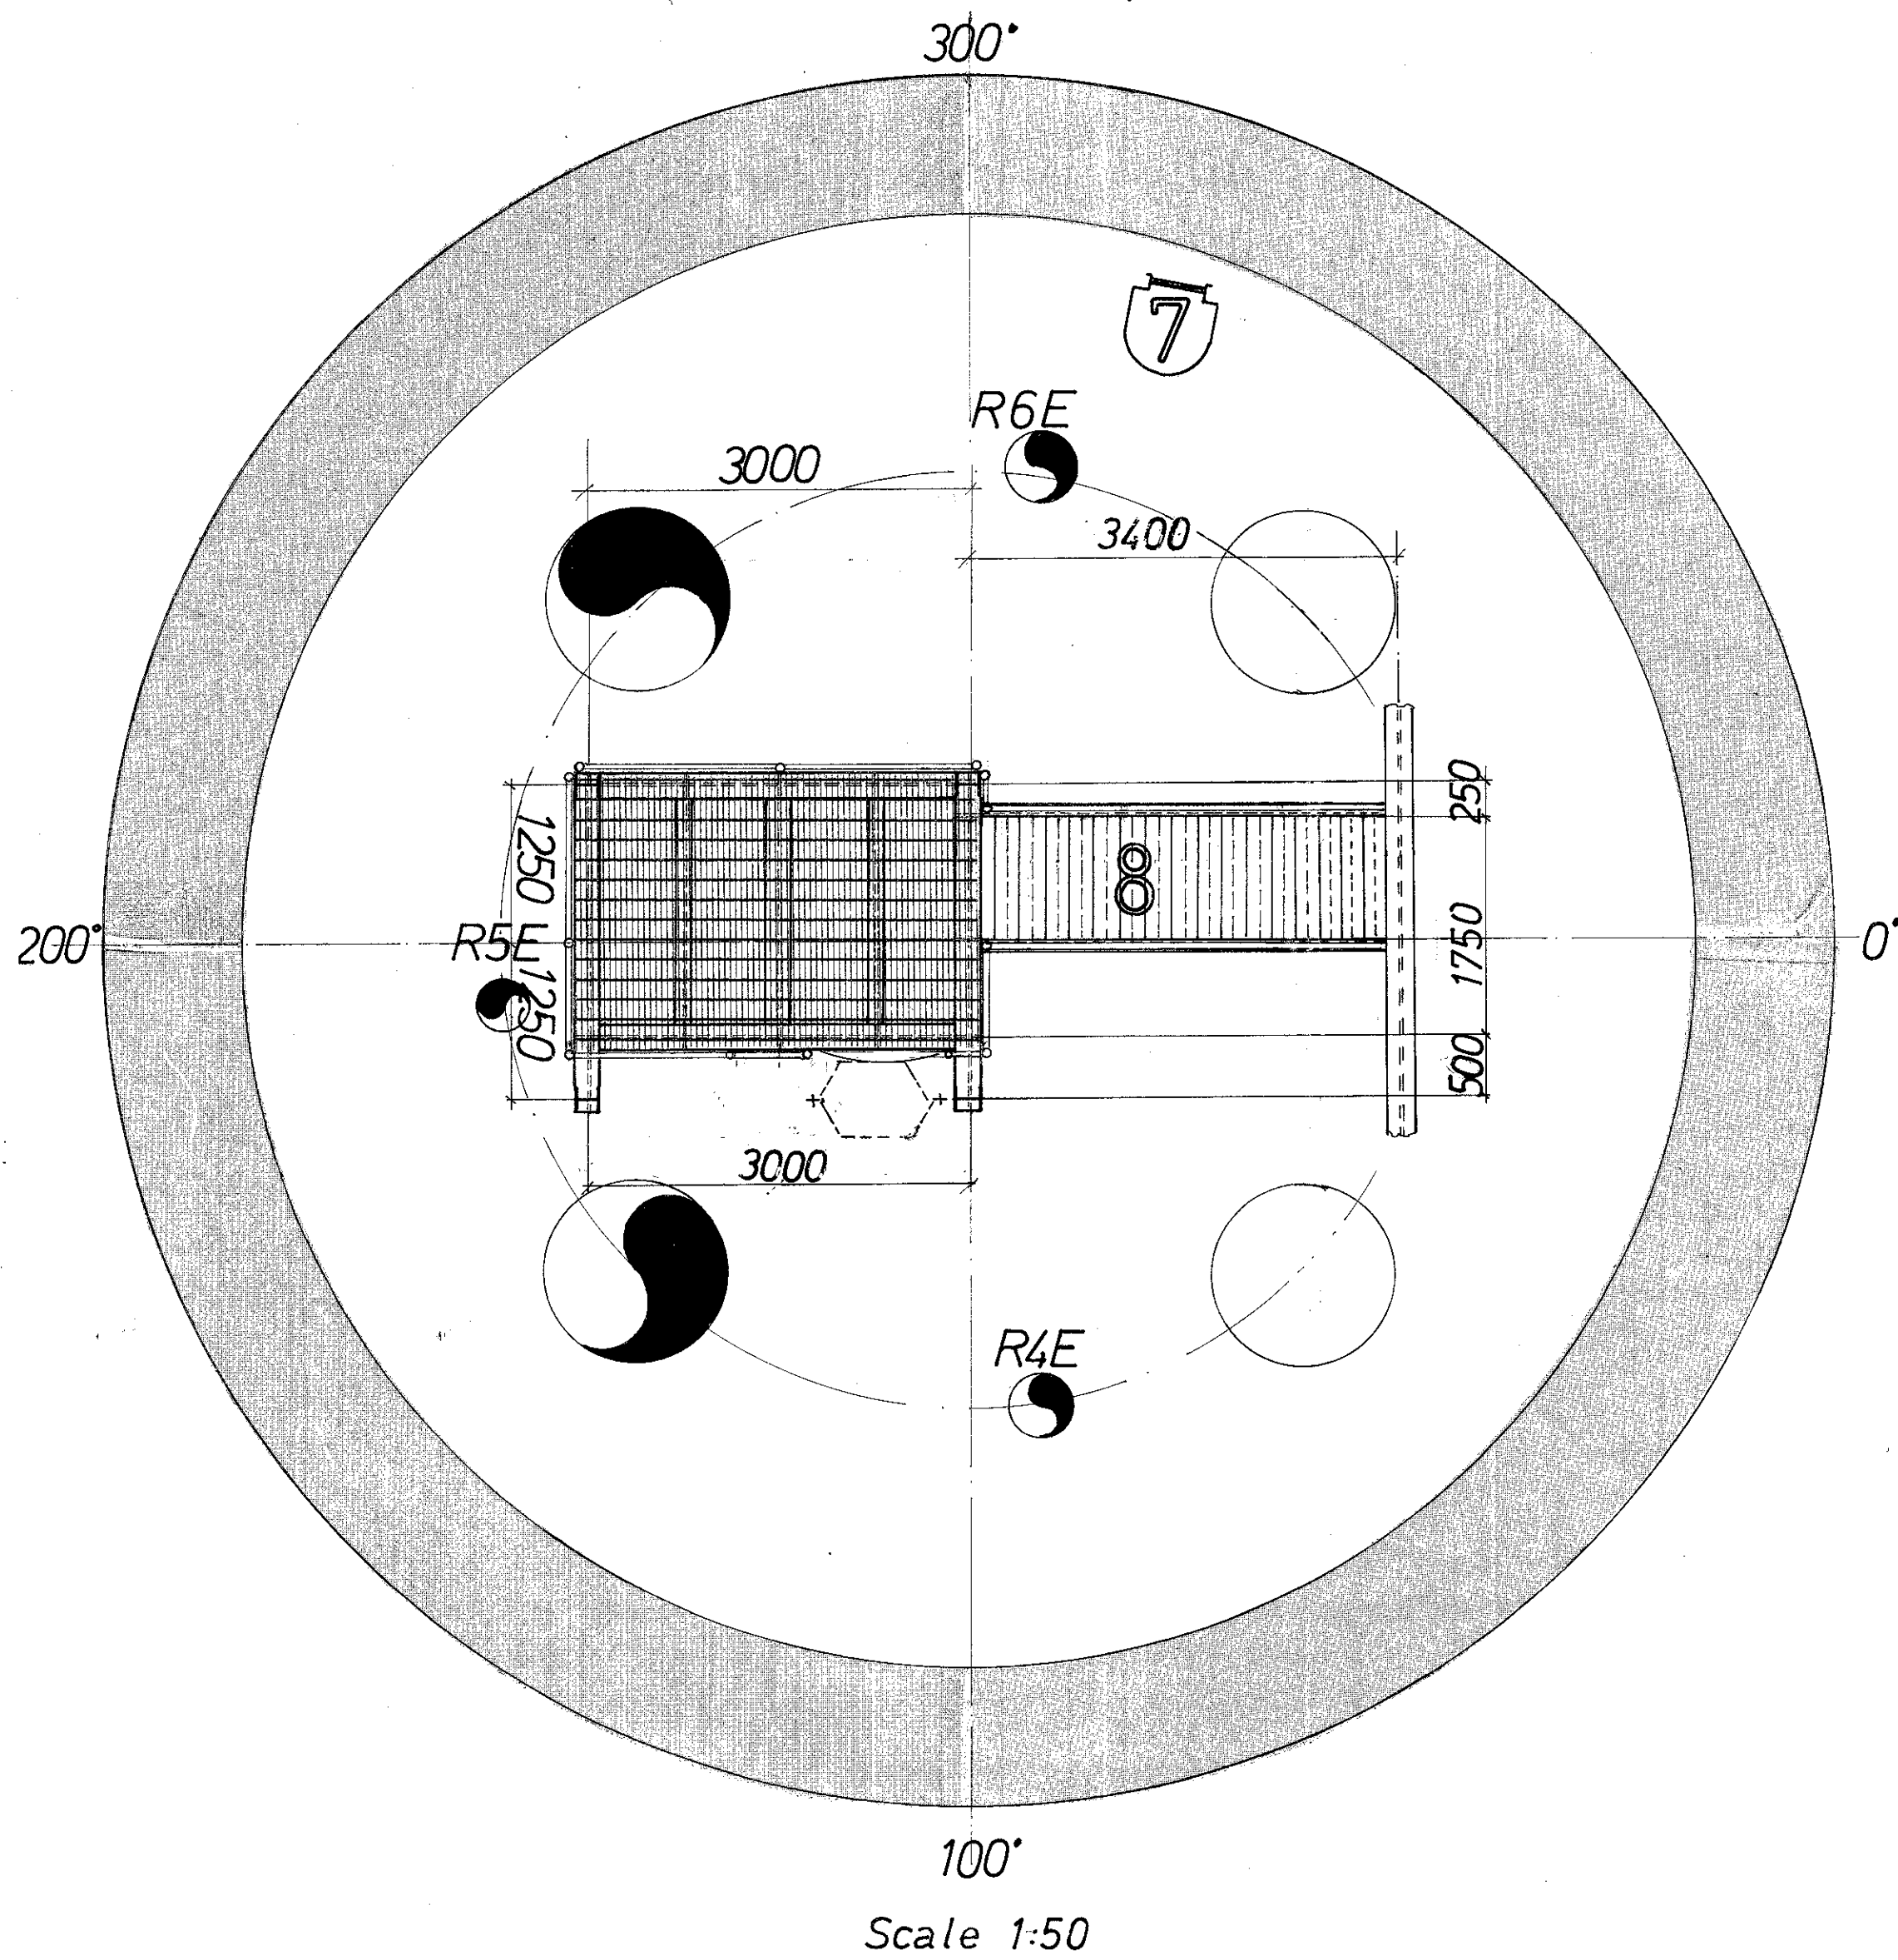

Scale 1:50

NOTES:

All new material to be RSt 37-2N or equal.
 1) New platforms at EL 127720 and EL 112720. 2) New beam in deck at EL 131700 and EL 131510.
 3) Stair from EL 131700 to EL 127720. 4) New beam at EL 116250. 5) Ladder from EL 116250 to EL 110250.
 6) New ladder inside tower from EL 110250 to EL 45250. 7) New beams in deck at EL 45250 and 8470.

PAINTING: All material to be painted acc. to ELF painting spec. 1052 no 3-498 rev 1. (Also existing ladder-tower.) All new stair, ladders, handrails and grating to be hot dip galvanised after fabrication.

GRATING: Type BULL. Design load: 5000 N, with serrated span bars, not to allow a 15 mm ball through the flooring.

HANDRAILS: All fixed type: FF 10 21 00 1000.

BOLT etc: All to be hot dip galvanised.

MAIN WINCH:

EMERGENCY WINCH:

GUIDING WIRES:

MAIN CRADLE: See dwg. FF 85 21 26.4074, 4079, 4076, 4066.

INSPECTION CRADLE: See dwg. FF 85 21 26.4072, 4077, 4066.

EMERGENCY CRADLE: See dwg. FF 85 21 26.4073, 4078, 4067.

REFERENCE DWG:

ELF: FF 85 21 26 4093

McDERMOTT - HUDSON: ELN 2177-B226-C226

KVAERNER - TECHNIP: 5424 W 5318 11650-2

BROWN & ROOT: A1 TCP-2-M443-M421-M424-M425-M426-M429-M557-M575-M576-M577-M578-M370-M371

CHRISTIANI NIELSEN: 33450-801, 33450-500

POTAIN: D 12 104 01 U 17 113 33

STANDARDS:


Gruveheisningsnett: Direktoratet for Arbeidstilsynet.

ELF; Fabrication: 1052 no 3-155 rev 2

Material: 1052 no 3-145 rev 4

Painting: 1052 no 5-498 rev 1


Design: NS 3472

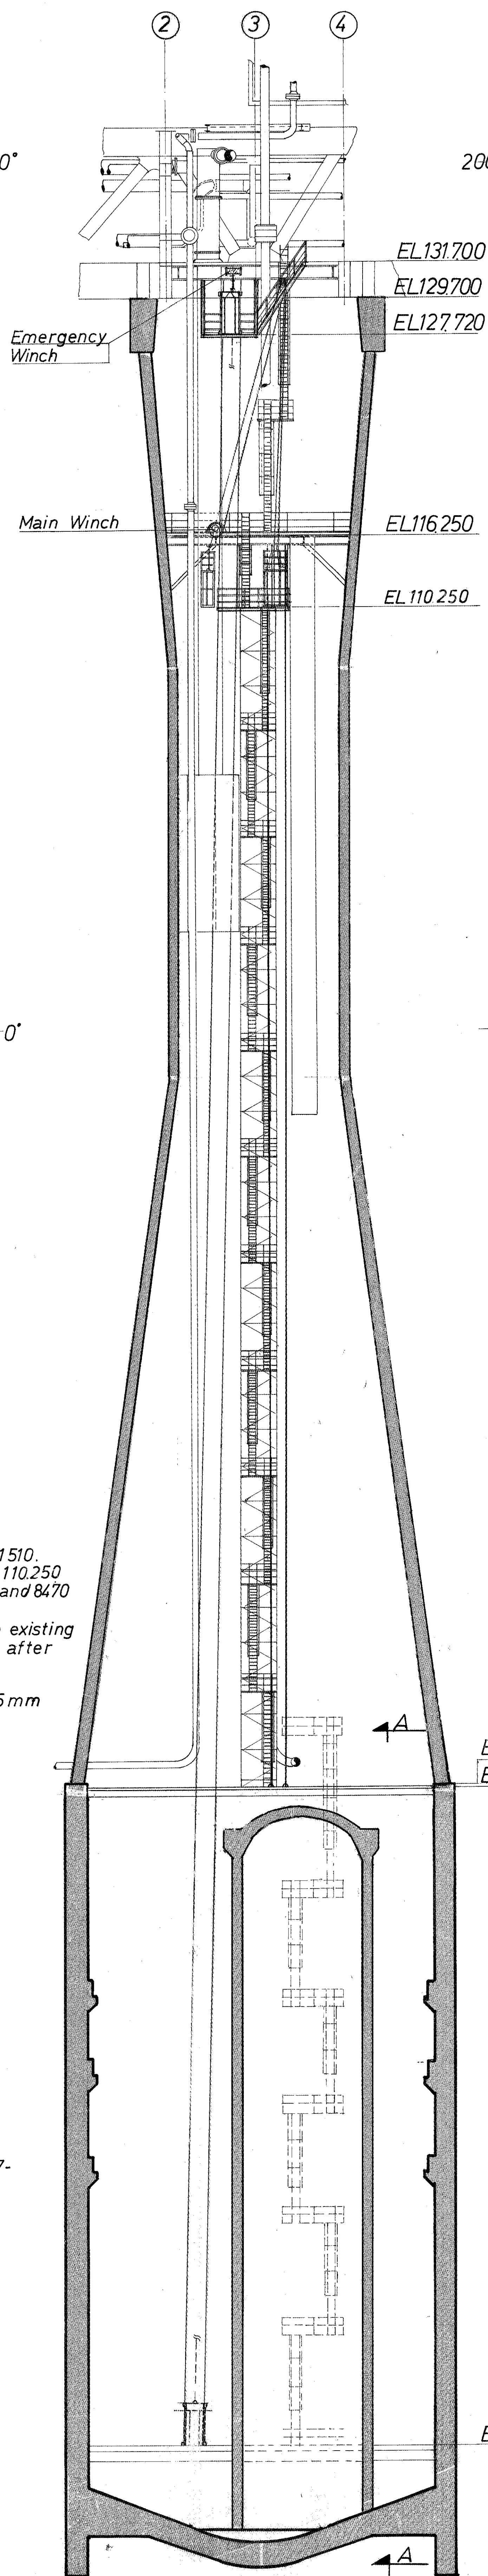


Scale 1:150

SECTION A-A

PLAN VIEW EL 131700 TOS

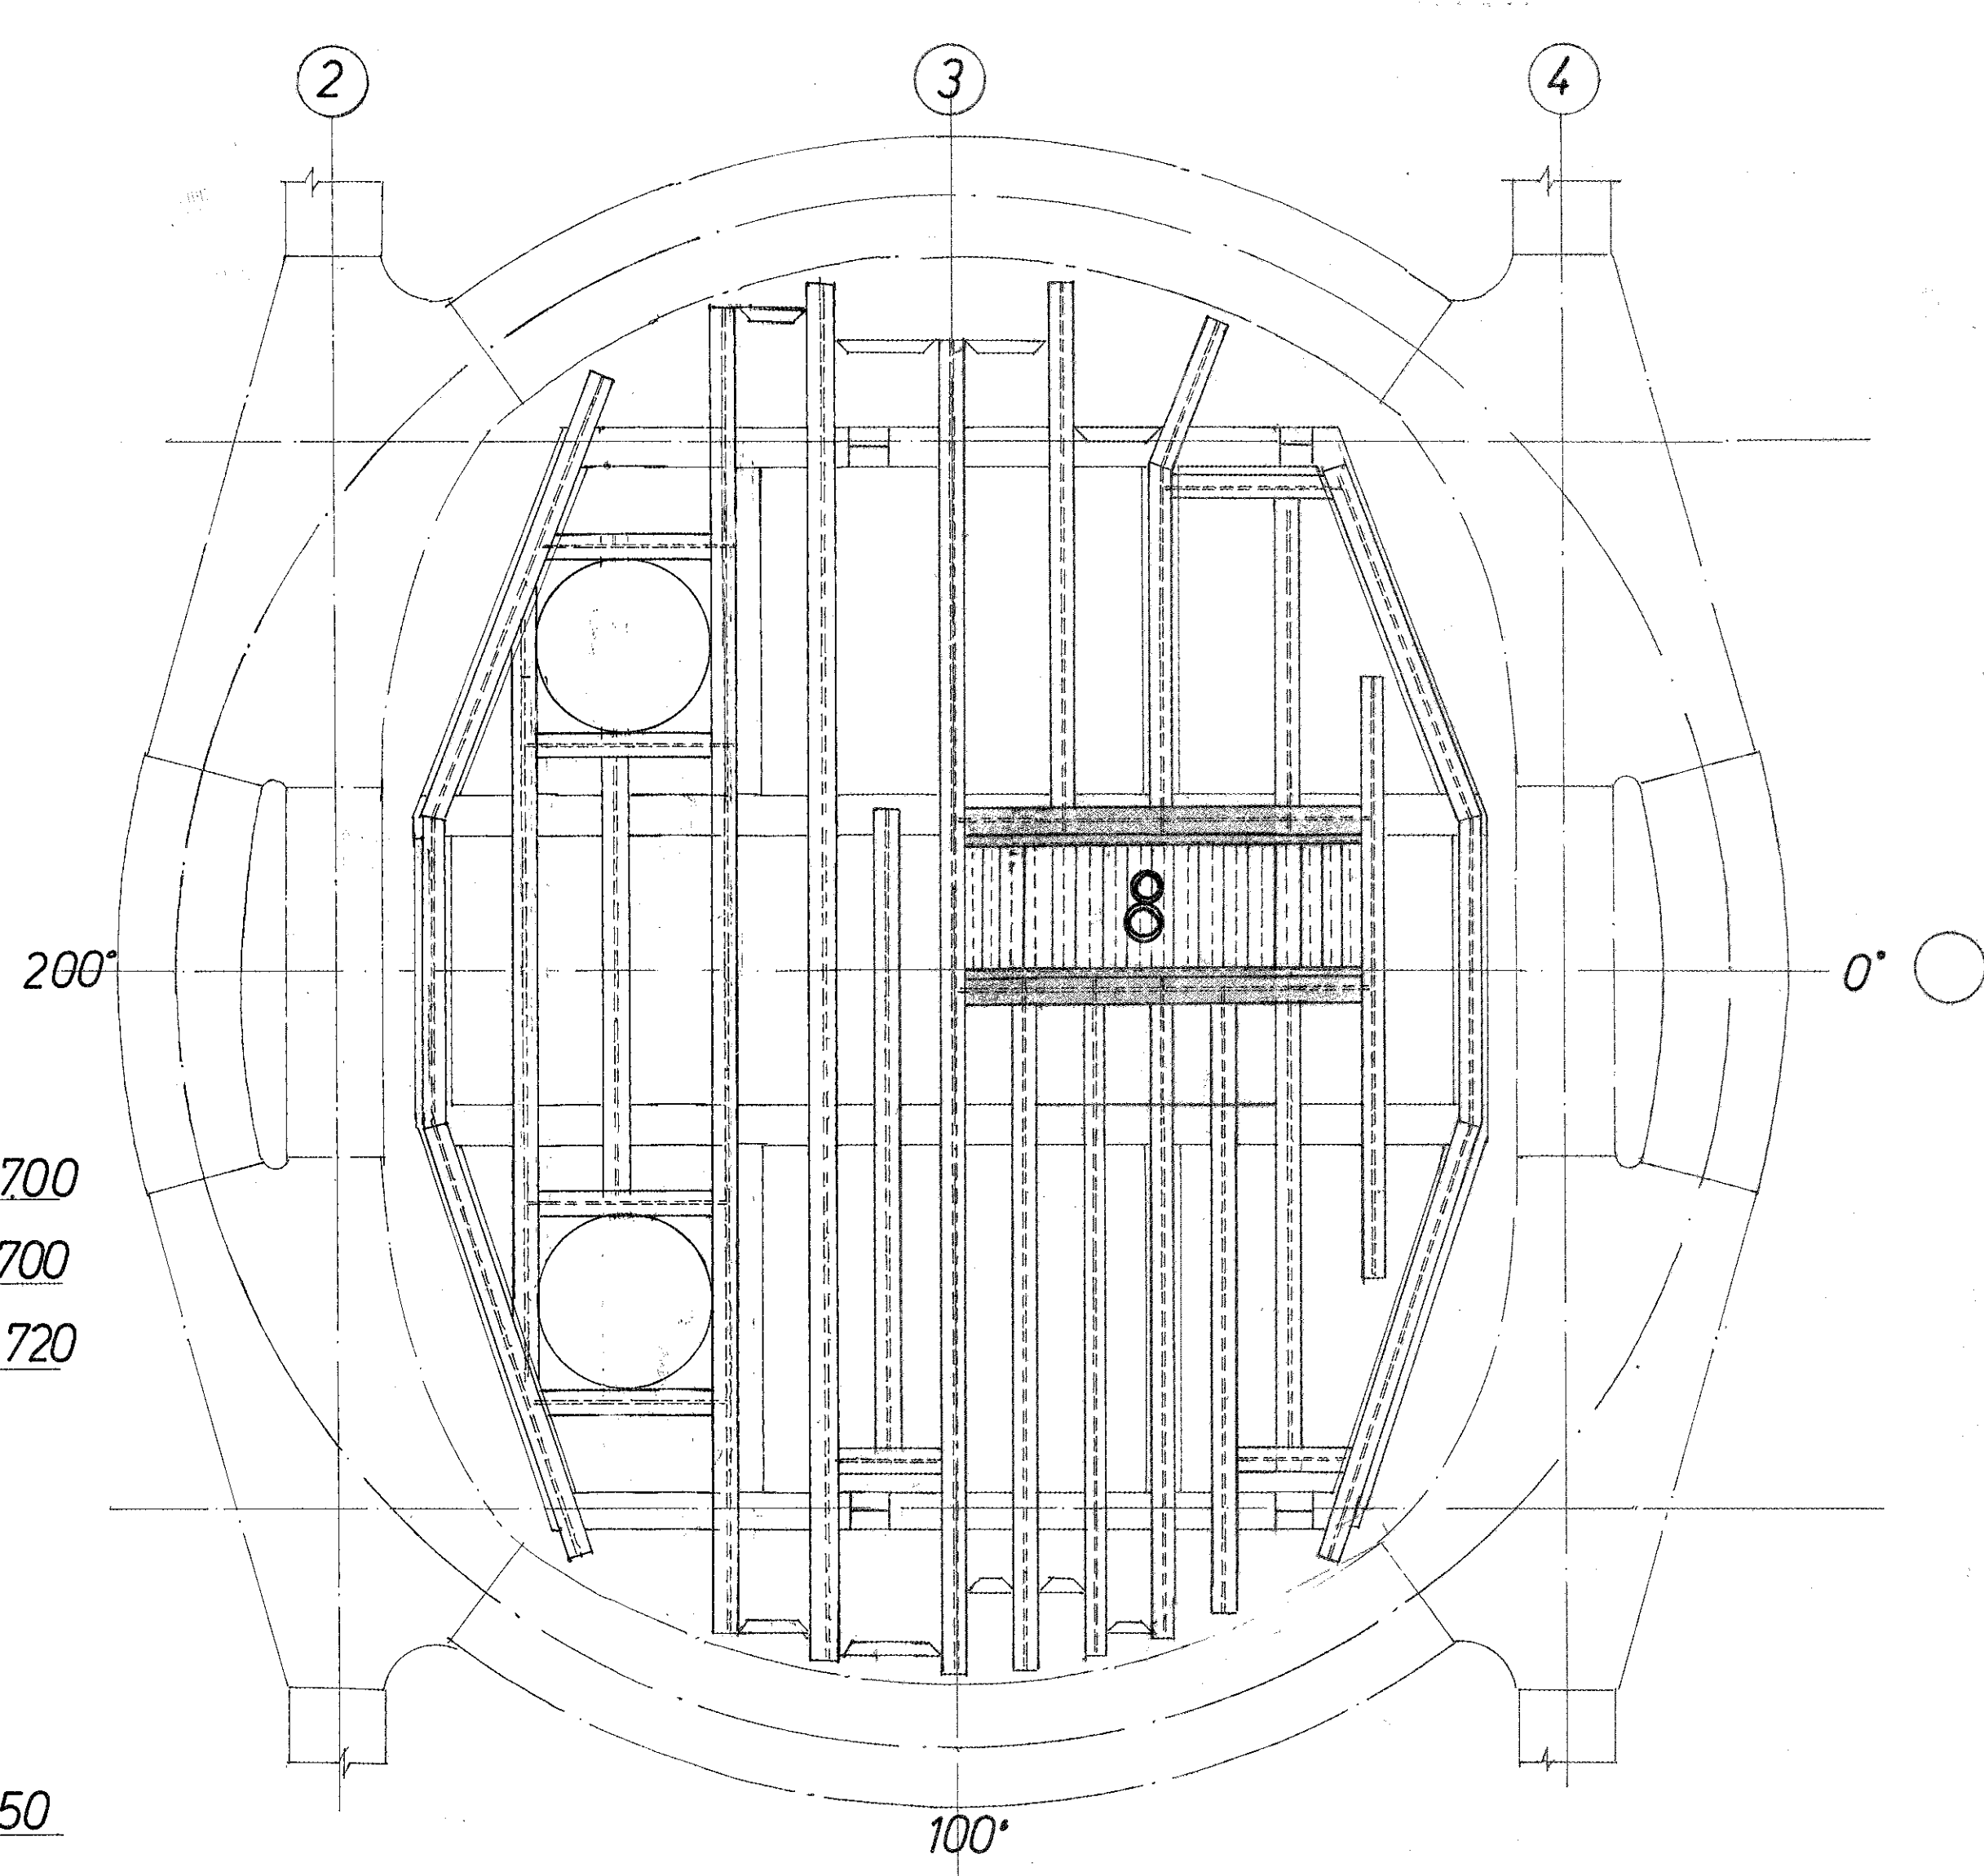

PLAN VIEW EL 131700 TOS AFTER TCP 2 EXTENSION INSTALLATION

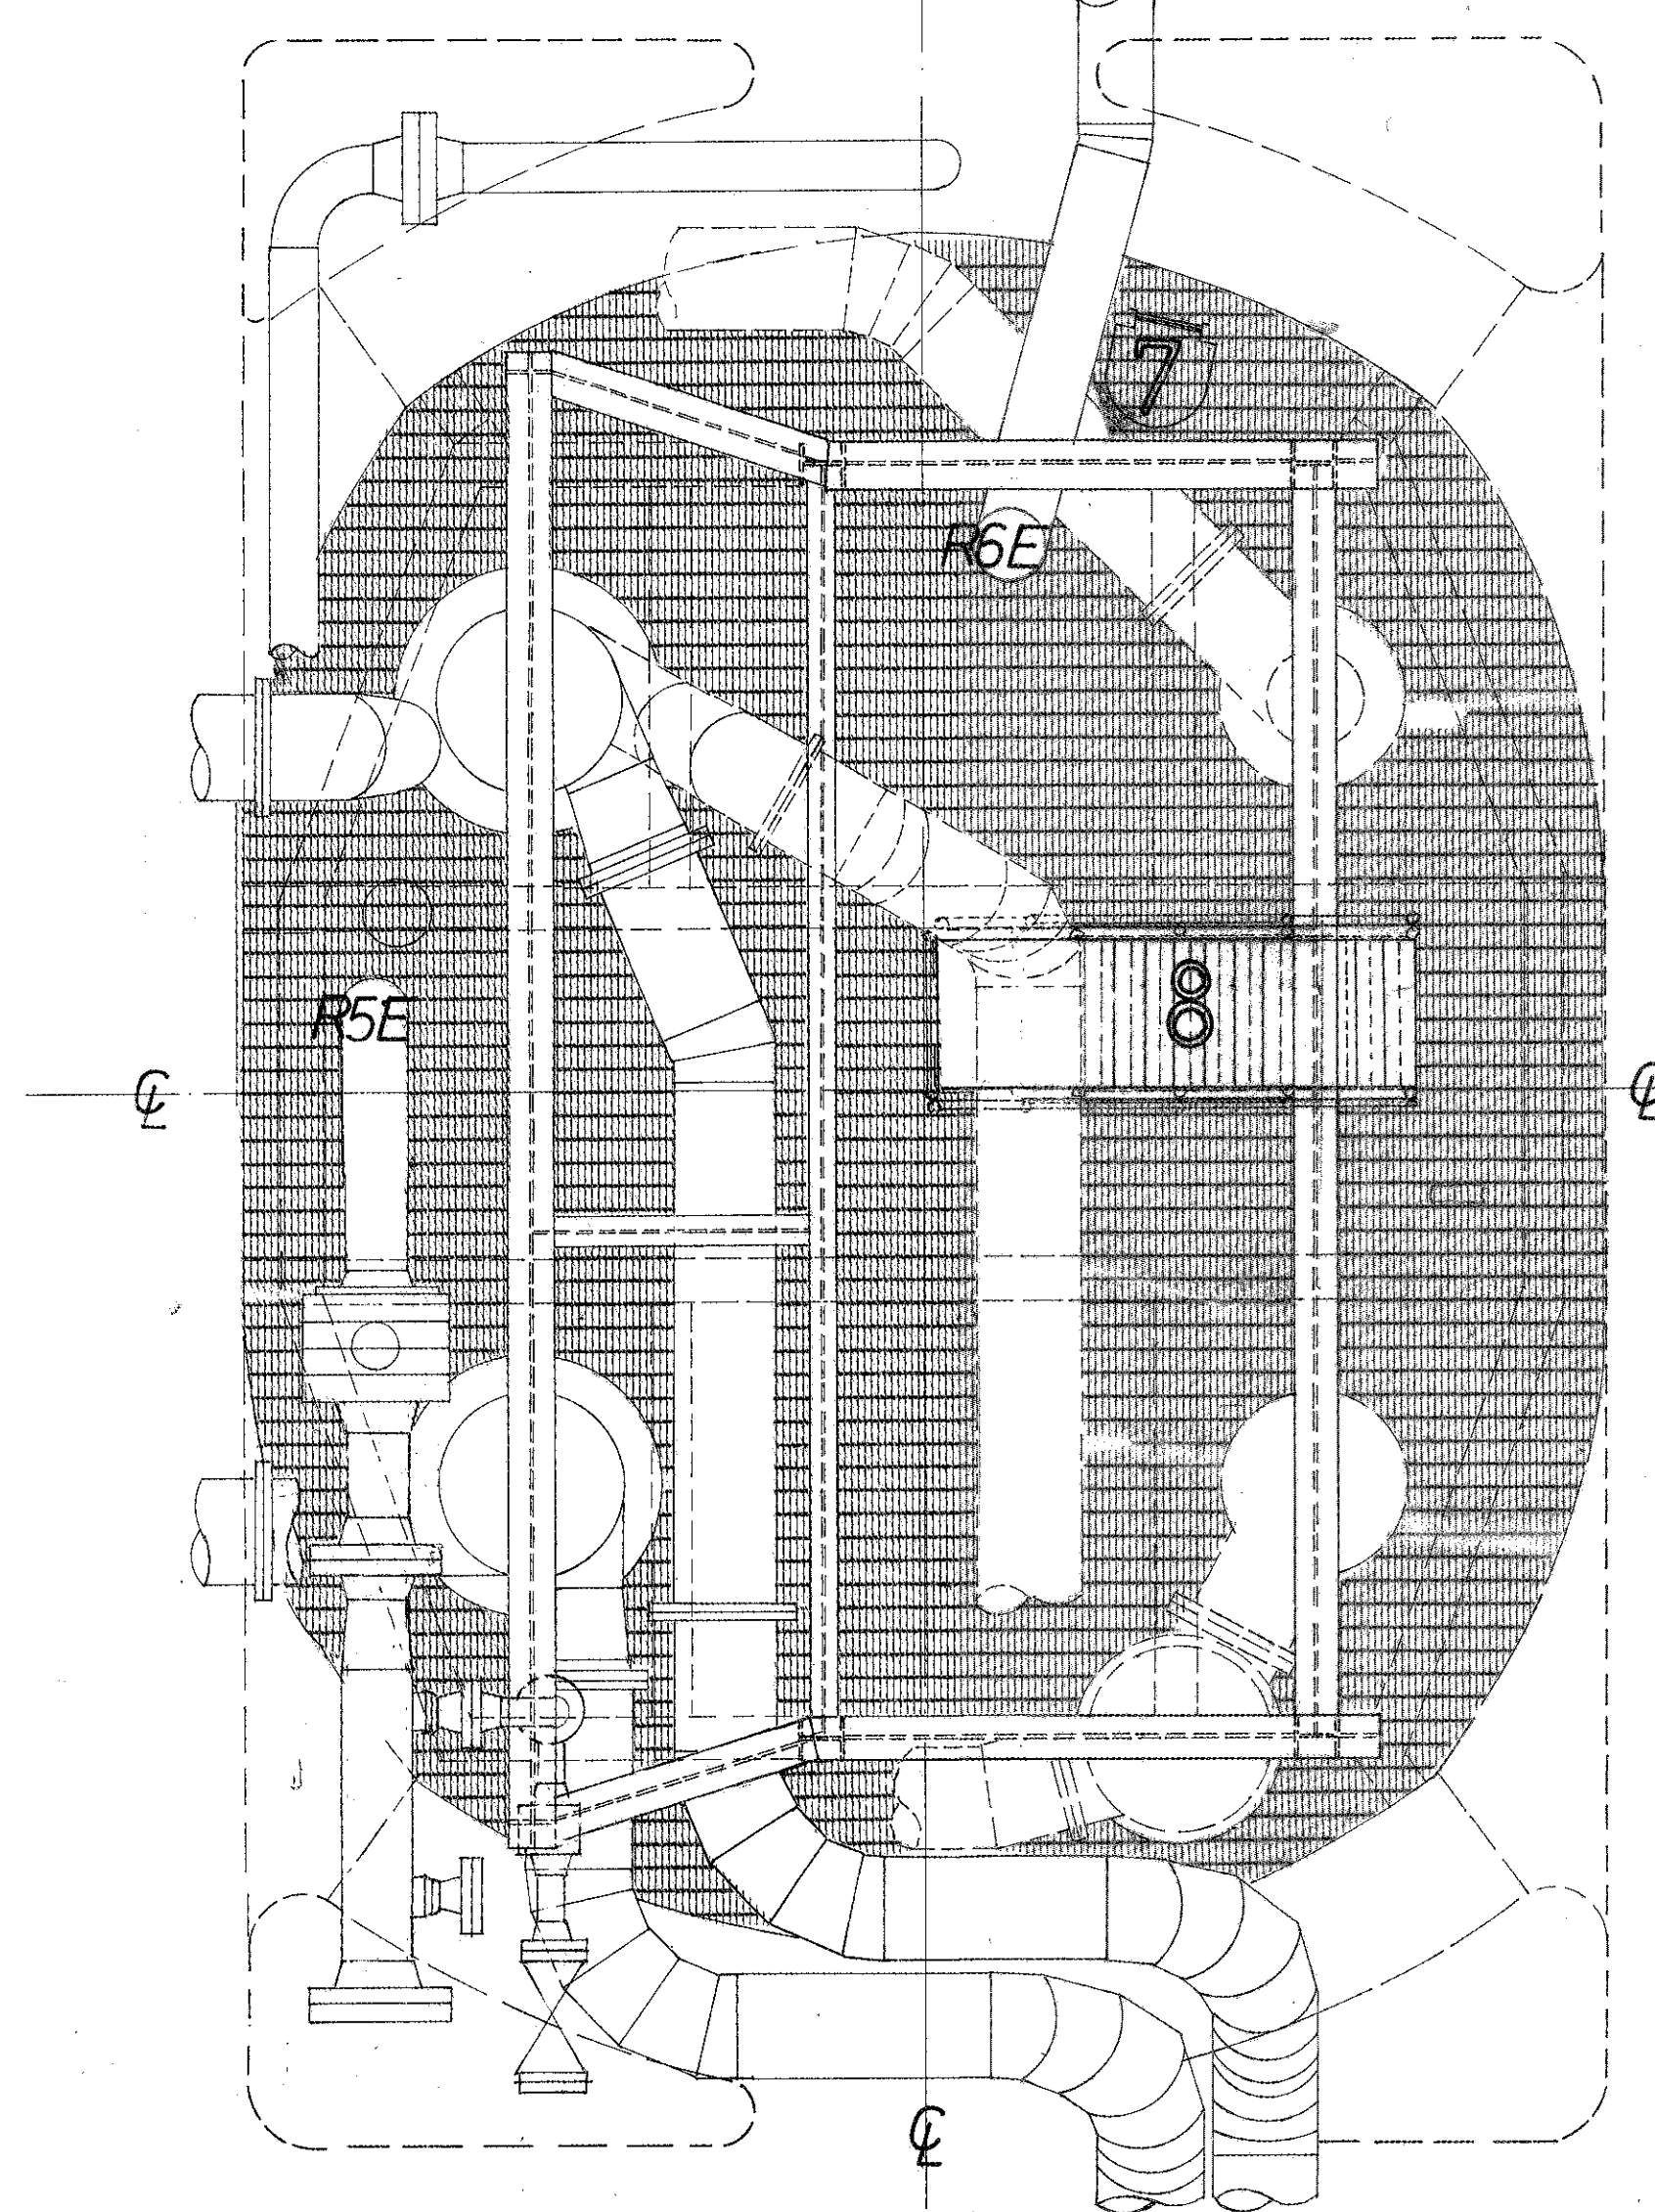


Scale 1:50

GENERAL NOTES:

For number on accesses see dwg. FF 85 2126 4046

FORM NO. 100.325 REV.0

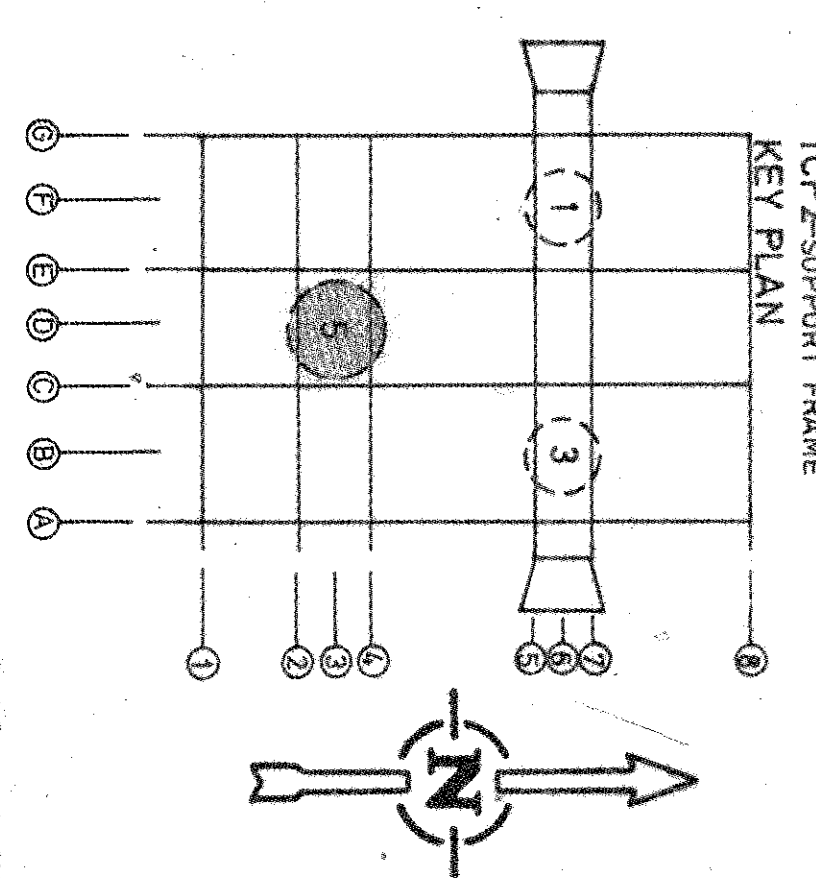

elf aquitaine norge a/s
**APPROVED
 FOR CONSTRUCTION**

NAME: D. SOLTVEDT
 SIGNATURE: *[Signature]*

AS BUILT

UP TO:

rev.	date	DESCRIPTION	by	app.
2	20.12.82	AS BUILT	af	
1	15.11.81	ISSUE FOR CONSTRUCTION	D.S.	D.S.
0	29.12.81	first issue	D.S.	

	elf aquitaine norge a/s p.o. box 168 - 4001 Stavanger	
	Installation	System
	TCP-2	STRUCTURAL
	GENERAL ARRANGEMENT ACCESSES IN COLUMN 5	
Job no. MR 85078		
Scale 1:150		
FRIGG FIELD	Dwg. no. FF 85 21 26 4045	Rev. 2
		Sheet 1/1