



PLAN VIEW EL 115600

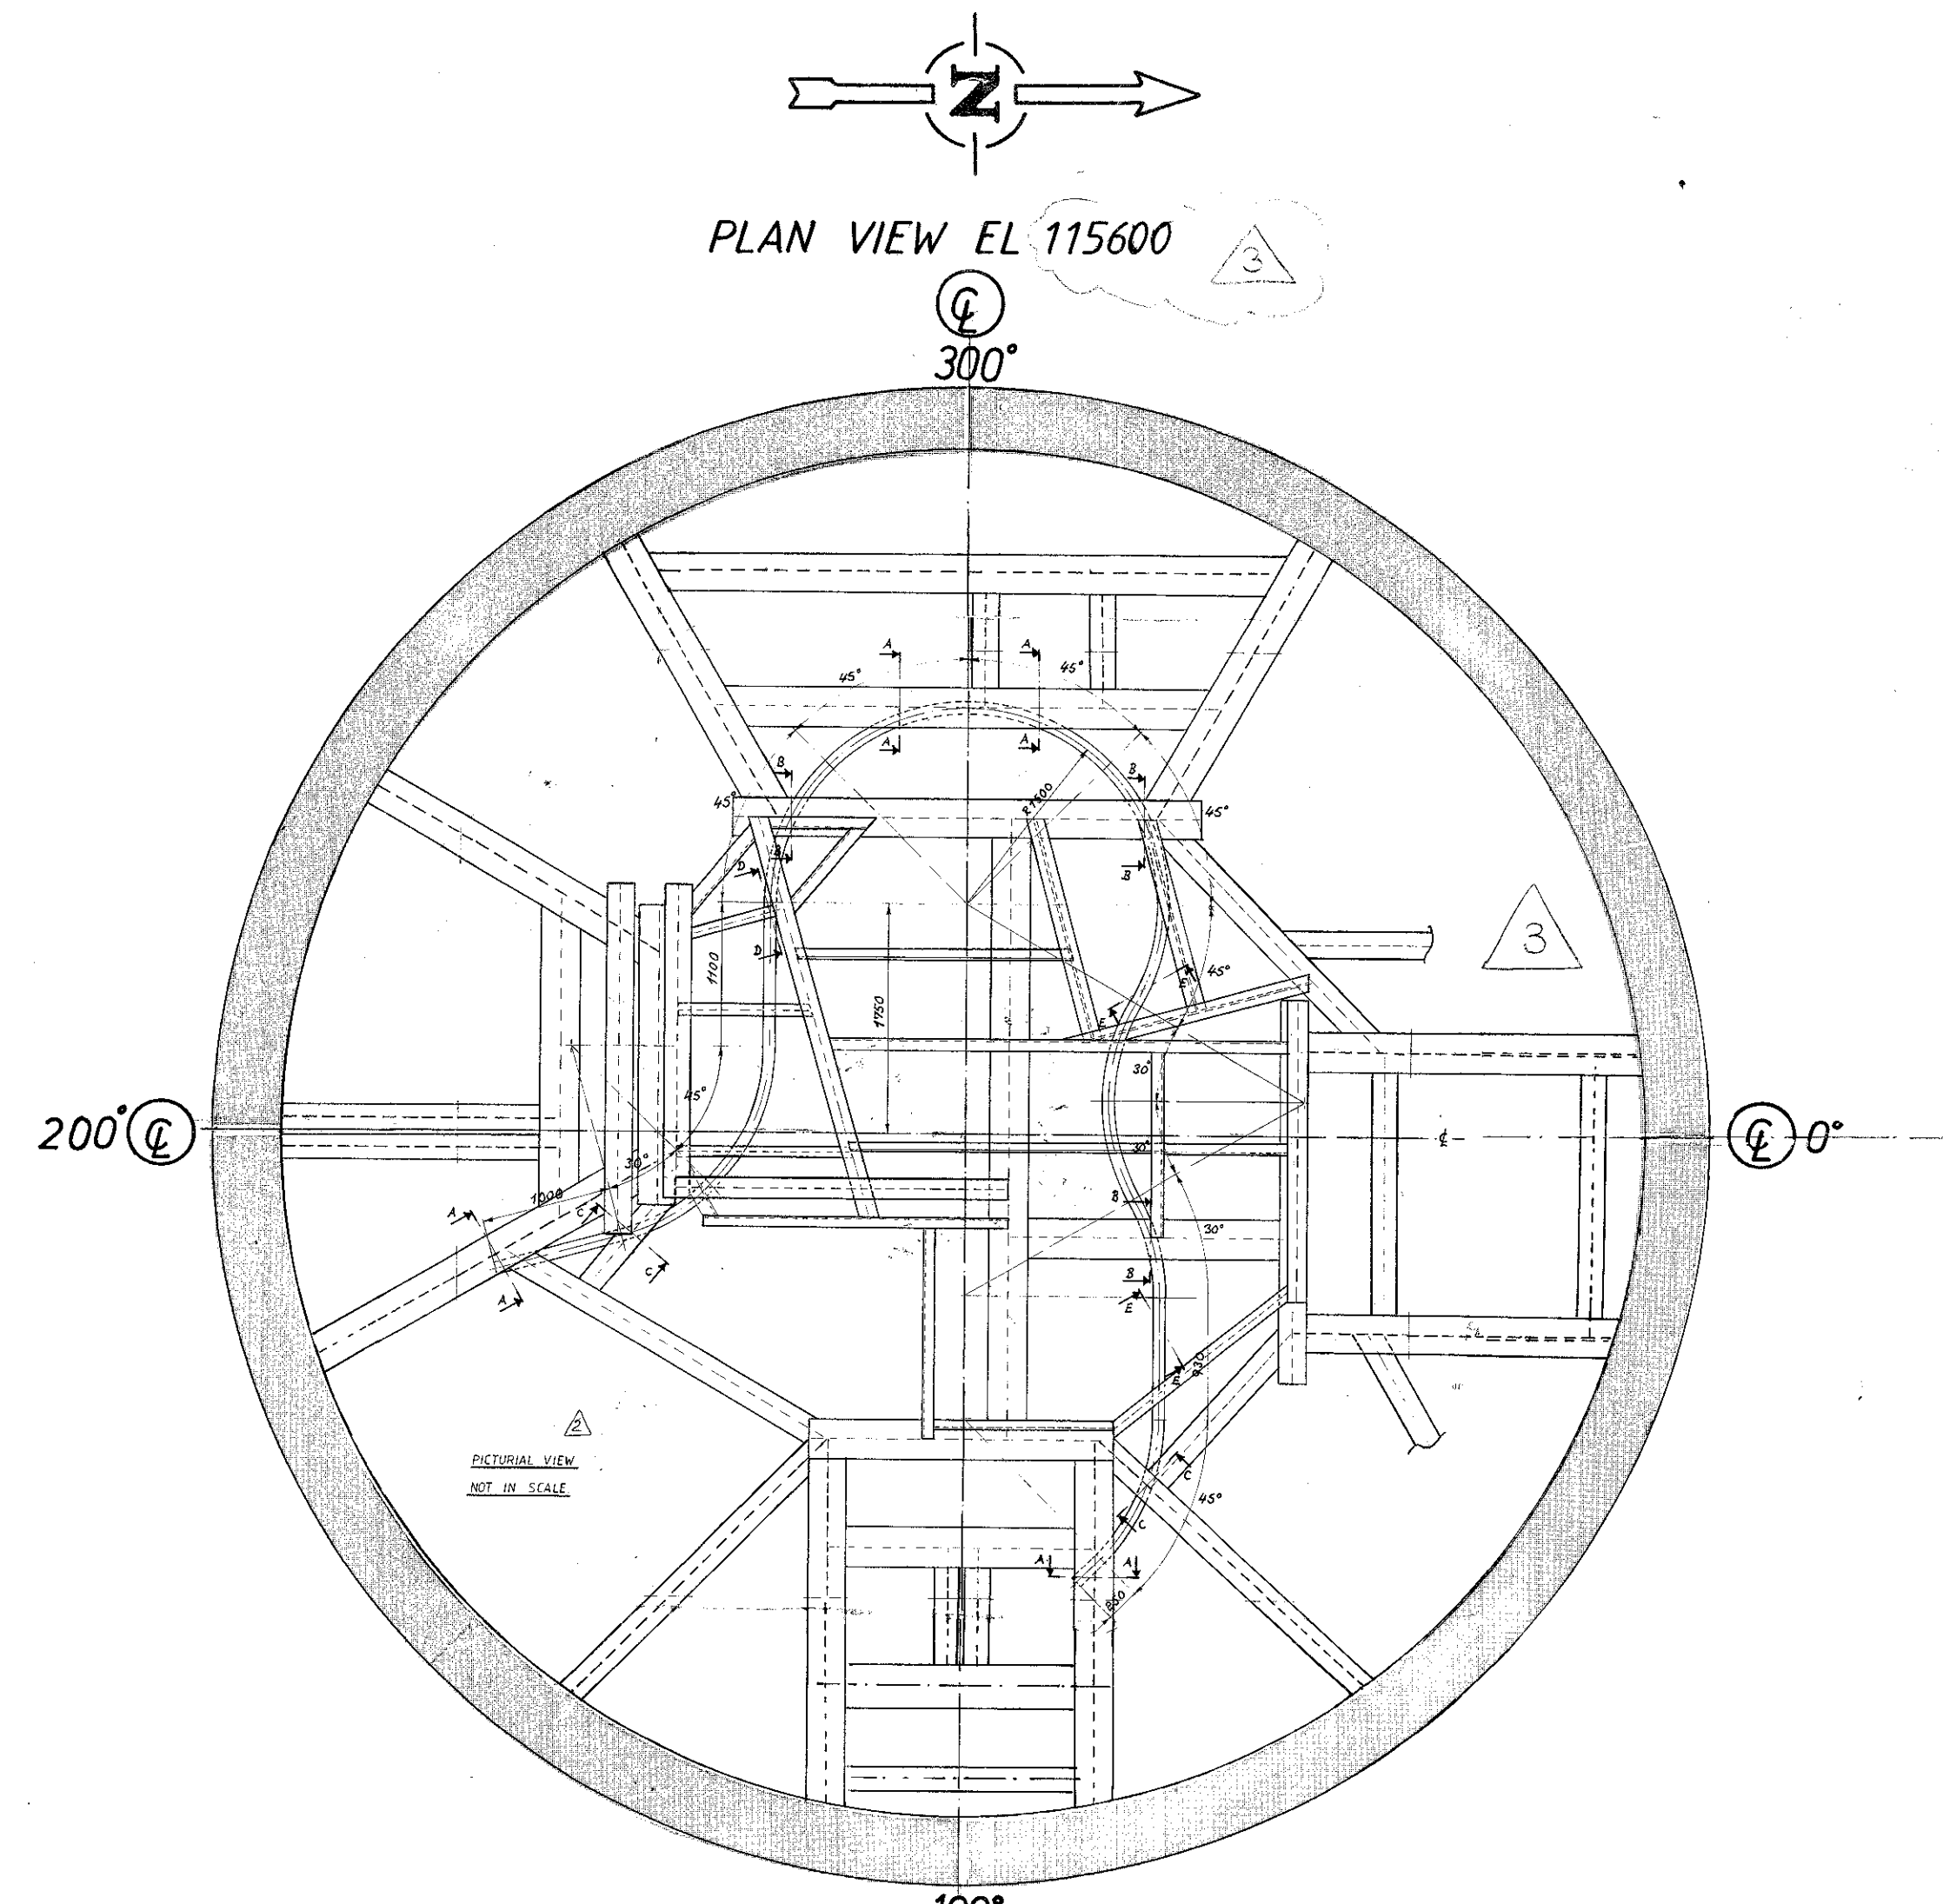

PLAN VIEW EL 116520 T.O.S. / 116250 T.O.S.

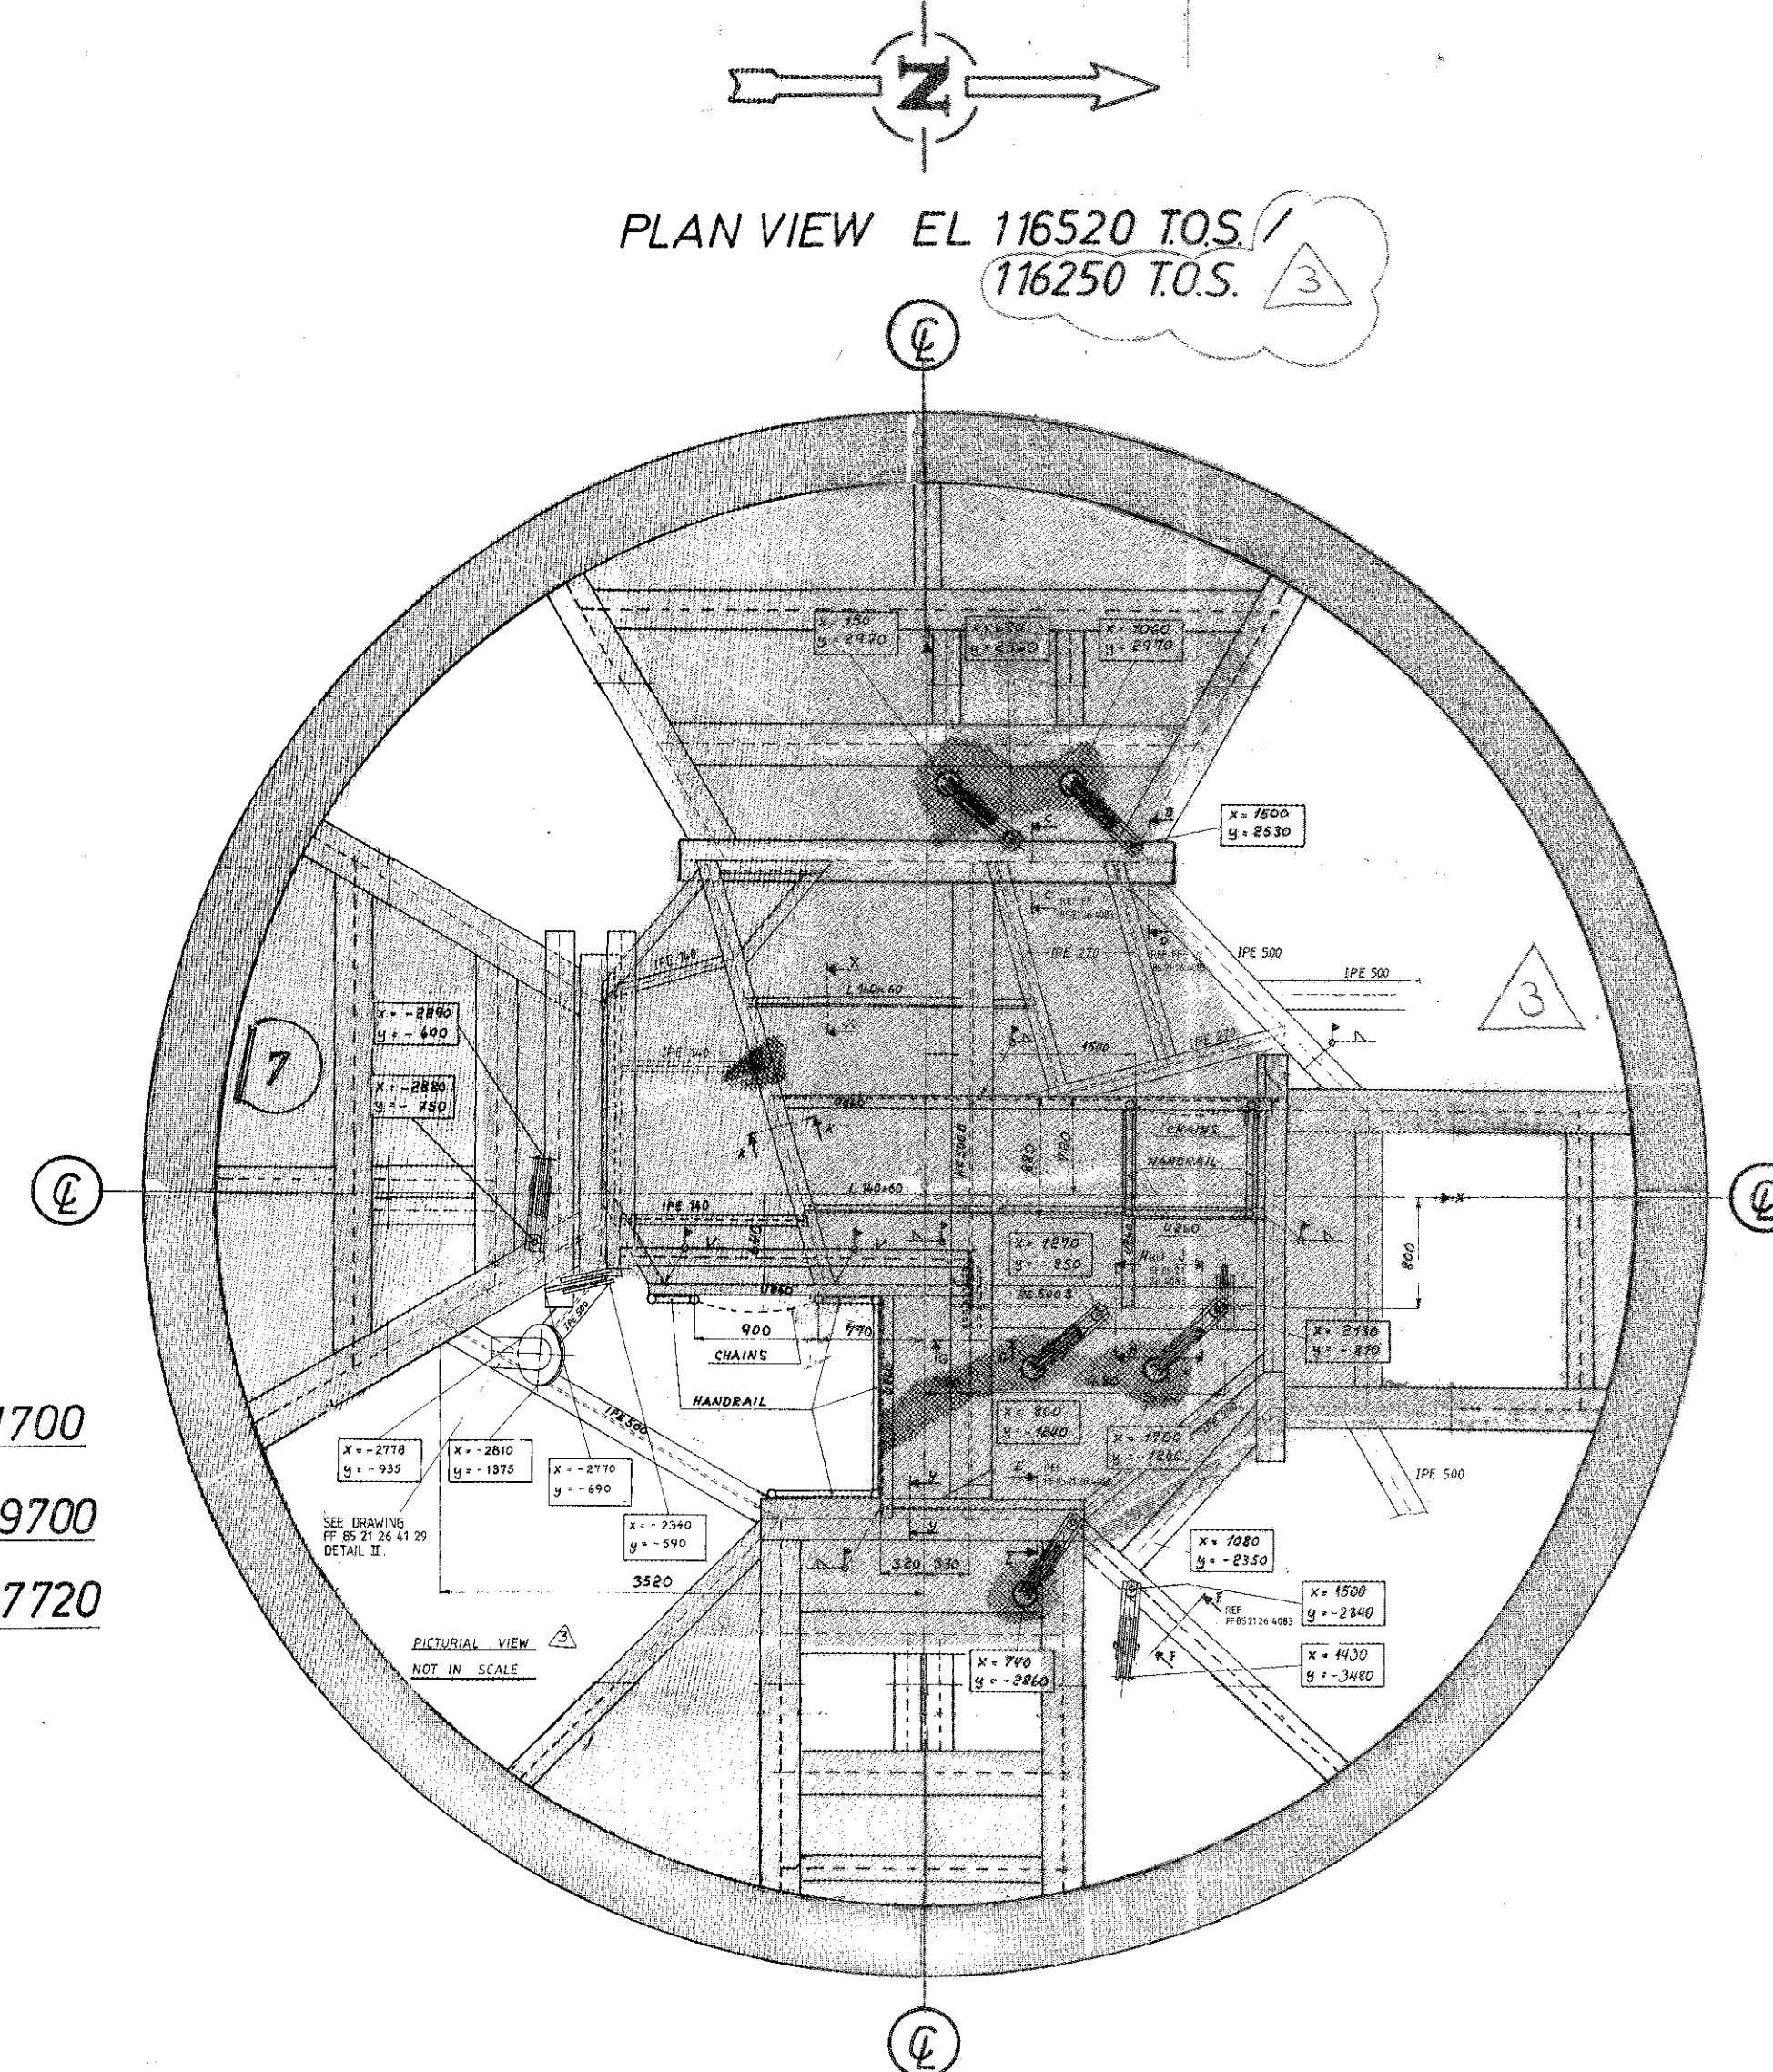


EL 131700
EL 129700
EL 127720

EL 116250



EL 110250

PLAN VIEW EL 110250 T.O.S.

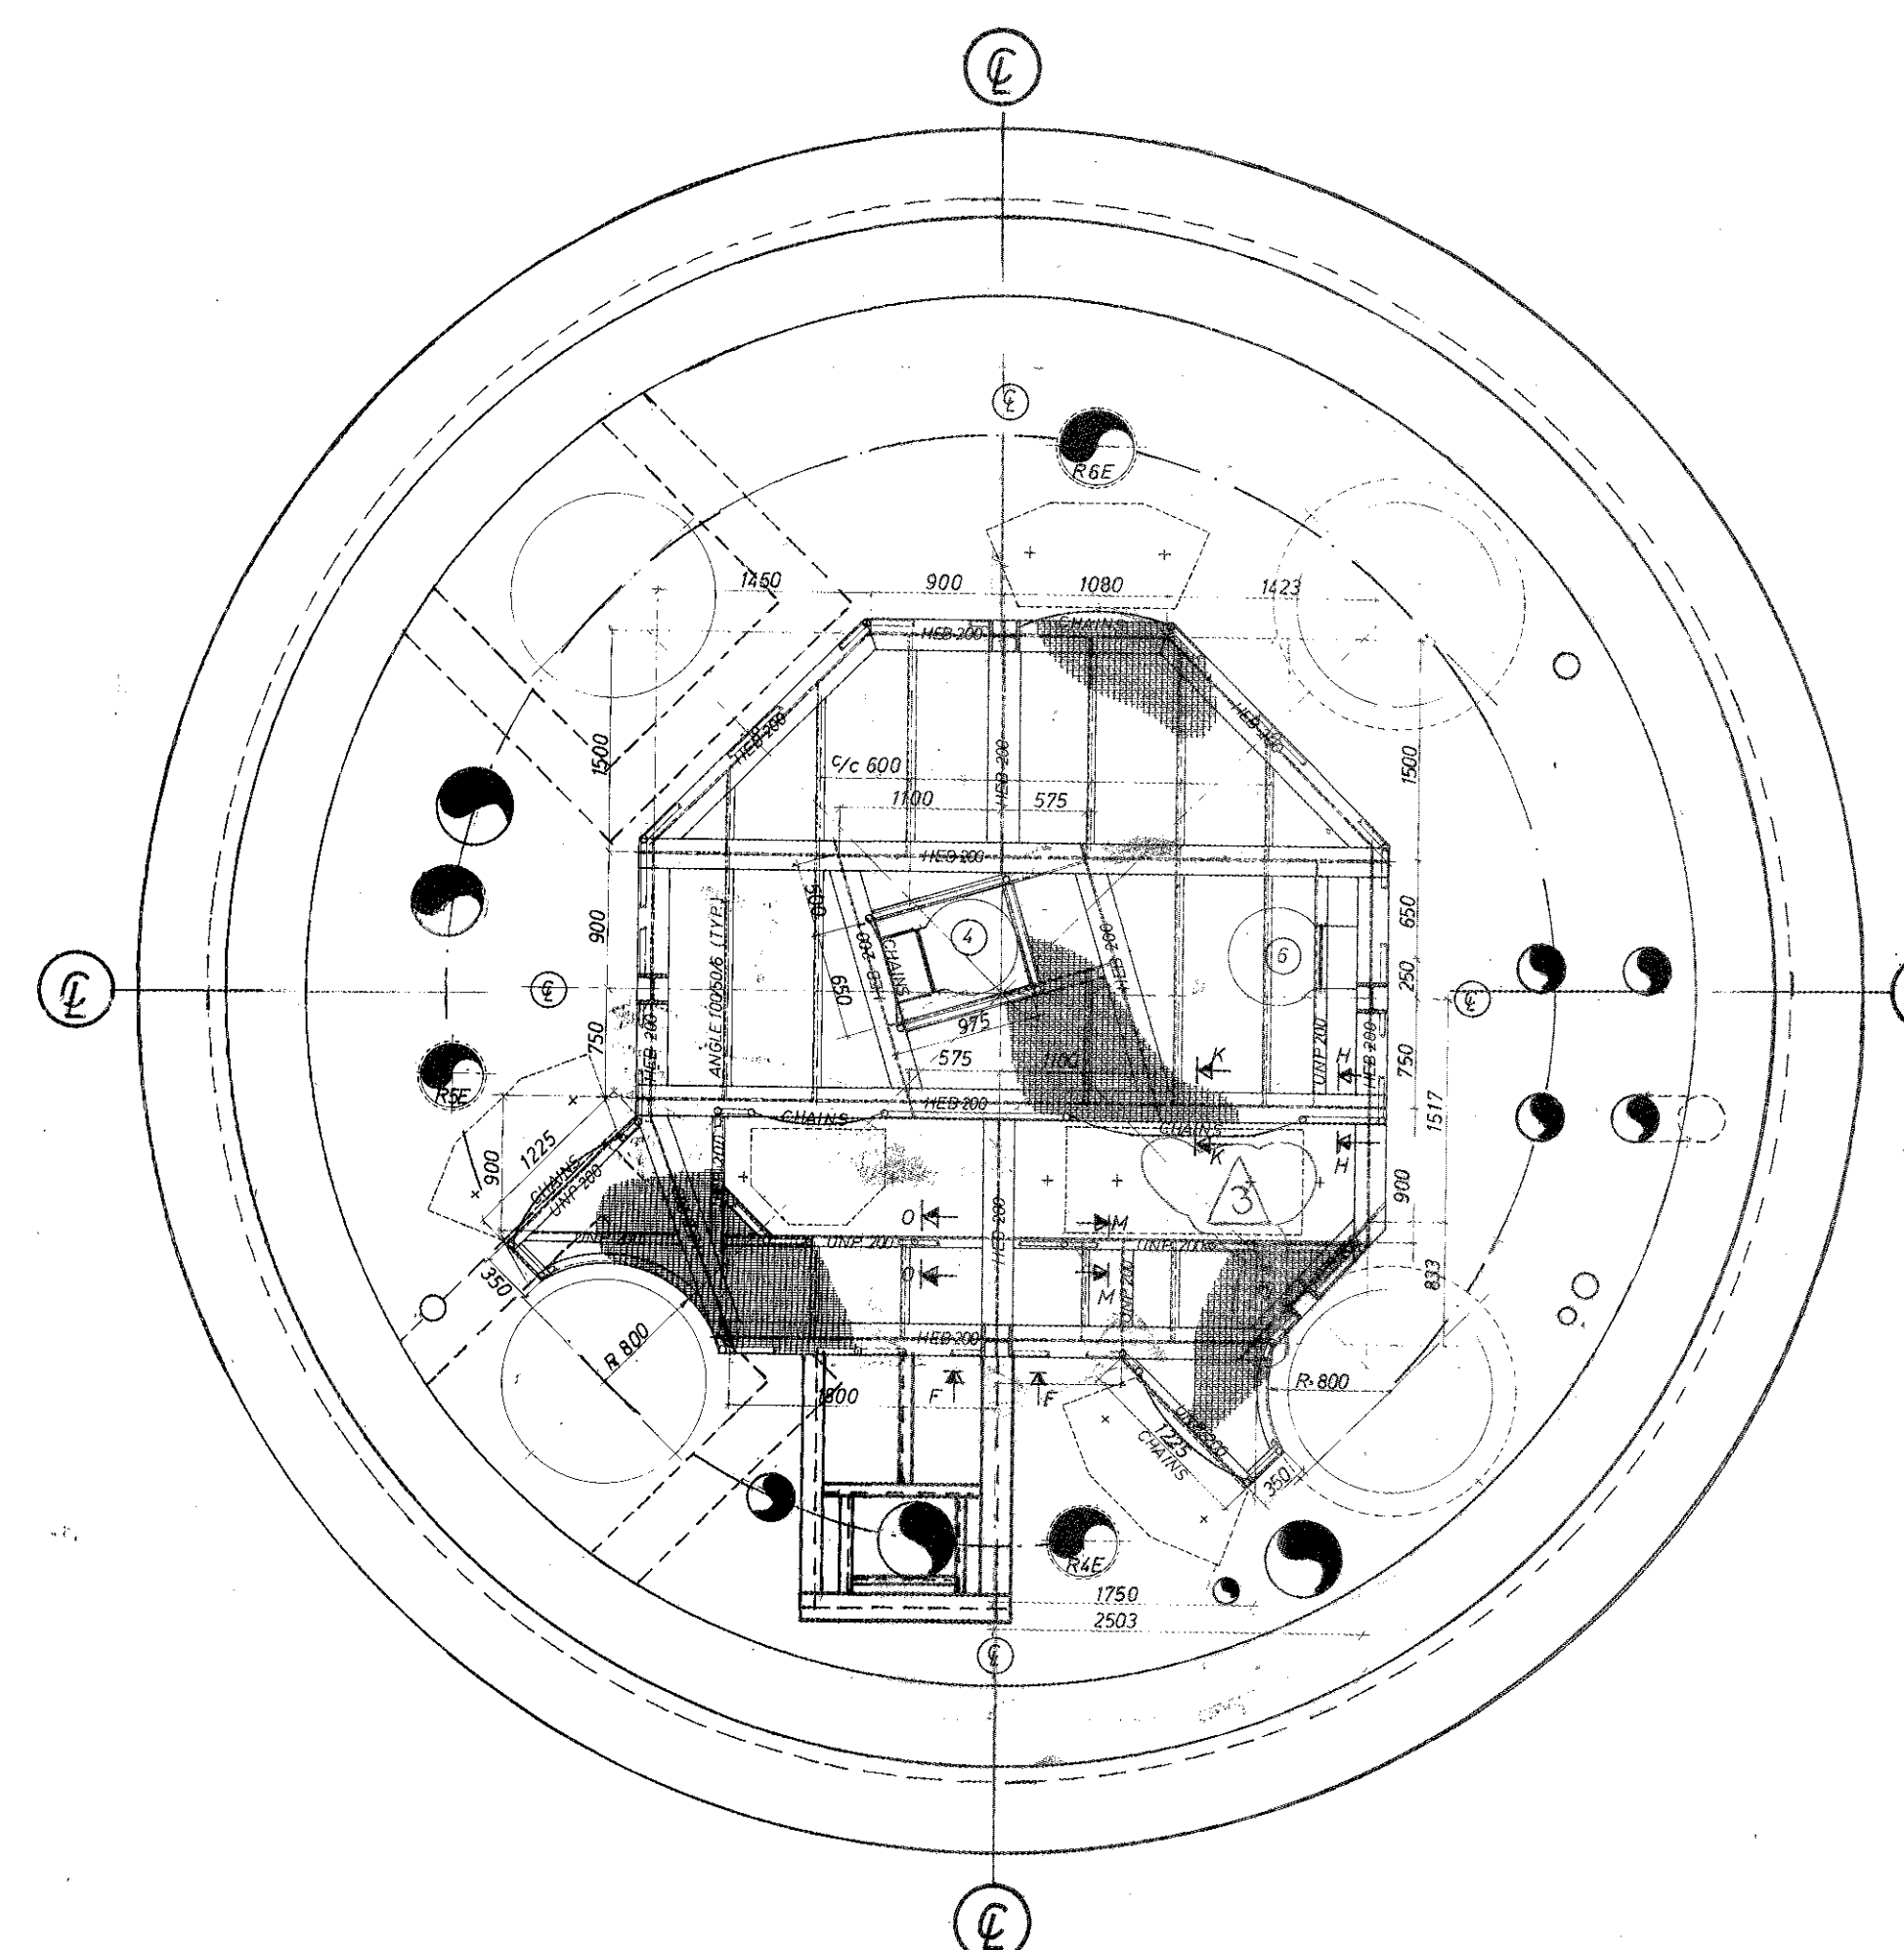


Scale 1:50

PLAN VIEW EL 45250 T.O.S.

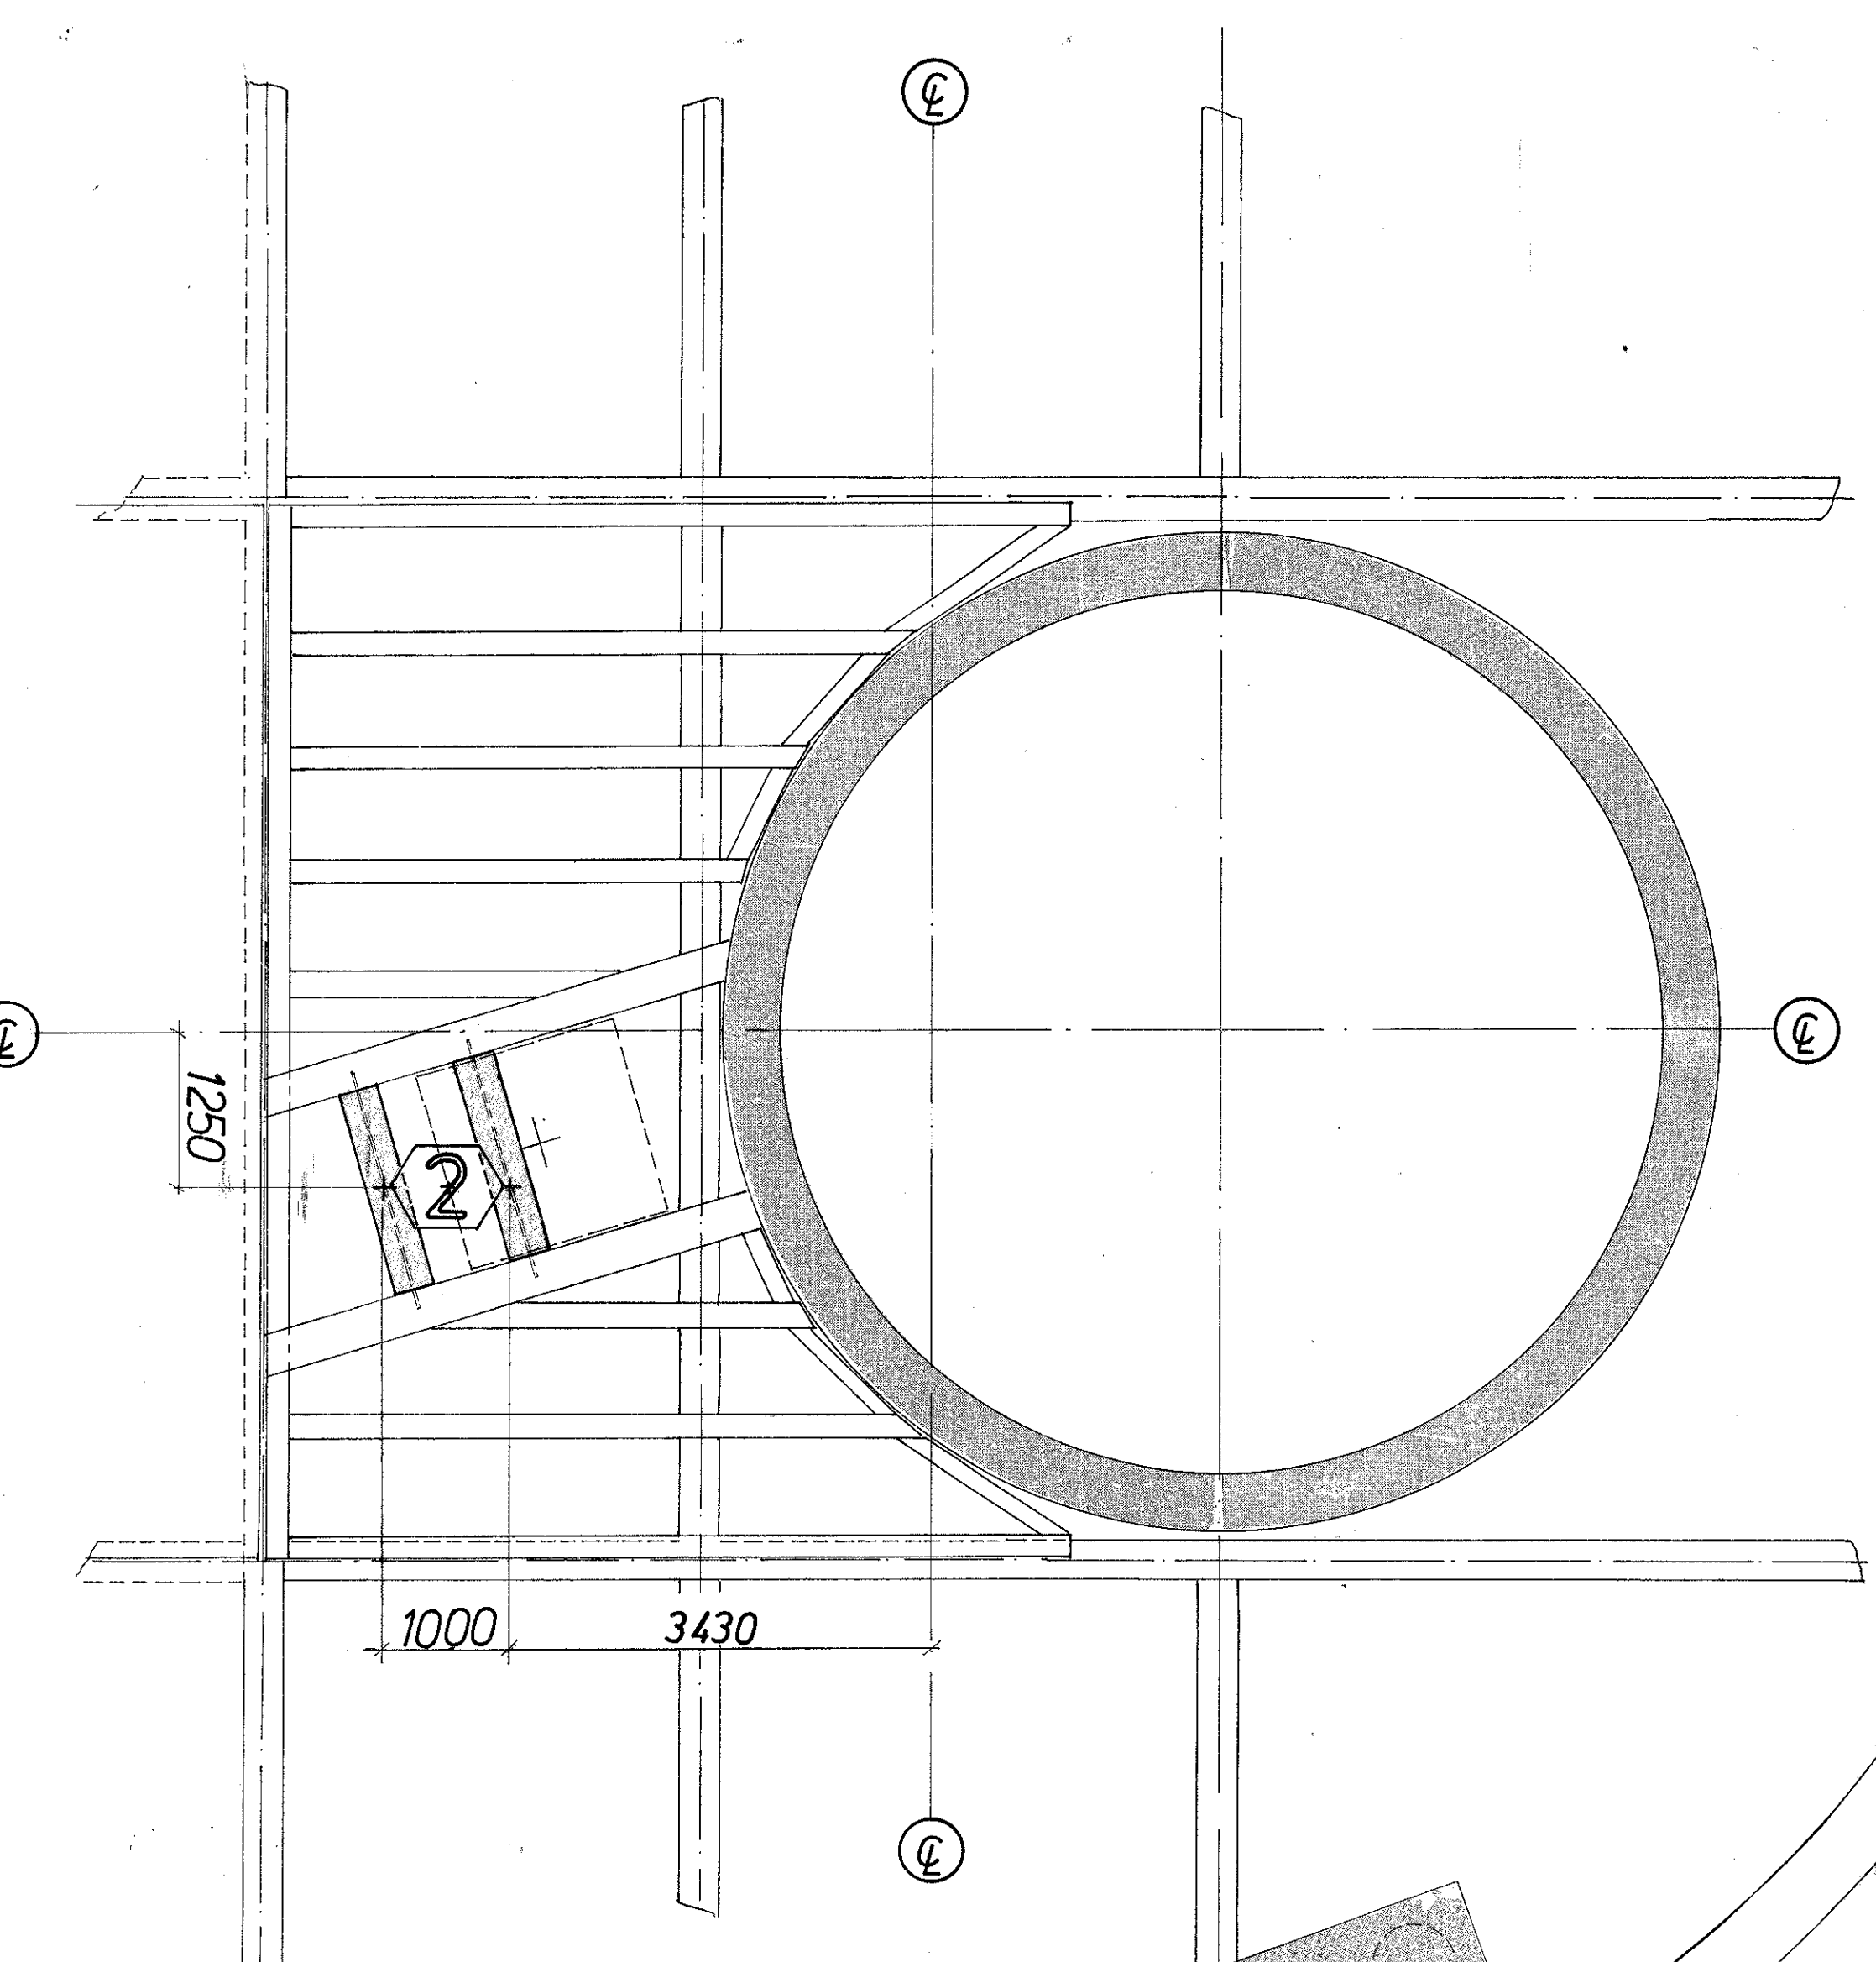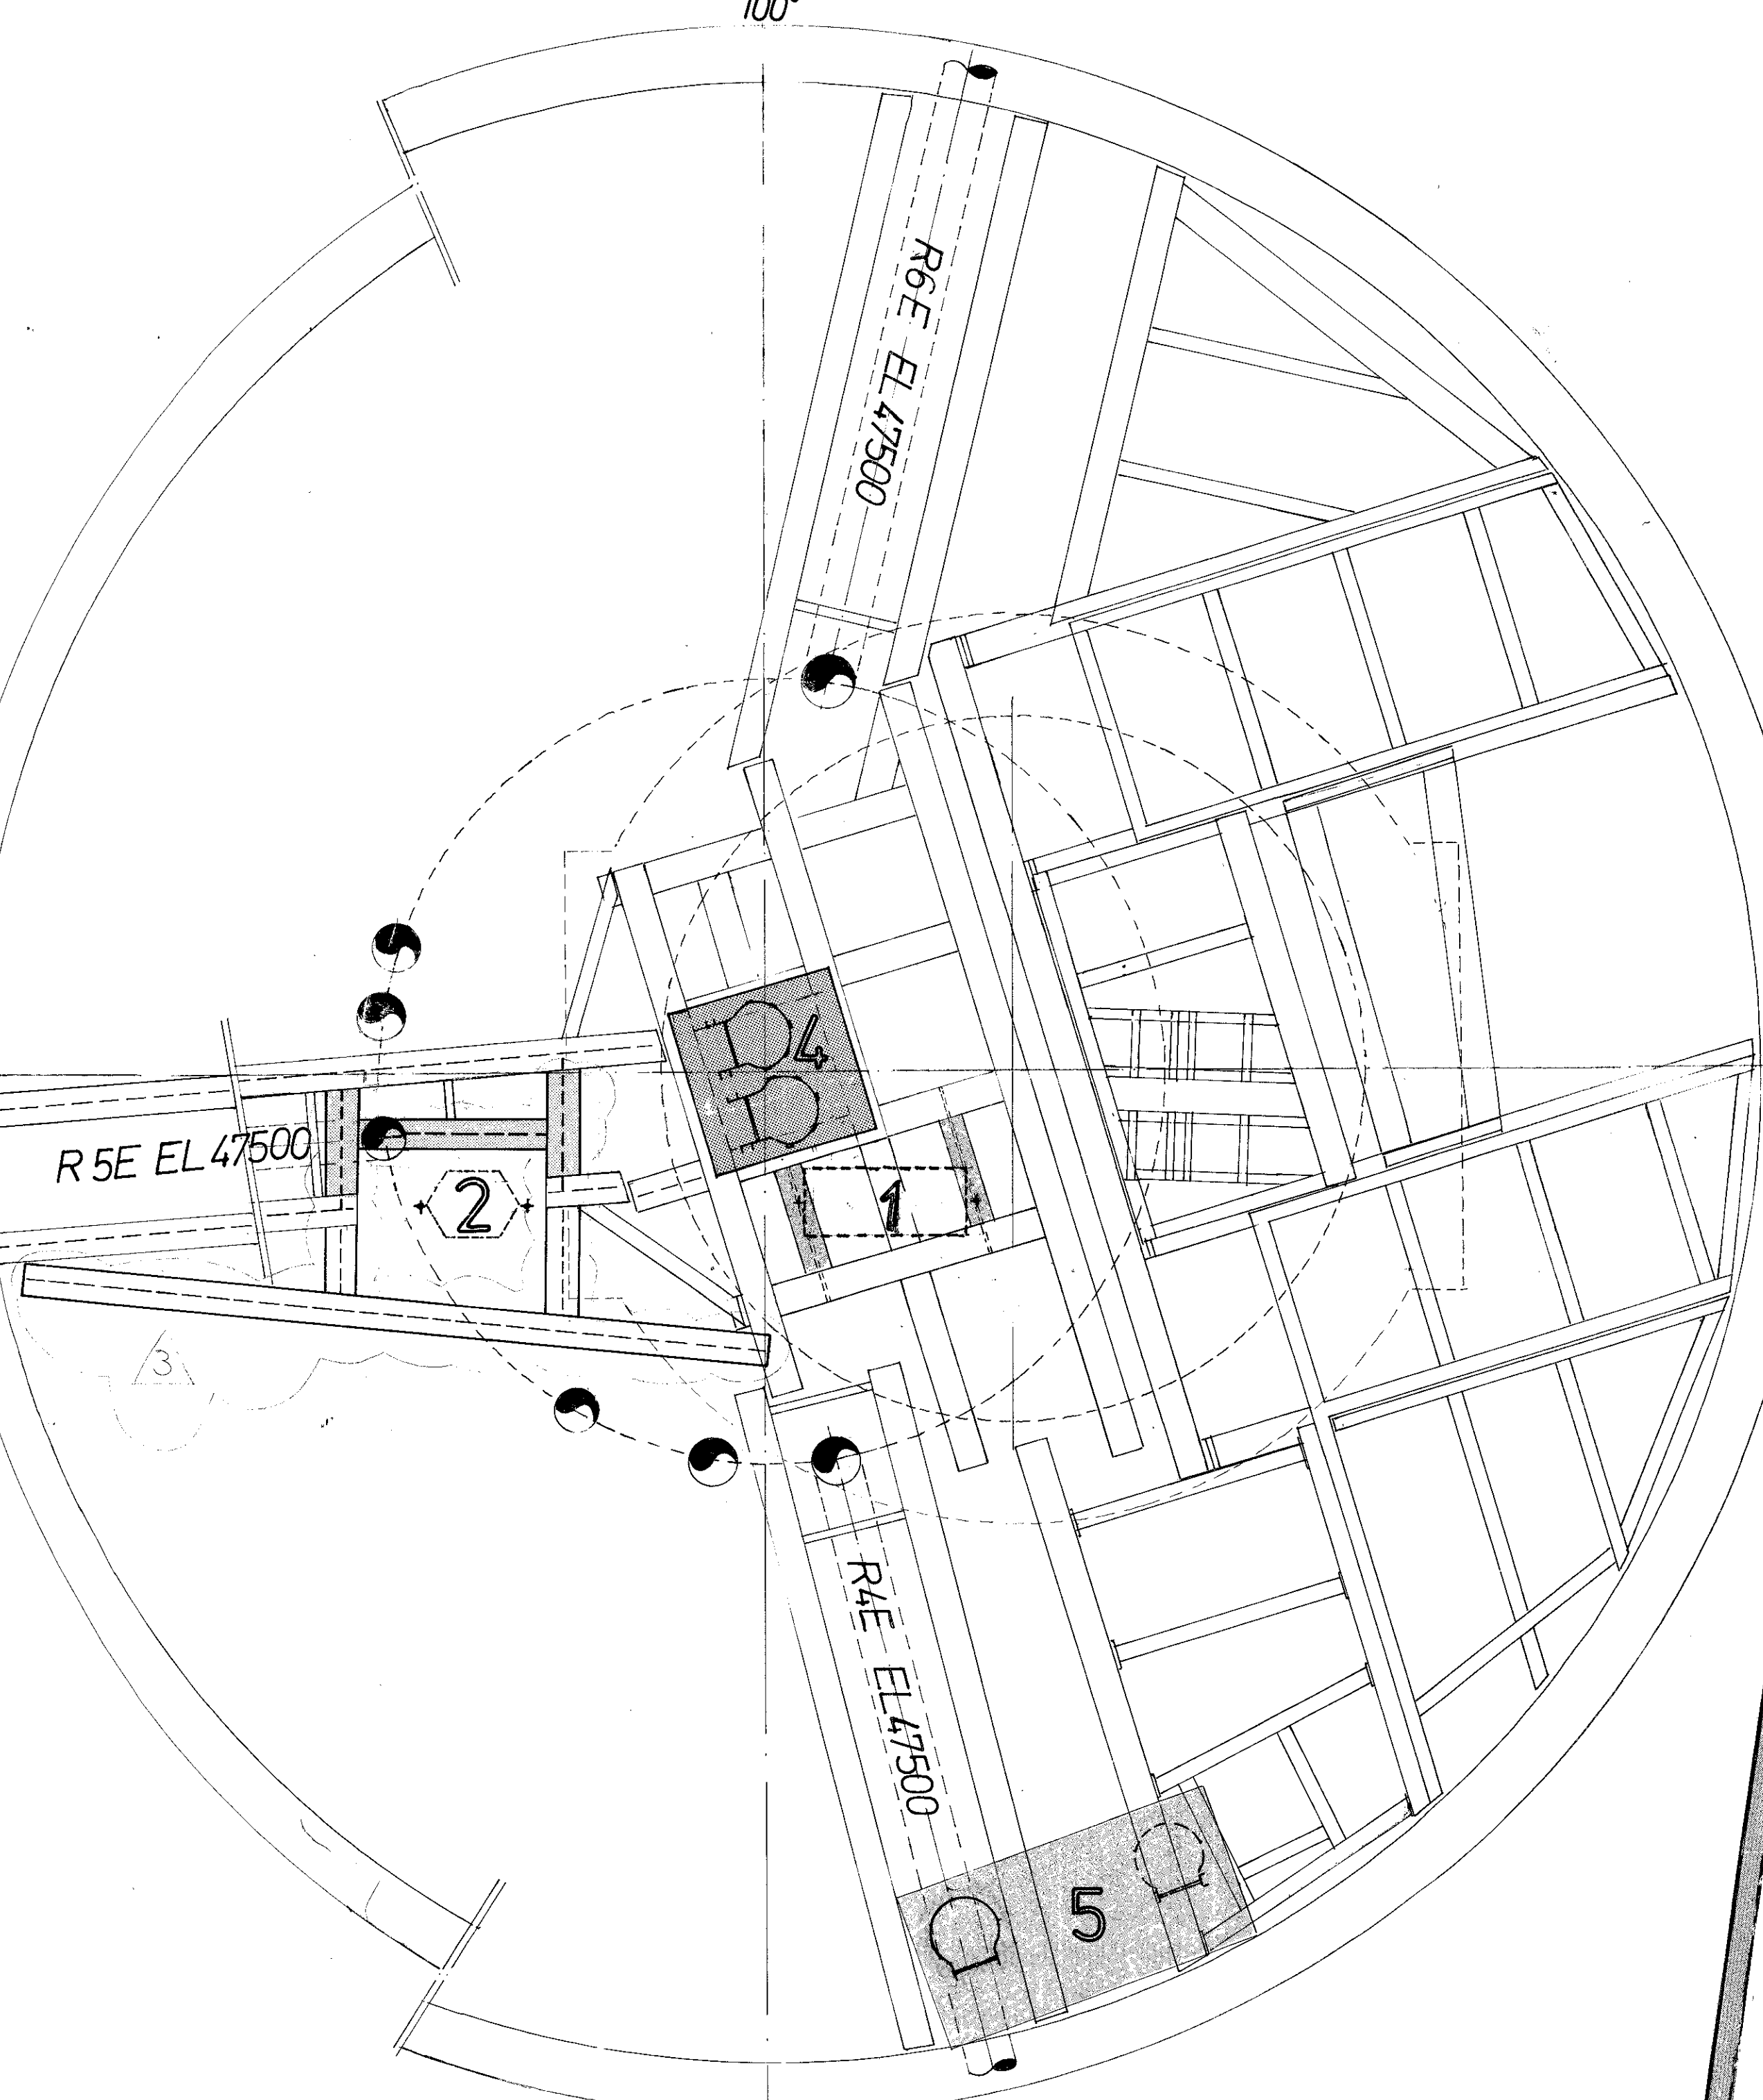

PLAN VIEW EL 8470 T.O.S.

Scale 1:50

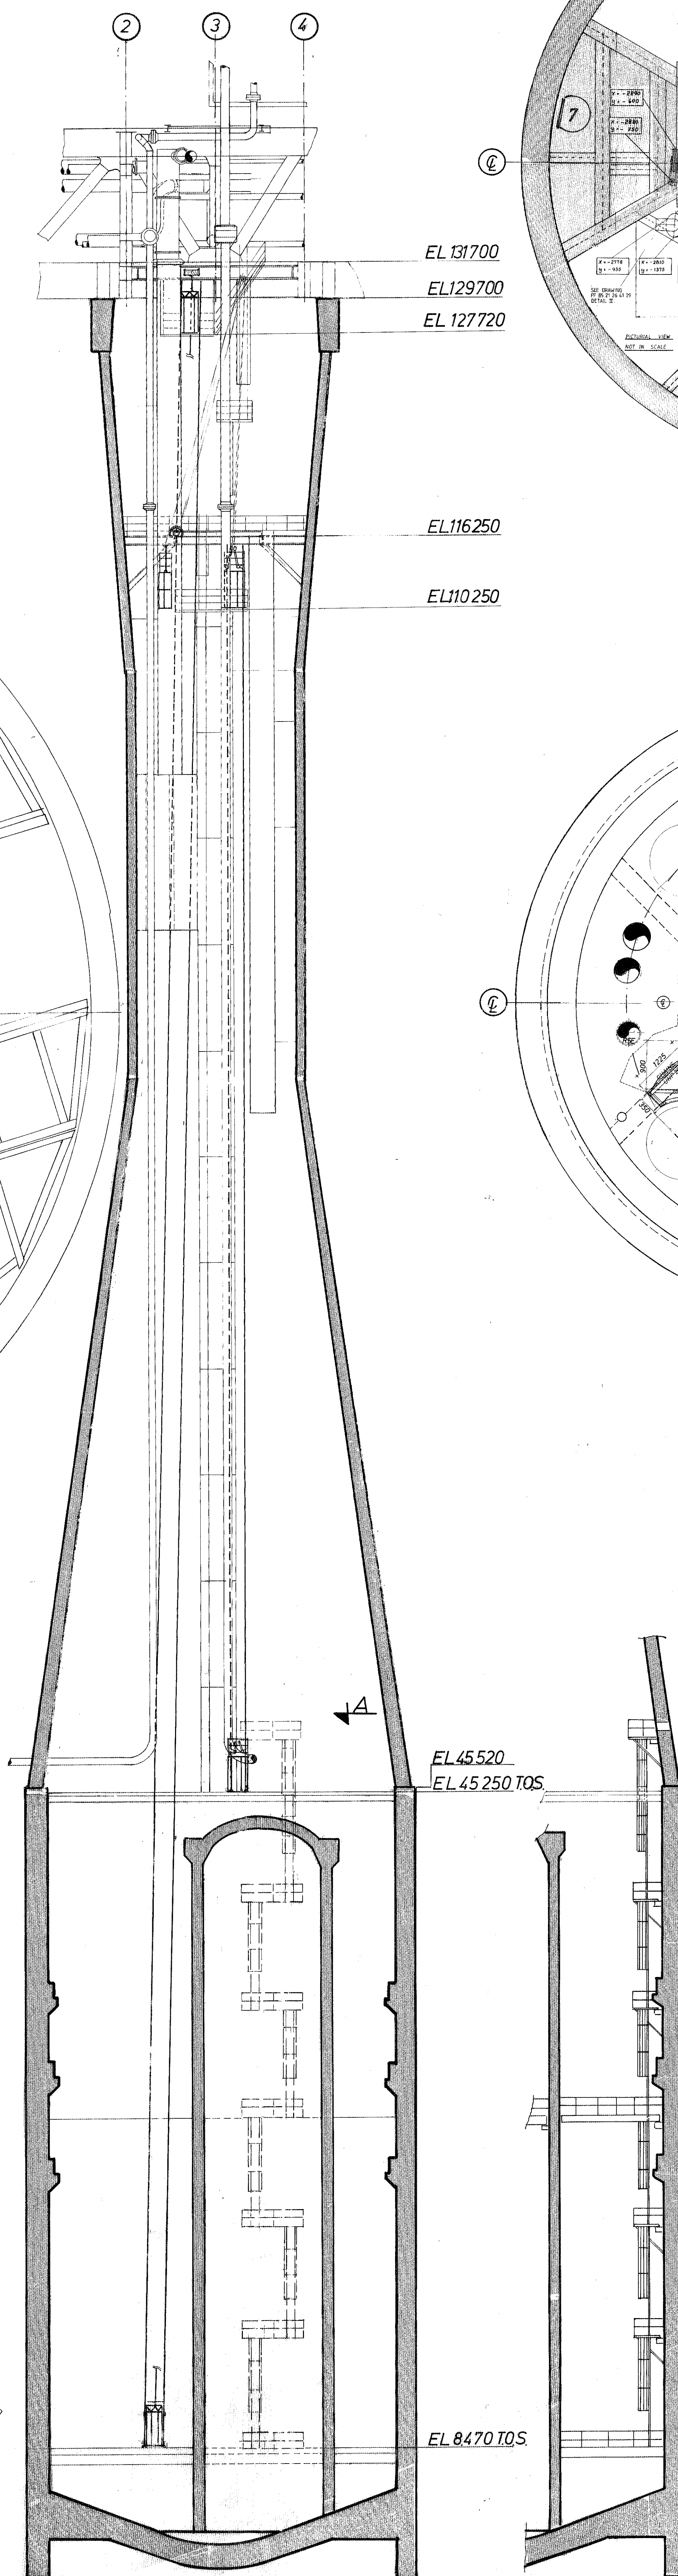

Scale 1:150


SECTION A-A

GENERAL NOTES:

- 1: Main access from EL 110 250 to EL 45250
- 2: Emergency access from EL 127.720 to EL 8470
- 3: Inspection access from EL 110 250 to EL 45250
- 4: Ladder access from EL 110 250 to EL 45250
- 5: Ladder access from EL 45.250 to EL 8470
- 6: Ladder access from EL 116.250 to EL 110 250
- 7: Ladder access from EL 131.700 to EL 116.250
- 8: Stair access from EL 131.700 to EL 127.720

For other notes see dwg FF 85 21 26 4045

REFERENCE DRWGS.: FF 85 21 26 4093

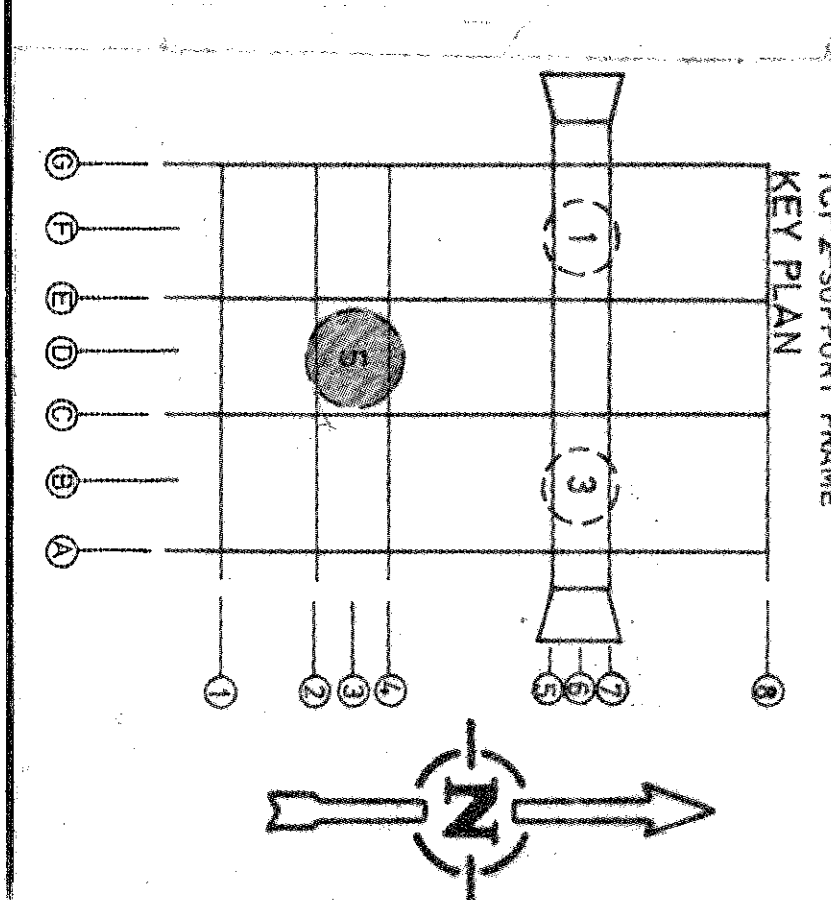

elf aquitaine norge as
APPROVED FOR CONSTRUCTION
NAME: D. SOLVSTAD
SIGNATURE: DS

rev.	date	DESCRIPTION	by	app.
4	6.12.88	EL 110 250 T.O.S. UPDATED	S.S.B.	
3	05.08.86	UPDATED	R.D.	
2	20.12.83	AS BUILT	O.P.	
1	15.12.82	ISSUE FOR CONSTRUCTION	D.S. D.S.	
0	27.12.81	first issue	D.S.	

elf aquitaine norge as p.o. box 168 - 4001 Stavanger	
Installation TCP-2	System STRUCTURAL
Job no. MR 85078	GENERAL ARRANGEMENT ACCESSES IN COLUMN-5
Scale 1:150 1:50	Drwg. no. FF 85 21 26 4046
Rev. 4	Sheet 1/1