




PLAN VIEW EL 131510 TOS

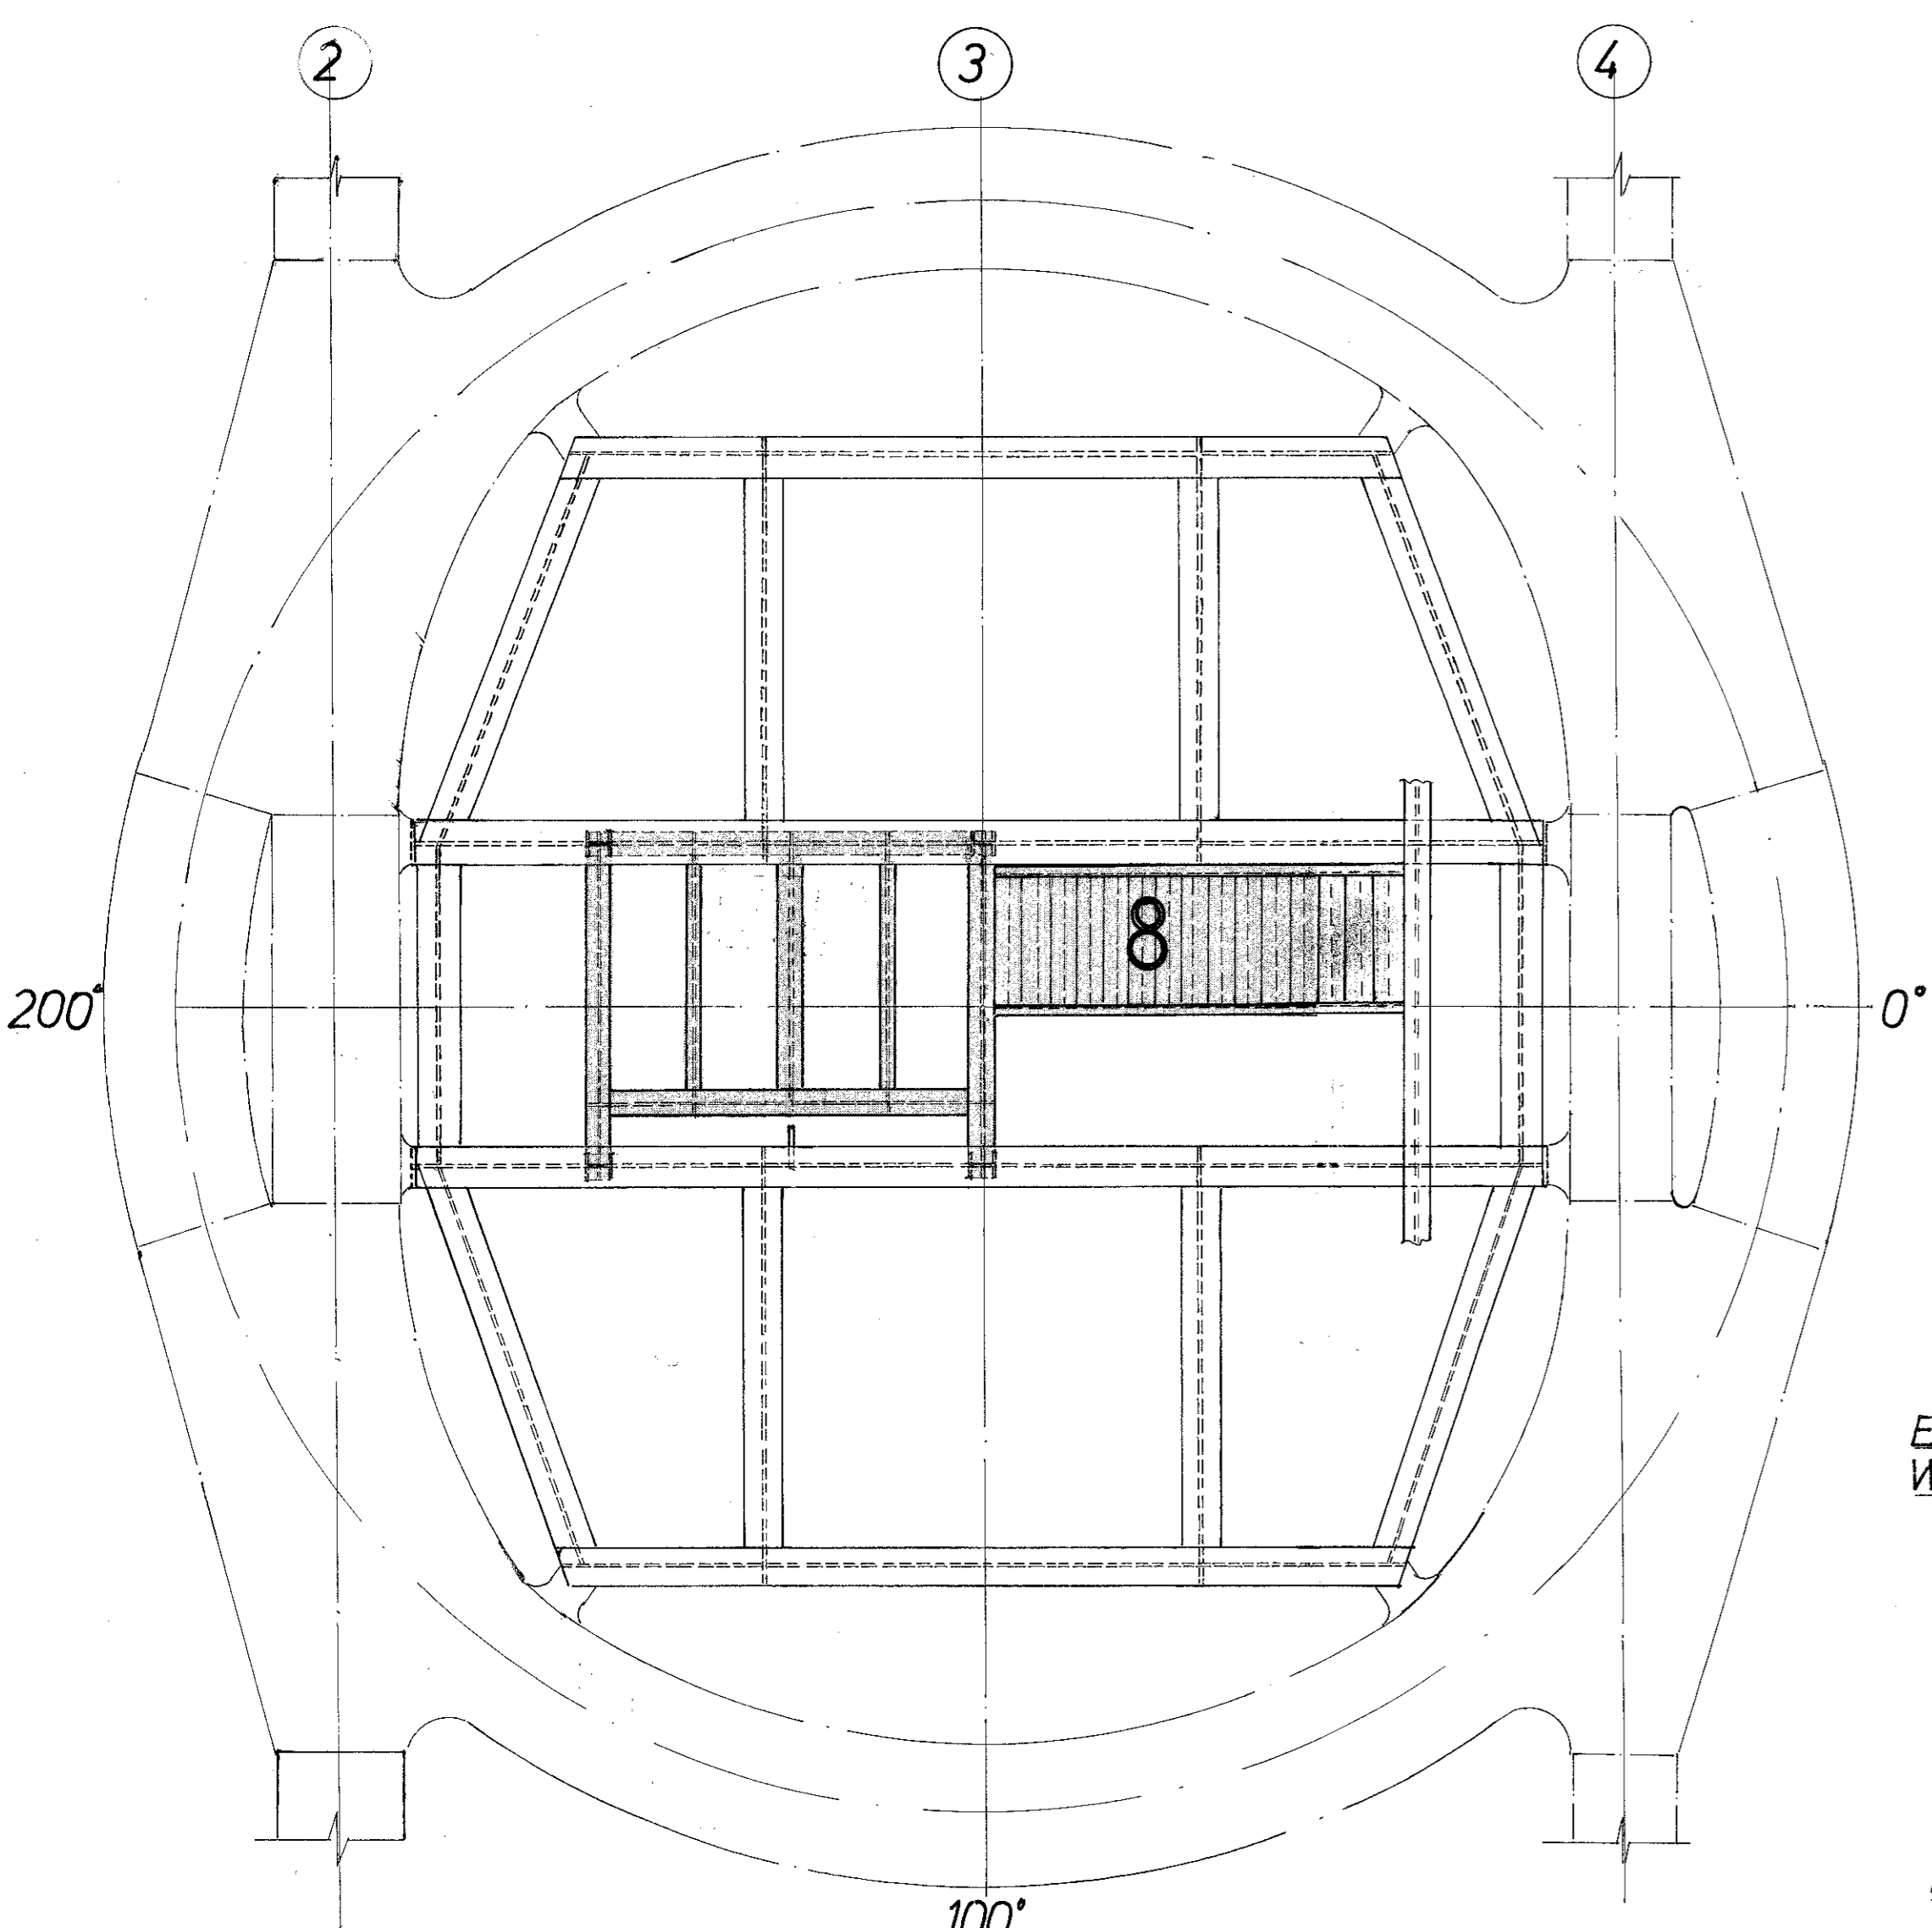



PLAN VIEW EL 131700 TOS

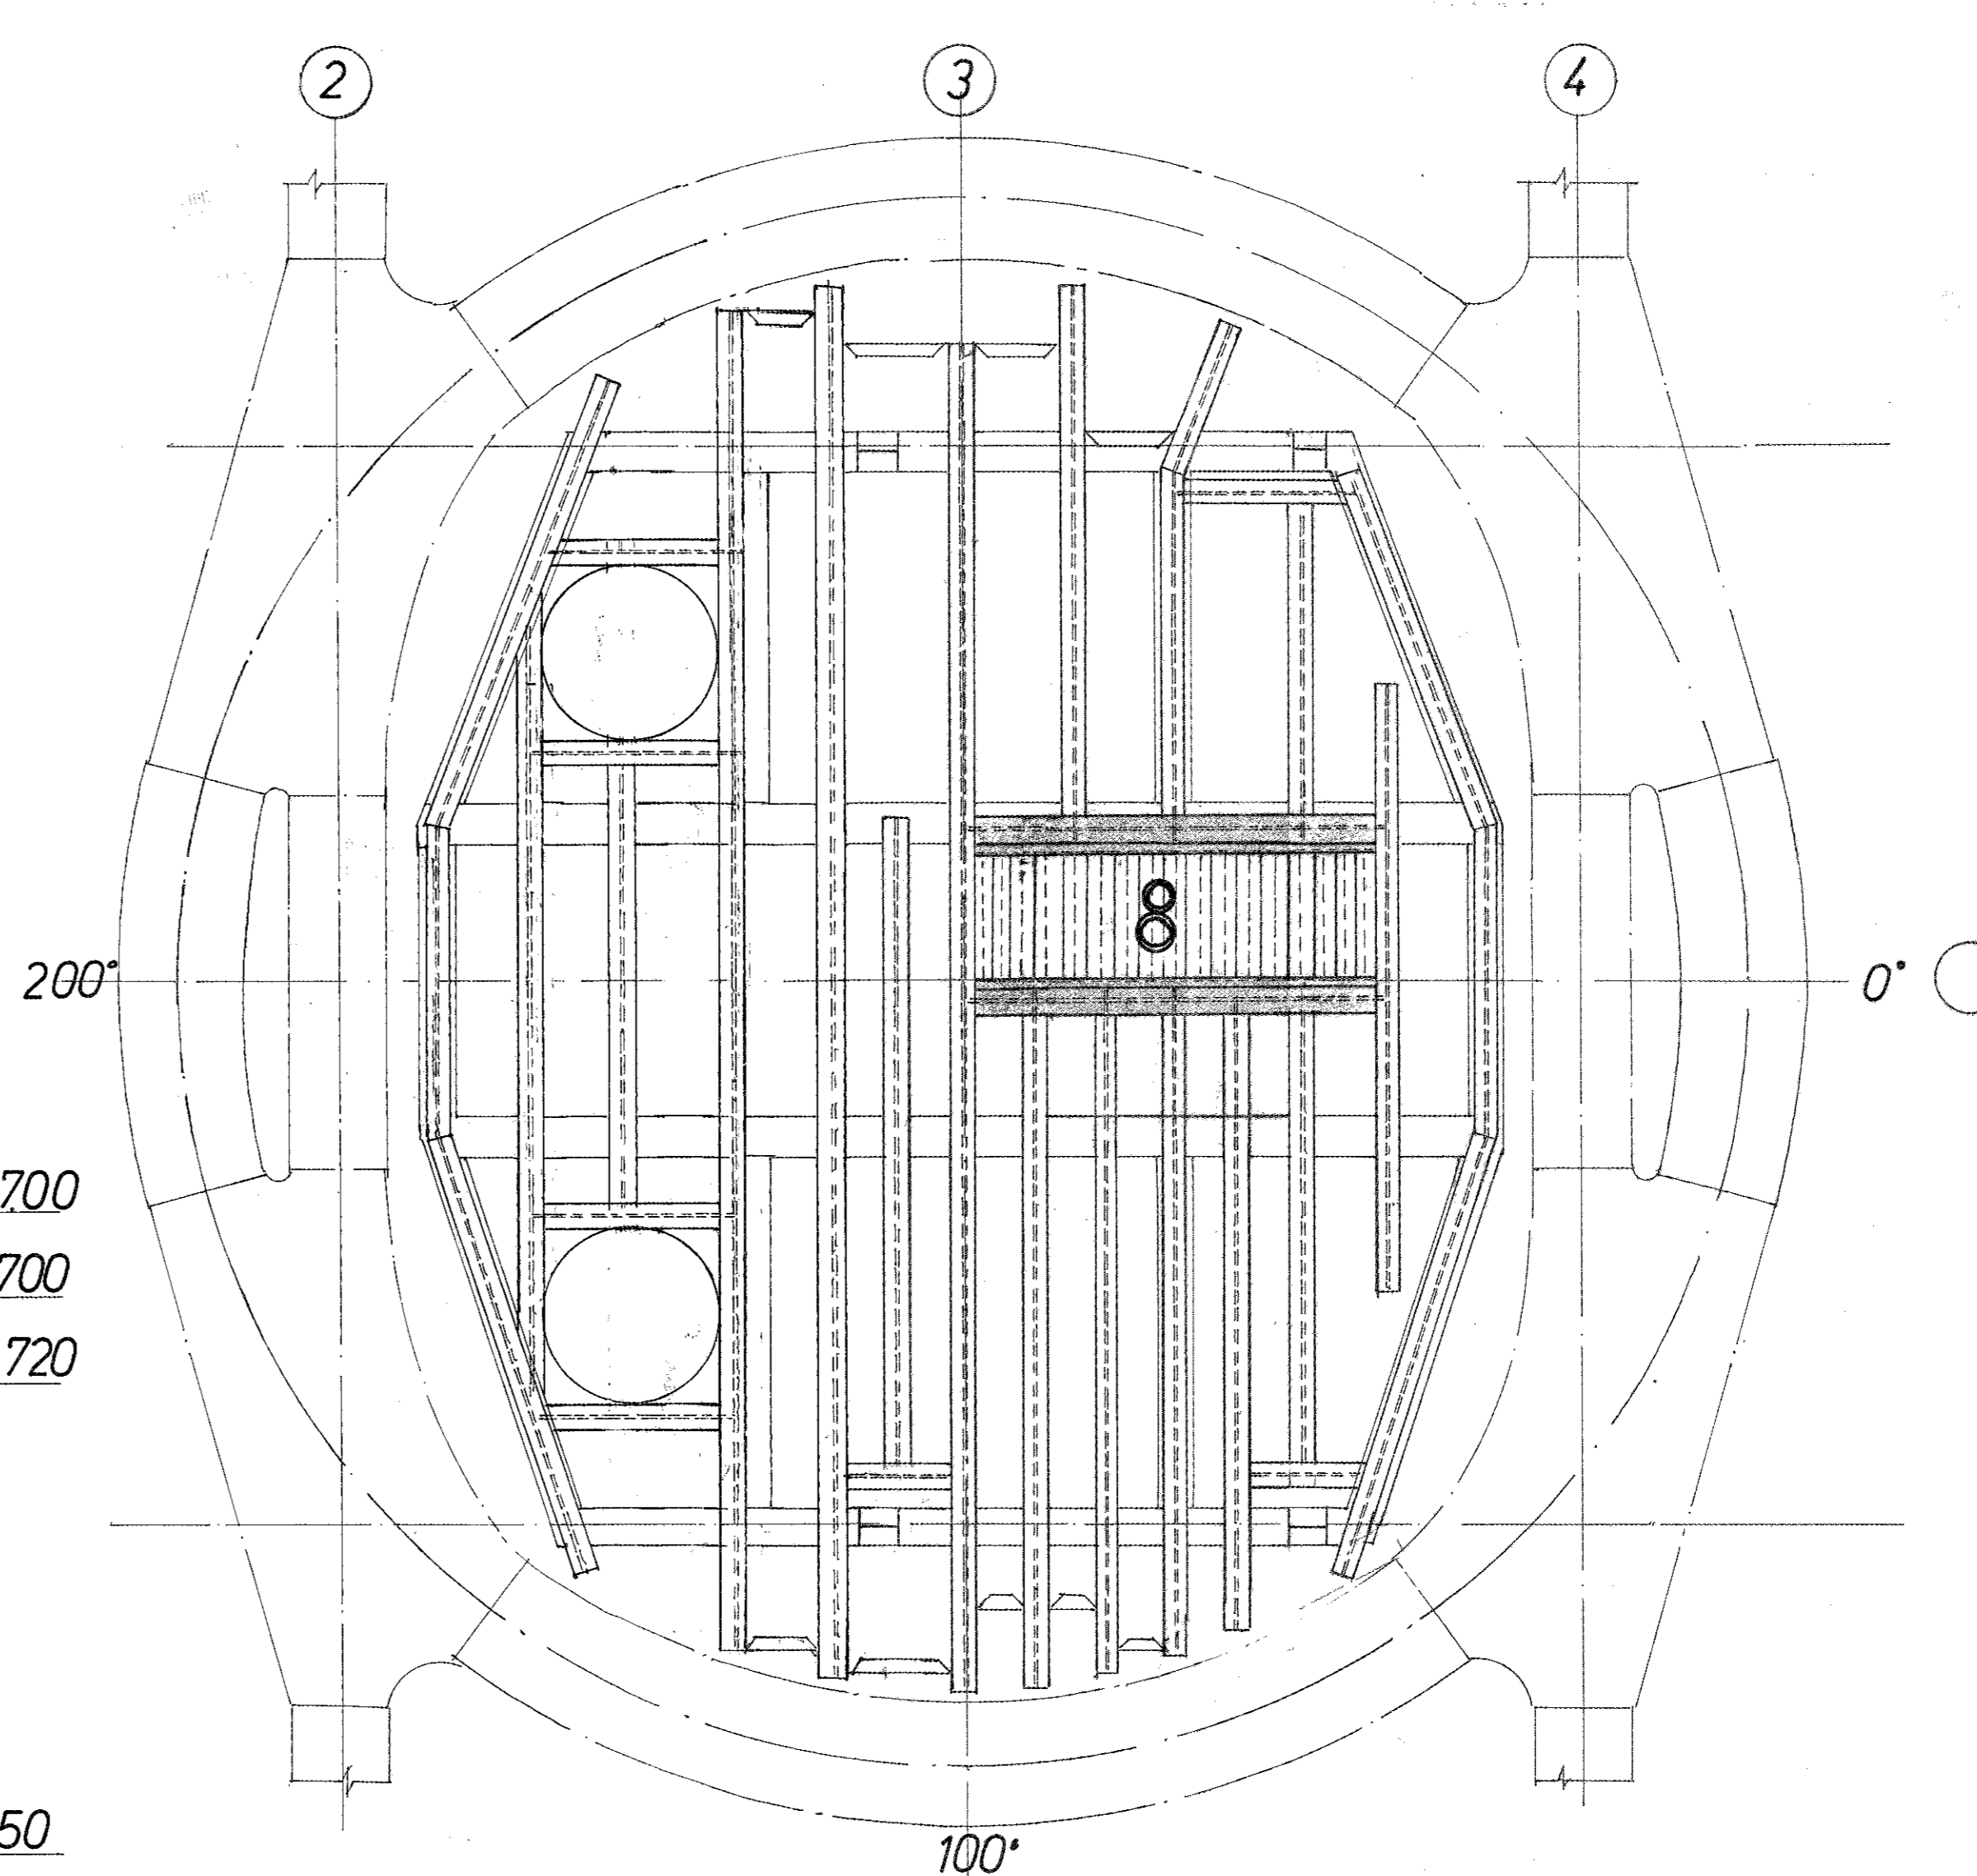

PLAN VIEW EL 127720 TOS

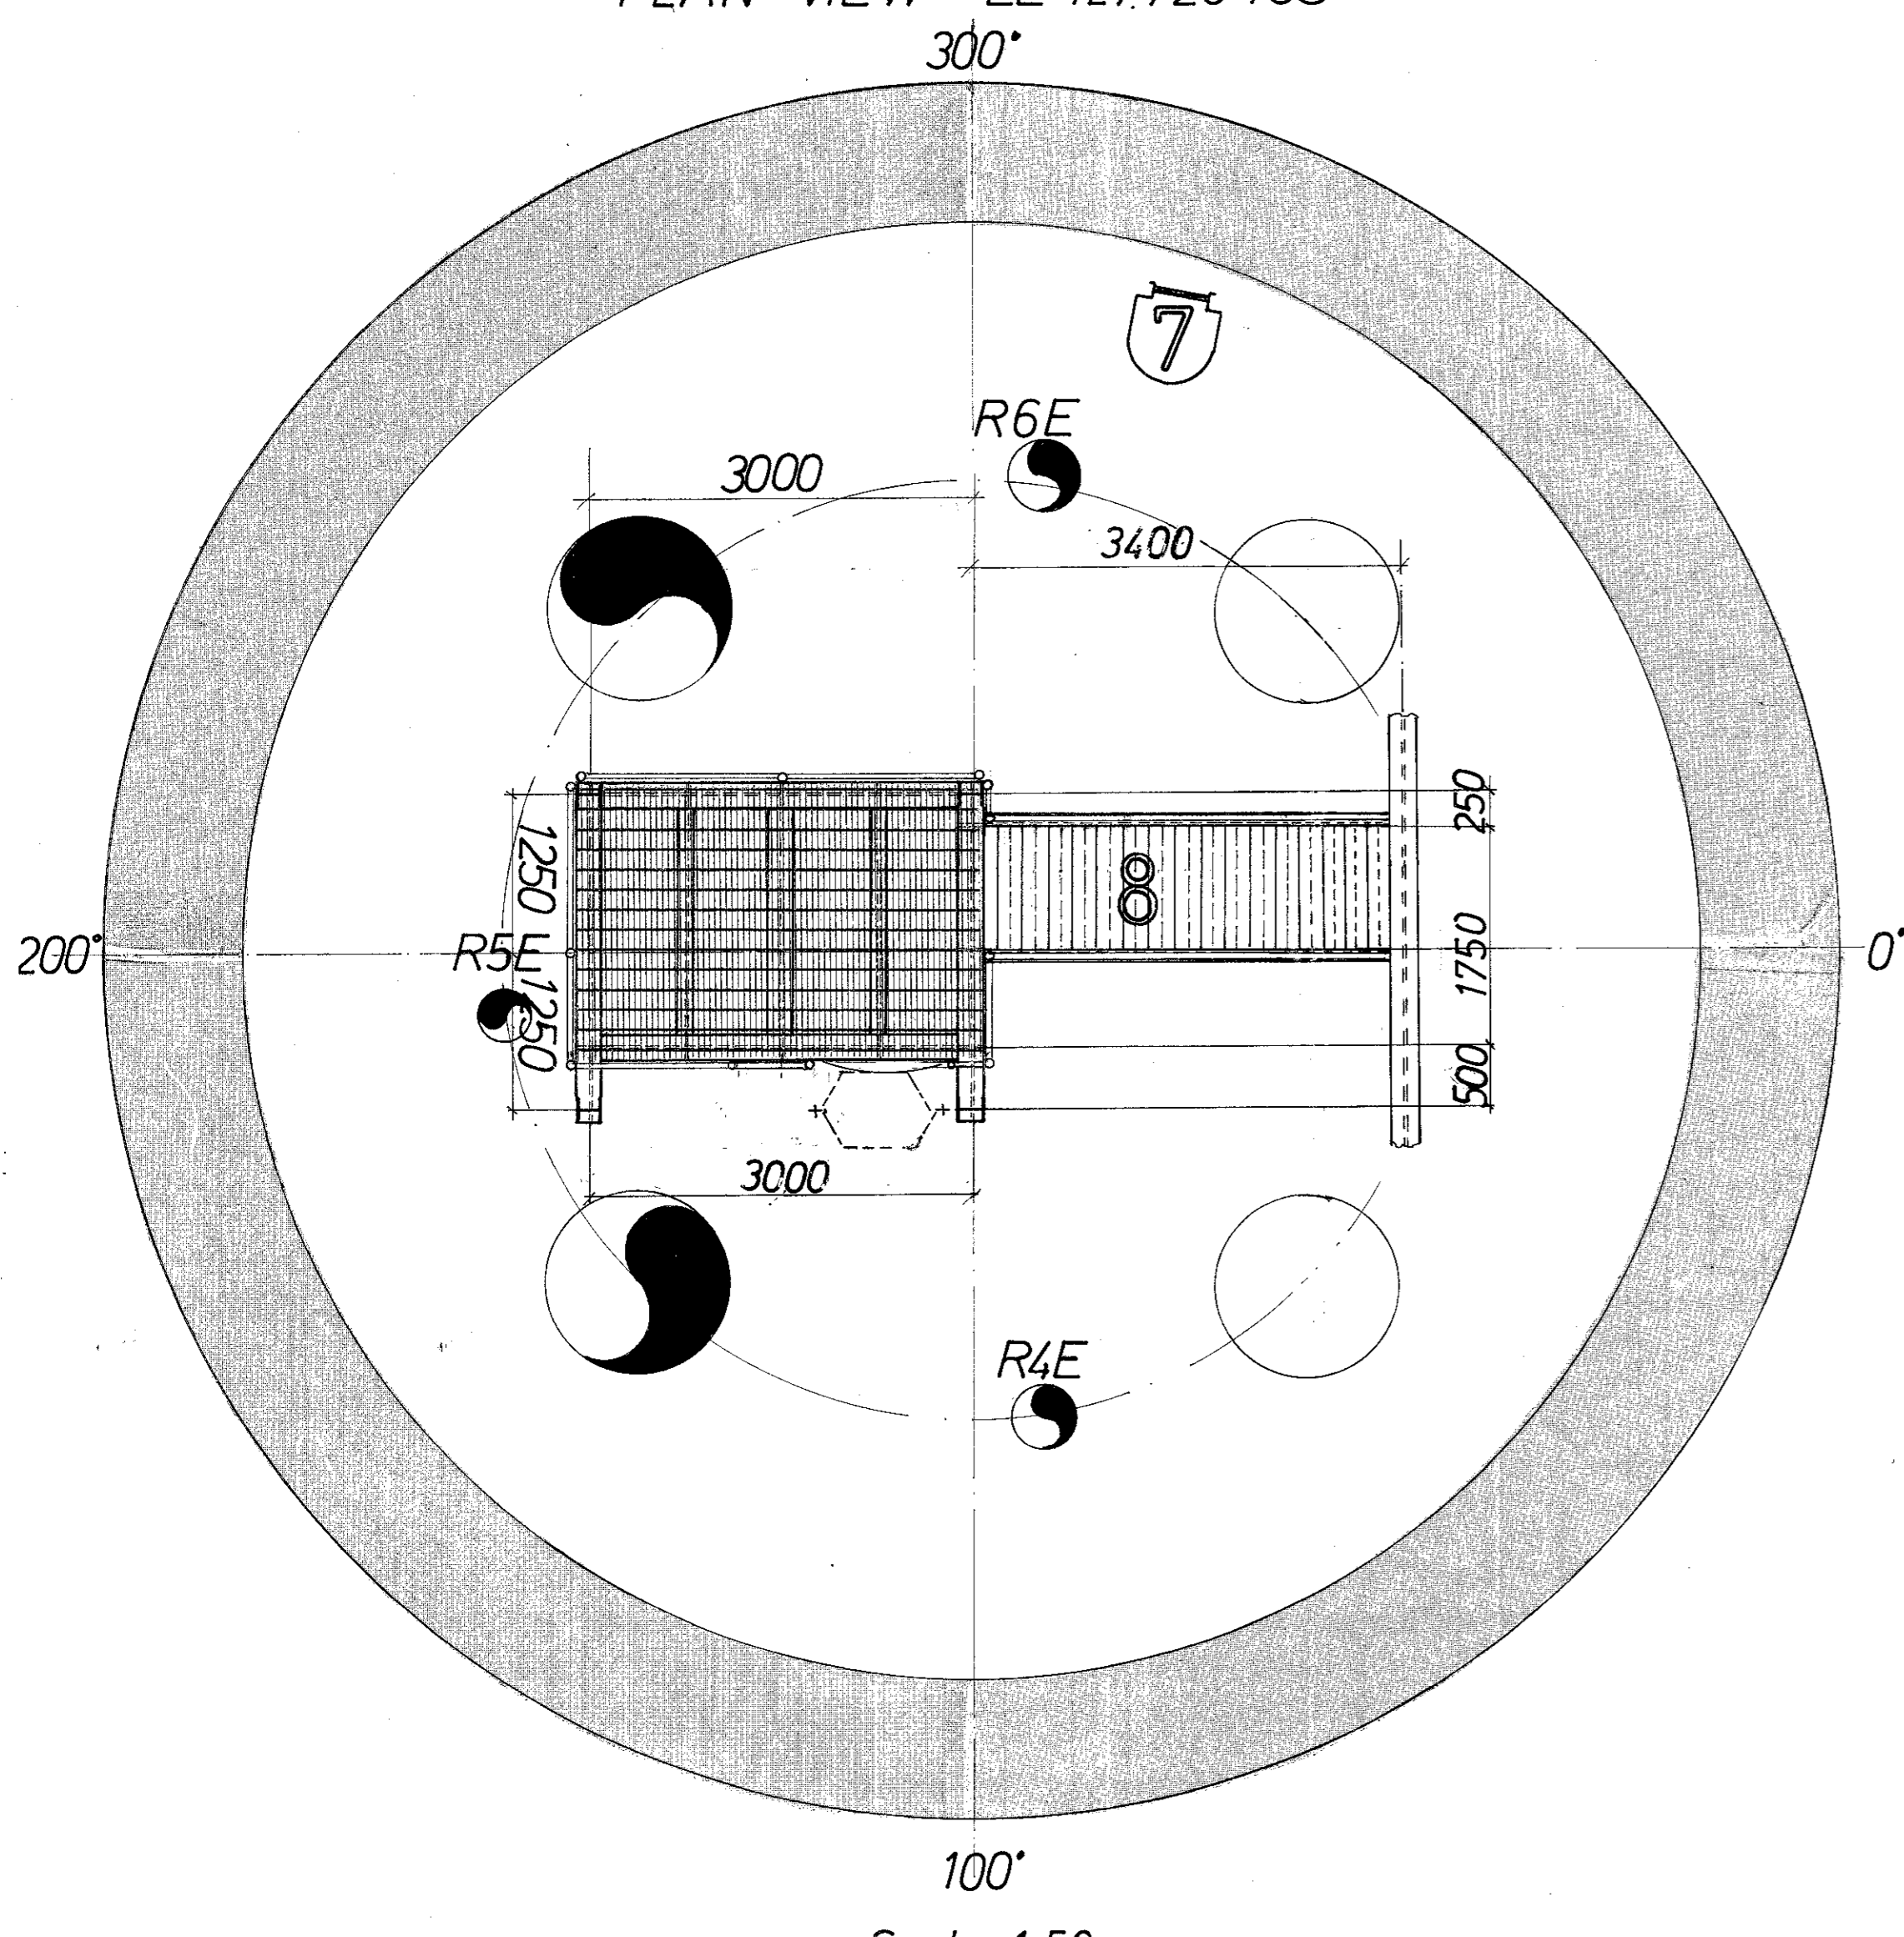

PLAN VIEW EL 131700 TOS AFTER TCP2 EXTENSION INSTALLATION

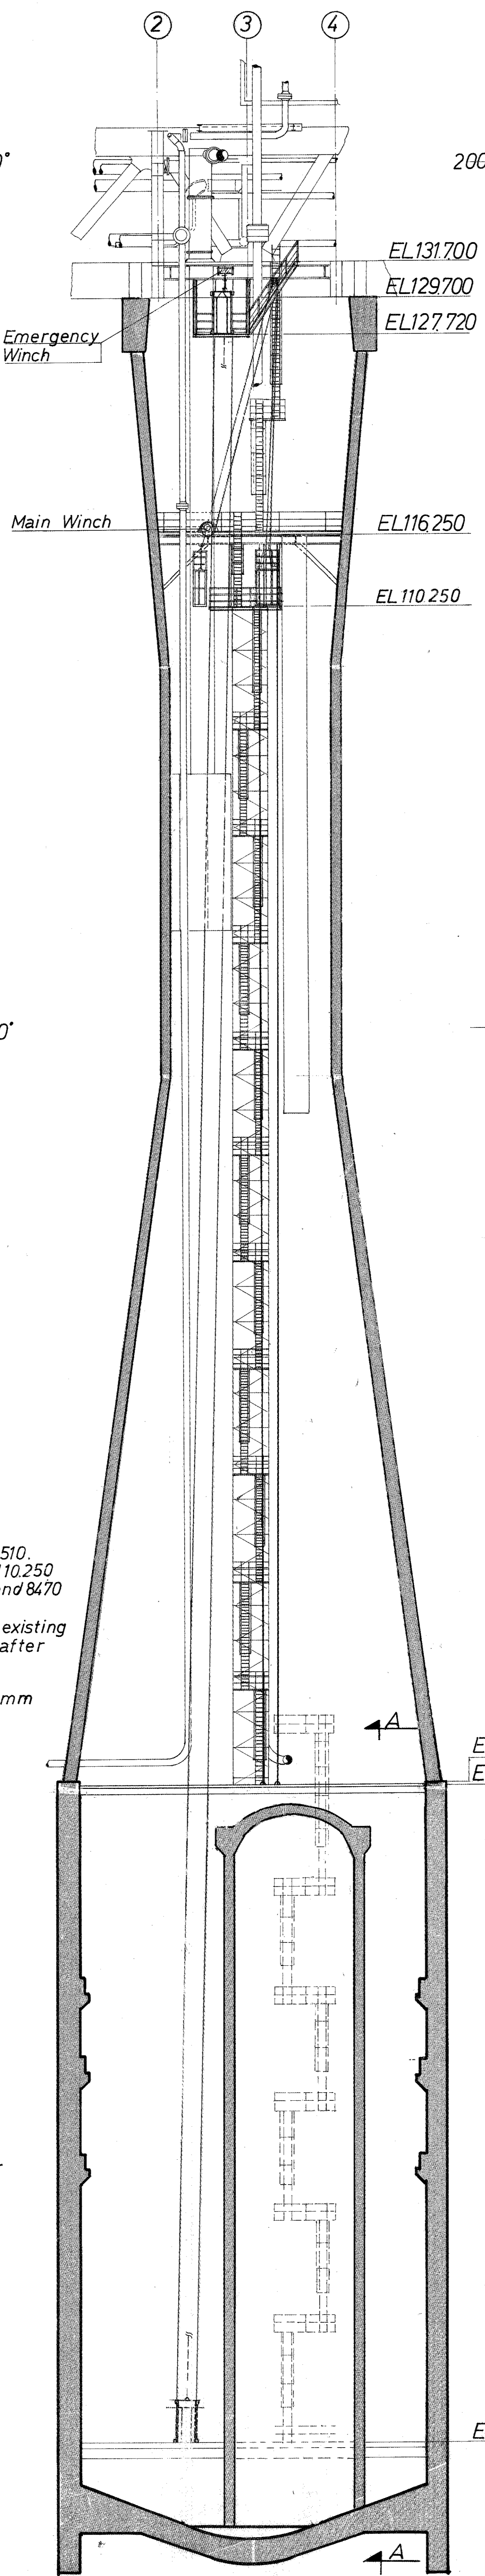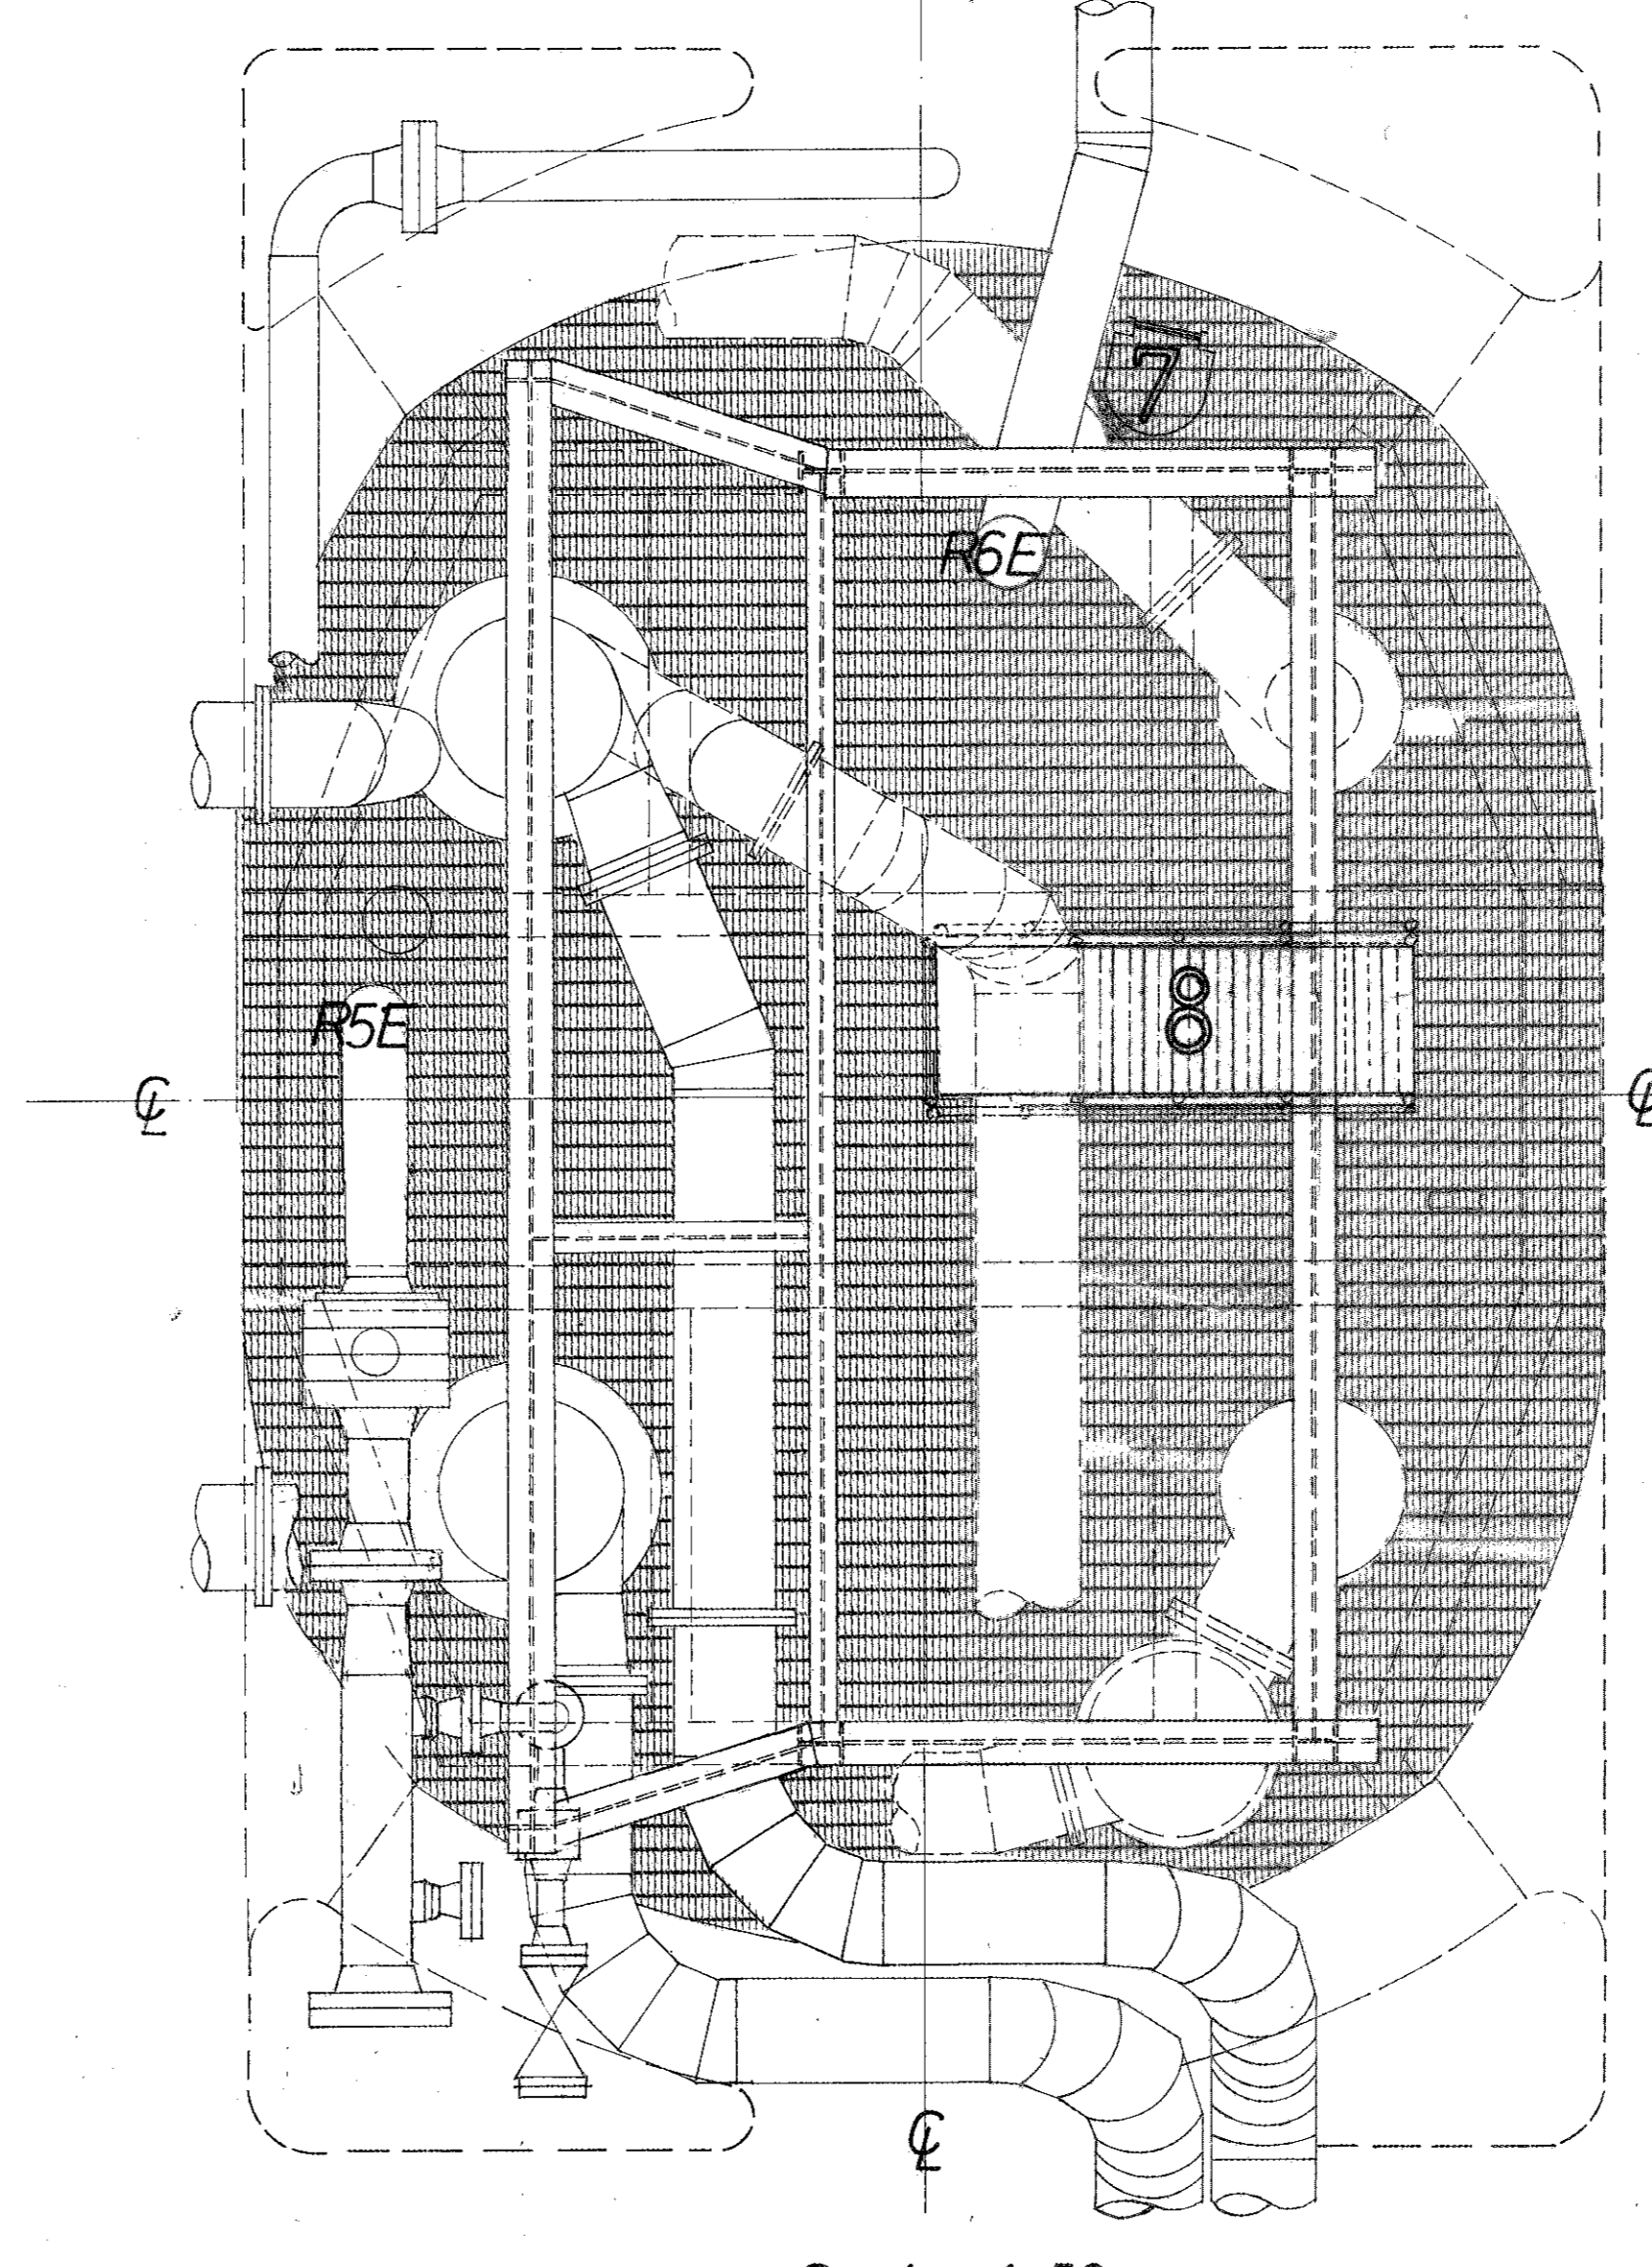

**NOTES:**  
 All new material to be RSt 37-2N or equal.  
 1) New platforms at EL 127720 and EL 112720. 2) New beam in deck at EL 131700 and EL 131510.  
 3) Stair from EL 131700 to EL 127720. 4) New beam at EL 116250. 5) Ladder from EL 116250 to EL 110250.  
 6) New ladder inside tower from EL 110250 to EL 45250. 7) New beams in deck at EL 45250 and 8470.

**PAINTING:** All material to be painted acc. to ELF painting spec. 1052 no 3-498 rev 1. (Also existing ladder-tower.) All new stair, ladders, handrails and grating to be hot dip galvanised after fabrication.

**GRATING:** Type BULL. Design load 5000 N, with serrated span bars, not to allow a 15 mm ball through the flooring.

**HANDRAILS:** All fixed type: FF 10 21 00 1000.

**BOLT etc:** All to be hot dip galvanised.

**MAIN WINCH:**

**EMERGENCY WINCH:**

**GUIDING WIRES:**

**MAIN CRADLE:** See dwg. FF 85 21 26. 4074, 4079, 4076, 4066.

**INSPECTION CRADLE:** See dwg. FF 85 21 26 4072, 4077, 4066.


**EMERGENCY CRADLE:** See dwg. FF 85 21 26. 4073, 4078, 4067.

**REFERENCE DWG:**  
 ELF: FF 85 21 26 4093

McDERMOTT - HUDSON: ELN 2177-B226-C226  
 KVAERNER - TECHNIP : 5424 W 5318 11650-2  
 BROWN & ROOT: A1 TCP-2-M443-M421-M424-M425-M426-M429-M557-M575-M576-M577-M578-M370-M371  
 CHRISTIANI NIELSEN: 33450-801, 33450-500  
 POTAIN: D 12 104 01 U 17 113 33

**STANDARDS:**  
 Gruvheisningsleg: Direktoratet for Arbeidstilsynet.  
 ELF; Fabrication: 1052 no 3-155 rev 2  
 Material: 1052 no 3-145 rev 4  
 Painting: 1052 no 5-498 rev 1  
 Design: NS 3472

**GENERAL NOTES:**  
 For number on accesses see dwg. FF 85 21 26 4045

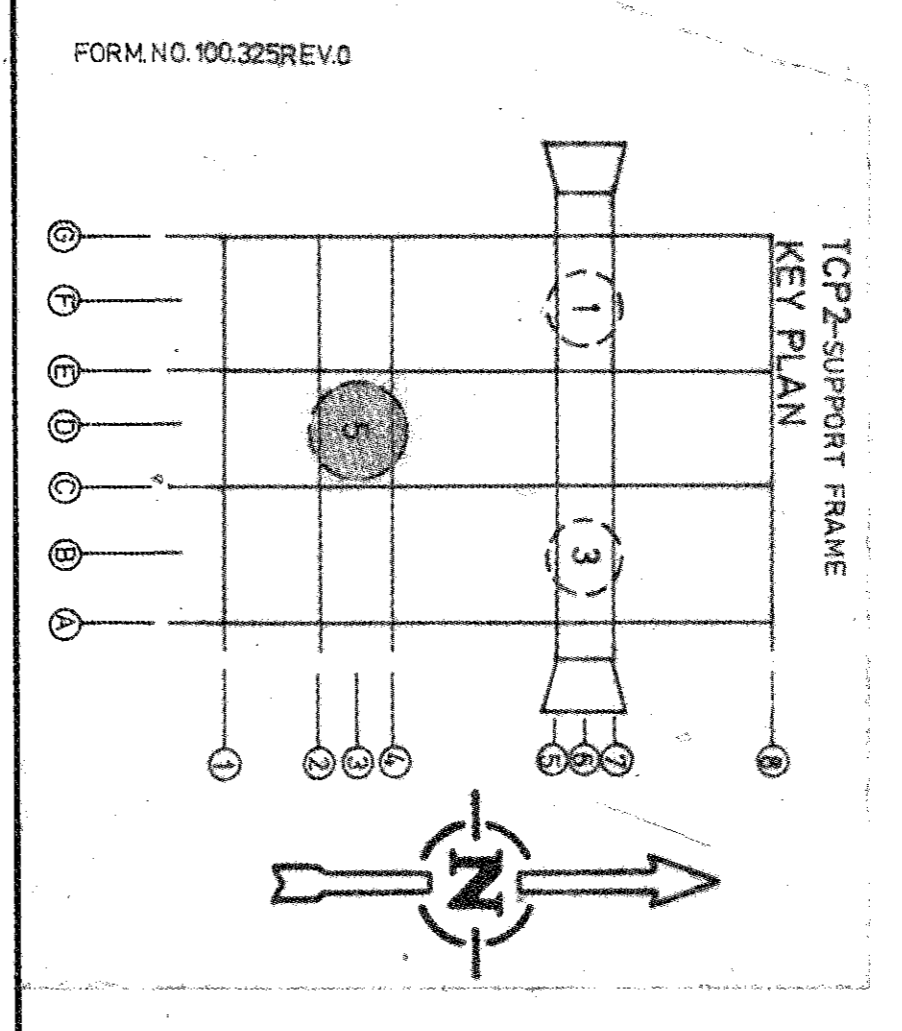

elf aquitaine norge a/s  
**APPROVED FOR CONSTRUCTION**  
 NAME: D. SOLTVEDT  
 SIGNATURE: [Signature]

**AS BUILT**  
 UP TO:

rev.	date	DESCRIPTION	by	app.
2	26.12.87	AS BUILT		
1	15.11.87	ISSUE FOR CONSTRUCTION	D.S.	D.S.
0	29.12.87	FIRST ISSUE	D.G.	

elf aquitaine norge a/s p.o. box 168 - 4001 Stavanger

Installation: TCP-2 System: STRUCTURAL

**GENERAL ARRANGEMENT ACCESSES IN COLUMN 5**

Job no. MR 85078  
 Scale 1:150

FRIGG FIELD Dwg. no. FF 85 21 26 4045 Rev. 2 Sheet 1/1

Scale 1:150

SECTION A-A