

MOTOR WIRING & SCHEMATIC DIAGRAM SHT. NO. 651
 M.C.C. UNIT NO. LF6 LE1

CABLE NO. 419 420

RELAY UNIT


643 657
 RA7 LG5 LF7 LC2

425 426 411 8009

RELAY BOX RB 1

646 648 643 673 643 642 647 653 656
 5 LA2 LD4 LC3 LC5 LG3 LC4 LF4 LF3

429 430 431 432 433 434 435 436 437

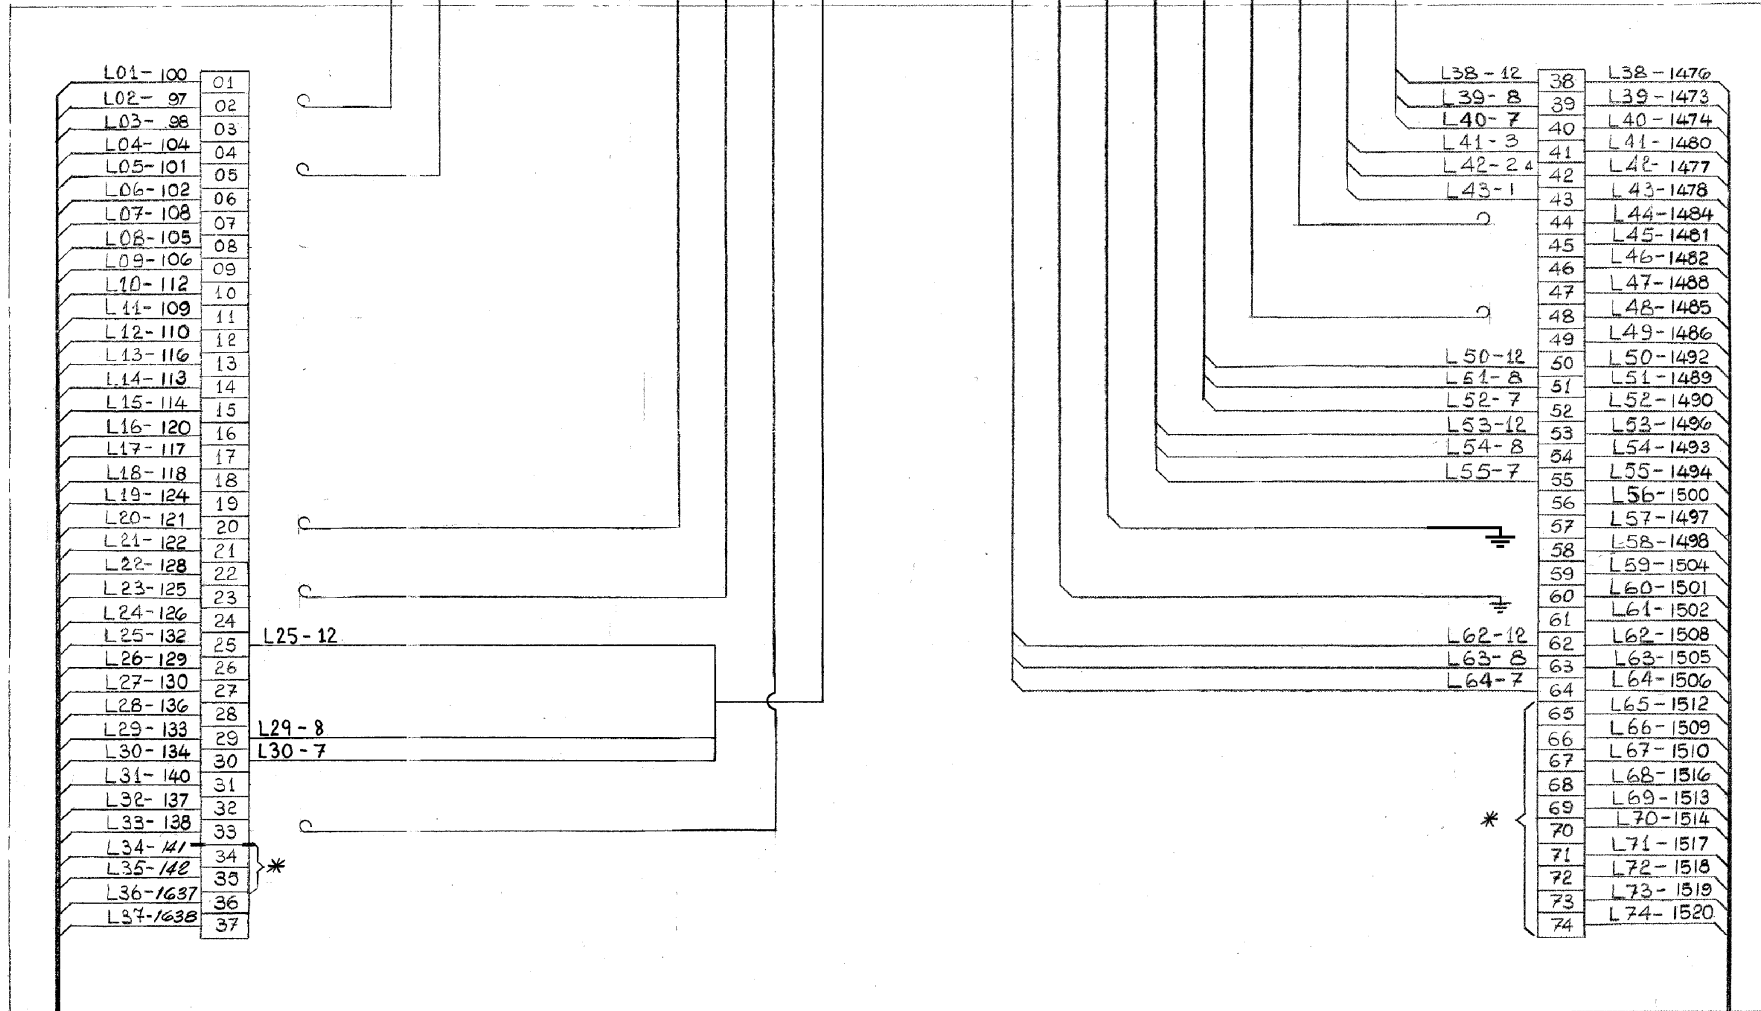

401 CABLE NO

FOR CONTINUATION SEE
 DWG. NO. ELN 2110 SHT. NO. 7117 & 7130
 FF95.16.00.104.0

TO INTERPOSING RELAY CABINET

402 CABLE NO

FOR CONTINUATION SEE
 DWG. NO. ELN 2110 SHT. NO. 7115
 FF95.16.00.103.8

LEGEND:
 L 01-12 CABLE CORE MARKING
 ———— TERMINAL NO. IN M.C.C. UNIT TO
 ———— TERMINAL NO. IN MARSHALLING BOX LEFT SIDE MARSHALLING BOX
 33
 34 TERMINAL PARTITION KLIPPON TYPE TW130A

* DENOTES SPARE CABLE CORES CONNECTED TO SPARE RELAYS IN INTERPOSING RELAY CABINET.

REFERENCE DRAWINGS

DWG. NO.	SHT. NO.	TITLE
ELN 2110	643-657	MOTOR WIRING & SCHEMATIC DIAGRAMS
IP/TP/1212	1 TO 3	PARSONS PEBBLES ARRANGEMENT OF LV SW BOARD
ELN 2110	7115 & 7117	INTERPOSING RELAY CABINET WIRING
ELN 2110	600 PAGE 27	ELECTRICAL CABLE SCHEDULE

12	12	UPDATED FOLIO 12119	15	10/75
13F	21/04/07	AS BUILT, REF WRM 85470	EL	POS
14	27/10/95	UPDATED MW95325X	PT	10/75
rev.	date	DESCRIPTION	by	app.
Contractor: elf equitaine norge a/s p.o. box 188 - 4001 Stavanger Dev. no.: FF 25 23 03 0080 Rev. 15F Sheet 1/3				

ELF - NORGE
 FRIGG FIELD

TREATMENT PLATFORM NO 1
 NORTH SEA JOB 1-40-C2 W.D. 104 M

McDERMOTT-HUDSON
 LONDON - ENGLAND

APPROVED:
Toby Darnley
 DATE: 13/10/75
 ENGINEERS APPROVAL

AS BUILT
 TO INFORMATION RECEIVED
 UP TO NOVEMBER 1977

CUSTOMER APPROVAL
 BY: *gum*
 DATE: 27.10.75

FAB. STDS. REQ'D. THIS SHT

DESIGN	ELEC.	INSTR.	PIPING	STRUCT.	NO.	BY	DATE	REVISIONS	DATE	APP.	DESIGN	ELEC.	INSTR.	PIPING	STRUCT.	NO.	BY	DATE	REVISIONS	DATE	APP.
	LD	LD			4	REP	21.4.76	TERMINALS L41-5 WERE L41-6	30.9.76	JJ						3	JS	7.2.76	CORE REF N° ADDED	21.11.76	LD
		LD			5	MB	12.11.76	LA2 WAS LD3, TERM N° & NOTE ADDED	24.3.77	LD						2	FW	23/10/75	ISSUED FOR A.F.C.	27.10.75	JJ
					6	LD	15.10.77	ISSUED AS BUILT	15.10.77	LD						1	MC	29 SEP	ISSUED FOR APPROVAL	13.10.75	JJ
					7	SL	7/11/77	REVISED TO INCORPORATE CONDENSATE SYSTEM mod & FURTHER AS BUILT INFO	3.12.77	LD						0	CG	4 SEP	ISSUED FOR PINK		JJ

PROJECT	STRUCTURAL	MECHANICAL	ELECTRICAL	INSTALLATION	T&E CHECK	PROP. CHECK
BY	DATE	DATE	DATE	DATE	DATE	DATE
23	12.10.75					
DRAWN BY	SCALE	DATE	DWG. NO.			
R. LATKA	N.T.S.	15-8-1975	ELN 2110			
DESIGNED BY			SHEET NO.			
R.L.			641 PAGE 1 of 3			
LEFT SIDE MARSHALLING BOX [MB] WIRING						