


TOP OF TOWER PLATFORM EL. 88782

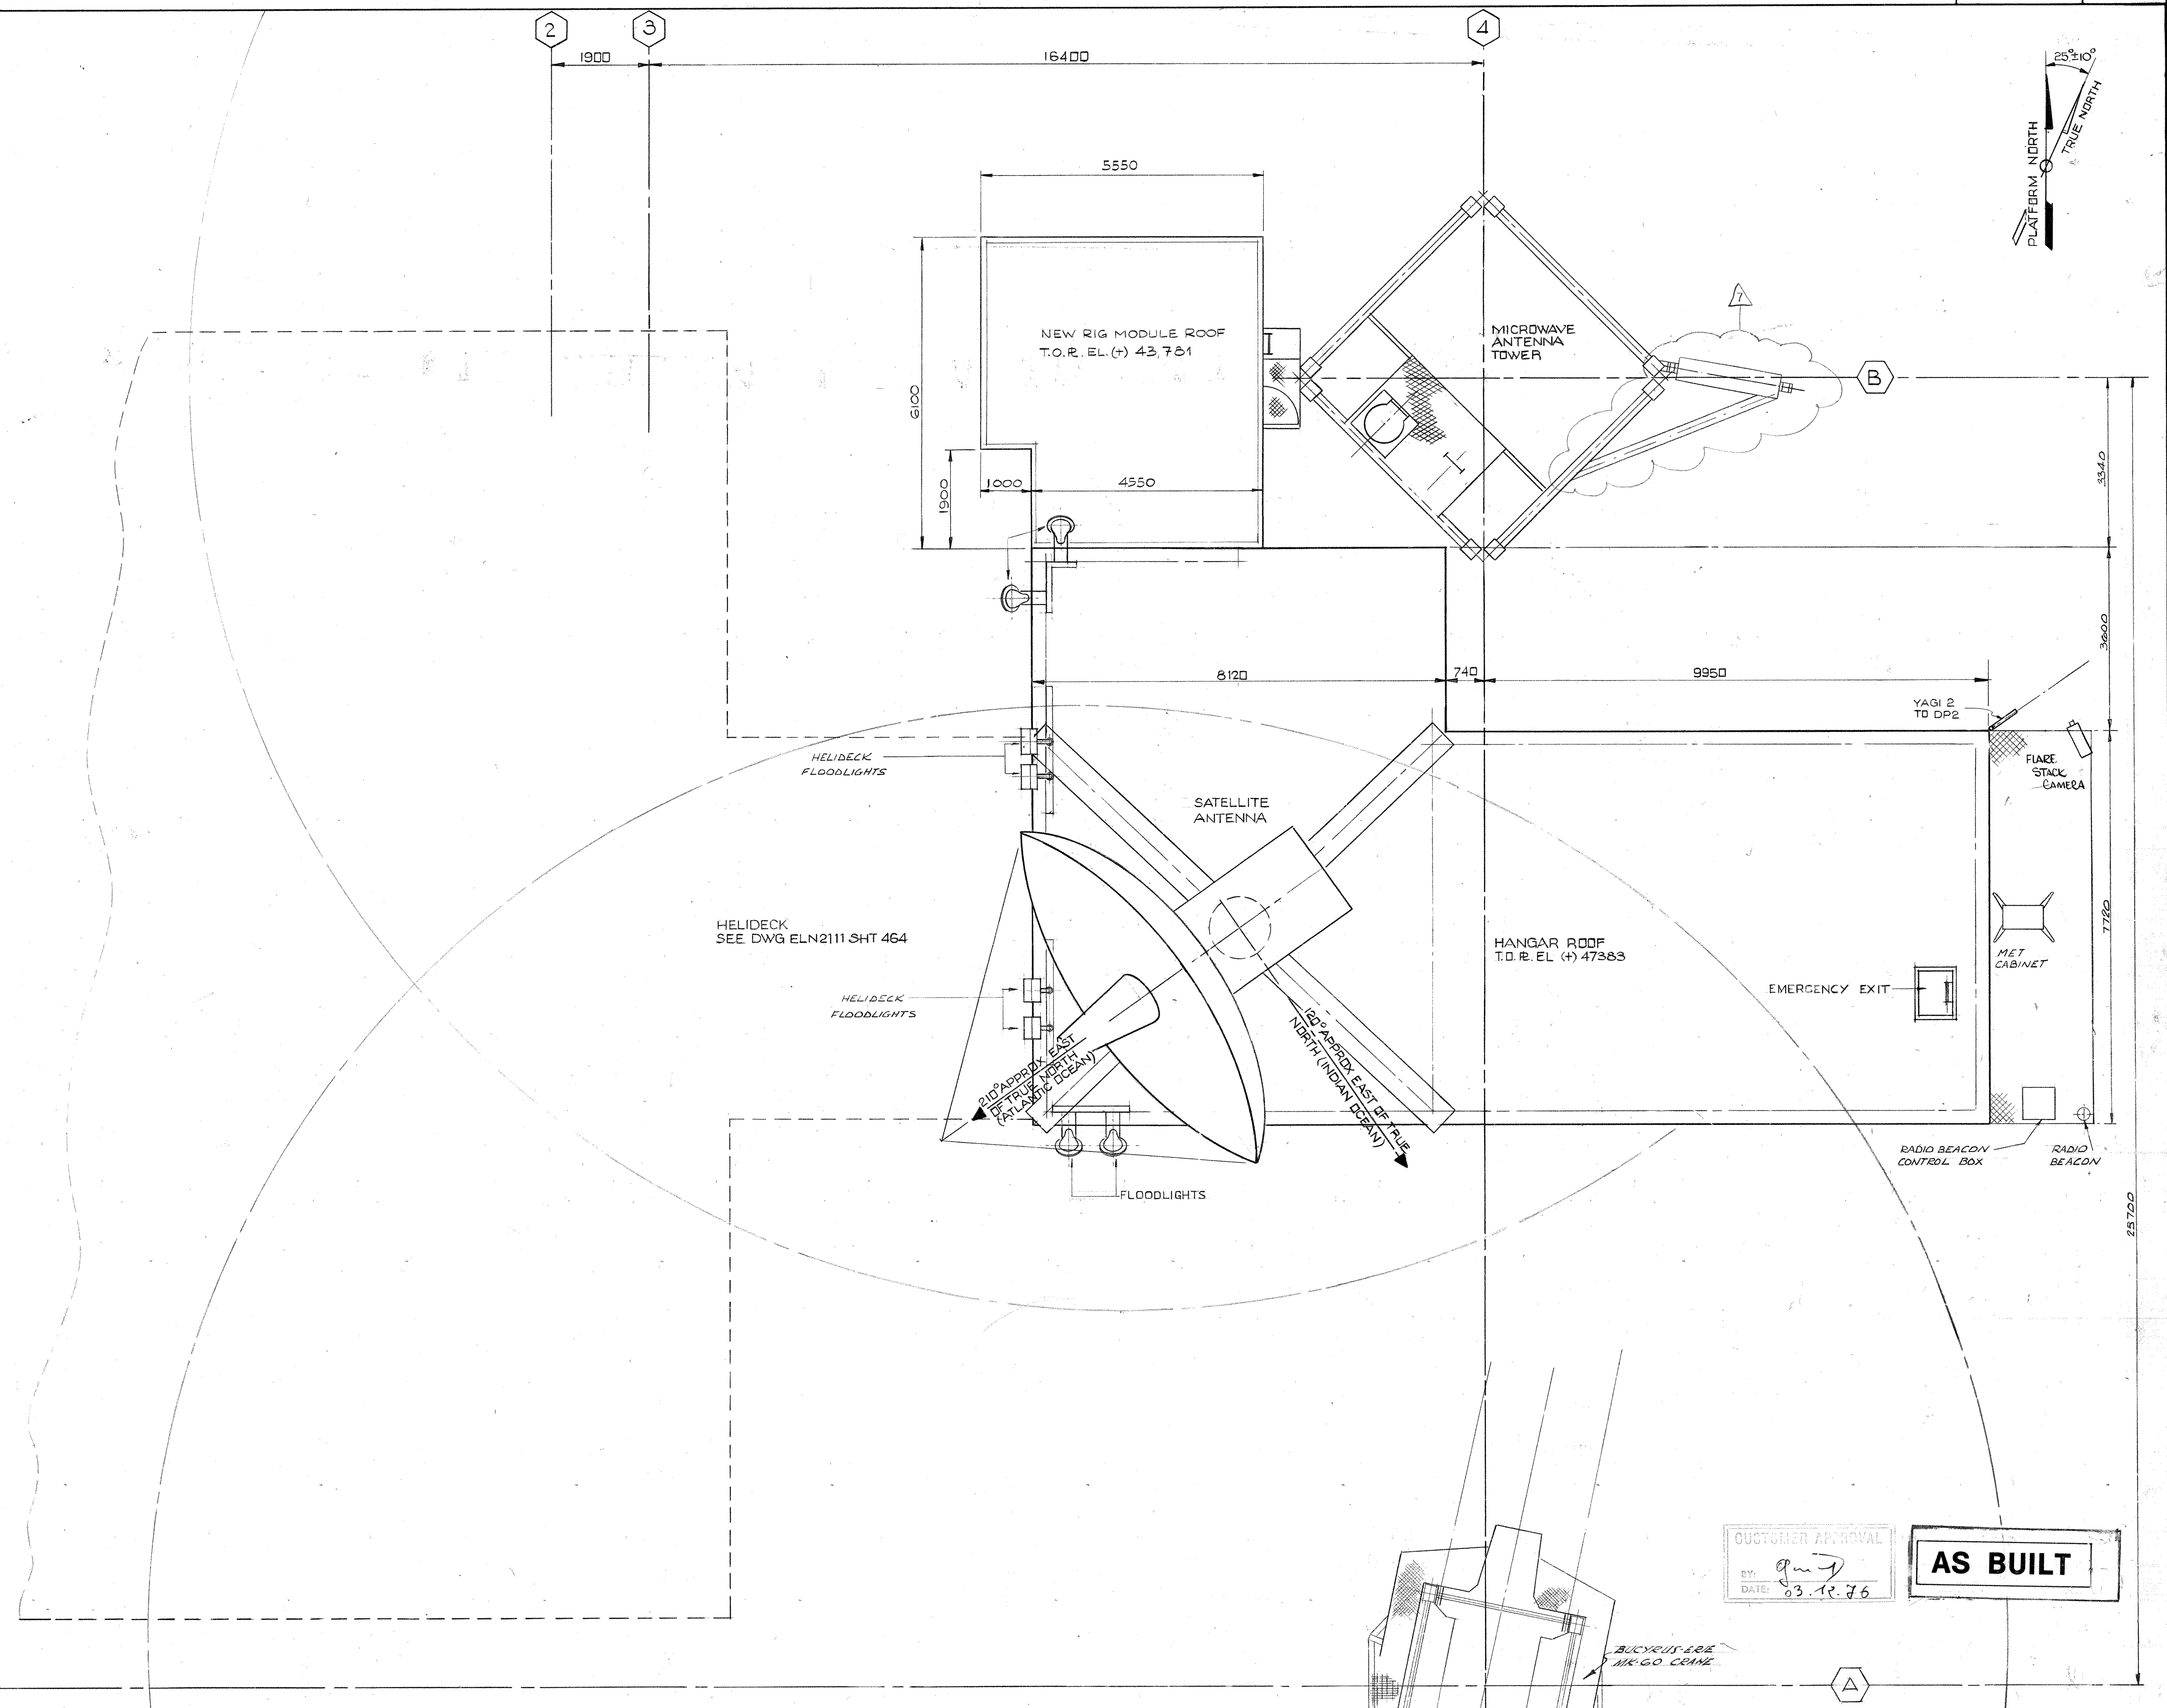

CUSTOMER APPROVAL
 BY: *[Signature]*
 DATE: 03.12.76

AS BUILT

APPROVED: <i>[Signature]</i> PROJECT MANAGER: HUDSON DATE: 21/12/76 ENGINEERS APPROVAL		ELF - NORGE FRIGG FIELD NORTH SEA JOB 1-40-D2 W.D. 104 M	
DRAWN BY: C.E. REEVE SCALE: 1:50 DATE: JAN '75 DESIGNED BY:		McDERMOTT - HUDSON LONDON - ENGLAND DWG. NO. ELN 2111 SHEET NO. 465	
OVERALL EQUIPMENT & ARCHITECTURAL PLOT PLAN HANGAR, ROOF LEVEL +EL 47383			

NO.	DATE	BY	REVISIONS
0	20/12/75	CER	FOR APPROVAL
1	21/12/75	CER	GENERALLY REVISED
2	27-7-75	DER	REVISED
3	16/10/76	PS	ROOF LIGHTS, SATELLITE ANTENNA, RADIO BEACON, FLARE STACK, ADJUST & REVISIONS TO HANGAR, PIPING