


TOTAL
14/9 MCP-01

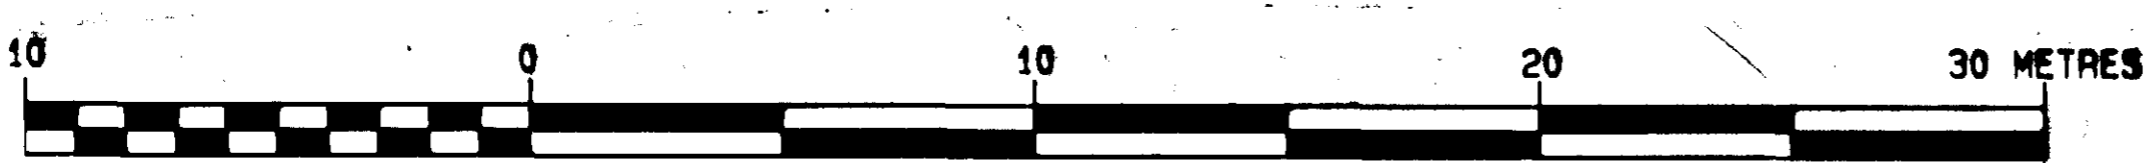

rev	315	AS BUILT	by	
date				
drawn:	A. M'NEIL			
date:	31-5-87			
checked:	R			
date:				
title:		TOTAL OIL MARINE p.l.c.		
description:		OVERALL PLATFORM LAYOUT NORTH ELEVATION		
diag. no:		MP-TOMA-M-0-00-5008		rev: 2