


EL 185.765.
 EL 182.800.
 PL EL 173.070.
 EL 158.070.
 EL 158.070.
 EL 158.094.
 PL EL 152.800.
 T.O.S. EL 148.250.
 PL EL 148.250.
 EL 147.800.
 EL 146.100.
 EL 144.900.
 EL 142.268.
 EL 137.024.
 EL 135.000.
 EL 131.965.
 EL 129.000.
 EL 123.800.
 EL 117.350.
 EL 116.700.
 EL 105.000.
 EL 96.100.
 EL 94.000.
 EL 92.000.

TOTAL 14/9 MCP-OI

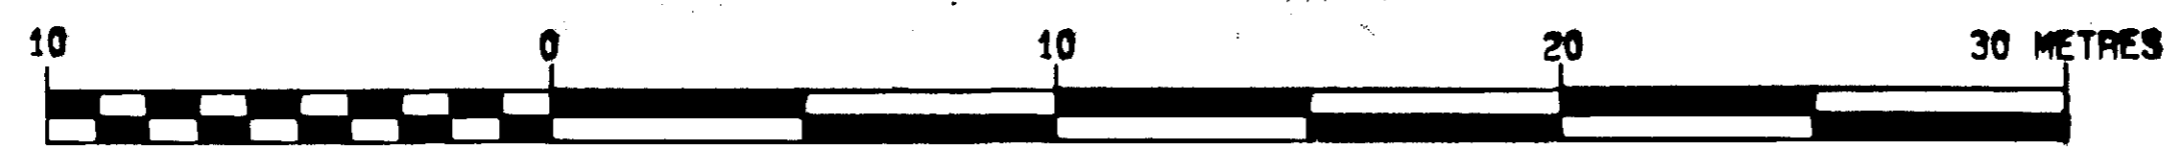

Z	3/5	AS BUILT.	0/1/1
rev	date	description	by
drawn:	AMF/NEL	TOTAL OIL MARINE p.l.c. OVERALL PLATFORM LAYOUT SOUTH ELEVATION	
date:	31-5-87		
checked:	[Signature]		
date:			
dra. no:	MP-TOMA-M-0-00-5010	rev:	2