


PA 201
MUD PIG RECEIVER
(NOT IN USE)

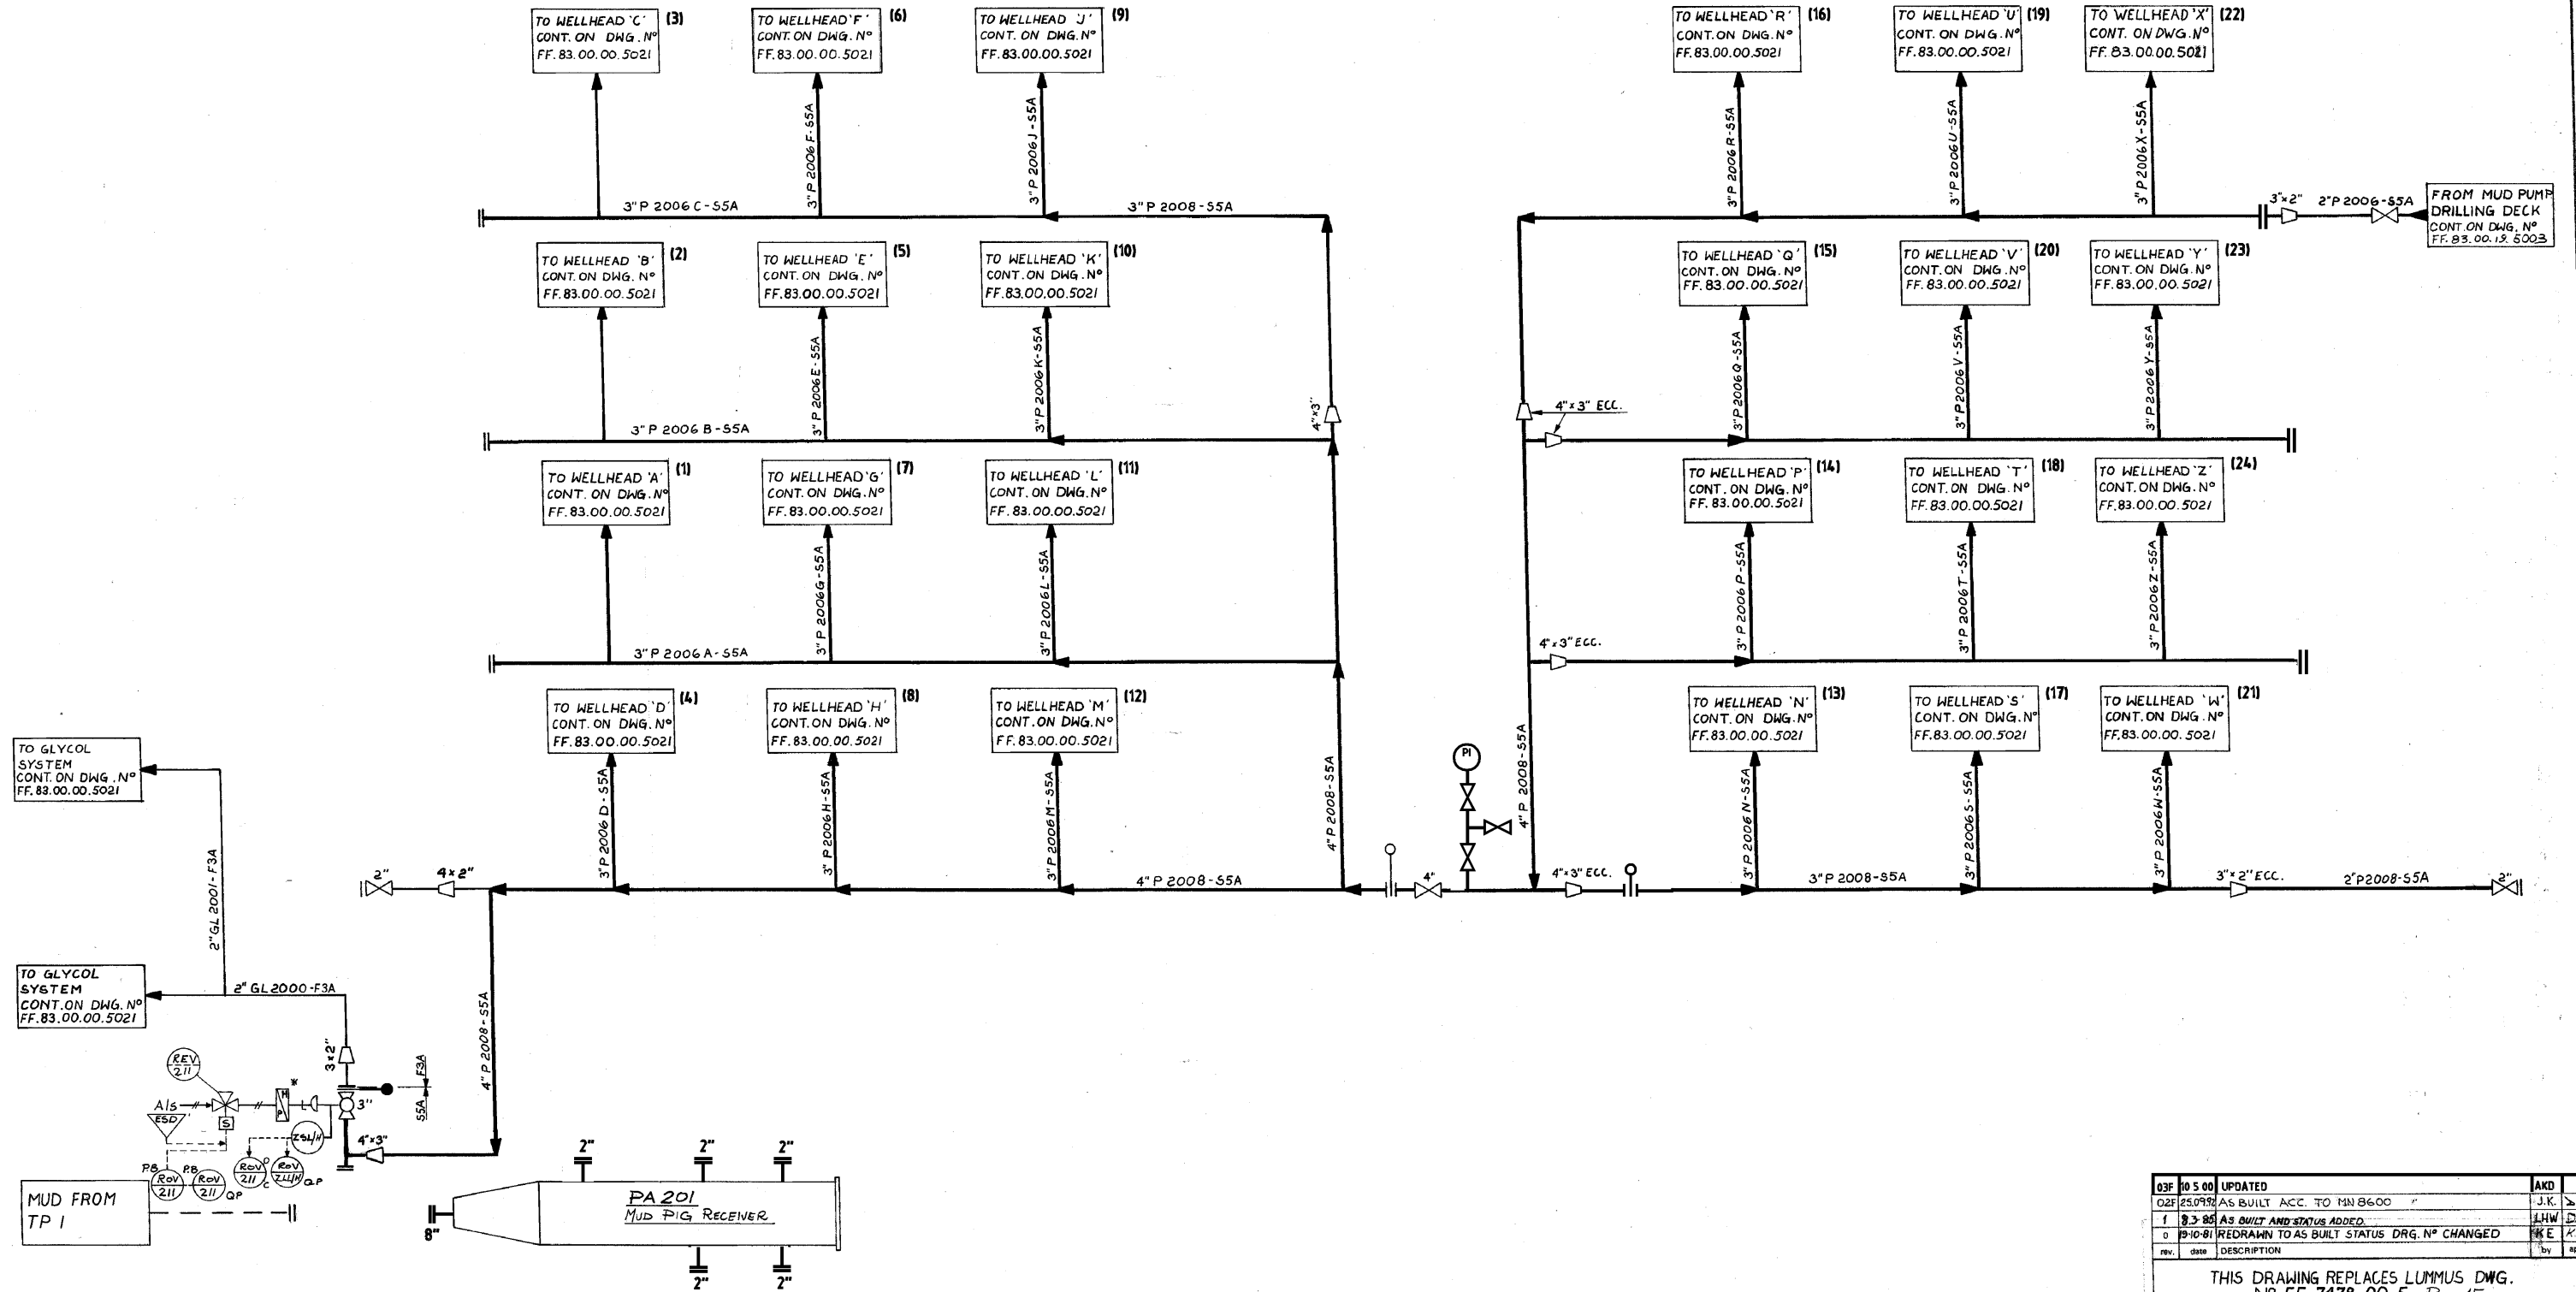

AS BUILT
UP TO: 19-10-81

03F	10 5 00	UPDATED	AKD
02F	25 09 92	AS BUILT ACC. TO MN 8600	J.K.
1	3 3 85	AS BUILT AND STATUS ADDED	LHW
0	19 10 81	REDRAWN TO AS BUILT STATUS DRG. N° CHANGED	K/E
rev.	date	DESCRIPTION	by

THIS DRAWING REPLACES LUMMUS DWG.
N° EF. 7478.00.5 Rev. 15

elf aquitaine norge as		p.o. box 168 - 4001 Stavanger	
A	Installation	DP2	System
Job no. PIPING AND INSTRUMENT DIAGRAM			
Scale MUD SYSTEM			
FRIGG FIELD	Drwg. no. FF 83 00 19 5024	Rev. 03F	Sheet 1/1

* CAMERON HYD. UNIT.

<DATA>

<USERNAME>KFTLNAV2