


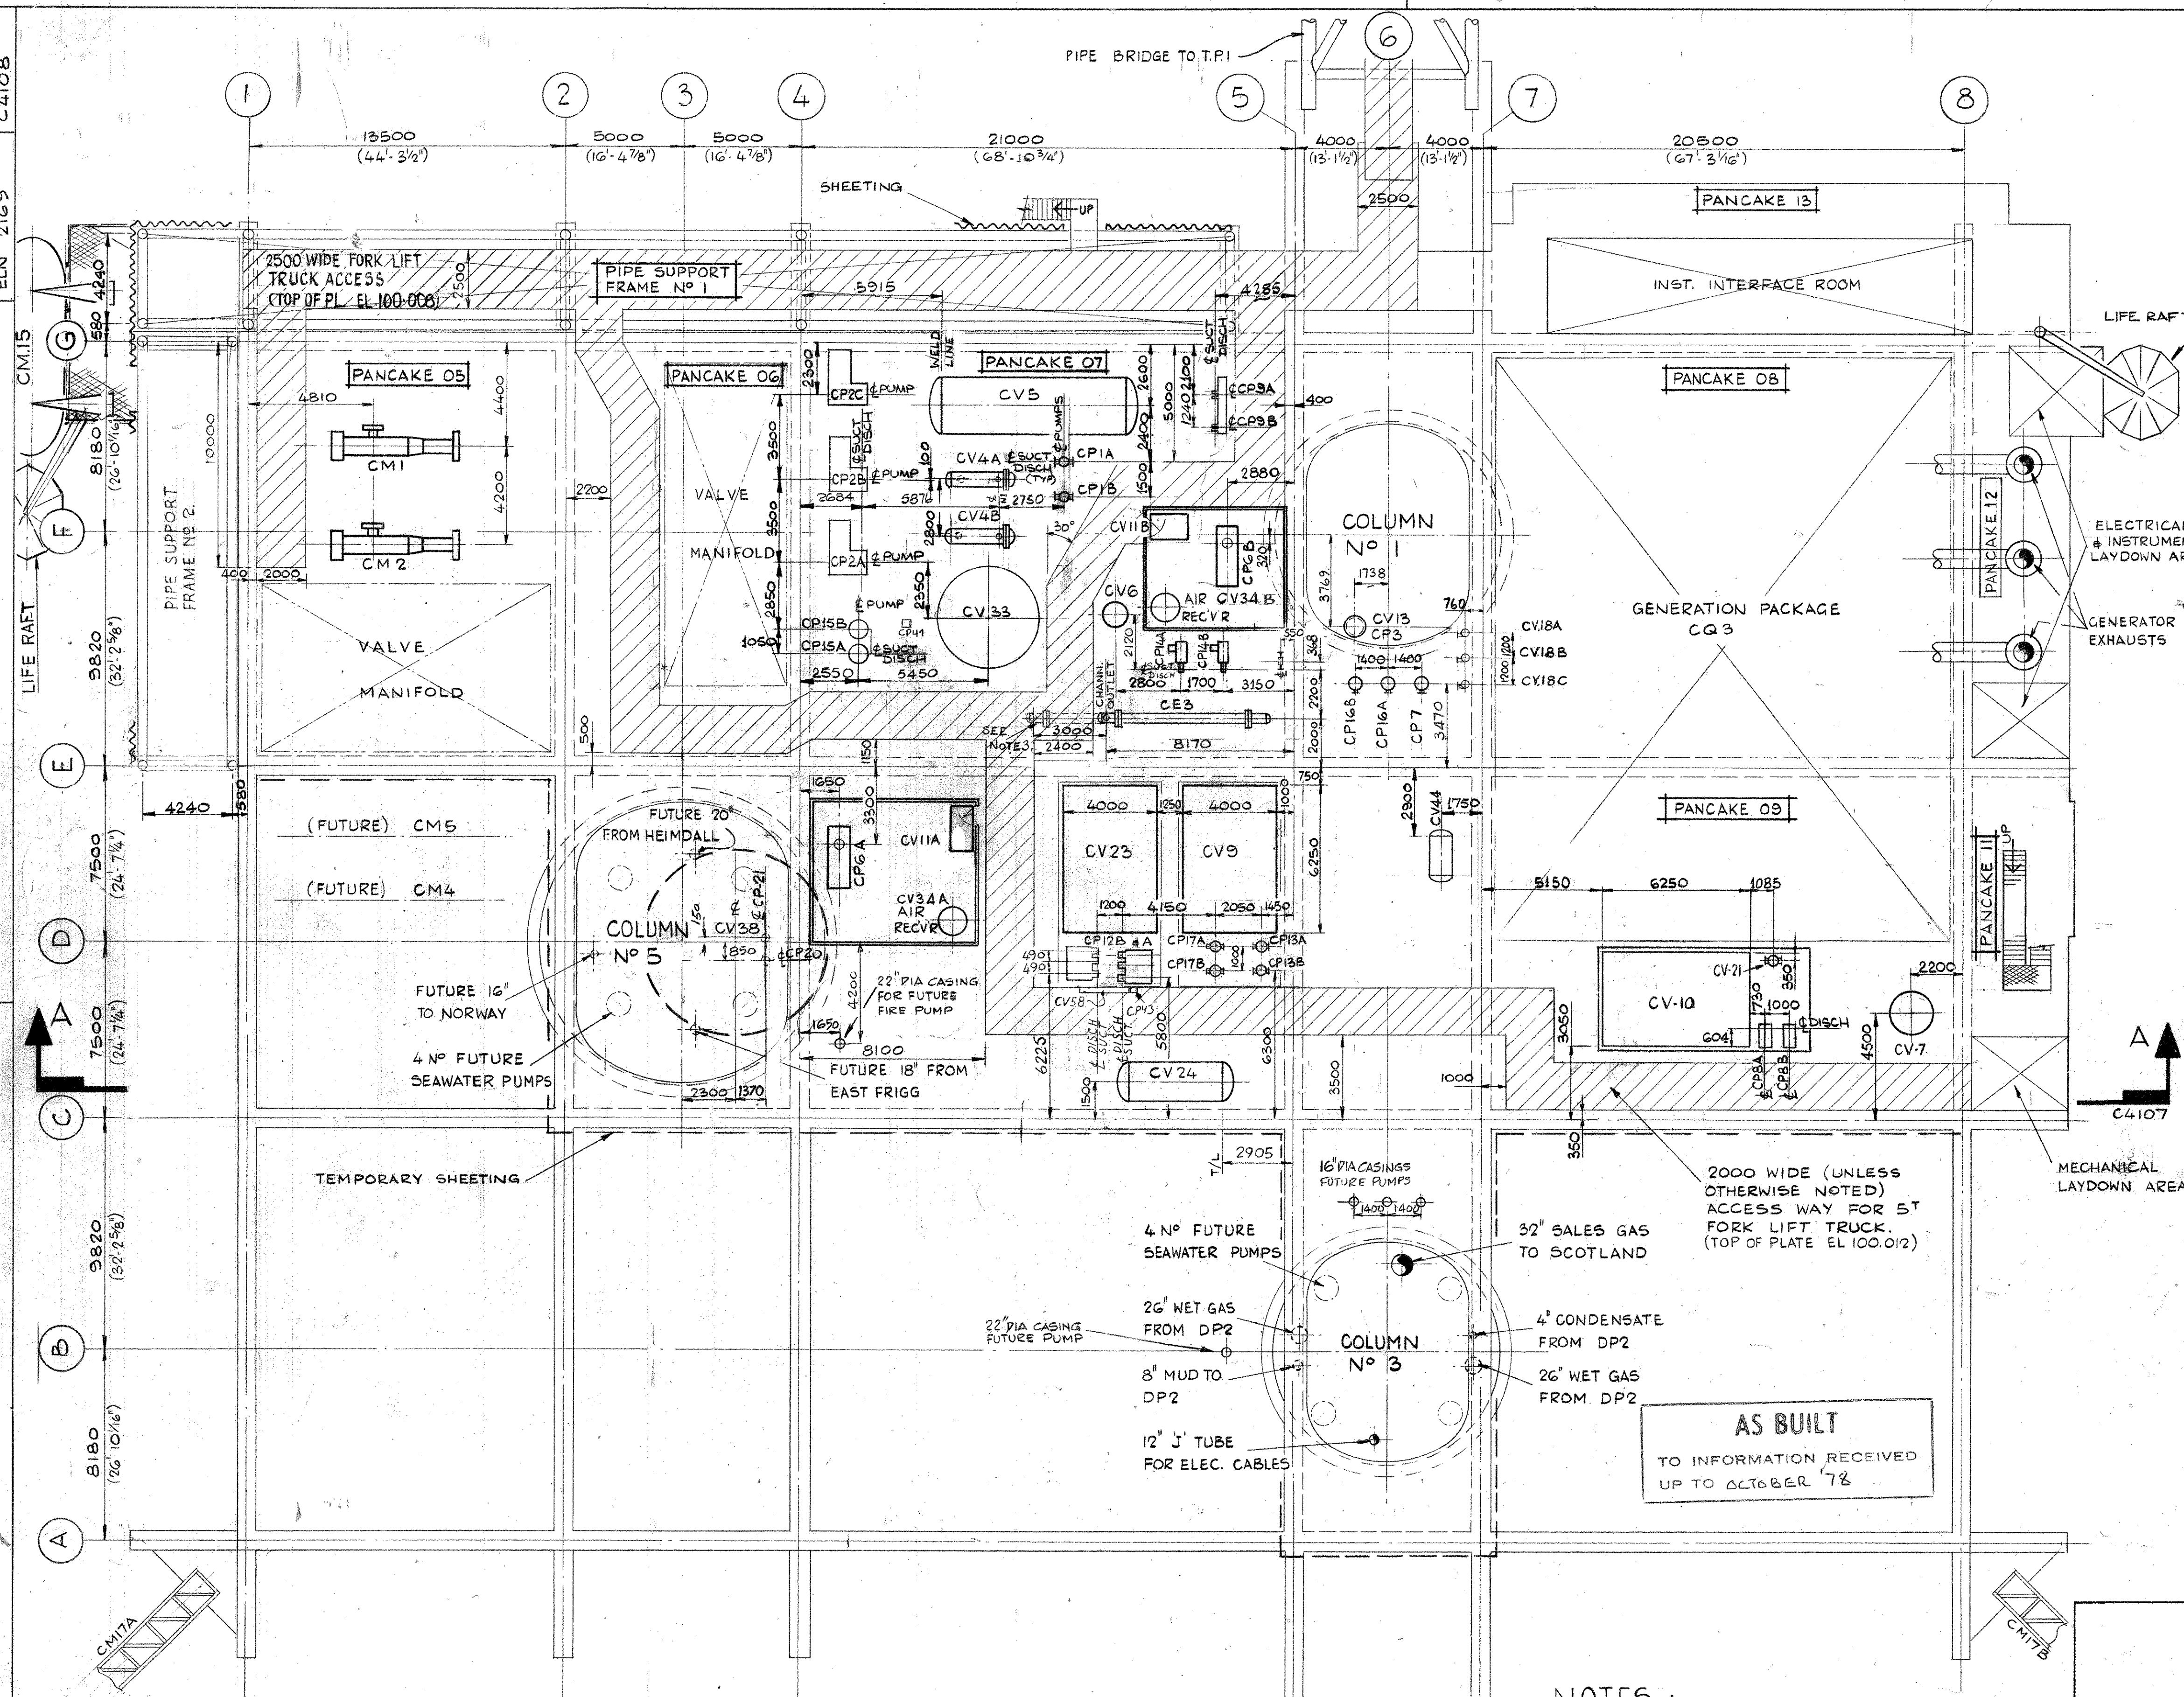

PLATFORM NORTH

EQUIPMENT NO	DESCRIPTION	ELEVATION
CV4A & B	COALESCE	EL 101.380
CV5	OIL SKIMMER	EL 102.106
CV6	FUEL GAS SCRUBBER	BTM. TAN/LINE EL 100.770
CV7	L.P. VENT SCRUBBER	BTM. TAN/LINE EL 101.008
CV9	GLYCOL STORAGE TANK	U/SIDE SKID EL 100.008
CV10	DIESEL STORAGE TANK	U/SIDE SKID EL 100.008
CV11A & B	DIESEL DAY TANK (FIRE PUMP HOUSE)	U/SIDE SKID EL 102.500
CV13	SUMP CAISSON	EL 100.440
CV21	DIESEL FILTER	EL 100.008
CV23	METHANOL STORAGE TANK	U/SIDE SKID EL 100.008
CV24	H.P. RELIEF SCRUBBER	EL 102.780
CV31	GLYCOL CHARCOAL FILTER	EL 101.500
CV33	CONDENSATE RECYCLE TANK	U/SIDE BASE PL. EL 100.008
CV38	CONDENSATE STORAGE TANK	COLUMN 5
CP1A & B	CONDENSATE BOOSTER PUMPS	EL 100.333
CP2A, B & C	COND. RETURN PUMPS (CV29)	EL 100.344
CP3	SUMP PUMP	F.O.F. DISCH. EL 100.542
CP6A & B	FIRE WATER PUMP (CV11 & AIR REC.V)	EL 100.440
CP7	WASHDOWN PUMP	EL 100.408
CP8A & B	DIESEL PUMP	EL 100.512
CP9A & B	SLOPS OIL PUMPS (CV30)	F.O.F. DISCH. EL 100.371
CP15A & B	CONDENSATE RECYCLE PUMPS	EL 100.371
CP12A & B	METHANOL INJECTION PUMPS (CV32)	F.O.F. DISCH. EL 101.082
CP13A & B	GLYCOL FILL PUMPS	EL 100.512
CP14A & B	GLYCOL INJECTION PUMPS	F.O.F. DISCH. EL 100.707
CP16A & B	WATER CURTAIN PUMP	EL 100.408
CP17A & B	METHANOL TRANSFER PUMPS	EL 100.512
CP20	CONDENSATE STORAGE PUMP	COLUMN 5
CP21	OILY WATER PUMP	COLUMN 5
CQ3	TURBINE GENERATOR PACKAGE	
CP41	METHANOL WATER TRANSFER PUMP	EL 101.040
CV44	AIR RECEIVER (GEN. PACKAGE)	EL 101.508
CV58	METHANOL DRAINTANK FOR CP12A & B	EL 100.008
CV34A & B	AIR RECEIVER (FIRE PUMP HOUSE)	
CQ12A & B	FIRE PUMP HOUSE VENT/PRESS. PACKAGE	
CM1	26" PIG RECEIVER (GAS FROM DP2)	EL 101.419
CM2	26" PIG RECEIVER (GAS FROM DP2)	EL 101.419
CM4	20" PIG RECEIVER (FROM HEIMDALL FUTURE)	
CM5	18" PIG RECEIVER (FROM EAST FRIGG FUTURE)	
CM15	OPEN LAUNCH	
CM17A & B	CONDENSATE BURNER BOOMS	
CE3	FUEL GAS EXCHANGER	EL 101.075
CV18A, B & C	TURBINE GAS DEMISTERS	F.O.F. GAS OUTLET EL 101.558
CP43	METHANOL DRAINAGE PUMP (CV58)	EL 100.008
CP42	FUEL GAS CONDENSATE DRAINAGE PUMP	EL 100.118

REFERENCE DRAWINGS:
PLOT PLAN - MAIN DECK C4105
PLOT PLAN - UPPER DECK C4106
PLOT PLAN - SECTION A-A C4107

NOTES :-

- PLATFORM REFERENCE EL 100.000 IS THE THEORETICAL TOP OF STEEL ELEVATION OF THE LOWER CHORD OF THE MAIN TRUSSES. 100.000 = +27.240 METRES ABOVE (L.A.T.)
- /// DENOTES FORKLIFT TRUCK ACCESS WAY.
- DOTTED LINE INDICATES EQUIPMENT LOCATION DURING LIFTING OF PANCAKE.

CUSTOMER APPROVAL
BY: *[Signature]*
DATE: 18.9.75

APPROVED
[Signature]
M. DERMOTT
DATE: 18/9/75
ENGINEERS APPROVAL

ELF - NORGE
FRIGG FIELD

TREATMENT / COMPRESSION
PLATFORM No.2

NORTH SEA JOB 1-40-E2 WD. 104-M

McDERMOTT - HUDSON
LONDON - ENGLAND

DRAWN BY: V. ASHFORD
DESIGNED BY: V. ASHFORD
SCALE: 1:150
DATE: 22.5.75
DWG. NO. ELN 2169
SHEET NO. C4108

PLOT PLAN - CELLAR DECK

DESIGN	ELEC.	INSTR.	PIPING	STRUCT.	NO.	BY	DATE	REVISIONS	DATE	APP.	DESIGN	ELEC.	INSTR.	PIPING	STRUCT.	NO.	BY	DATE	REVISIONS	DATE	APP.
7	DW	3-877	SP2C & CV46 WERE FUTURE & FUTURE PUMPS & LIFE RAFTS ADDED. CP20 DRUG. 10.2.77								8	JEM	24/4/78	CM15 POSITION ALTERED & LIFE RAFT EQUIP. NO. REVISED. CS1 REVISED					24/4/78		
6	CS	20.8.76	CV15, CV18A, CV13, CP15, CP1A & B RELOCATED 10/9								2	VA	11/10/75						11/10/75		
10	E.I.A.		UPDATED ACC. TO MN12508/12520/13003								1	VA	28/11/75	APPROVED FOR CONSTRUCTION					10.9.75		
9	MSC	5/9/78	AS BUILT STAMP ADDED								0	VA	20/9/75	REDRAWN - REPLACES DRG N° C4101, C4102, C4103 & C4104					3.7.75		