
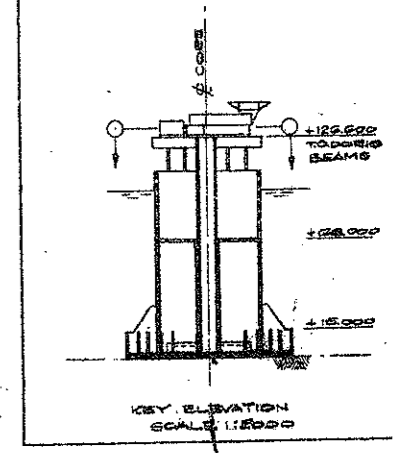


NLQ EQUIPMENT DRAWING

OUTLINE OF TEMPORARY QUARTERS, GANTRY/BEAM DECK

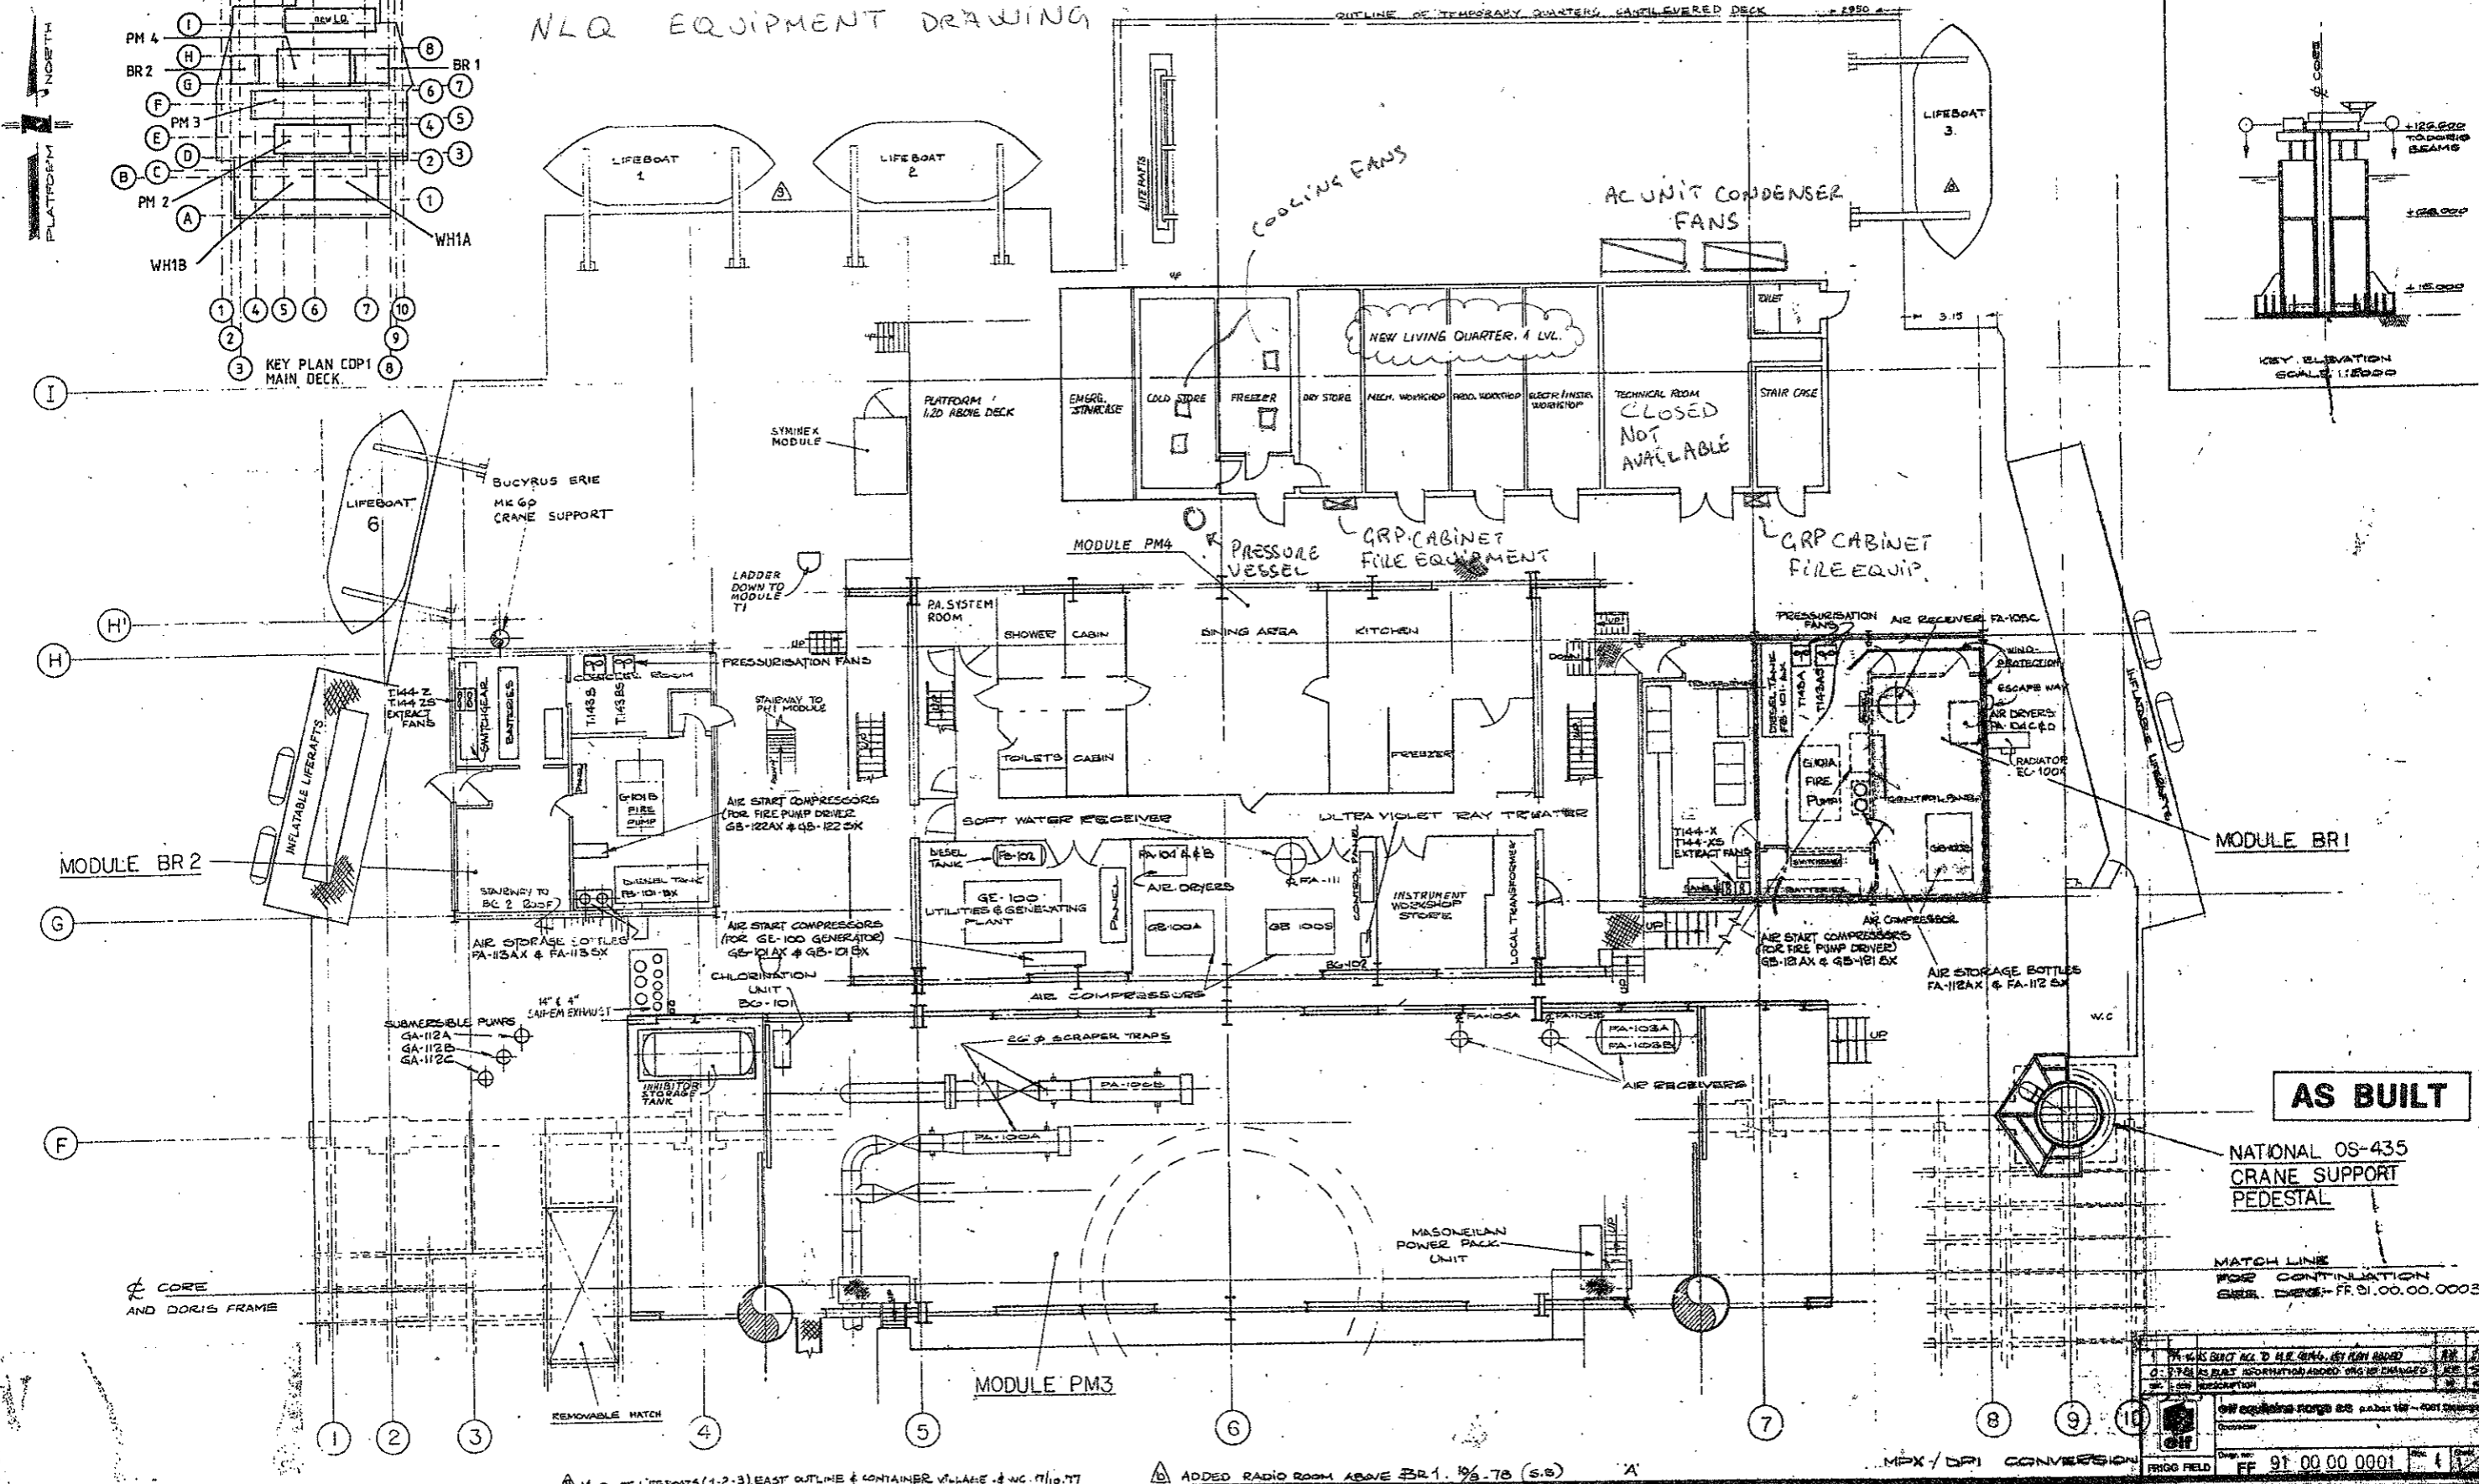

AS BUILT

NATIONAL OS-435
CRANE SUPPORT
PEDESTAL

MATCH LINE
FOR CONTINUATION
SEE DRAWING FF 91.00.00.0003

△ MOD. OF LIFEBOATS (1-2-3) EAST OUTLINE & CONTAINER VILLAGE & WC. 17/10/77
 △ ADDED RADIO ROOM ABOVE BR1. 1/8-78 (S.B) 'A'

NOTES

REVISION	BY	DATE
1	ISSUED FOR CONSTRUCTION	
2	MODULES UPDATED SHOWING STEELWORK, WALKWAYS, PIPEWORK & POWER PACK IN NEW POSITION, CRANE SUPPORTS AND PEDESTALS, MATCH, STAIRS, GFD REFERENCES AND MODULE TITLES ADDED. PNEUMATIC A 2000A GAS LINE REVISED AND	
3	REVISION BY DATE	
4	BR1 & BR2 UPDATED G.E.S. G1170	
5	DIESEL GEN. SET AND G2-101	
6	ADDED AND NATIONAL CRANE SUPPORT LEGS ALTERED A.C.T.N	
7	REMOVED TO AS BUILT STATUS AS CANCELLED SPT 7/17	
8	ADDITIONAL AS-BUILT INFO (14/1/77)	
9	REMOVED AND ADDED SPT 16/1/77	

Brown & Root, (U.K.) Ltd.

Engineers - Constructors
LONDON, ENGLAND.

DRAWN BY: G.E.B.	APPROVED:
DATE 14.2.75	
CHECKED BY: S.H.N.	APPROVER:
DATE 12.4.75	
SCALE: 1-100	

CONTRACT NO. 1-00-00

DRAWING NO. CDPLPR 101

REV 1/14

FF 91 00 00 0001

MPX/DPI CONVERSION