



AS BUILT

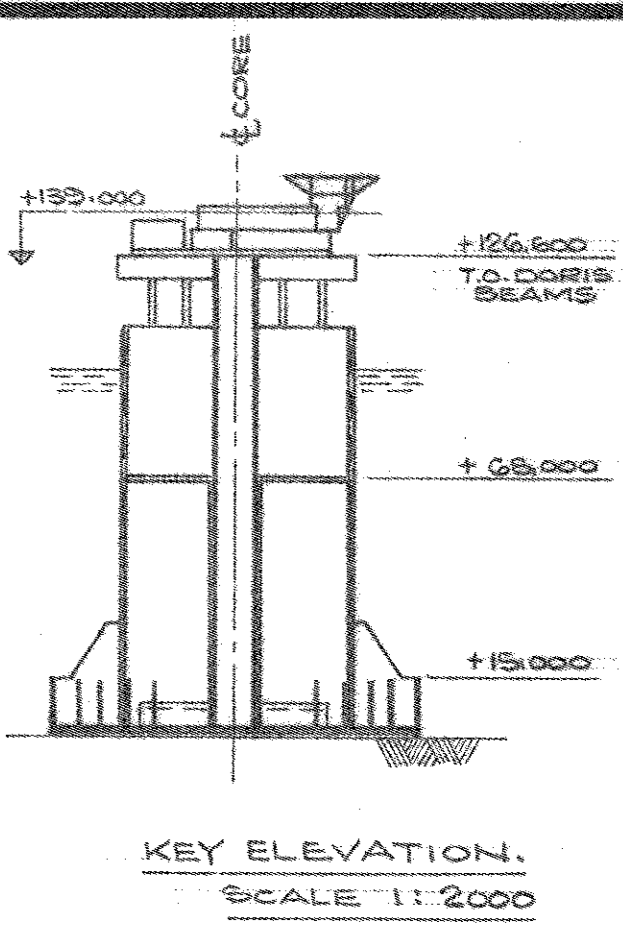

**AS BUILT CHECK
VISUAL CHECK ONLY**

**AS BUILT CHECK -
NOT YET INSTALLED
14/05/77**

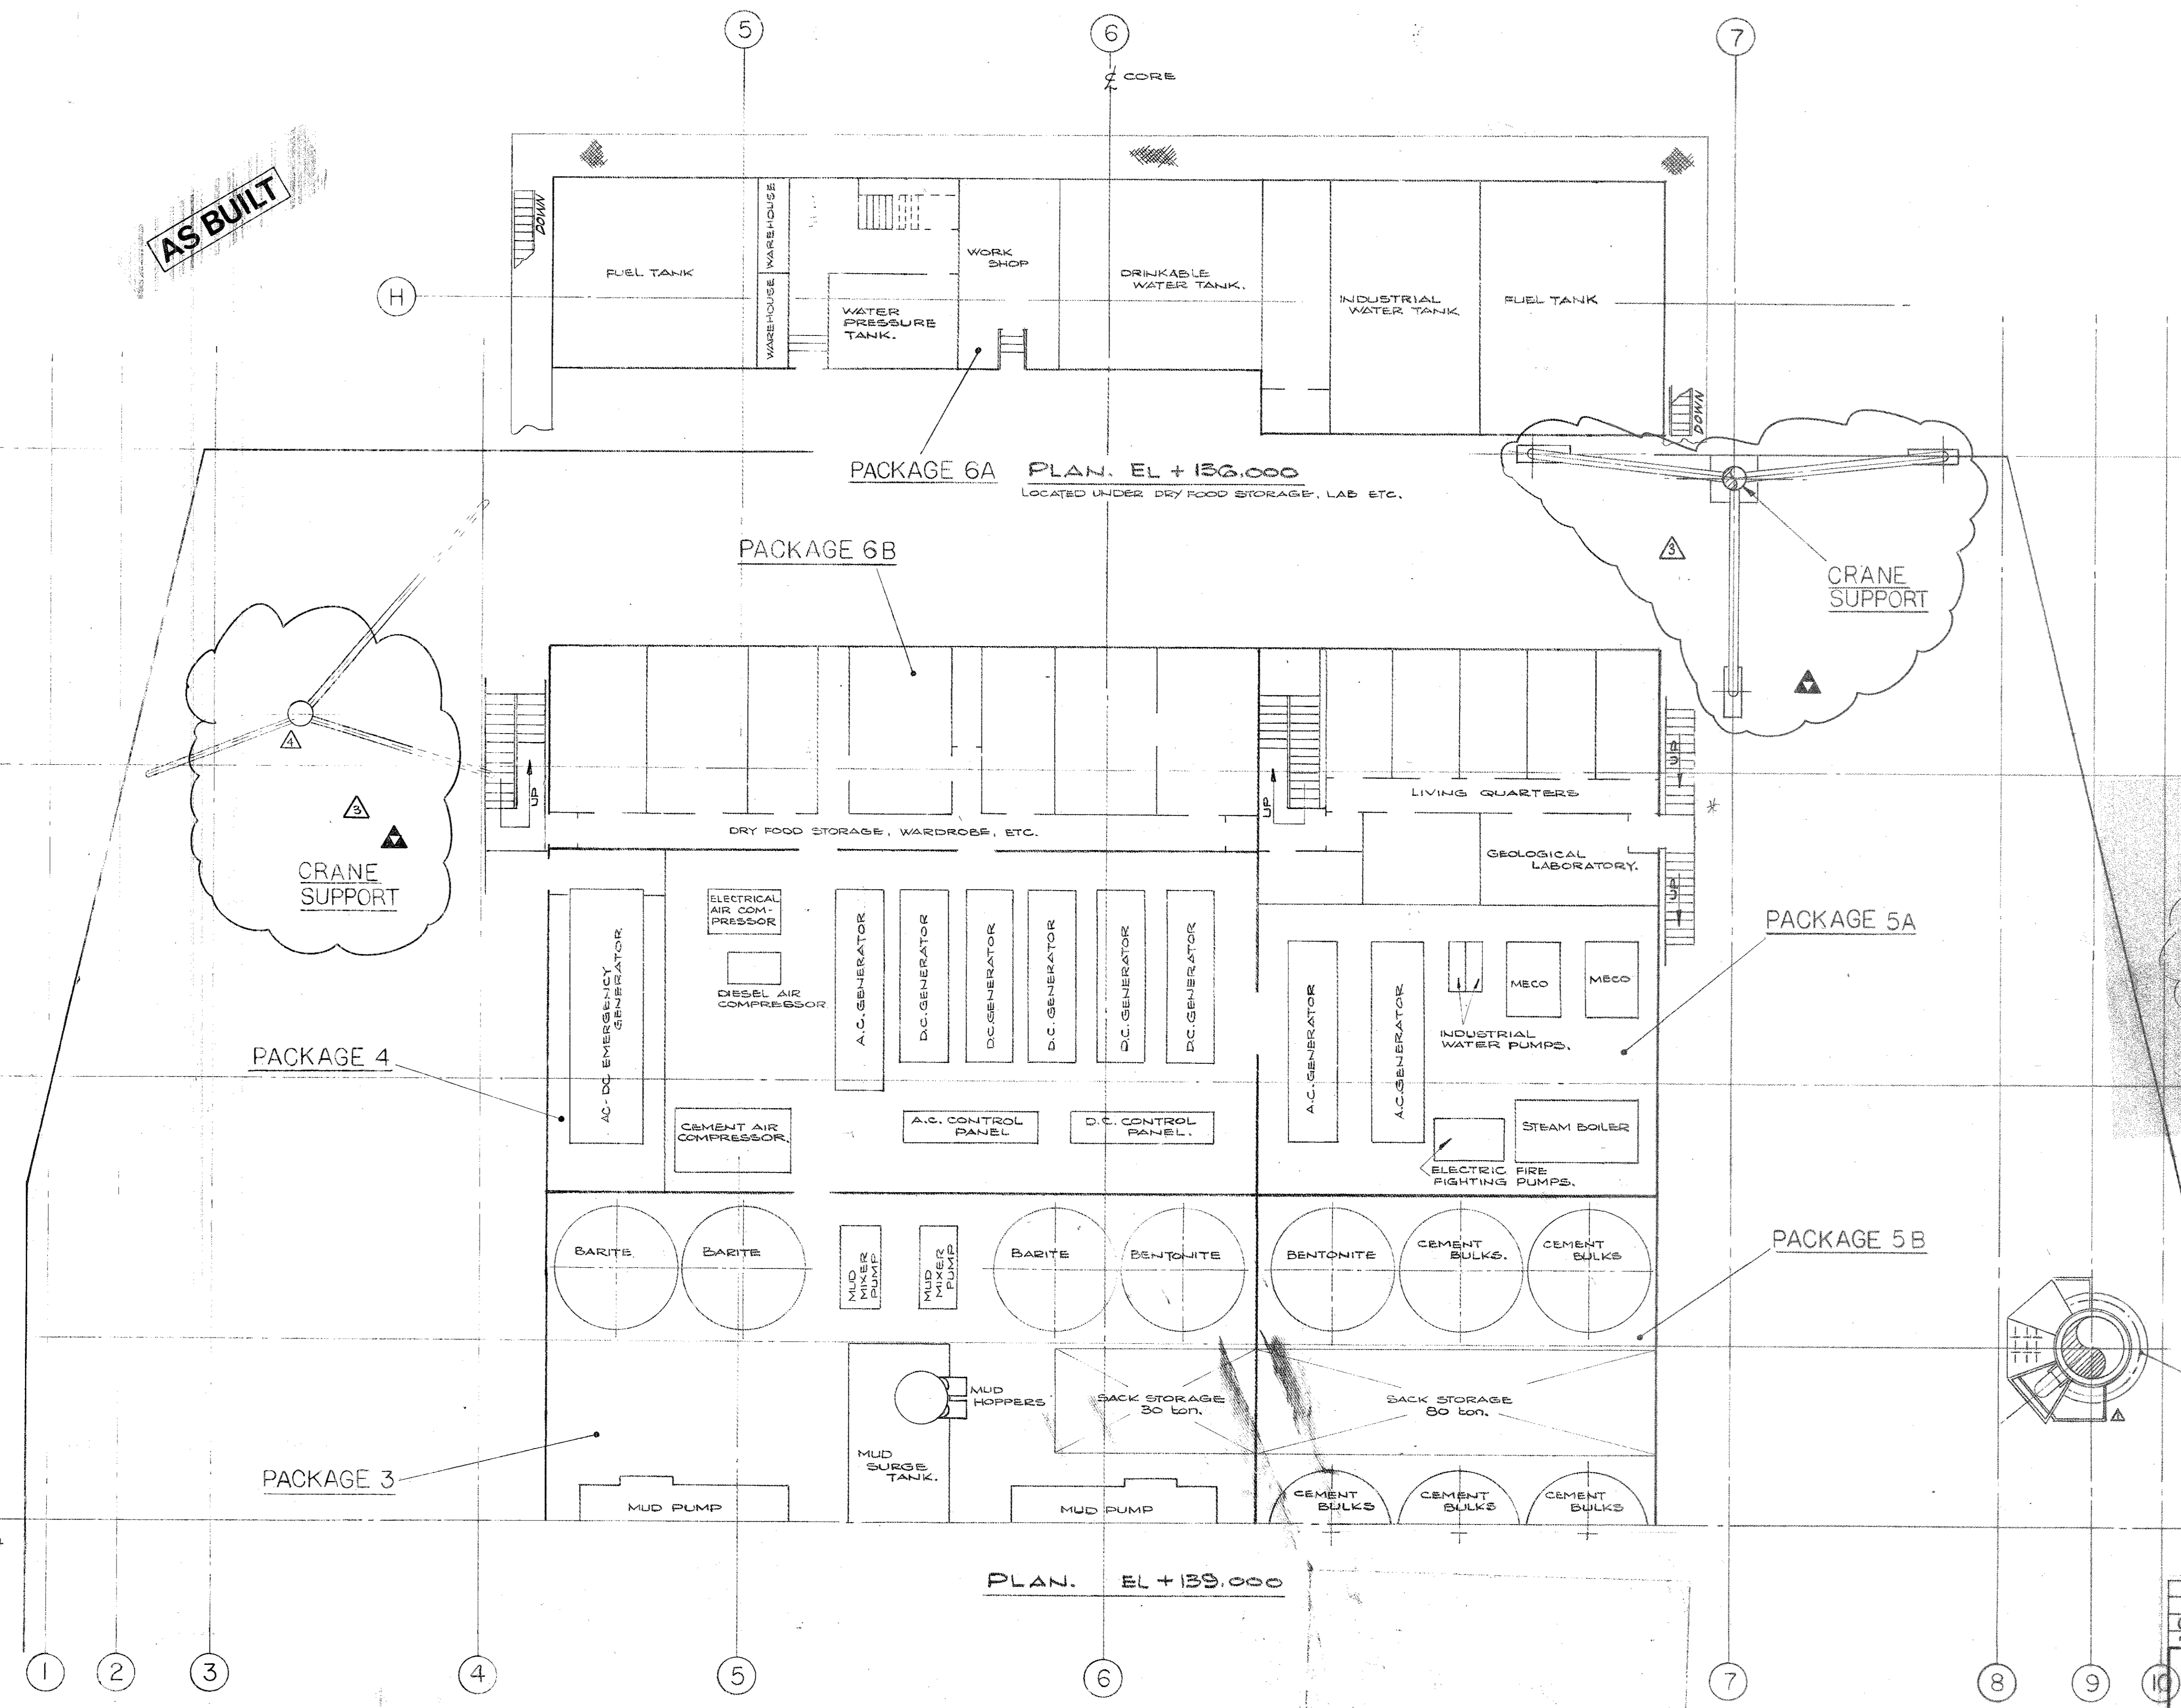

MATCHLINE
FOR CONTINUATION
SEE DRG CDPI/PP/104

NATIONAL OS-435
CRANE SUPPORT
PEDESTAL

0	REVISED			
REV.	DATE	DESCRIPTION	BY	APP.
elf aquitaine norge a/s		p.o. box 168 - 4001 Stavanger		
Contractor				
Dwg. no. FF 91 00 00 0005		Rev. 0 / 1		
FRIGG FIELD				

NOTES

REVISION	BY	DATE	REVISION	BY	DATE
1	SPT	16/3/77	1	SPT	16/3/77
2	SPT	16/3/77	2	SPT	16/3/77
3	SPT	16/3/77	3	SPT	16/3/77
4	SPT	16/3/77	4	SPT	16/3/77
5	SPT	16/3/77	5	SPT	16/3/77
6	SPT	16/3/77	6	SPT	16/3/77
7	SPT	16/3/77	7	SPT	16/3/77
8	SPT	16/3/77	8	SPT	16/3/77
9	SPT	16/3/77	9	SPT	16/3/77
10	SPT	16/3/77	10	SPT	16/3/77

Brown & Root, (U.K.) Ltd.

 Engineers-Constructors
 LONDON, ENGLAND.

DRAWN BY: POC
DATE: 21-2-76
CHK'D BY: JHN
DATE: 12-4-75
SCALE: 1/100

APPROVED

APPROVED

TITLE OF DRAWING: PLOT PLAN, NORTH.
ELEVATIONS: +139000 & +136000
NAME OF OWNER: ELF-NORGE, A/S.
LOCATION OF PROJECT: FRIGG FIELD.

CONTRACT NO.: 40-A3
DRAWING NO.: CDPI/PP/103
REV 4 (ES)
SHEET 1 OF 1