



WORKSHOP LAYOUT — MAIN DECK — T.O.P. EL. 108.858

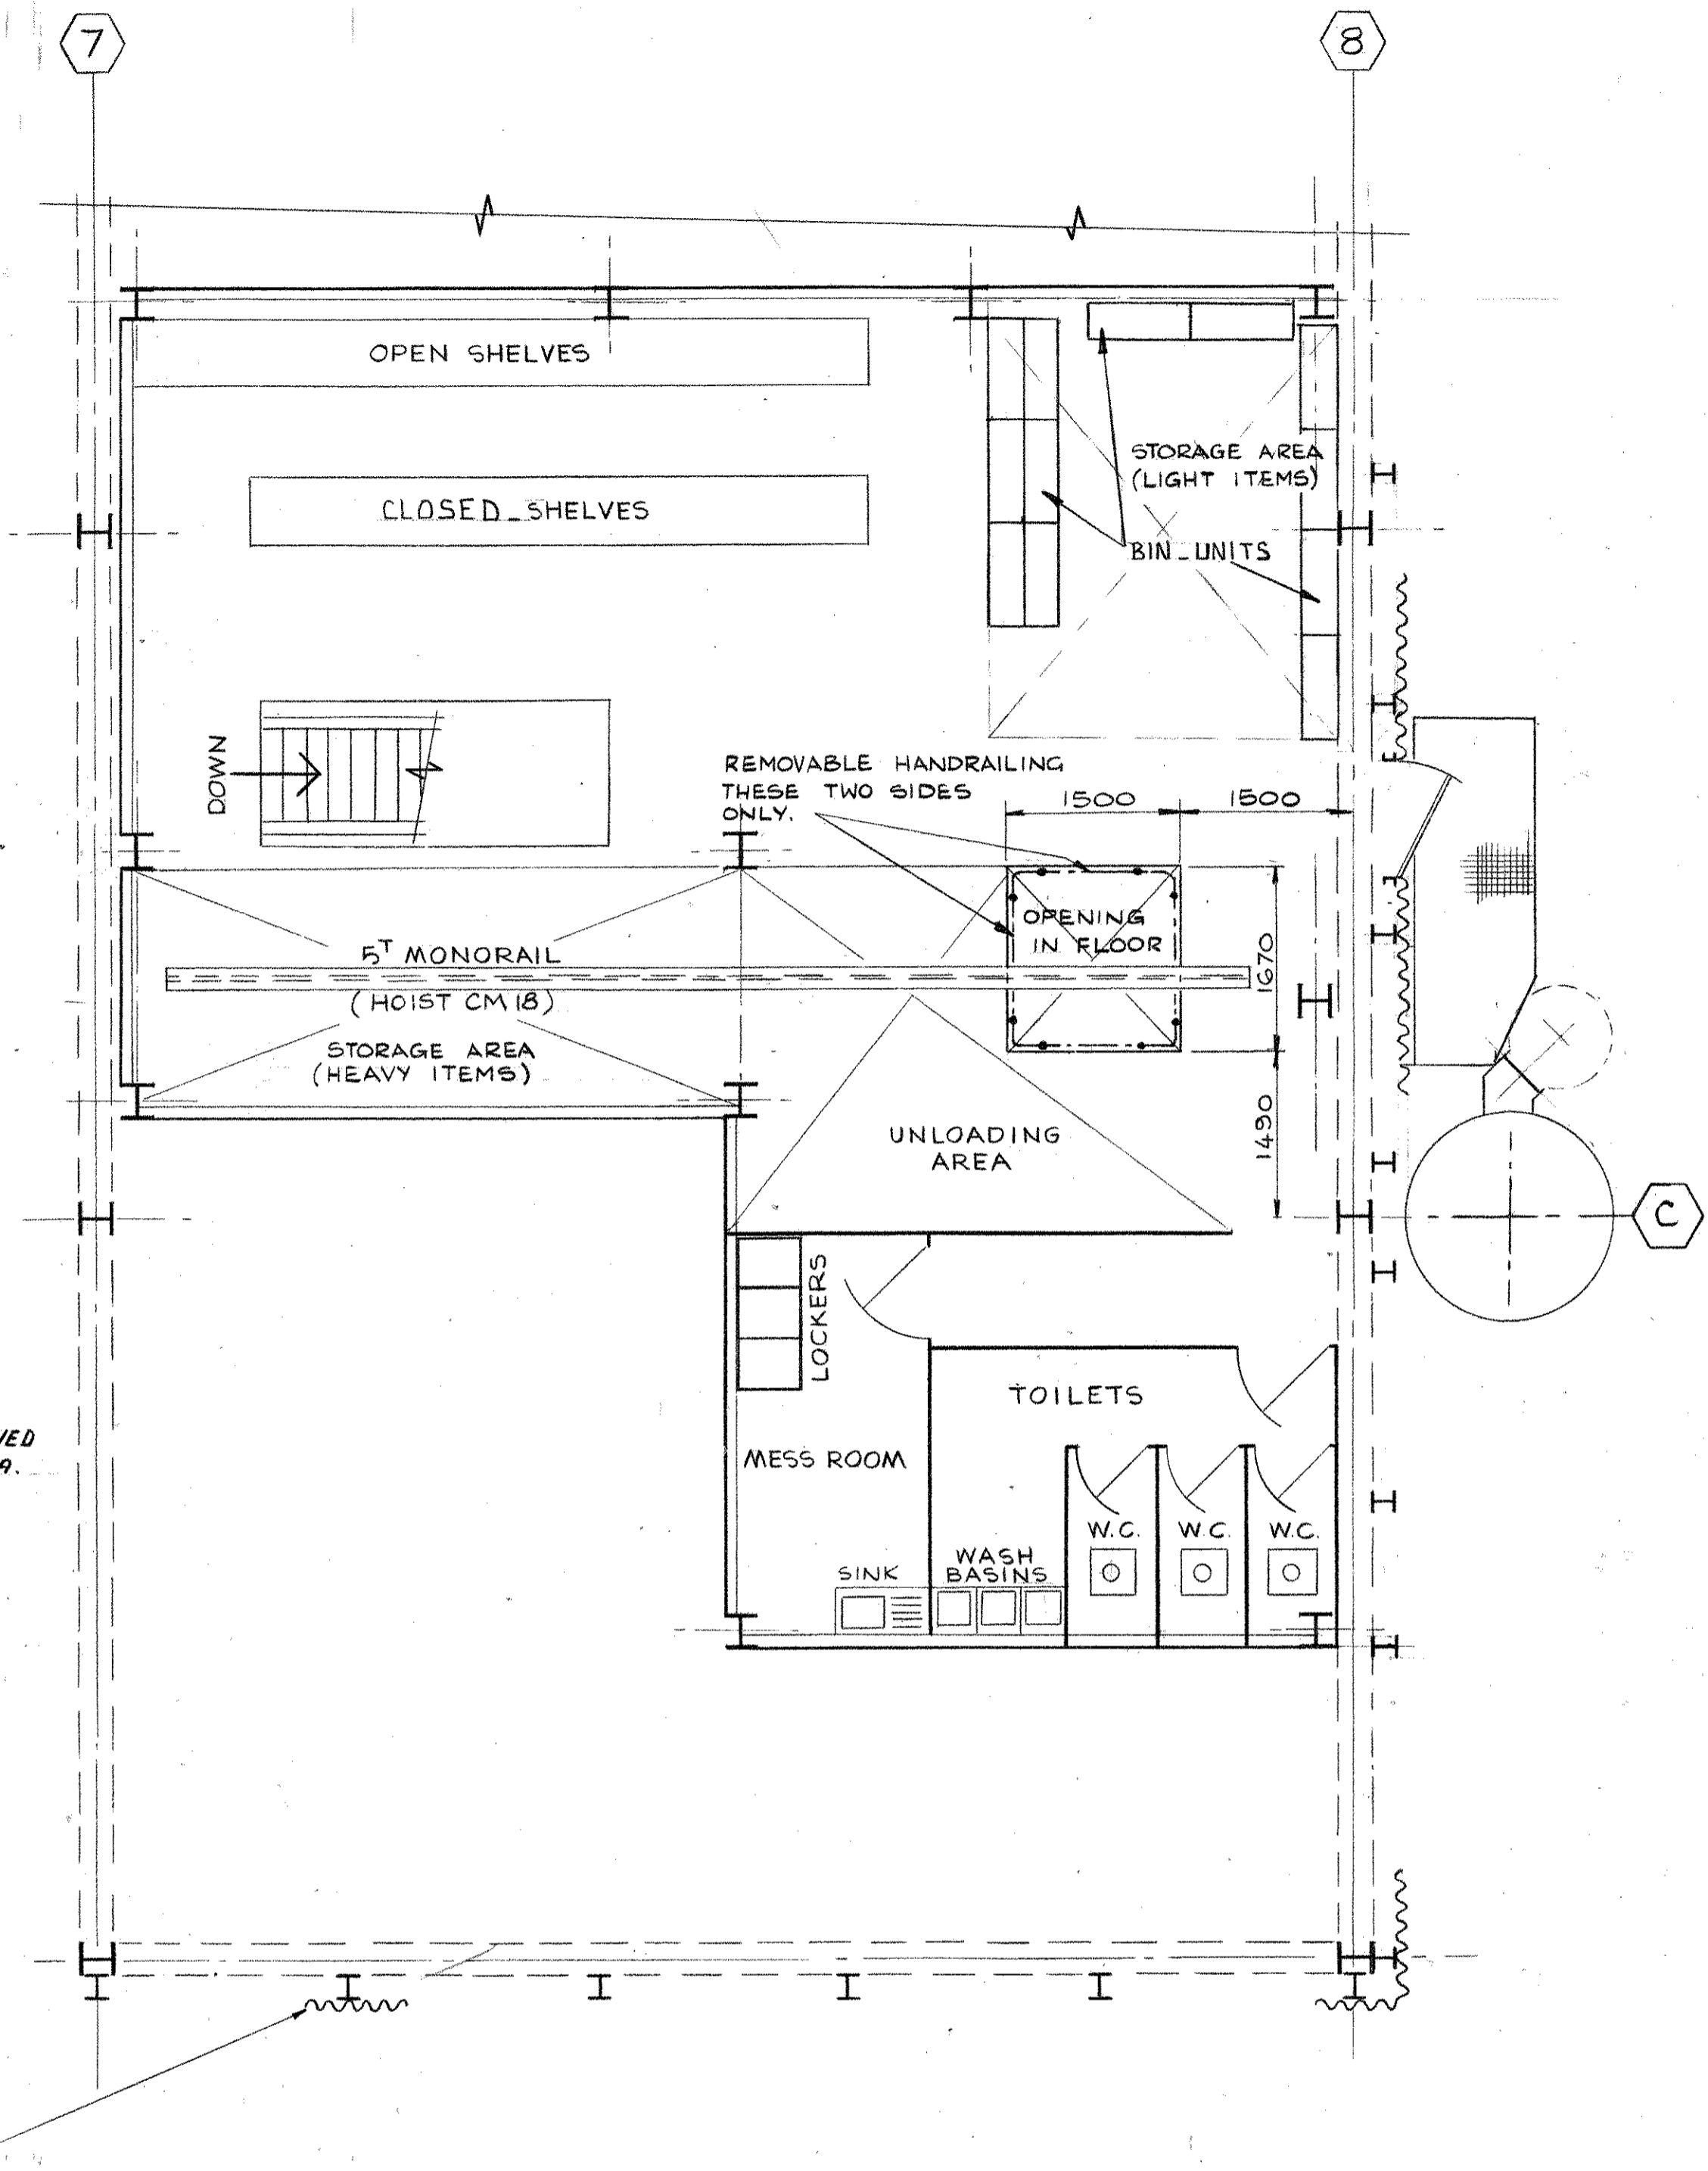

STORES LAYOUT — MEZZANINE LEVEL — T.O.P. EL. 112.358
(OVERALL DIMENSIONS AS WORKSHOP)

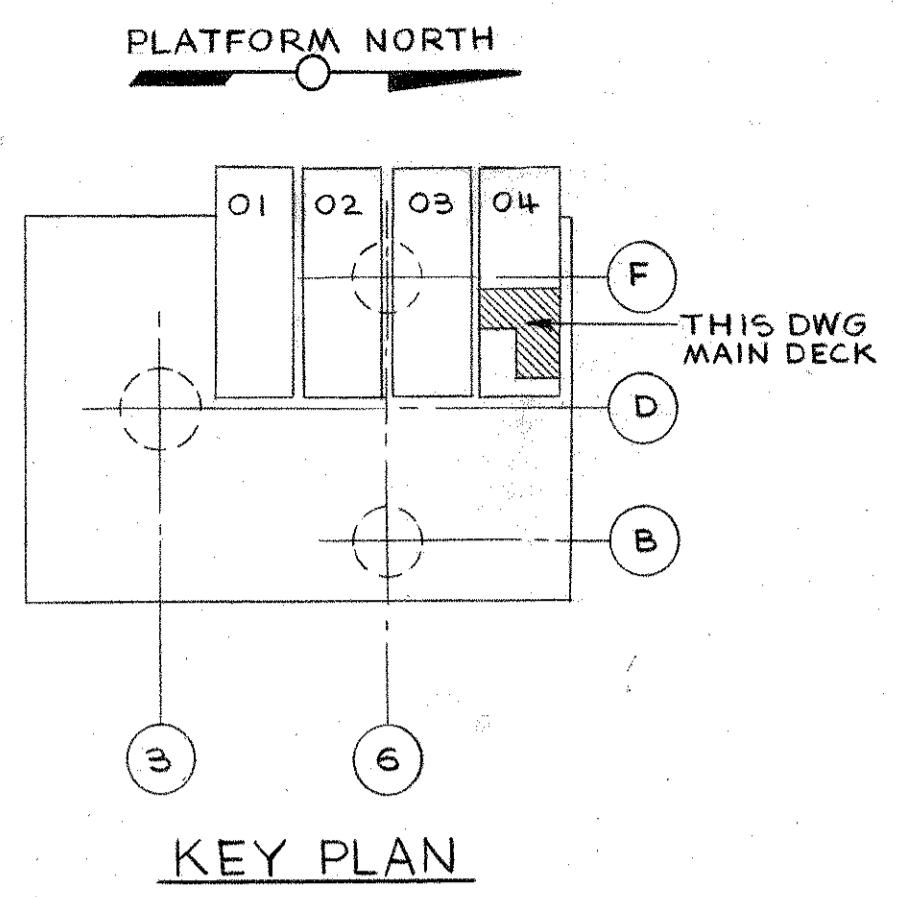

REFERENCE DRAWINGS
PLOT PLAN - MAIN DECK - C4105

- NOTES
1. ALL WALLS IN TOILET AREA TO BE COVERED WITH STAINLESS STEEL SHEETING.
 2. W.C.'S TO BE 'ARAB TYPE'
 3. MESS ROOM TO BE PAINTED

AS BUILT
TO INFORMATION RECEIVED
UP TO OCTOBER '78

ELF - NORGE
FRIGG FIELD
TREATMENT / COMPRESSION
PLATFORM No.2
NORTH SEA JOB 1-40-E2 WD. 104-M.
McDERMOTT - HUDSON
LONDON - ENGLAND

HOLDS
2' POSITION VENTILATION EQUIP.

APPROVED: *Tony Dawson*
McDERMOTT - HUDSON
DATE: 27 Nov. 1975

ENGINEERS APPROVAL	BY	DATE
<i>[Signature]</i>	MR	21/10/75
	MR	26/11/75
	MR	30/10/75
	MR	17/10/75
	MR	30/9/75
	MR	29/9/75
	VA	19/9/75

CUSTOMER APPROVAL
[Signature]
DATE: 28.11.75

DESIGN	ELEC.	INSTR.	PIPING	STRUCT.	NO.	BY	DATE	REVISIONS	DATE	APP.	DESIGN	ELEC.	INSTR.	PIPING	STRUCT.	NO.	BY	DATE	REVISIONS	DATE	APP.
						RS	3/8/77	1050 WAS 1000-1450 WAS 1500 #								2	DW	3-8/77	INSPECTION HATCH ADDED		
						RS	13/7/76	CG 13 SEWAGE TREATMENT ADDED								1			CG 13 SEWAGE TREATMENT ADDED		
						MH	15/11/75	LAYOUT REVISED TO MEET APPROVED EQUIPMENT								0	TG	15/11/75	ISSUED FOR CONSTRUCTION		
						MH	10/9/75	DRG NO WAS SKP 28								A	PJP	10/9/75	ISSUED FOR CLIENT APPROVAL		
						MH	11/9/78	AS BUILT STAMP ADDED								3	MSC	5/9/78	AS BUILT STAMP ADDED		

PROJECT	SCALE	DATE	DWG. NO.
ELF - NORGE	1:50	10-9-75	ELN 2169
DESIGNED BY	DRAWN BY	DATE	SHEET NO.
V.A.	PJP		C4109

PLOT PLAN — WORKSHOP & STORES
MODULE 04