



COLUMN C2

COLUMN C1

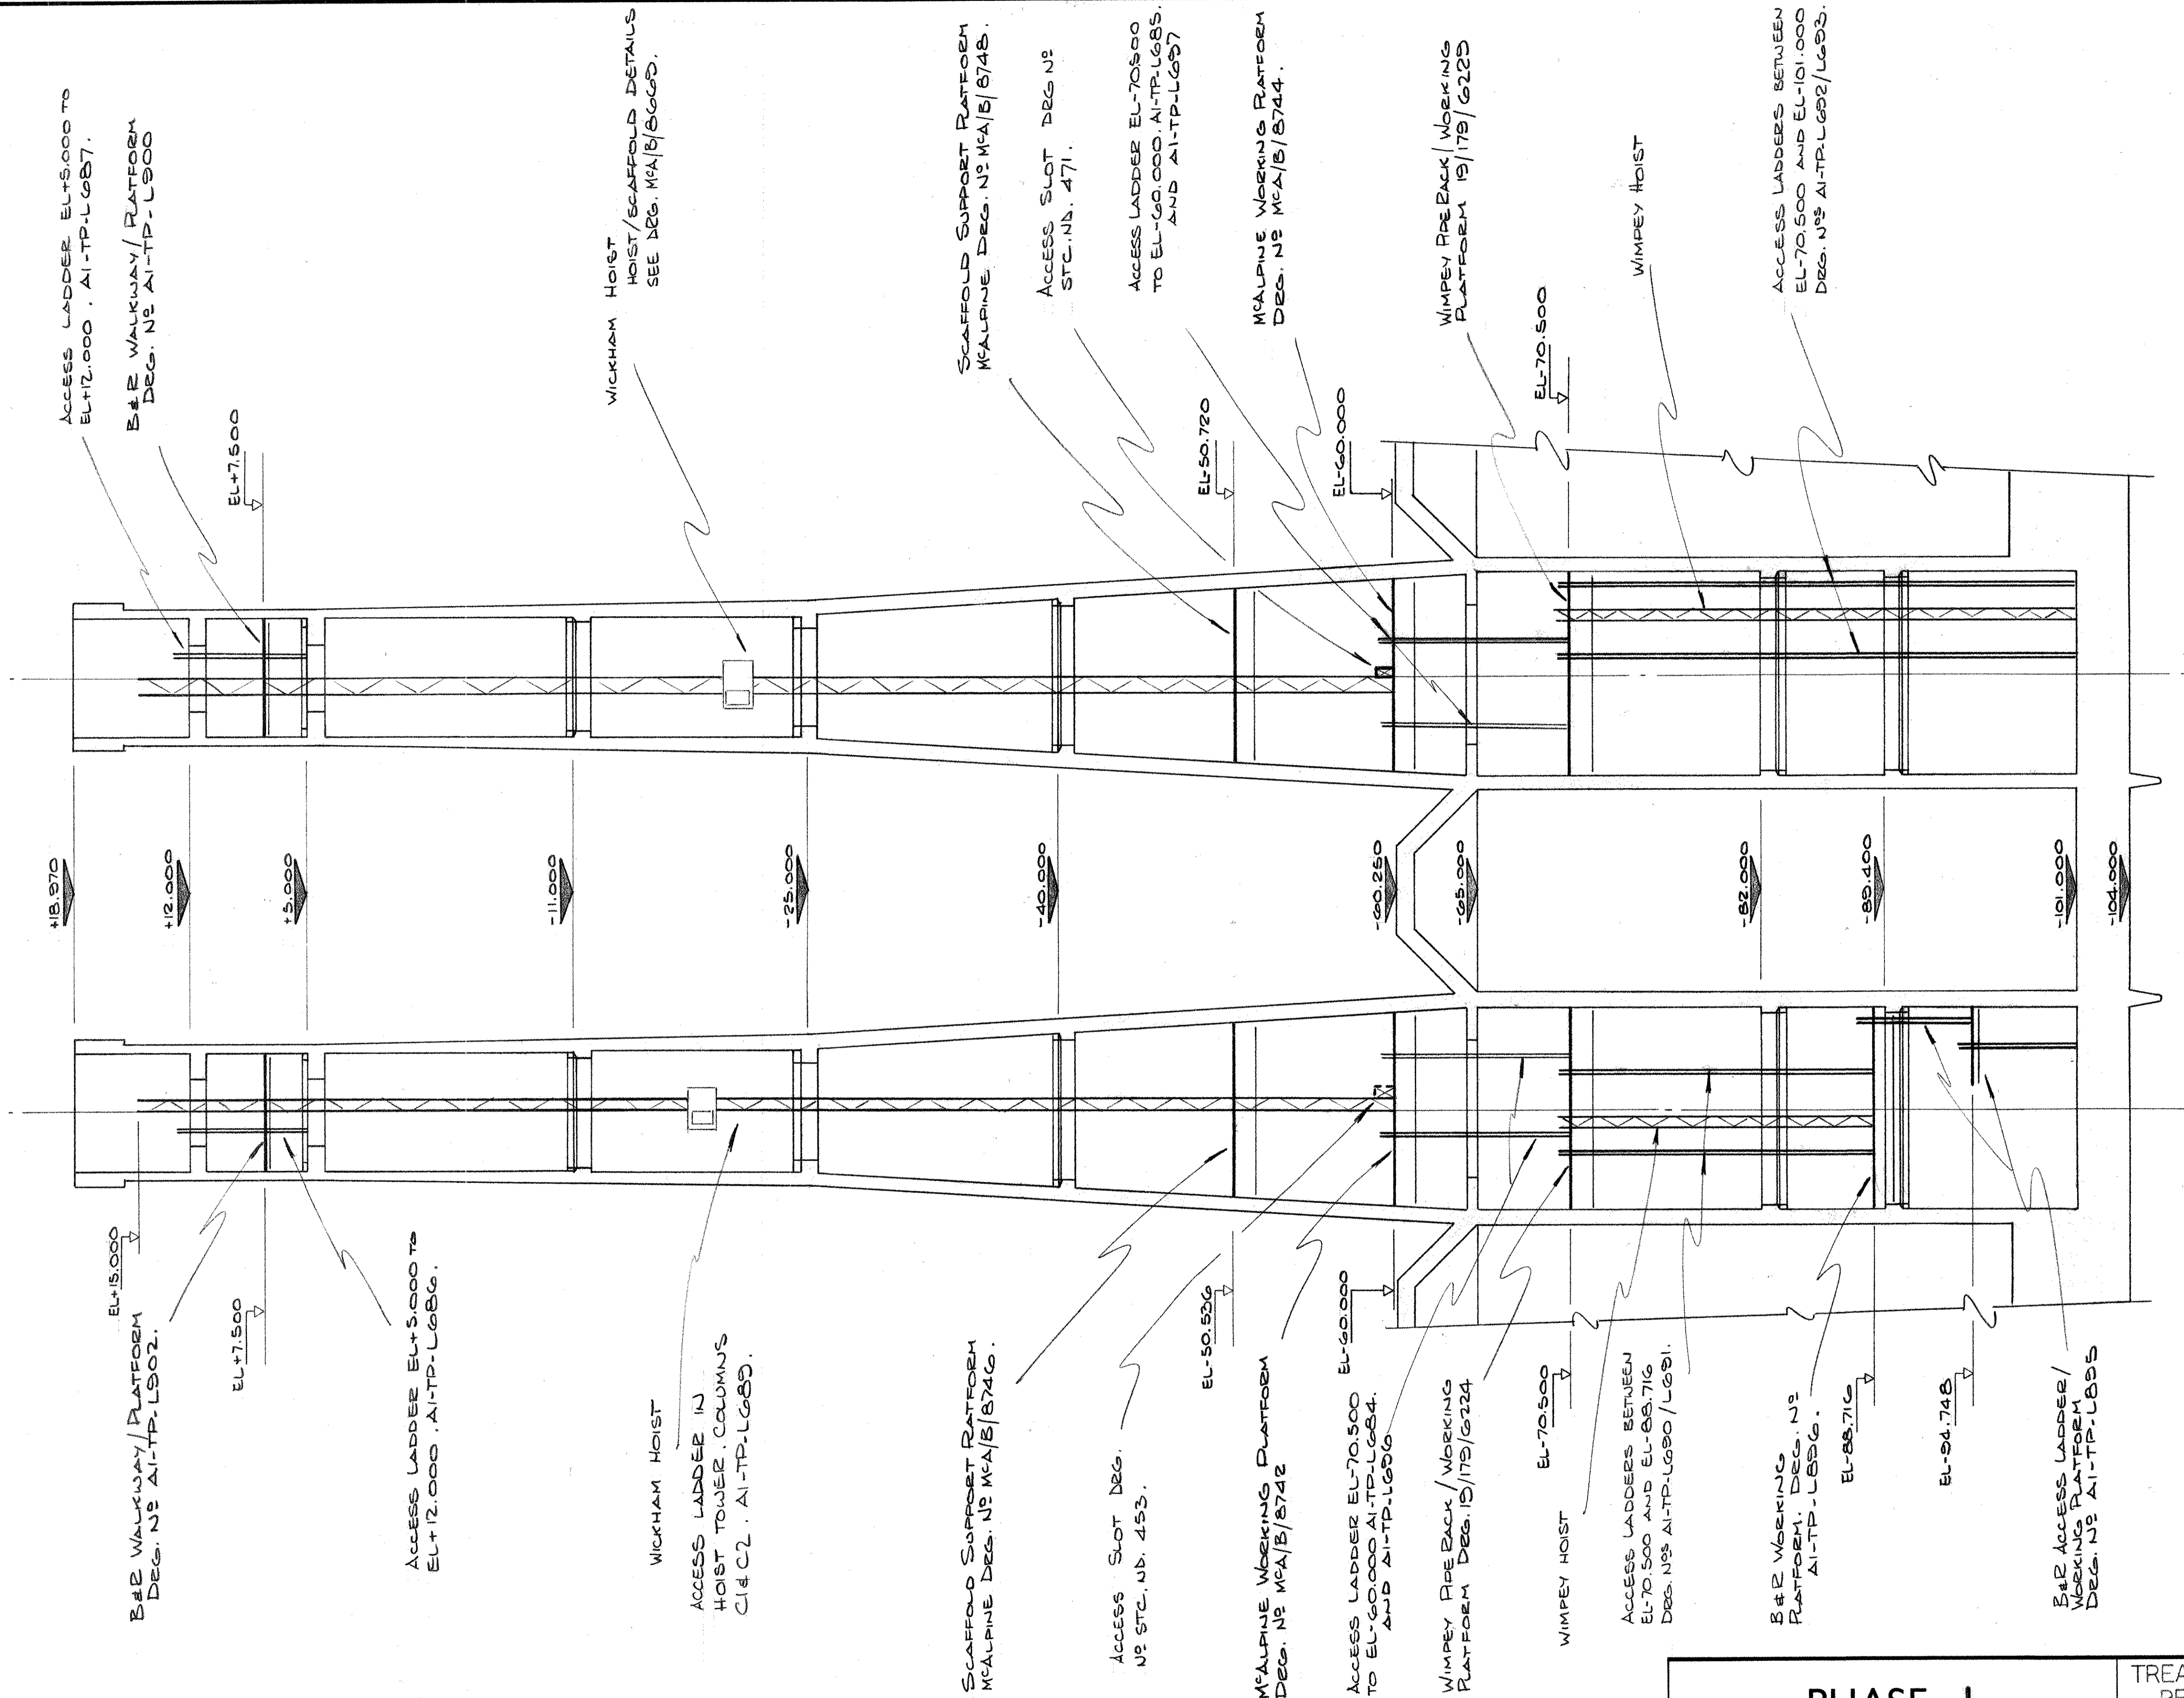

NOTES :-

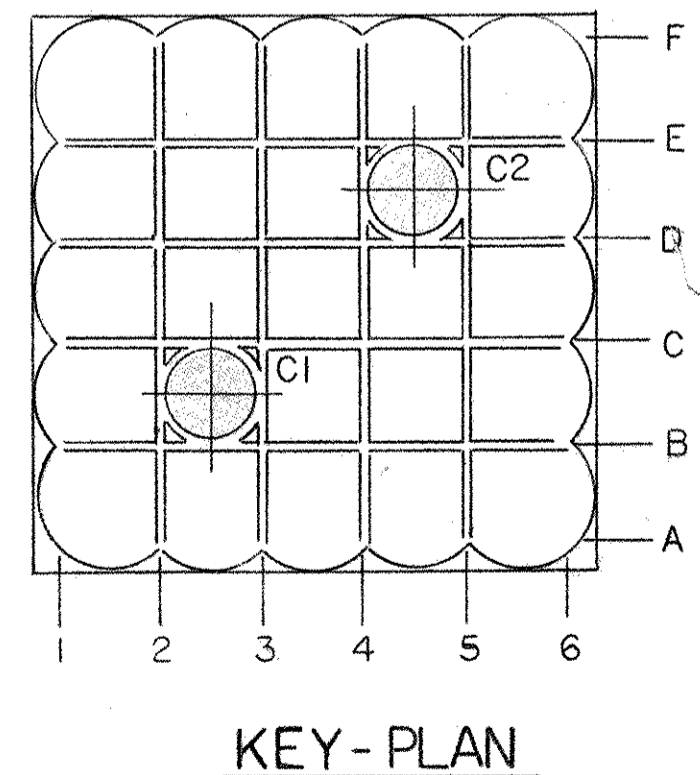

10

TREATMENT PLATFORM No.1
AS BUILT
RISER & "J" TUBE INSTALLATION

REFERENCE DRAWINGS		REV. NO.	REVISION	BY	DATE	CHKD
NUMBER	TITLE					
A		1	LADDERS EL+60. TO EL+70.500 ADDED	CJS	8/2	
B		2	CONSTRUCTION ISSUE	CJS	15/1/75	
C		3	ADDED "AS BUILT"	AF	2/3/77	

PHASE I

Brown & Root, (U.K.) Ltd.
Engineers, Constructors
LONDON, ENGLAND.

BY: CJS
DATE: 2.10.75

CHECKED: MAF
DATE: 3/10/75

APPROVED: MAF
DATE: 7/11/75

TREATMENT PLATFORM No.1 .T.P1.
PERMANENT PLATFORMS
IN COLUMNS

elf **ELF. NORGE - A/S**

FRIGG FIELD DEVELOPMENT PROJECT

SCALE: 1:200

PROJECT No. 78-5711

DRAWING NUMBER: AI-TP-L695

REV. C