


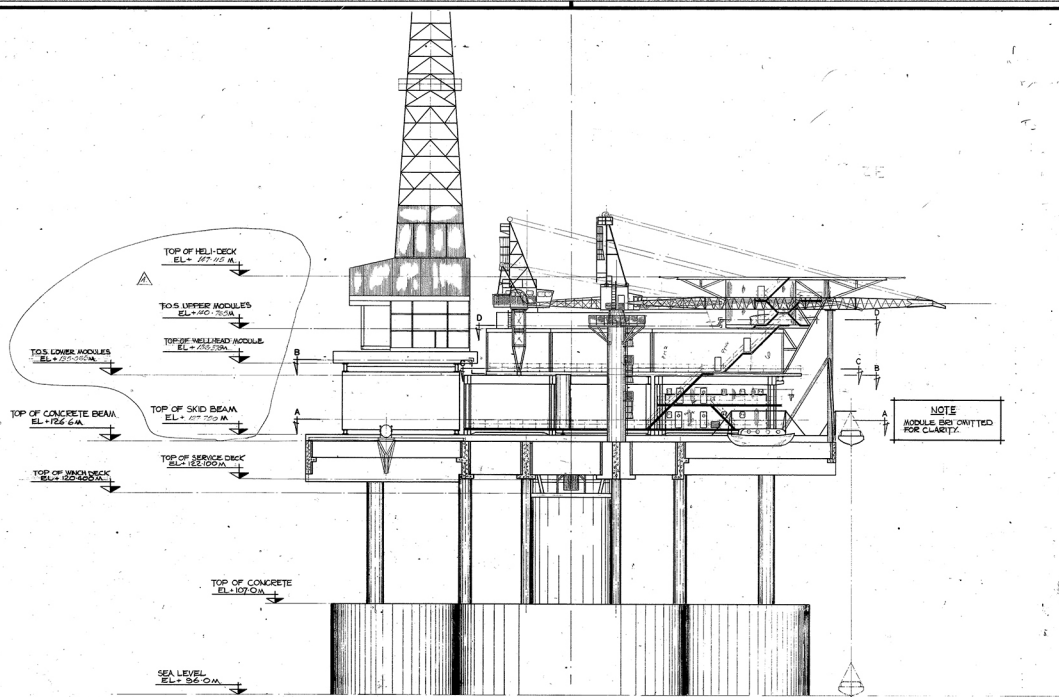


EAST ELEVATION ON MODULES


- EN-AA-003 NORTH ELEVATION ON MODULES
- EN-AA-004 S.A. OF MODULES ON PLATFORM
- EN-AA-005 UPPER MODULE DECK PLAN EL + 120.75 M
- EN-AA-006 UPPER MODULE FLOOR PLAN EL + 120.75 M
- EN-AA-007 LOWER MODULE DECK PLAN EL + 120.00 M
- EN-AA-008 LOWER MODULE FLOOR PLAN EL + 120.00 M
- EN-AA-009 MAIN DECK CONCRETE BEAM LAYOUT EL + 126.6 M
- EN-AA-010 PLAN ON SERVICE DECK EL + 128.00 M
- EN-AA-011 WEST ELEVATION ON MODULES
- EN-AA-012 WEST ELEVATION ON MODULES
PROPRIETARY INFORMATION

This drawing/figure/illustration contains proprietary information belonging to Brown & Root, Inc. and may not be wholly or partially reproduced nor disclosed without prior written permission of Brown & Root, Inc.

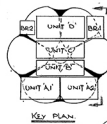

KEY PLAN

NOTES




APPROVED

APPROVED

TITLE OF PROJECT EAST ELEVATION ON MODULES

MPX-DPI CONVERSION

ELF-NORGE A/S

LOCATION OF PROJECT FRIGG FIELD

CONTRACT NO. 1-40-A3

DRAWING NO. B-EN-AA-002

SHEET 01