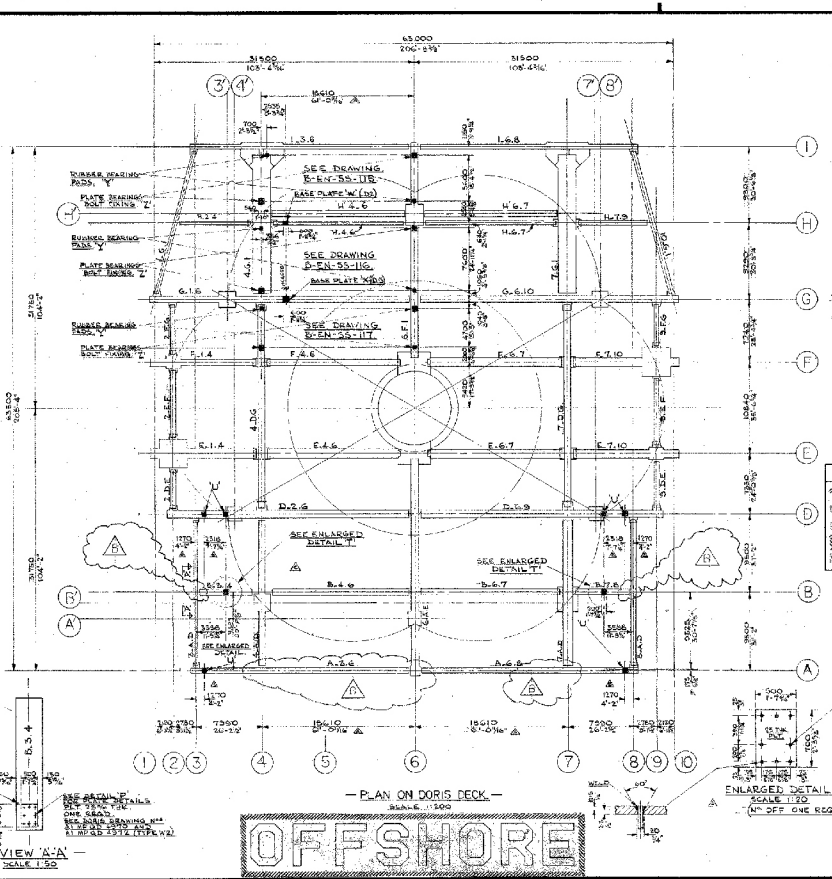

— PLAN ON DORIS DECK —
SCALE 1:200

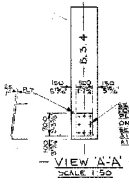

— VIEW 'A'-'A' —
SCALE 1:50

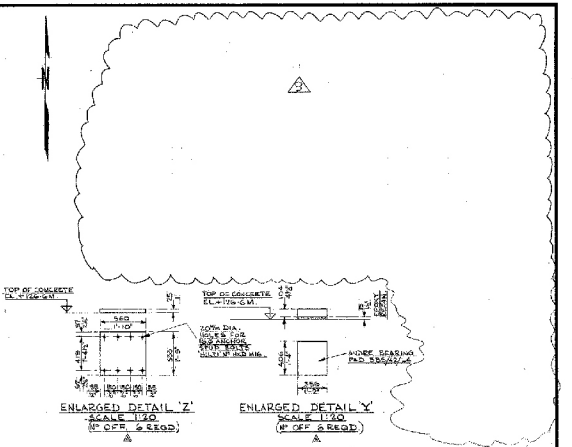

MAT. ST-37-3N. UNLESS OTHERWISE NOTED.

PROPRIETARY INFORMATION
This drawing/report/document contains proprietary information belonging to Brown & Root, and may not be used or partially reproduced nor disclosed without prior written permission of Brown & Root Inc. or Brown & Root (U.K.) Ltd.

NOTES
ING PLAN FOR TANKS FB-110 & FB-110 SUPPORT MODULE B-EN-SS-115
ING PLAN FOR PUMP ROOM & CRANE PEDESTAL TANK W.T.B.D. & STEELWORK DRAWING PLANS FOR TANKS FB10 & FB10 SUPPORT MODULE AND DECK B-EN-SS-117

REVISION	BY	DATE

REVISION	BY	DATE
A. On Sht. 1 Title Added		
B. Plan & Elevation Sheet No.		
C. Revision to Pile Positions Added. Minor revisions to Details.		

Brown & Root, (U.K.) Ltd.
Engineers Constructors
LONDON, ENGLAND.

DRAWN BY	
DATE	4.7.76
CHKD BY	
DATE	5.7.76
SCALE	1:200

APPROVED
APPROVED
SEAL

TITLE OF DRAWING	EXTRA PADS REQ'D. FOR DORIS DECK. MPX-DPI CONVERSION.
NAME OF OWNER	ELF NORGE A/S.
LOCATION OF PROJECT	FRIGG FIELD.
CONTRACT NO.	1-40-A3
DRAWING NO.	B-EN-SS-164/A
SHEET	1 OF 1