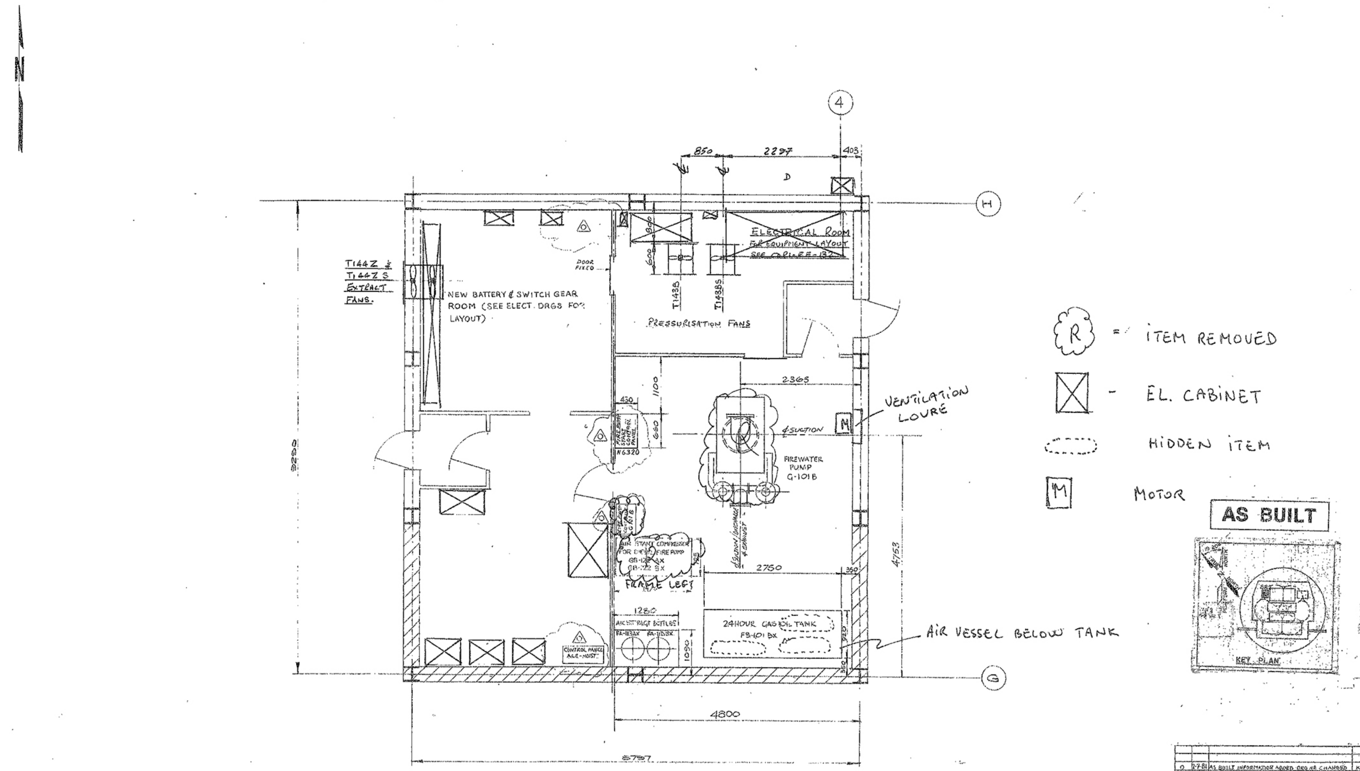

AREA ZONE 'T'

rev.	date	DESCRIPTION	by	app.
0	2-7-81	AS BUILT INFORMATION ADDED ORG AS CHANGED	KE	

elf aquitaine norge a/s p.o.box 168 -- 4001 Stavanger

Contractor

FRIGG FIELD — Dwg. no. FF 91 00 00 0012 — Rev. 0 — Sheet 1/1

NOTES

REFERENCE DRAWINGS

PIPING ARRANGEMENT MODULE BR2	FF91.20.03.2116
MODULE BR2 PLAN	CDP1-AC-7704
CABLE TRAYS & GROUNDING BR2	CDP1-EE-132
MODULE BR2 PLAN OF INSULATED WALLS	B-EN-AA-39
MODULE BR2 FLOOR & ROOF PLANS	CDP1-SS-77
BR2 FLOOR DRAINS	CDP1-PP-190

REVISION	BY	DATE
B ADDITIONAL 'AS BUILT' INFO.		12-07-77

REVISION	BY	DATE
ISSUED FOR CONSTRUCTION		
0	PWF	
REDRAWN	G.S.B.	6-1-76
A GENERAL REVISIONS		
B		2.3.76
C REVISED TO AS-BUILT STATUS AS CLOUDED	R.G.C	15.07.77

Brown & Root, (U.K.) Ltd.
Engineers - Constructors
LONDON, ENGLAND.

DRAWN BY: M.J. GILBERT
DATE 5-05-75
CHK'D. BY:
DATE 17-6-76
SCALE: 1:33⅓

APPROVED

APPROVED

SEAL

TITLE OF DRAWING: EQUIPMENT LAYOUT MODULE BR2
CDP1 PLATFORM
NAME OF OWNER: ELF NORGE A/S
LOCATION OF PROJECT: FRIGG FIELD

CONTRACT NO. 1-40-A7
DRAWING NO. CDP1-PP-134
SHEET 1 OF 1