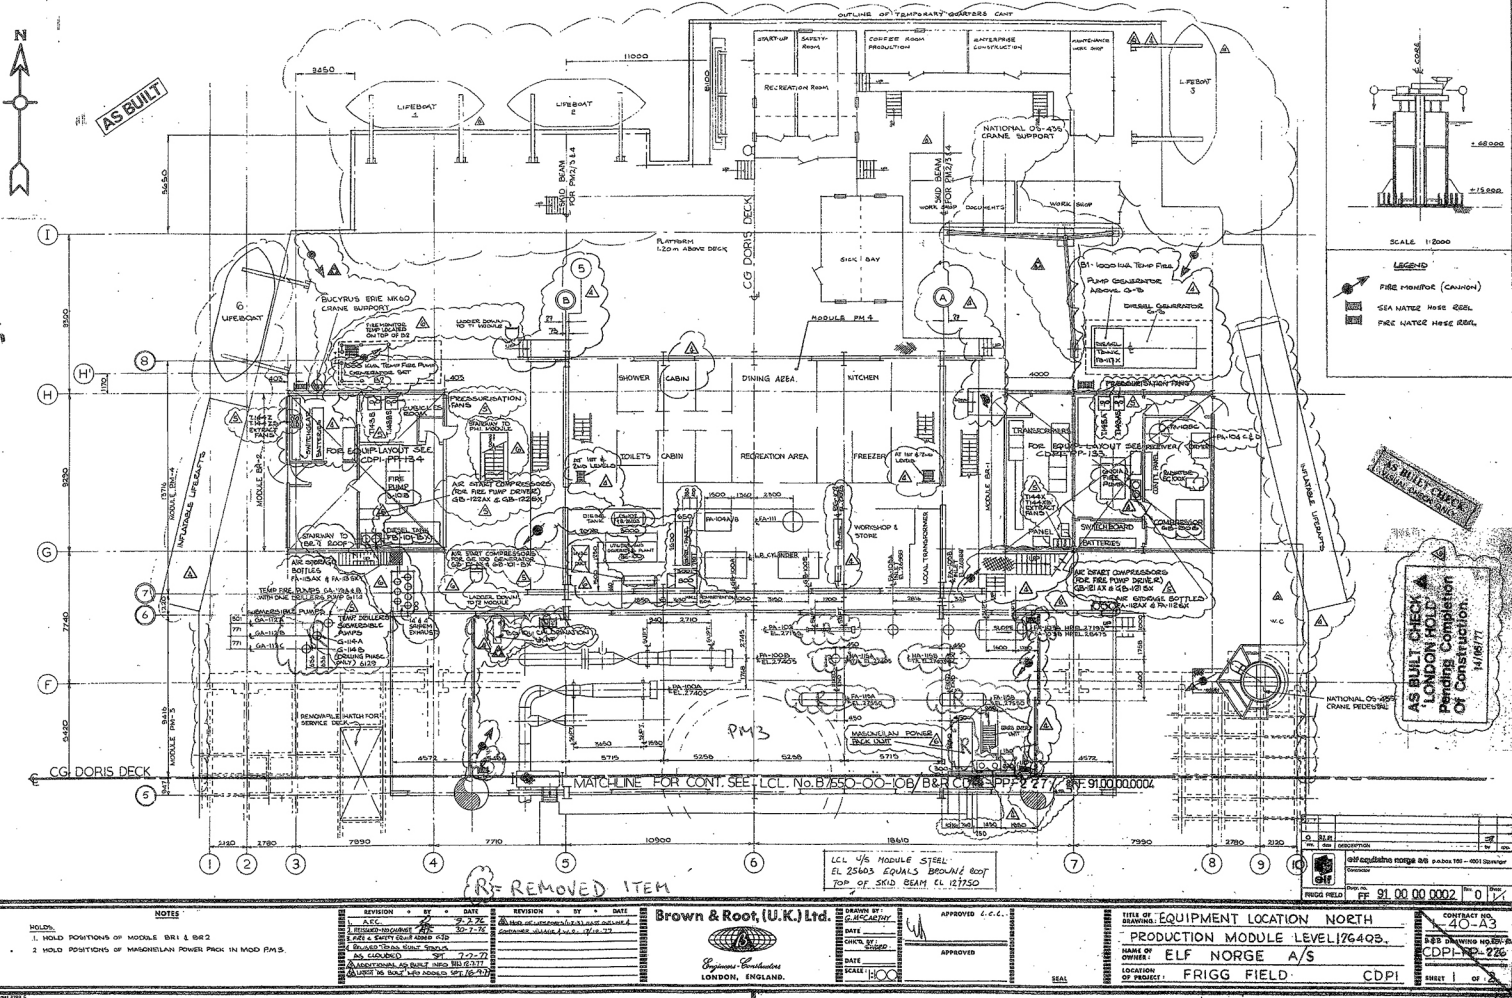

NOTES
HOLDS.
1. HOLD POSITIONS OF MODULE BR1 & BR2
2 HOLD POSITIONS OF MASONEILAN POWER PACK IN MOD PM5.

REVISION	BY	DATE
A.F.C.		9.7.76
1 REVISED-NO CHANGE	AF	30-7-76
2 AS & SAFETY EQUIP ADDED	AF	
3 BULKS TO AS BUILT STATUS		
AS CLOUDED	SJT	1-12-77
4 ADDITIONS AS BUILT REV BR1 6.3.77		
LADDER AS BUILT REV ADDED SEPT 16-9-77		

REVISION	BY	DATE

Brown & Root, (U.K.) Ltd.
Engineers Contractors
LONDON, ENGLAND.

DRAWN BY: G.MCCARTHY
DATE
CHCK. BY: J. SHIRLEY
DATE
SCALE: 1:100

APPROVED C.C.C.
APPROVED
SEAL

TITLE OF DRAWING: EQUIPMENT LOCATION NORTH
PRODUCTION MODULE LEVEL 17640B.
NAME OF OWNER: ELF NORGE A/S
LOCATION OF PROJECT: FRIGG FIELD CDPI

CONTRACT No. 40-A3
B&B DRAWING No. REV. 0
CDPI-PP-226
SHEET 1 OF 2

No.	BY	date	DESCRIPTION	by	date
0	BJR	14.6.77	ISSUED FOR CONSTRUCTION		

elf aquitaine norge as p.o.box 160 – 4001 Stavanger
Contractor

FRIGG FIELD — Drwg. no. FF 91 00 00 0002 — Rev. 0