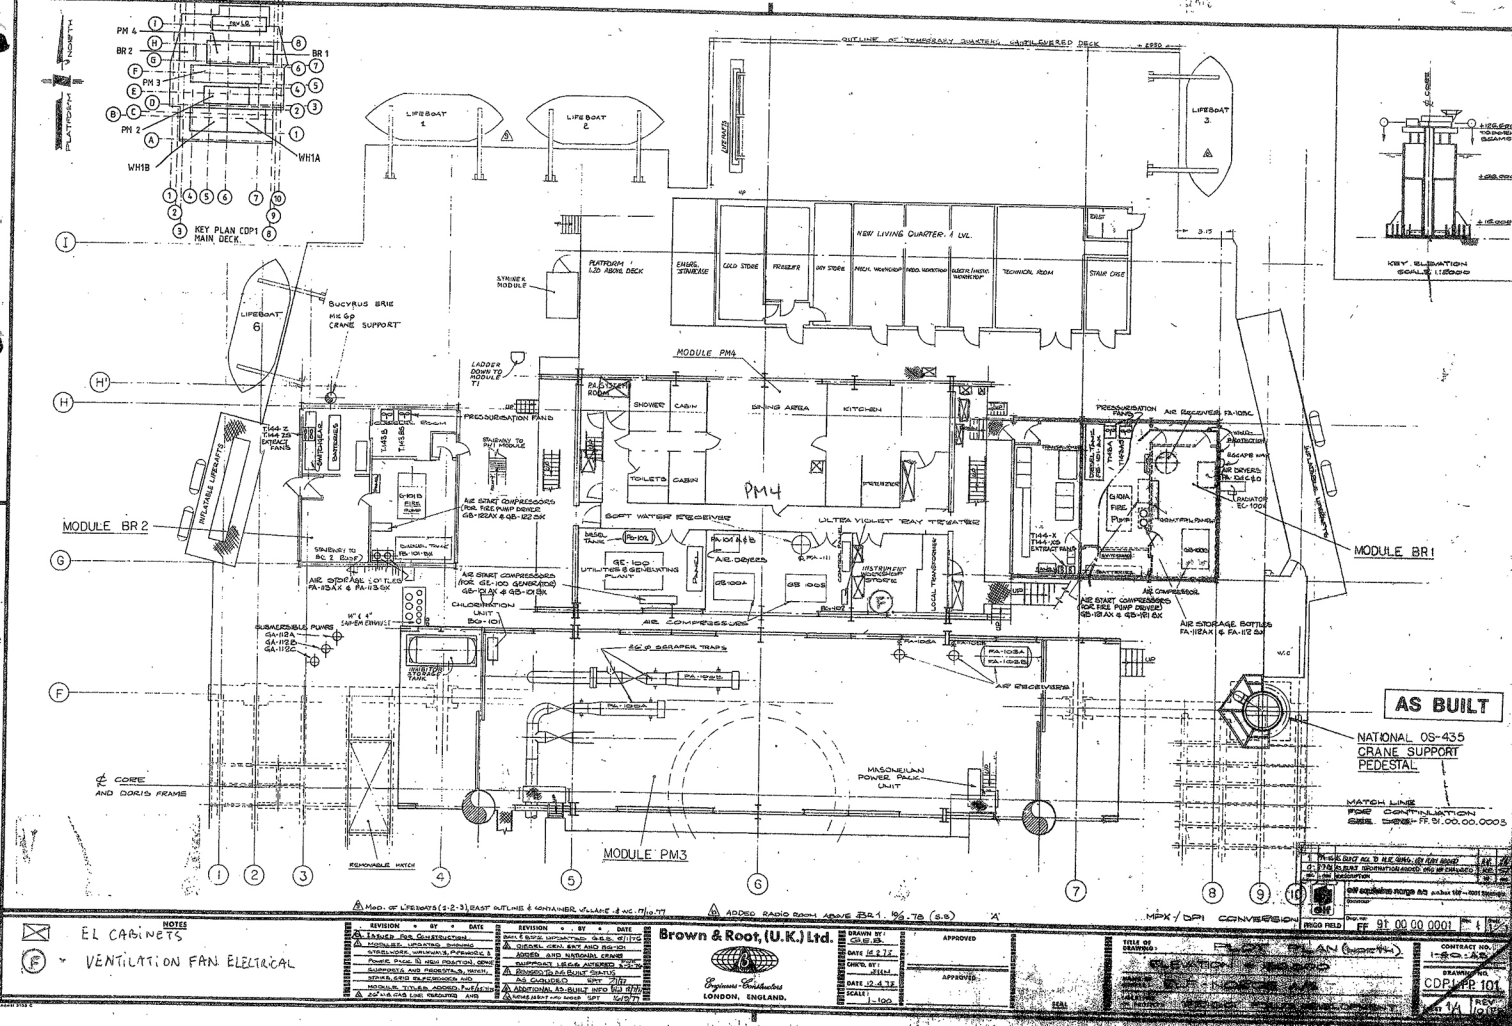

PLATFORM NORTH
PM 4
BR 2
BR 1
PM 3
PM 2
WH1B
WH1A
KEY PLAN CDP1 MAIN DECK
OUTLINE OF TEMPORARY QUARTERS CANTILEVERED DECK
LIFEBOAT 1
LIFEBOAT 2
LIFEBOAT 3
LIFEBOAT 6
NEW LIVING QUARTER 1 LVL.
PLATFORM 1 420 ABOVE DECK
EMERG. STAIRCASE
COLD STORE
FREEZER
DRY STORE
MECH. WORKSHOP
PROD. MONITOR
ELECTR./INSTR. MONITOR
TECHNICAL ROOM
STAIR CASE
STAIRWEX MODULE
BUCYRUS ERIE MK 6P CRANE SUPPORT
LADDER DOWN TO MODULE T1
MODULE PM4
PA SYSTEM ROOM
SHOWER CABIN
DINING AREA
KITCHEN
TOILETS CABIN
PM4
PRESSURISATION FANS
AIR RECEIVER FA-101C
AIR DRYERS FA-104C & D
RADIATOR EC-100A
INFLATABLE LIFERAFTS
MODULE BR 2
MODULE BR1
SOFT WATER RECEIVER
ULTRA VIOLET RAY TREATER
DIESEL TANK
GE-100 UTILITIES & GENERATING PLANT
AIR DRYERS
GB-100A
GB-100B
INSTRUMENT WORKSHOP STORE
LOCAL TRANSFORMER
AIR COMPRESSORS
AIR COMPRESSOR
AIR START COMPRESSORS (FOR FIRE PUMP DRIVER) GB-122AX & GB-122BX
AIR START COMPRESSORS (FOR GE-100 GENERATOR) GB-101AX & GB-101BX
AIR STORAGE BOTTLES FA-113AX & FA-113BX
AIR STORAGE BOTTLES FA-112AX & FA-112BX
CHLORINATION UNIT BO-101
SUBMERSIBLE PUMPS GA-112A GA-112B GA-112C
AIR RECEIVERS
MASONEILAN POWER PACK UNIT
℄ CORE AND DORIS FRAME
REMOVABLE HATCH
MODULE PM3
KEY ELEVATION SCALE 1:2000
AS BUILT
NATIONAL OS-435 CRANE SUPPORT PEDESTAL
MATCH LINE FOR CONTINUATION SEE DWG. FF 91.00.00.0003
MPX / DPI CONVERSION
NOTES
EL CABINETS
VENTILATION FAN ELECTRICAL
REVISION BY DATE
ISSUED FOR CONSTRUCTION
MODULES UPDATED DRAWING STRUCTURE, WALKWAYS, PIPEWORK & POWER PACK TO NEW POSITION, CRANE SUPPORTS AND PEDESTALS, WATCH, STAIRS, GRID REFERENCES AND MODULE TITLES ADDED. PWR/PWR
ADDED RADIO ROOM ABOVE BR1. 10/9.78 (S.B.)
Brown & Root, (U.K.) Ltd.
Engineers Constructors
LONDON, ENGLAND.
DRAWN BY: G.E.B.
DATE 14.2.78
CHK'D BY: JHM
DATE 12.4.78
SCALE: 1:100
APPROVED
TITLE OF DRAWING: PLAN (NORTH)
ELEVATION
CONTRACT NO. 1-60-A3
DRAWING NO. CDP1 PP 101
REV. 1/01