


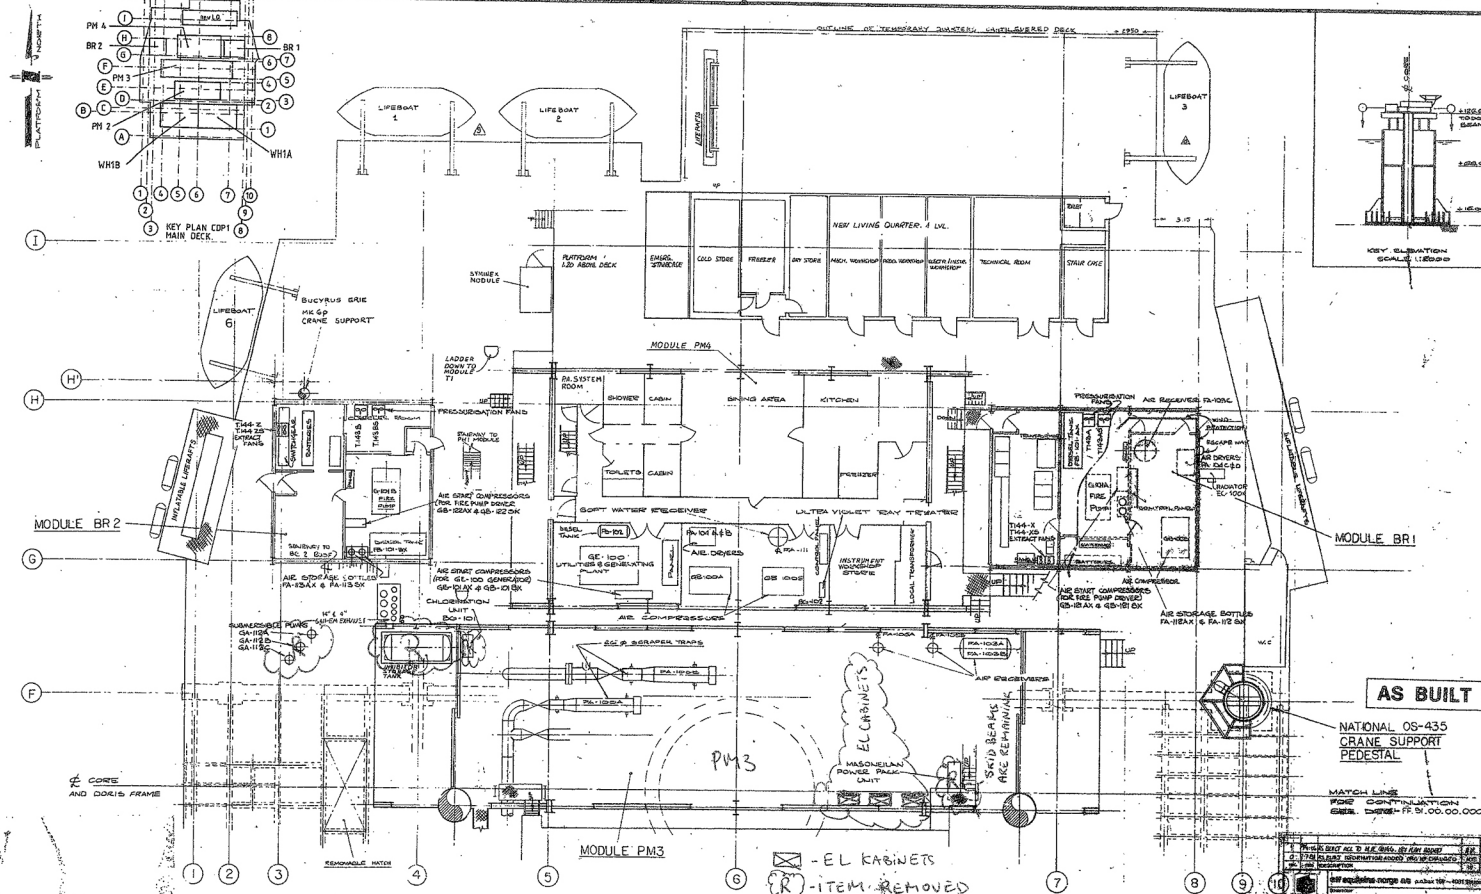

NOTES










