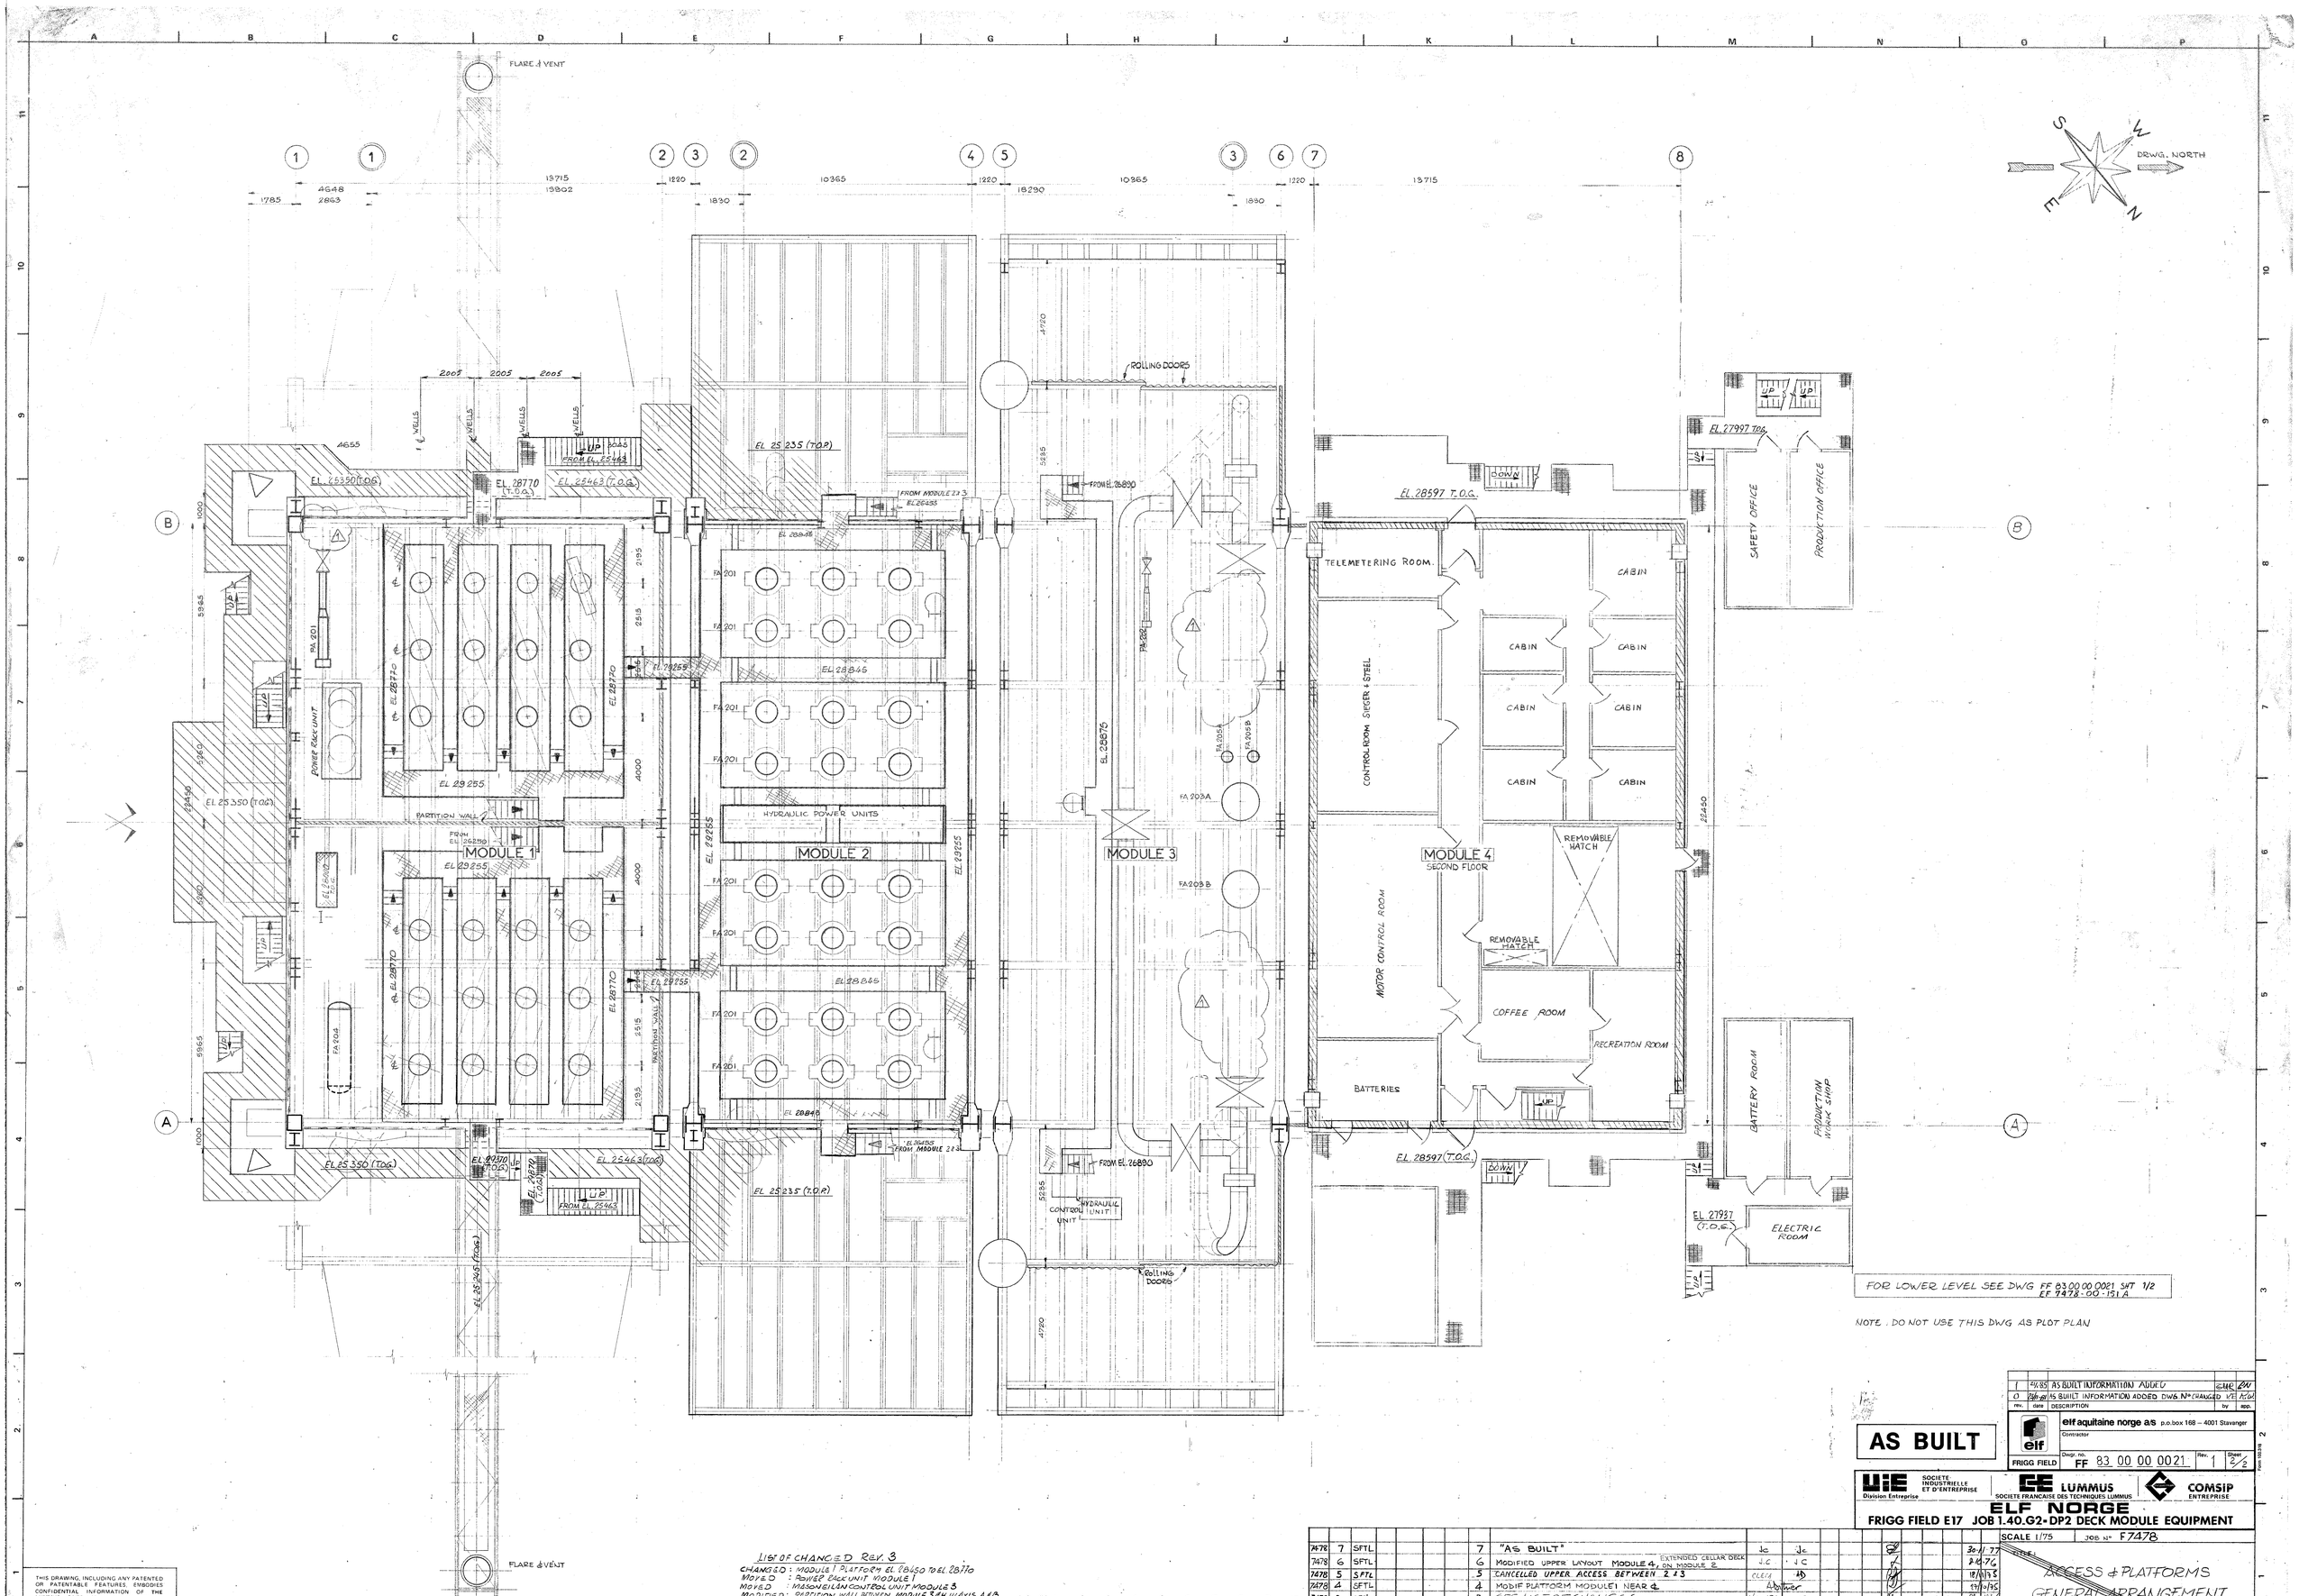


FOR LOWER LEVEL SEE DWG FF 83 00 00 0021 SHT 1/2
EF 7478-00-151 A

NOTE : DO NOT USE THIS DWG AS PLOT PLAN

LIST OF CHANGED REV. 3

CHANGED : MODULE 1 PLATFORM EL 28450 TO EL 28770
MOVED : POWER RACK UNIT MODULE 1
MOVED : MASONEILAN CONTROL UNIT MODULE 3
MODIFIED : PARTITION WALL BETWEEN MODULE 3 & 4 IN AXIS A & B
" " " MODULE 3 IN AXIS 6 FROM AXIS A & B TO ROLLING DOORS
CHANGED : PLATF. EL 28845 TO EL 29255 MODULE 2
" " " 28495 TO EL 29255 AND ACCESS IN MODULE 3
" PLATFORM MODULE 1 NEAR & MODULE SHORTEND.

0 0.5 1 2 3 4 5 6 7 8 9 10
SCALE 1/75°

| JOB | REV. | ISSUE | | DESCRIPTION | DWN | CHK'D. | INST. | STRESS | PROC. | PROJ. ENG. | DIV. ENG. | P.D.S. | M.P.D. | |
|---|---|---|---|---|---|---|---|---|---|---|---|---|---|---|
| 7478 | 7 | SFTL | 7 | "AS BUILT" | Jc | Jc | | | | | | | | 30-11-77 |
| 7478 | 6 | SFTL | 6 | MODIFIED UPPER LAYOUT MODULE 4, EXTENDED CELLAR DECK ON MODULE 2 | J.C | J.C | | | | | | | | 2-10-76 |
| 7478 | 5 | SFTL | 5 | CANCELLED UPPER ACCESS BETWEEN 2 & 3 | CLEIA | [illegible] | | | | | | | | 12/10/75 |
| 7478 | 4 | SFTL | 4 | MODIF PLATFORM MODULE 1 NEAR ℄ | Adjutor | | | | | | | | | 29/10/75 |
| 7478 | 3 | SFTL | 3 | SEE LIST OF CHANGES | HEINOL | | | | | | | | | [illegible] |
| 7478 | 2 | SFTL | 2 | APPROVED FOR CONSTRUCTION | VATER HEINOL | VATER | | | | | | | | [illegible] |
| 7478 | 1 | | 1 | FOR APPROVAL | Dilter | | | | | | | | | [illegible] |

| rev. | date | DESCRIPTION | by | app. |
|---|---|---|---|---|
| 1 | 24.85 | AS BUILT INFORMATION ADDED | GHR | RW |
| 0 | 26/11-81 | AS BUILT INFORMATION ADDED DWG. No CHANGED | VE | KCW |

**AS BUILT**

elf aquitaine norge a/s p.o.box 168 – 4001 Stavanger
Contractor
FRIGG FIELD
Dwgr. no. FF 83 00 00 0021 Rev. 1 Sheet 2/2

UIE SOCIETE INDUSTRIELLE ET D'ENTREPRISE Division Entreprise
LUMMUS SOCIETE FRANCAISE DES TECHNIQUES LUMMUS
COMSIP ENTREPRISE

**ELF NORGE**
**FRIGG FIELD E17 JOB 1.40.G2-DP2 DECK MODULE EQUIPMENT**

SCALE 1/75 JOB No F7478

ACCESS & PLATFORMS
GENERAL ARRANGEMENT
SHEET 2 OF 2

DRAWING No. EF7478. 00.151 B 7

THIS DRAWING, INCLUDING ANY PATENTED OR PATENTABLE FEATURES, EMBODIES CONFIDENTIAL INFORMATION OF THE LUMMUS COMPANY AND ITS USE IS CONDITIONED UPON THE USER'S AGREEMENT NOT TO REPRODUCE THE DRAWING IN WHOLE OR IN PART, NOR THE MATERIAL DESCRIBED THEREON, NOR TO USE THE DRAWING FOR ANY PURPOSE OTHER THAN SPECIFICALLY PERMITTED IN WRITING BY THE LUMMUS COMPANY

22471