


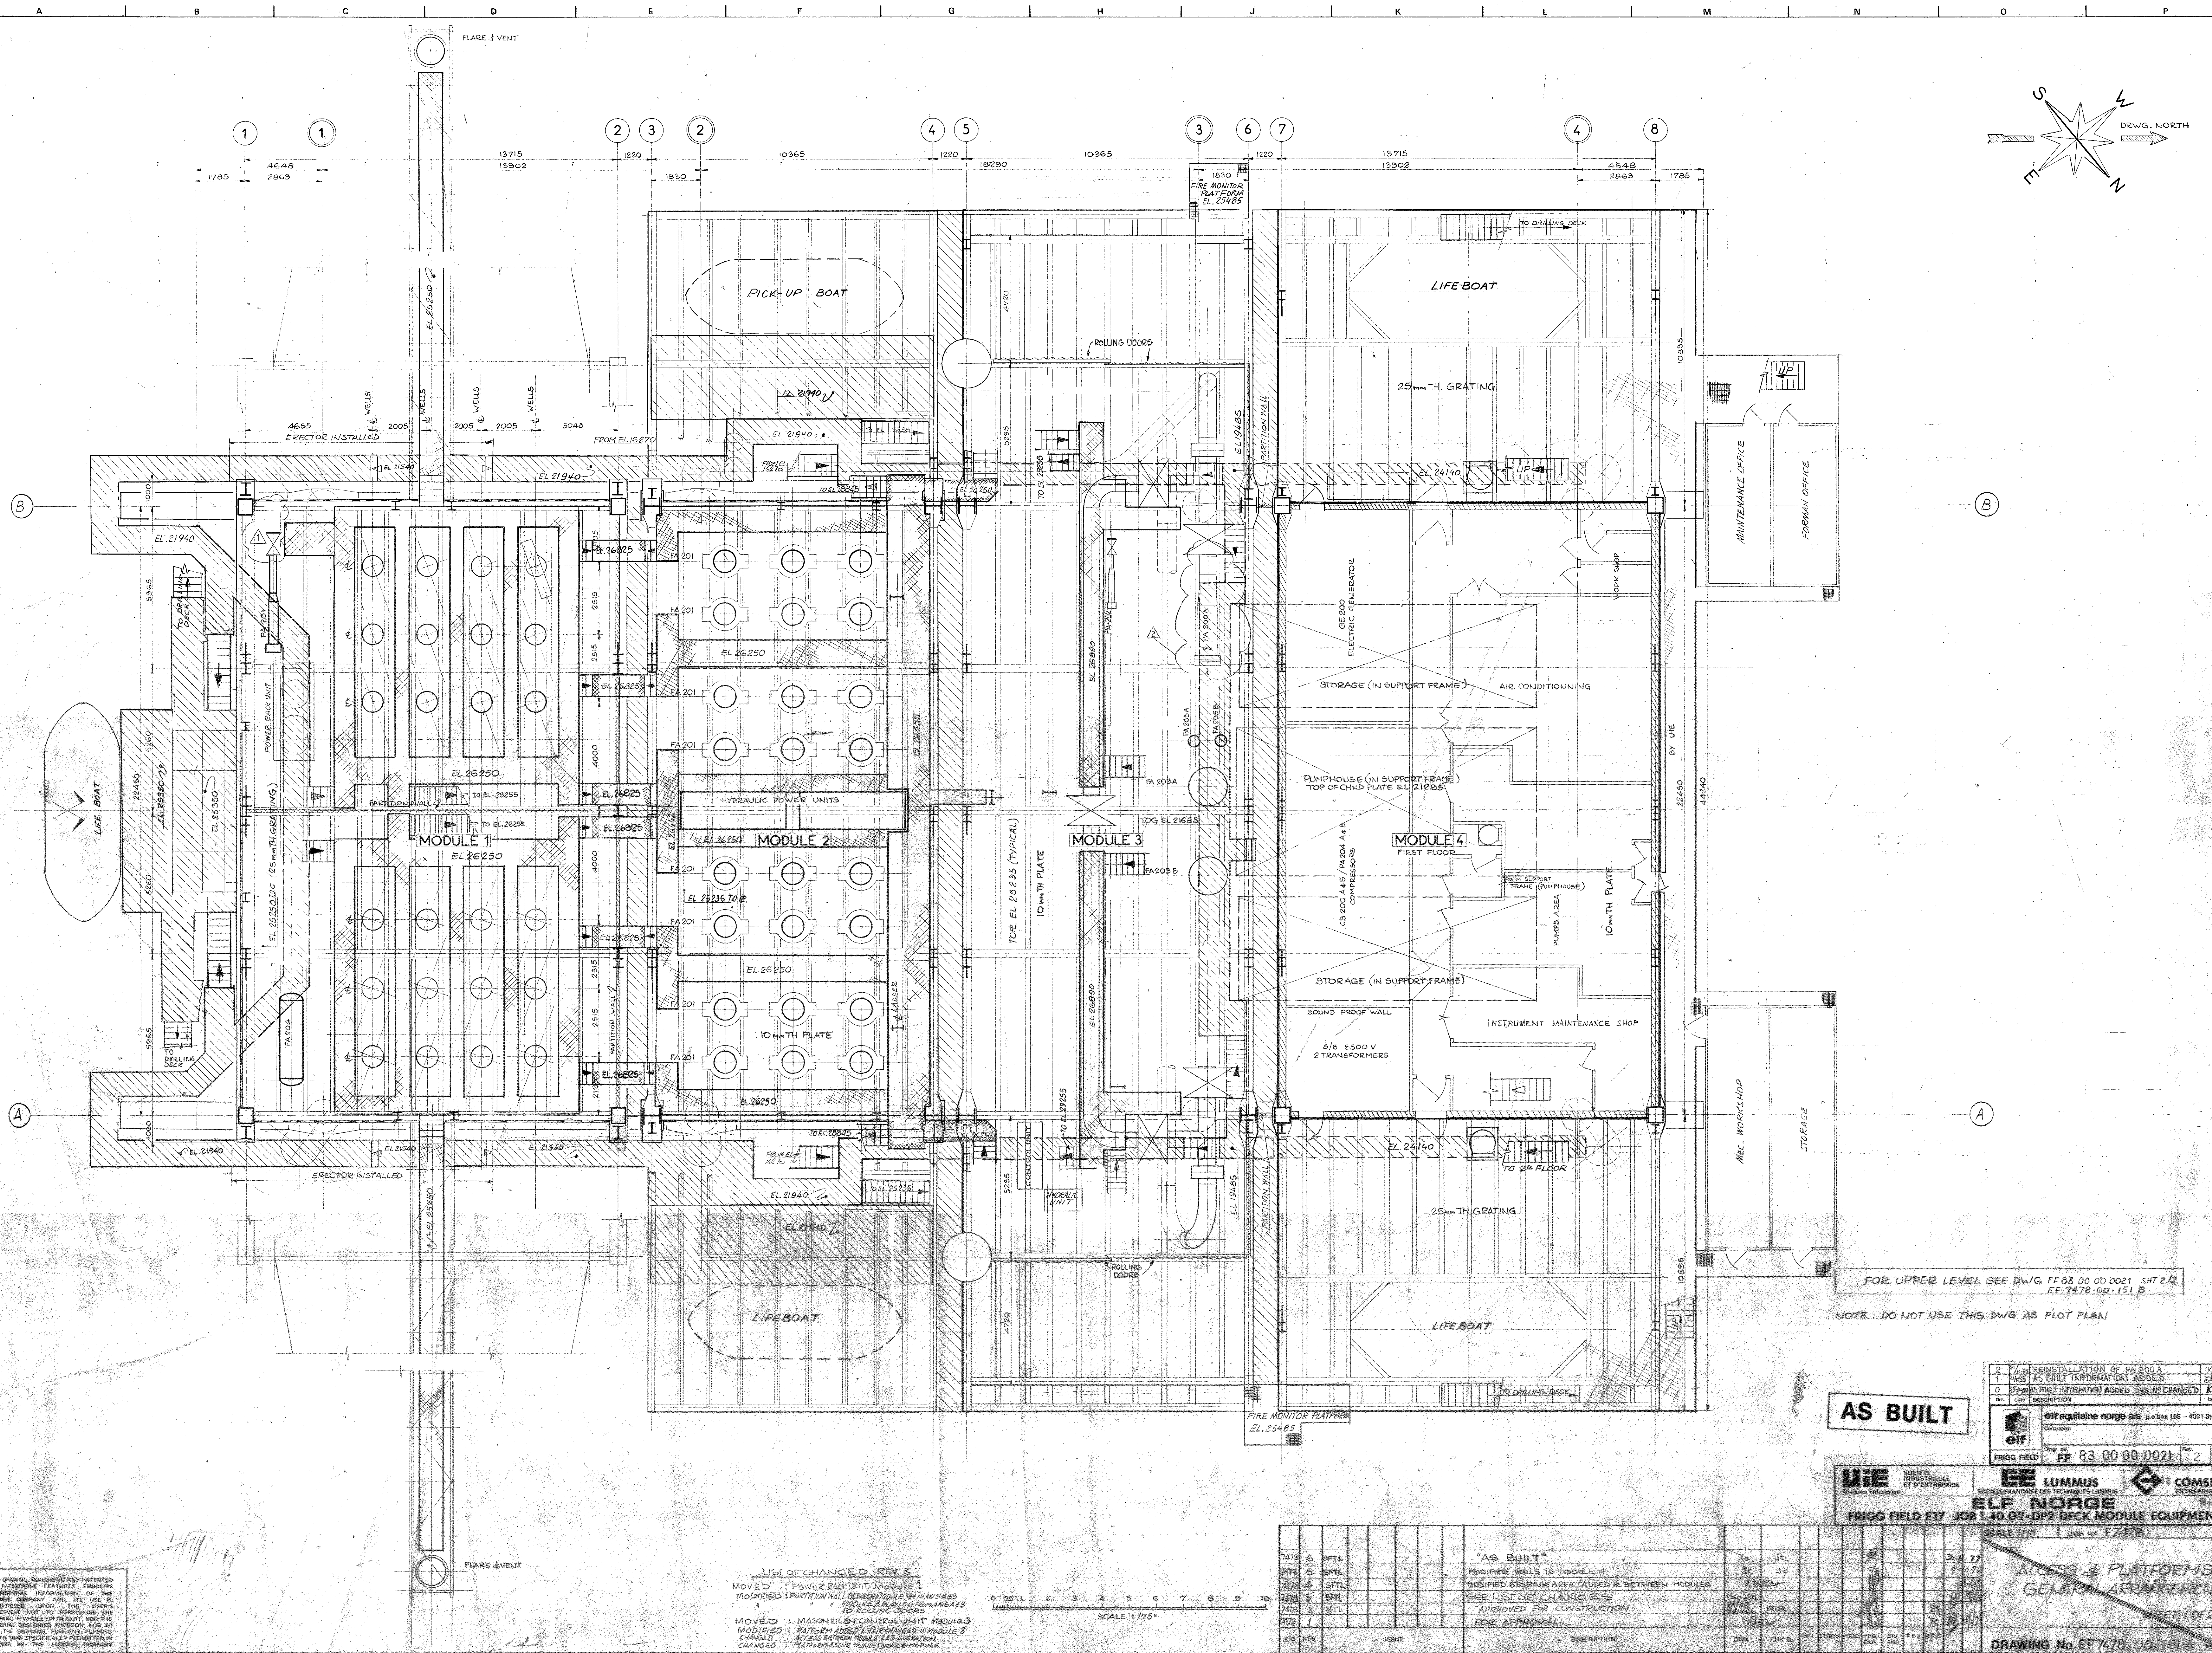

2	17/10/93	REINSTALLATION OF PA 200A	W/S	SA
1	14/03/93	AS BUILT INFORMATION ADDED	SA	SA
0	23/04/93	AS BUILT INFORMATION ADDED. DWS N° CHANGED	KE	SA
Rev.	date	DESCRIPTION	by	app
 elf aquitaine norge a/s p.o.box 188 - 4001 Stavanger Contractor				
Drawn by FRIGD FIELD			No 83.00.00.0021	Rev. 2
Sheet 1			of 1	

 SOCIÉTÉ INDUSTRIELLE ET D'ENTREPRISE
 Division Entreprise

 SOCIÉTÉ FRANÇAISE DES TECHNIQUES LUMMUS

 COMSIP
 ENTREPRISE

ELF NORGE
 FRIGG FIELD E17 JOB 1.40.G2-DP2 DECK MODULE EQUIPMENT

SCALE 1/75 JOB No. EF7478
 ACCESS & PLATFORMS
 GENERAL ARRANGEMENT
 SHEET 1 OF 2
 DRAWING No. EF7478.00.151A - 6

THIS DRAWING, INCLUDING ANY PATENTED OR PATENTABLE FEATURES, EMBODIES CONFIDENTIAL INFORMATION OF THE LUMBER COMPANY AND ITS USE IS CONDITIONED UPON THE USER'S AGREEMENT NOT TO REPRODUCE THE DRAWING IN WHOLE OR IN PART, NOR THE MATERIAL DESCRIBED THEREON, NOR TO USE THE DRAWING FOR ANY PURPOSE OTHER THAN SPECIFICALLY PERMITTED IN WRITING BY THE LUMBER COMPANY.

LIST OF CHANGED REV. 3

MOVED : POWER EX UNIT MODULE 1
MODIFIED : PARTITION WALL BETWEEN MODULE 3 & 4
MODULE 3 IN A 1/2 REMOVED
TO ROLLING DOORS
MOVED : MASONRY LANE CONTROL UNIT MODULE 3
MODIFIED : PLATFORM ADDED & AIR CHANGED IN MODULE 3
CHANGED : ACCESS BETWEEN MODULE 2 & 3 EVAPORATION
CHANGED : PLATFORM & MODULE 1 EXIST & MODULE

[illegible]