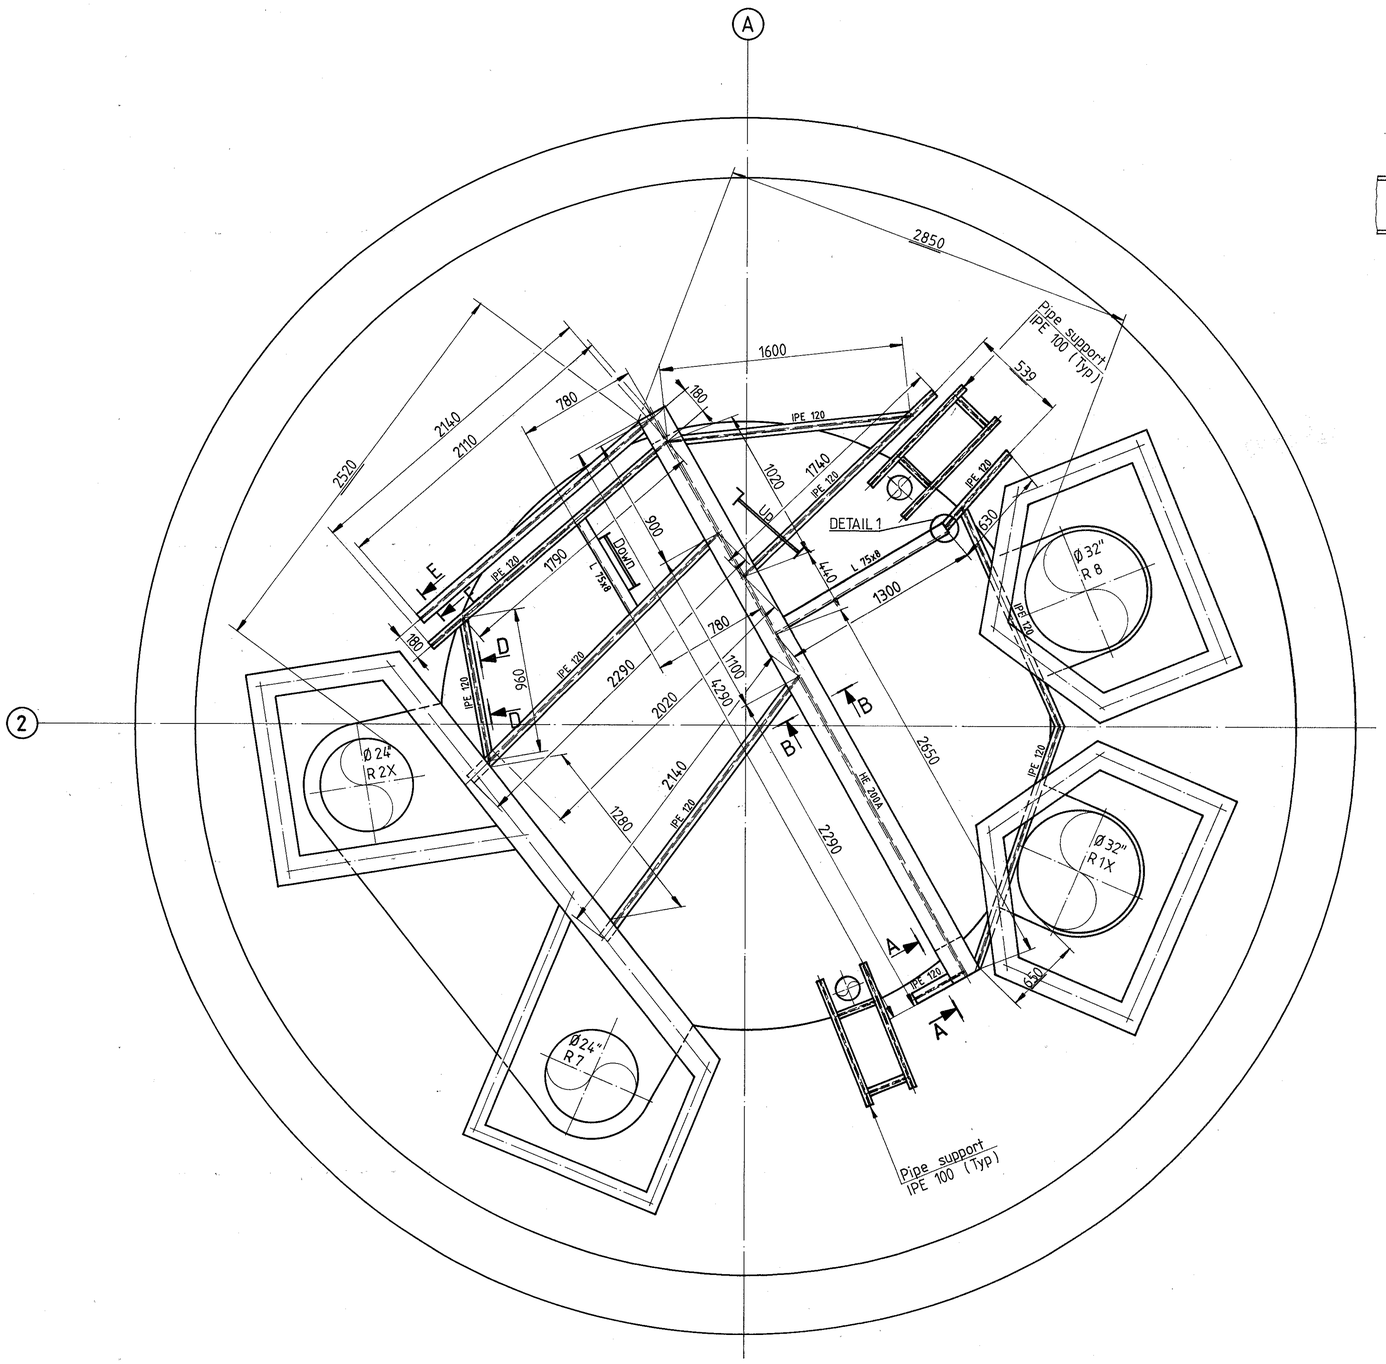

Existing framing column 2 level +5000

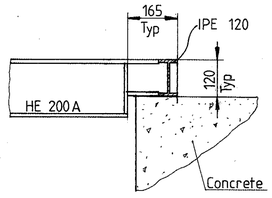

Section A - A
(TYP)

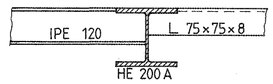

Section B - B
(TYP)

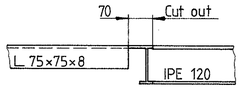

View C - C

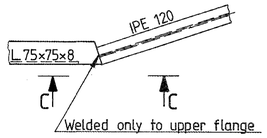

Detail 1

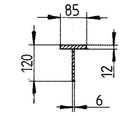

Section E - E

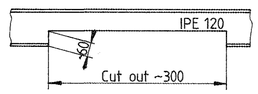

View D - D

Notes:

1. Steel quality unknown.

REF DRGS:
FF - 95 - 21 - 23 - 1264

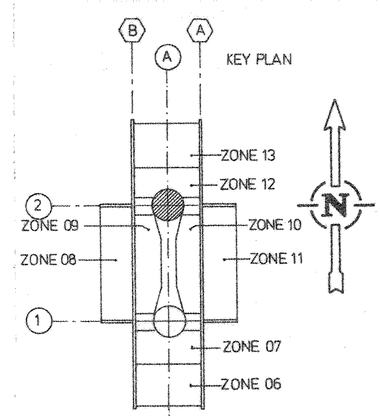

rev.	date	DESCRIPTION	by	app.
1	5/8-86	REPLACE DRG Nº FF - 95 - 21 - 28 - 1140	S.S	
0	2/6-86	first issue	S.E	

R.BJERCK AS
RÅDGIVENDE INGENIØRER
S 672 - 11359

elf aquitaine norge as p.o.box 168 – 4001 Stavanger

	Installation	System
A1	TP1	STRUCTURE

As built existing framing Column 2 Level +5000

Job no.	Scale	Drwg. no.	Rev.	Sheet
SR 95161	1:20 1:10	FF 95 21 23 12 41	1	1/1

FRIGG FIELD

Size A1 Form. 110 210 - 73 - 1980