DWG. NO. ELN 02020 | SHEET NO. 131

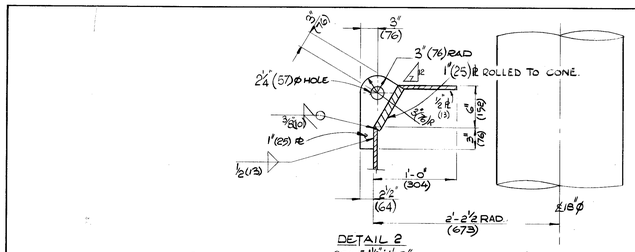

DETAIL 2
SCALE 1½" : 1'-0"

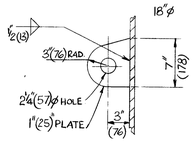

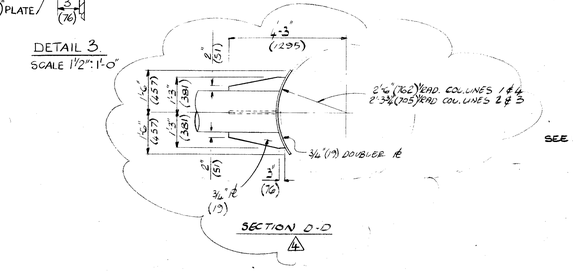

SECTION D-D
4

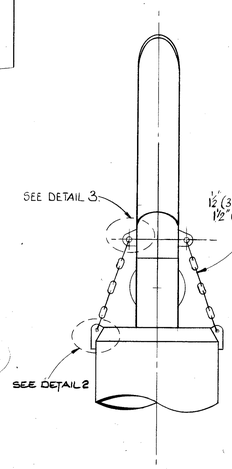

VIEW 'A-A'
SCALE ½" : 1'-0"

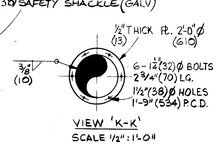

VIEW 'K-K'
SCALE ½" : 1'-0"

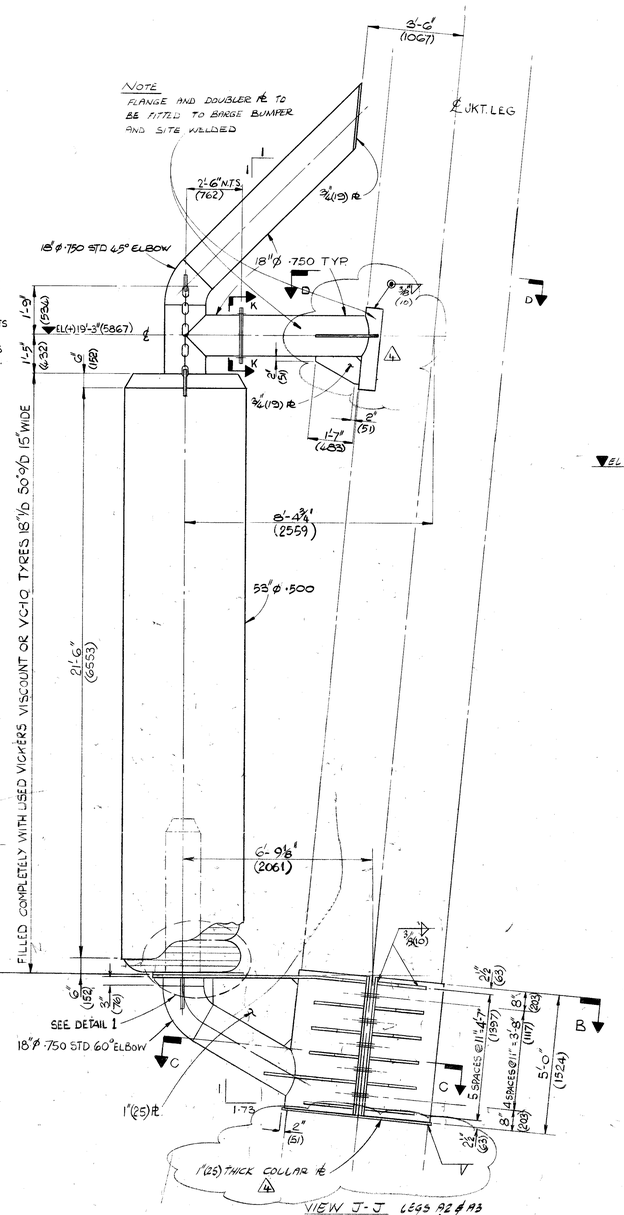

VIEW J-J LEGS R2 & R3
4

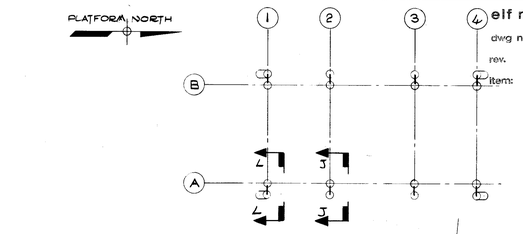

PLATFORM NORTH

elf norge a.s
dwg no: FF 931. E10. 034
rev. : 0 date : 09.10.74
item:

NOTES:-
1. PLATES, SHAPES & ROLLED PIPE TO BE ST-37-2 UNLESS OTHERWISE NOTED. MILL PIPE TO BE API-5L GRADE 'B'. BOLTS A.S.T.M A325.
2. DIMENSIONS SHOWN IN BRACKETS ARE METRIC EQUIVALENTS IN MILLIMETRES.

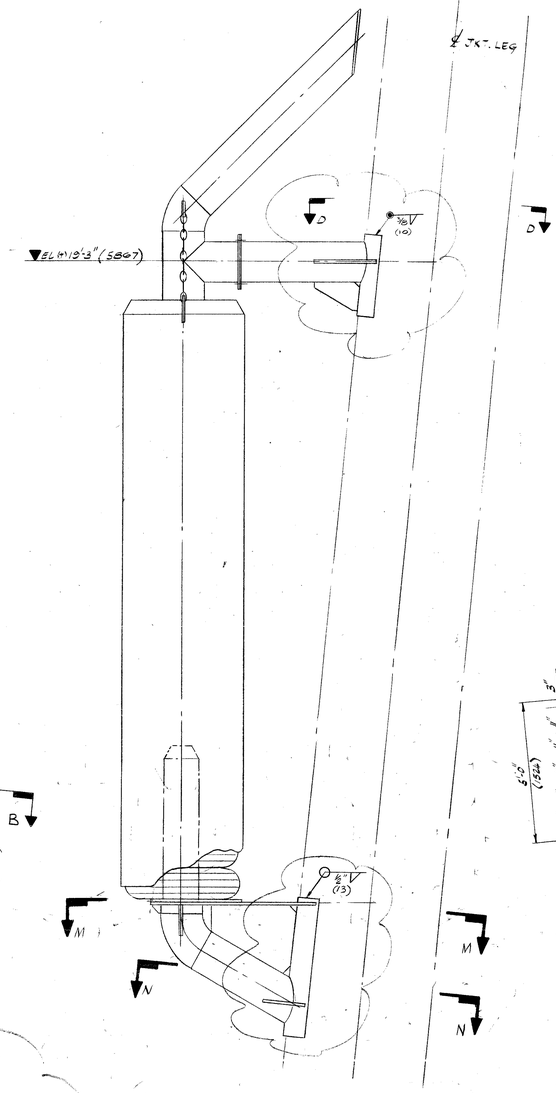

VIEW L-L LEGS R1, R4, B1, B2, B3 & B4
(SIMILAR TO VIEW J-J)
4

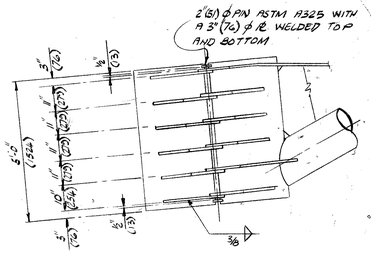

VIEW F-F 'ON BATTER

5-1¼" DIA (32) HEX BOLTS X 6" (152) LG. WITH 1¼ DIA. (32) HEAVY HEX. NUTS AND 2 WASHERS (EACH BOLT TO HAVE 3" (76) OF U.N.C. THREAD.)

VIEW 'G-G'
SCALE ½" : 1'-0"

SECTION 'B-B'

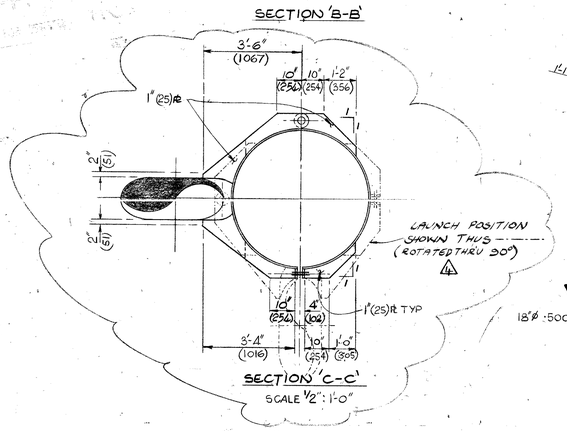

SECTION 'C-C'
SCALE ½" : 1'-0"

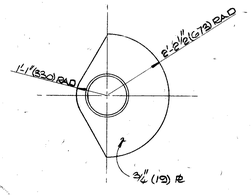

VIEW 'H-H'

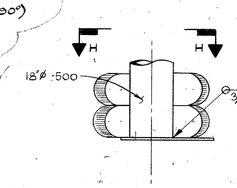

DETAIL 1
SCALE ½" : 1'-0"

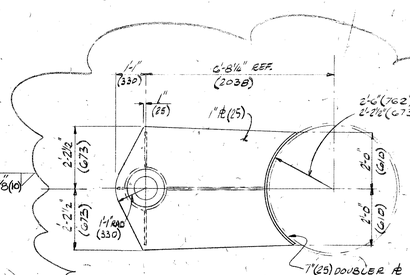

SECTION M-M
4

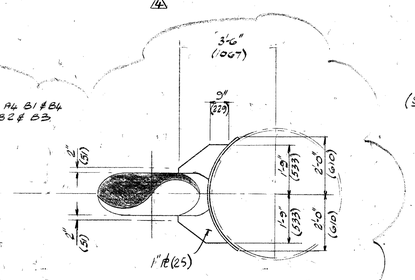

SECTION N-N
4

SCALES:-

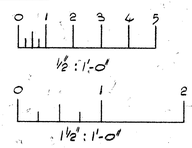

elf norge a.s
dwg no: FF 931. E10. 034
rev. : 0 date : 09.10.74
item:

APPROVED:
Mc DERMOTT — HUDSON
DATE: 22/12/72
ENGINEERS APPROVAL

ELF-NORGE A/S
NORWAY
24 WELL SELF CONTAINED
DRILLING PLATFORM No 1
NORTH SEA FRIGG FIELD WD 98 M
McDERMOTT – HUDSON
LONDON — ENGLAND

PROJECT		
STRUCTURAL	JJ	9/74
PROCESS		
MECHANICAL		
ELECTRICAL		
INSTRUMENT		
FAB. CHECK		
PROJ. CHECK		

DRAWN/BY J. Mitchell
DESIGNED BY
SCALE AS NOTED.
DATE 21-FEB-1973
DWG. NO. ELN 02020
SHEET NO. 131

BARGE BUMPER

FAB. STDS. REQ'D. THIS SHT.

DESIGN	STRUCT	PIPING	ELEC.	MK.	BY	DATE	REVISIONS	DATE	APP.
				4	CAP	11-12-73	ALTERATIONS TO CLAMP DETAILS	8/1/74	
				3	CAP	20-11-73	STABBING POINT REVISED (VIEW G-G)	20 Dec 73	
				2	RS	29-6-73	DETAIL 2 REVISED	24/8/73	
				1	JJ	26.5.73	VIEW 'K-K' & FLANGES ADDED.	11/6/73	

S & R LTD 24224