DWG. NO.	SHEET NO.
ELN 02020	132

NOTE:-
1) ALL STEEL MILD STEEL NON STRUCTURAL
2) DIMENSIONS SHOWN IN BRACKETS ARE METRIC EQUIVALENTS IN MILLIMETRES

elf norge a.s
dwg no: FF 931.210.035
rev. :0 date: 09.10.74
item:

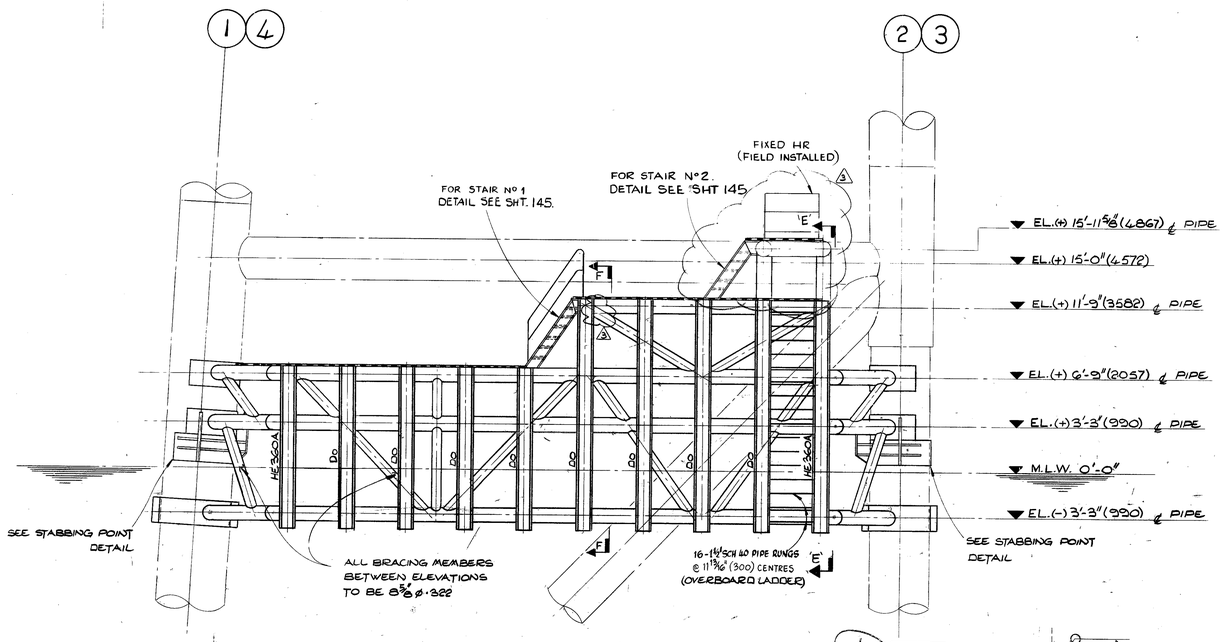

ELEVATION ON 'A-A'
SCALE ½" : 1'-0"
(SEE SHEET 133.)

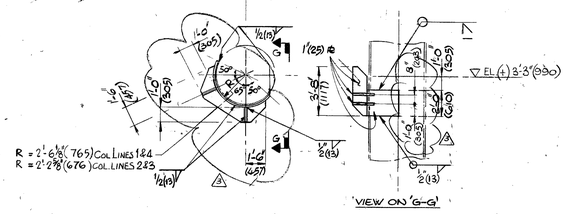

STABBING POINT DETAIL

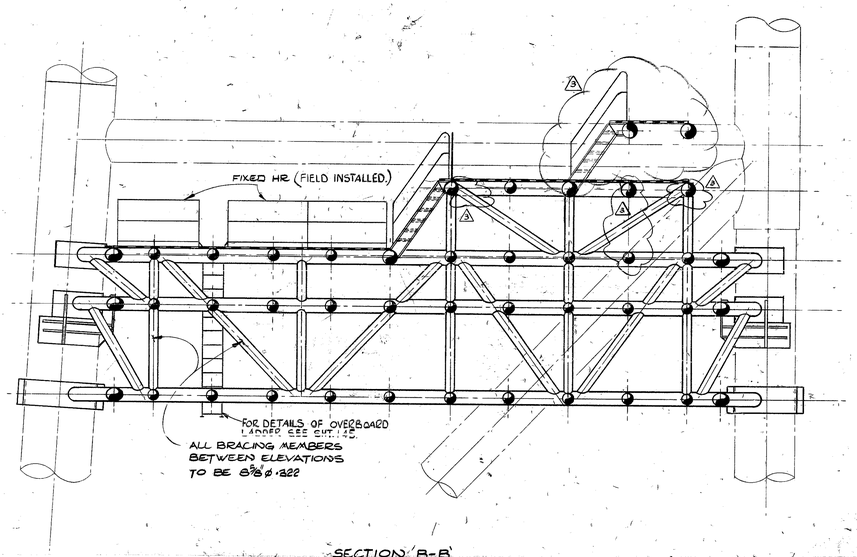

SECTION 'B-B'
SCALE ½" : 1'-0"
(SEE SHEET 133.)

PLANT NORTH

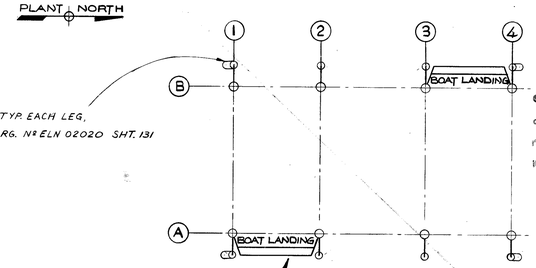

KEY PLAN

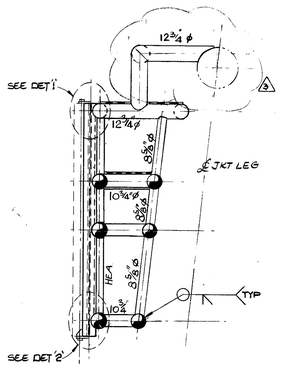

SECTION 'E-E'
SECTION F-F' SIMILAR.
SCALE ¼" : 1'-0"

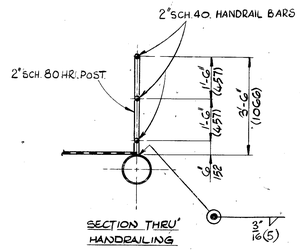

SECTION THRU' HANDRAILING

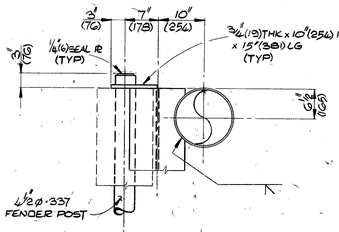

DETAIL '1'
SCALE 1" : 1'-0"

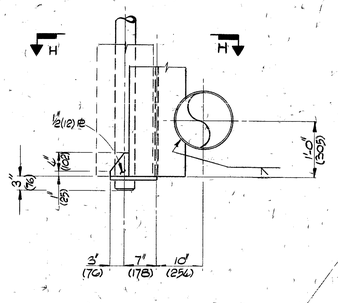

DETAIL '2'
SCALE 1" : 1'-0"

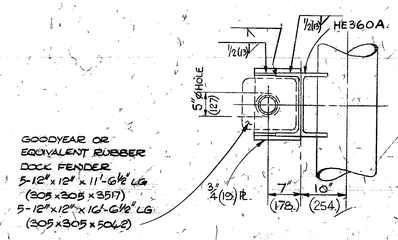

SECTION 'H-H'
SCALE 1" : 1'-0"

REFERENCE DWGS:-

Mc D-H DWGS:-	
PLANS OF BOAT LANDING SHT 2 OF 2	ELN 02020 SHT 133
BARGE BUMPER	ELN 02020 SHT 131
BOAT LANDING STAIRS & OVERBOARD LADDER	ELN 02020 SHT 145

SCALES:-

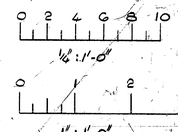

elf norge a.s
dwg no: FF 931.210.035
rev. :0 date: 09.10.74
item:

FAB. STDS. REQ'D. THIS SHT.

DESIGN	STRUCT.	PIPING	ELEC.	MK.	BY	DATE	REVISIONS	DATE	APP.

DESIGN	STRUCT.	PIPING	ELEC.	MK.	BY	DATE	REVISIONS	DATE	APP.

DESIGN	STRUCT.	PIPING	ELEC.	MK.	BY	DATE	REVISIONS	DATE	APP.
				3	AP	11-12-73	STUB NO 2 MOVED & DOUBLER PLATE REMOVED. WEB MEMBER BETWEEN (6) & (9) & 4-9 REMOVED. CLAMP FIXING & STABBING POINT DETAILS INCLUDED.	30/01/74	
				2	AP	23-6-73	WELD DETAIL ADDED. SECTION E-E	21/07/73	
				1	EW	14-3-73	DRAWING No CHANGED	16/5/73	

APPROVED			
Mc DERMOTT — HUDSON			
DATE			
ENGINEERS APPROVAL			
PROJECT			
STRUCTURAL			
PROCESS			
MECHANICAL			
ELECTRICAL			
INSTRUMENT			
F&B CHECK			
PROJ. CHECK			

ELF-NORGE A/S
NORWAY

24 WELL SELF CONTAINED
DRILLING PLATFORM No 1
NORTH SEA FRIGG FIELD WD 98 M

McDERMOTT – HUDSON
LONDON — ENGLAND

DRAWN BY	SCALE	DATE	DWG. NO.
J. Mitchell	½" : 1'2"	10 DEC 1972	ELN 02020
DESIGNED BY			SHEET NO.
B. HADDOW			132

BOAT LANDING SHT 1 OF 2

4

S & H LTD 2022