DWG. NO. ELN 2020 | SHEET NO. 149

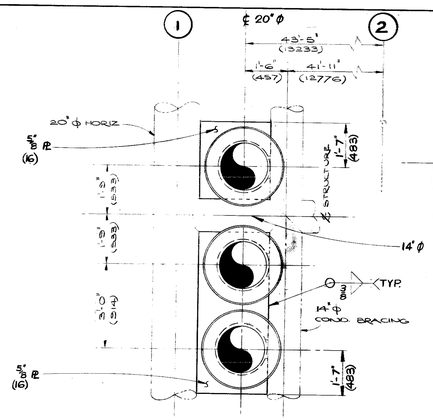

SECTION 'E-E'

DIMENSIONS AT EL (+) 72'-0" (21964)

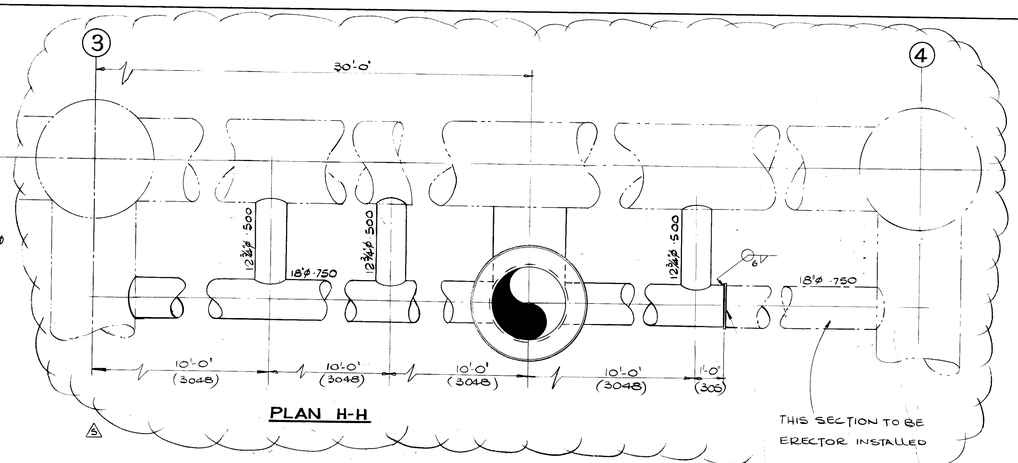

PLAN H-H

THIS SECTION TO BE ERECTOR INSTALLED

1-3"DIA (483) x ⅜" (6) CLOSING PLATE TO BE REMOVED BY ERECTOR BEFORE INSTALLATION OF 18"ϕ PIPE.

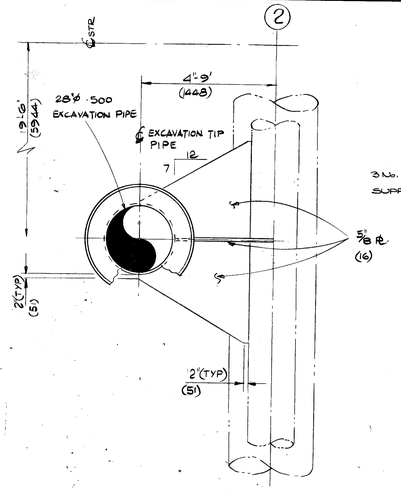

PLAN J-J

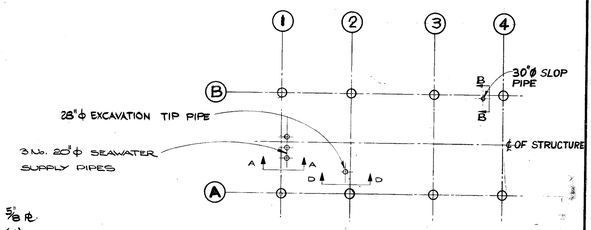

KEY PLAN

GENERAL NOTES

1. ALL STEEL TO BE NON-STRUCTURAL MILD STEEL.
2. FABRICATOR TO INSTALL IN JACKET ALL PIPE, CASING AND SUPPORTS BELOW EL (+) 18'-0".
3. FABRICATOR TO INSTALL ALL GUIDES AT EL (+) 72'-0"
4. FABRICATOR TO FURNISH ALL PIPE CASING BETWEEN EL (+) 18'-0" AND EL (+) 77'-0" AND SHIP LOOSE
5. ERECTOR TO INSTALL PIPE CASING BETWEEN EL (+) 18'-0" AND EL (+) 77'-0"

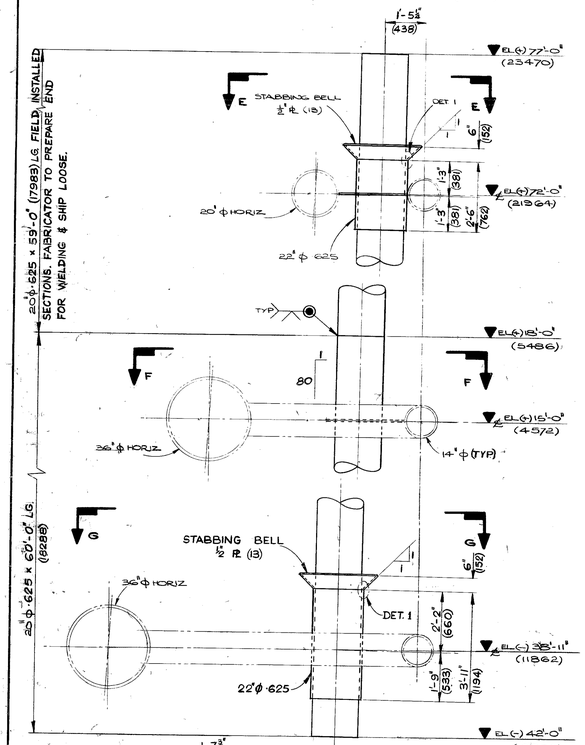

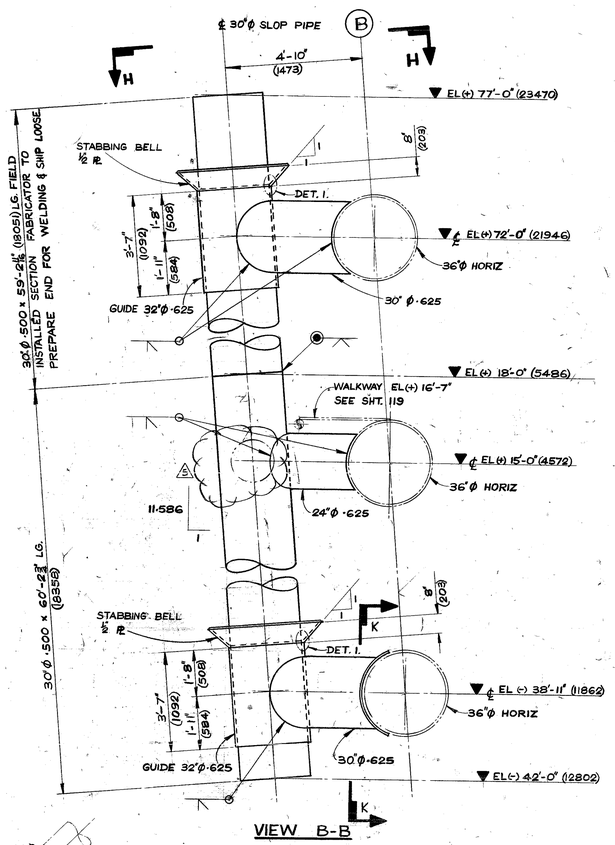

VIEW A-A

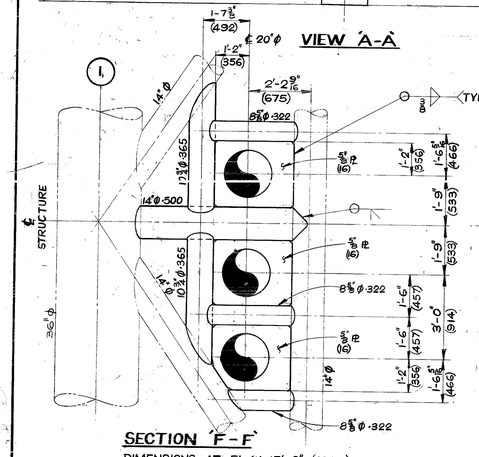

SECTION F-F

DIMENSIONS AT EL (+) 15'-0" (4572)

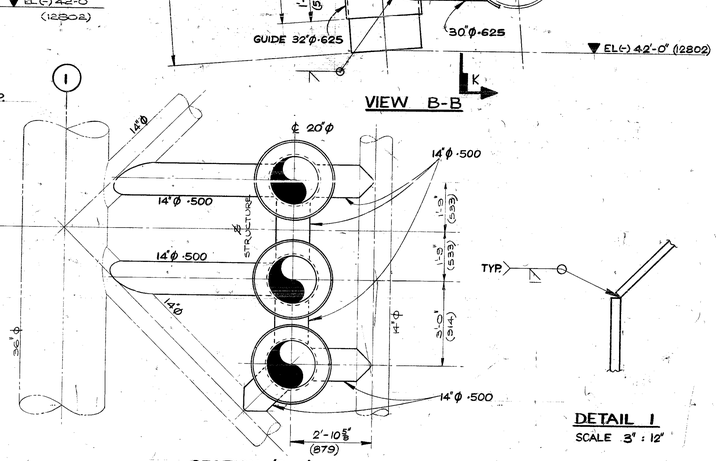

SECTION G-G

DIMENSIONS AT EL (-) 38'-11" (11862)

DETAIL 1

SCALE 3" : 12"

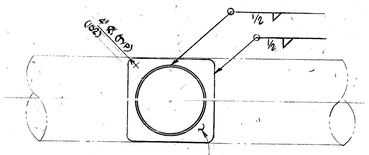

SECTION K-K

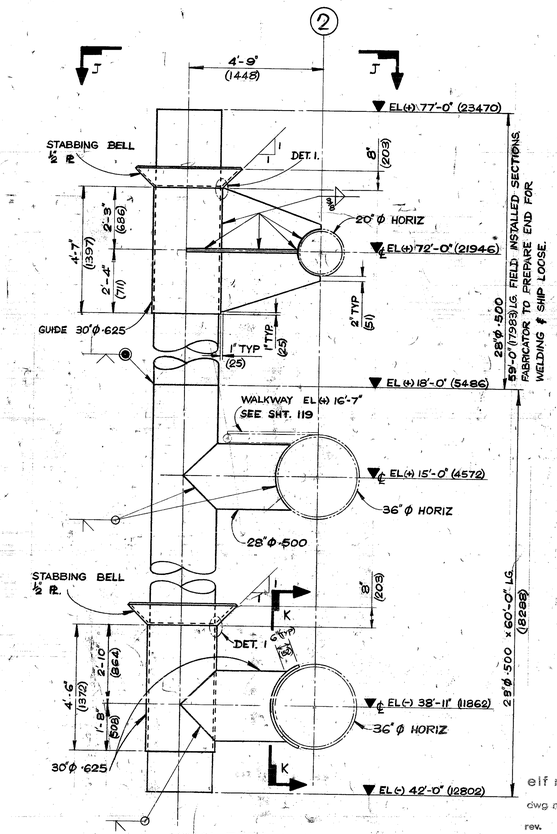

VIEW D-D

APPROVED
FOR CONSTRUCTION

elf norge a.s
dwg no: FF 931.210.051
rev. : 0 date: 09.10.74
Item:

FAB. STDS. REQ'D. THIS SHT.

DESIGN	STRUCT	PIPING	ELEC.	MK.	BY	DATE	REVISIONS	DATE	APP.
				5	MO	11/4/74	SUPPORT BUSS ADDED TO SLOP PIPE AT EL (+) 15'-0"	11/8/74	MA

DESIGN	STRUCT.	PIPING	ELEC.	MK.	BY	DATE	REVISIONS	DATE	APP.
				4	MGR	17-1-74	3 - 20"ϕ PUMP CASING REVISED	18/1/74	MA
				3	RD	14-1-74	3 NO 20"ϕ TOWER RET PLAN MODIFIED 3 No 20"ϕ CASINGS HELD.	5/2/74	MA
				1	MGR	18-10-73	REDRAWN	18/10/73	RD
				2	DJB	17-11-73	20" OTHER HAND VIEW C-C & 20"ϕ PIPE REMOVED ADDED	12/12/73	RD

PROJECT			
STRUCTURAL			
PROCESS			
MECHANICAL			
ELECTRICAL			
INSTRUMENT			
FAB. CHECK		ELN	15/10/73
PROP. CHECK			

ELF-NORGE A/S
NORWAY

24 WELL SELF CONTAINED

DRILLING PLATFORM No 1

NORTH SEA FRIGG FIELD WD 98 M

APPROVED: Mc DERMOTT — HUDSON DATE: 22 OCT 73

ENGINEERS APPROVAL

McDERMOTT — HUDSON
LONDON — ENGLAND

DRAWN BY	SCALE	DATE	DWG. NO
M.G. RADLEY	½" : 12"	18-OCT-73	ELN 2020
DESIGNED BY			SHEET NO
Moody			149

BRACKETS TO TIP & SEAWATER SUPPLY PIPES

S & H LTD 2517