4 — 18610 — 6 — 18610 — 7

LIFE BOAT 1 — LIFE BOAT 2 — LIFE BOAT 3

RECREATION ROOM — ELF OFFICE (O.C.D) — ELF MAINTENANCE OFFICE — MAINTENANCE OFFICE (INSTRUMENTS) — WORKSHOP — MAINTENANCE STORE (MECHANICAL)

TOG + 128570 — TOG + 127400 — PLATFORM TOG EL+ 128570 — MAIN DECK TOG EL + 127400

FOOD STORAGE — SICK BAY

WEST MANIFOLD — DRY MANIFOLD — 2730

WALKWAY TOG EL + 128570

SHOWER — CABIN — DINING AREA — KITCHEN — DRY STORAGE — TOILETS — CABIN — FREEZER — FREEZER — SAFETY EQUIPT.

BR2 — TOP EL+127905 — BR1 TOP EL+127987

GENERATORS PLANT — AIR COMPRESSORS — WORK SHOP STORE — LOCAL TRANSFO

I — H — G — 8 — 7 — B — A

9300 — 7398 — 9290 — 13716

27 — 10973 — 10973 — 27 — 18207 — 14572

REFERENCES DRAWINGS

BROWN & ROOT DRAWINGS

PM6.BR1.BR2 DORS DECK LOCATION	B.EN.AA 016
NATIONAL CRANE SUPPORT	B.EN SS 162 & 163
BR1 & BR2 SHD BEAM SHEET 1 & 2	CDP1 SS 326 & 327
ACCES TO BR1 WEST	CDP1-SS 470
ACCES TO BR2	CDP1-SS 472
STRUCTURE FOR LIFE BOAT REMOVABLE	CDP1-SS 210 & 211

VIE DRAWINGS

LIVING QUARTERS	PLAN VIEW	F 7045 E 101-04
" "	TYPICAL TRANSVERSAL SECTION	F 7045 D 103-04
WALKWAY FRAMING	+ 128570	F 7045 E 118-04
WALKWAY "	+ 131587	F 7045 E 119-04
WALKWAY GRATING		F 7045 E 120-04
LIVING QUARTERS	STAIRS	F 7045 D 115-04
" "	FRAME OF SIDING	F 7045 E 109-04
" "	FRAME FOR LIFEBOAT	F 7045 E 124-04

McDERMOTT. HUDSON DRAWINGS

EX IP1 "UNIT D"	CELLAR DECK FRAMING	ELN 0880 247
" " "	TRUSS 7 & 8	" " 248
" " "	DETAIL TRUSS	" " 249

WILSON WALTON ENG.

FLOOR PLAN BR1	5789-1001
TRUSS ELEVATION BR1	5789-1003 & 1004
FLOOR PLATING BR1	5789-1005
BR1 CLADING SIDE	202/114 TO 202/119
BR1 & BR2 TYPICAL DETAIL	202/139
FLOOR PLAN BR2	5789-1014
TRUSS ELEVATION BR2	5789-1016 & 1017
FLOOR PLATING BR2	5789-1018
BR2 CLADING SIDE	202/219 TO 202/222

PENN & BAUDUIN DRAWINGS

PUMPHOUSE AND TANK MODULE	ACCES LADDER	3223.75.09 & 75.10
" "	STAIR. DUMPHOUSE	3223-75.11 & 75.12

ELF AQUITAINE NORGE DRAWINGS

CONTAINER PLATFORM MODULE		FF 91 21 34 3100
EXTENTION PLATFORM MODULE		FF 91 21 34 3101
VILLAGE LAYOUT LOWER LEVEL		FF 91 00 00 0017
LIVING QUARTERS	EL+ 131587	FF 91 00 00 0021
" "	EL+ 135382	FF 91 00 00 0022
" "	EL + 141330	FF 91 00 00 0023

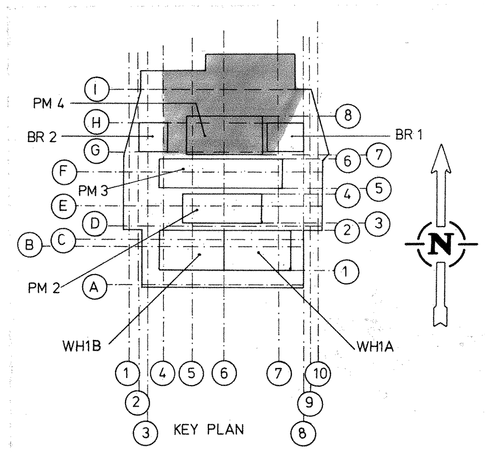

AS BUILT UP TO 20.4.81

REV 1. 29.1.81 - UP TO "AS BUILT"

elf aquitaine norge a/s p.o. box 168 - 4001 Stavanger

date: 4/01/79	CDP1 FRIGG FIELD
drawn by: DRESSENS	LIVING QUARTERS
checked by:	
appr. by:	LAYOUT EL+128570
size:	
draw.no.: FF 91 00 00 0020	scale: 1/50 rev.: 1