
RIG SIDE

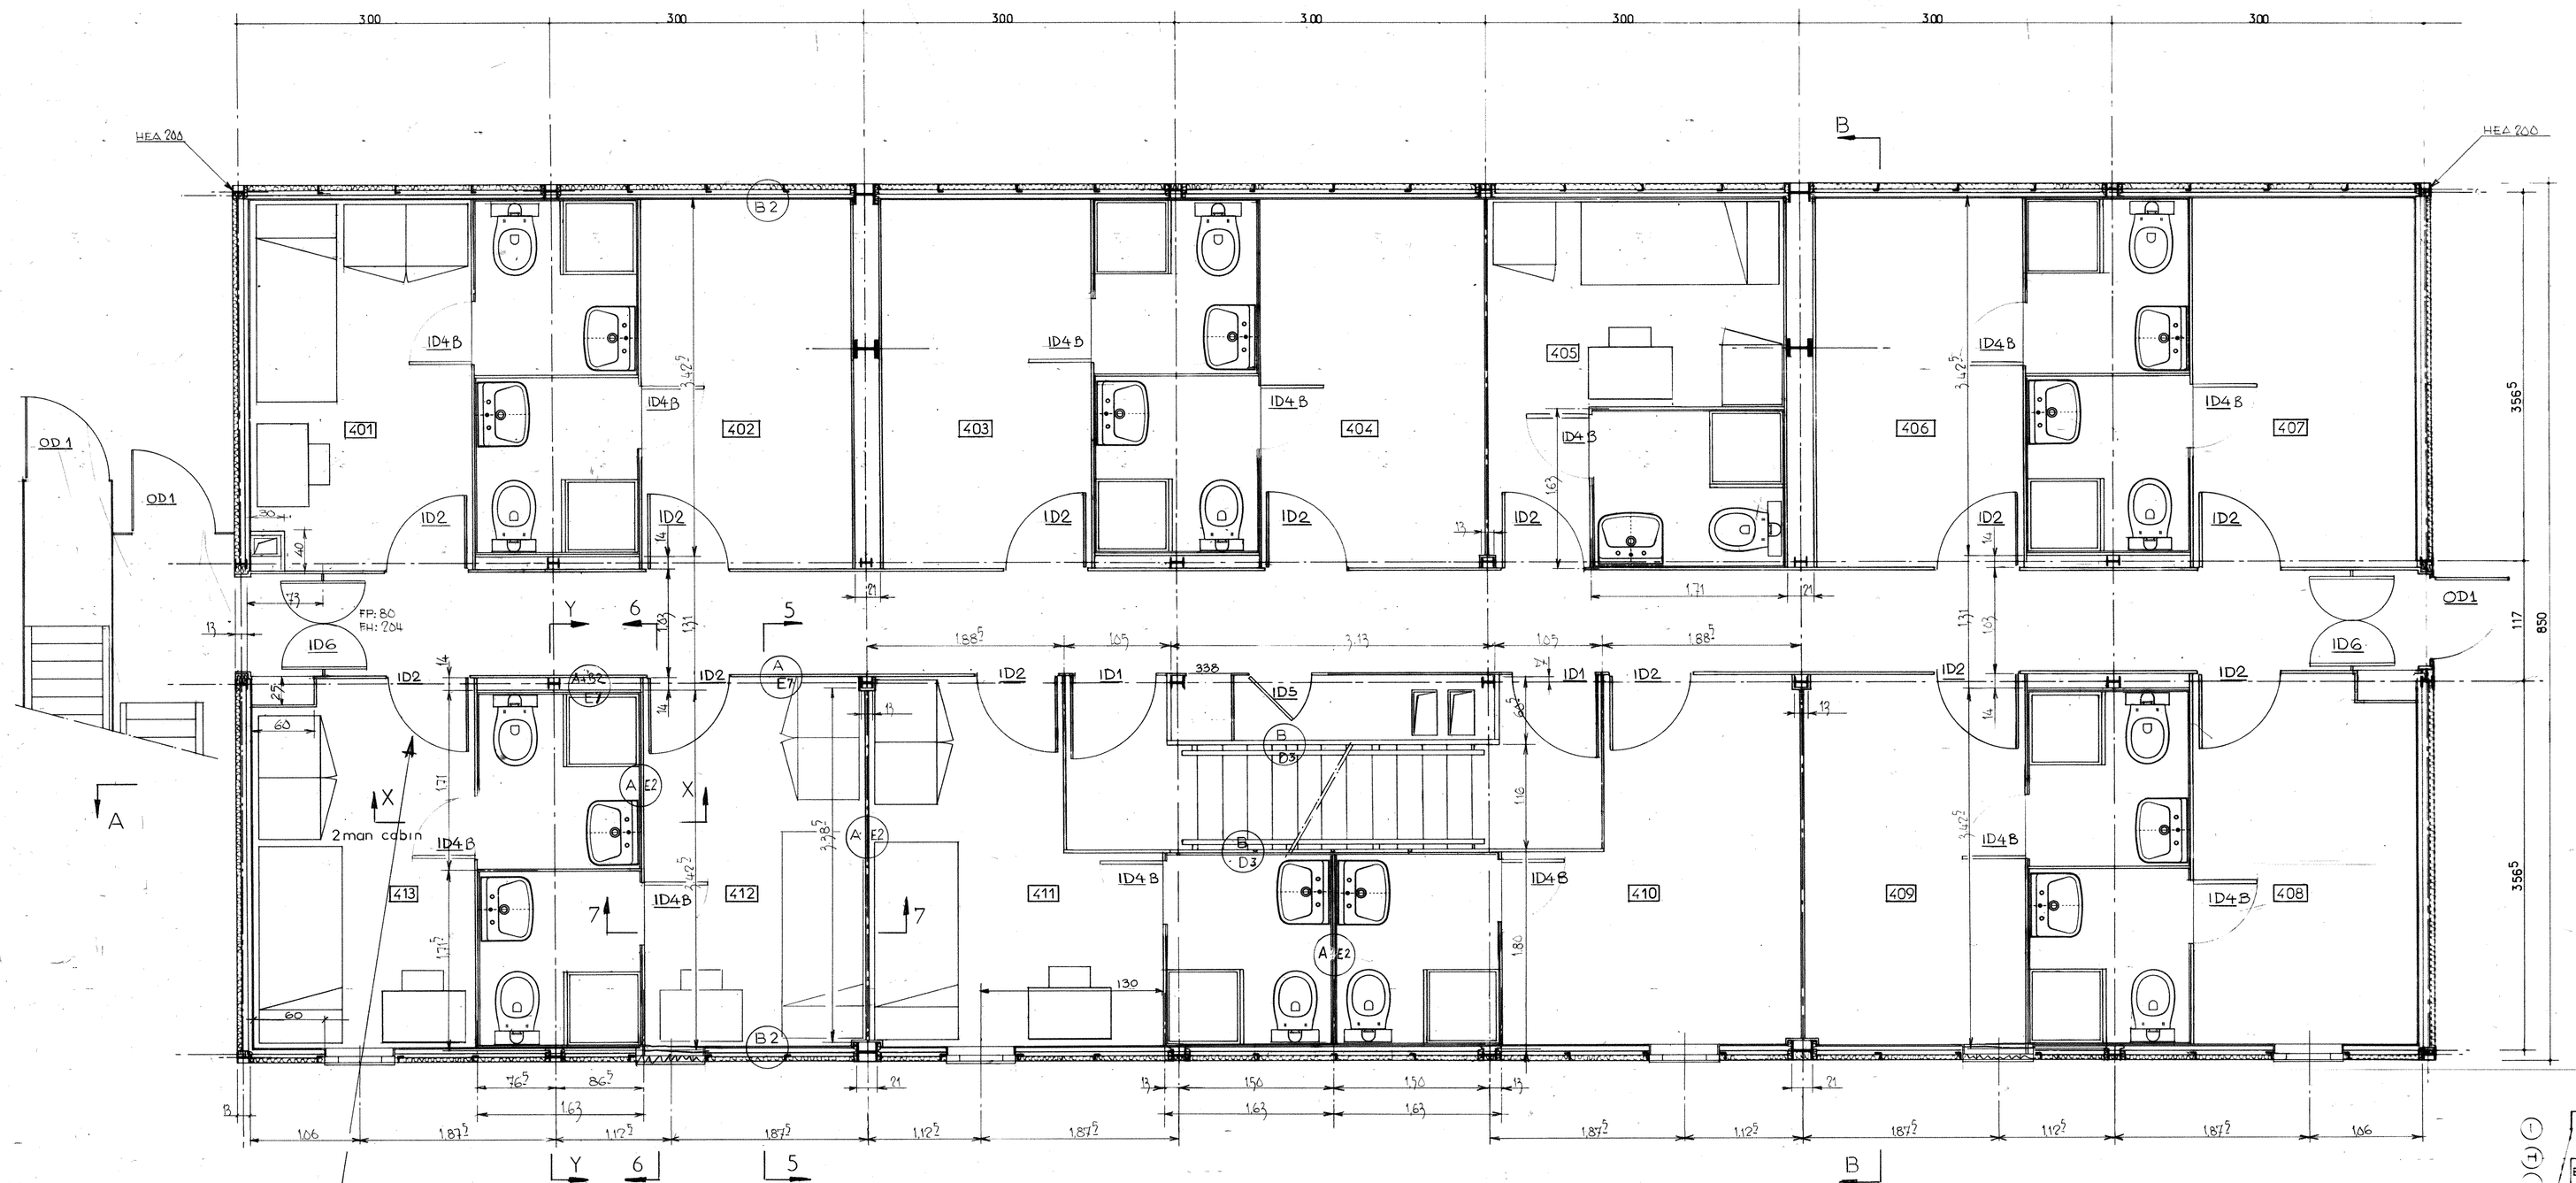

FP: FREE PASSAGE
FH: FREE HEIGHT

OD = OUTSIDE DOORS
OD1 FP 80 x FH (to be checked on site)


ID = INTERNAL DOORS included in to call for bid Bulkheads
ID1 FP 80 x FH 204
ID2 FP 70 x FH 204
ID3 FP 70 x FH 189+step 15
ID4 FP 60 x FH 189+step 15
ID5 FP 60 x FH 204
ID6 FP (2x40) x FH 204
A - DOORS WITH ~~220~~ 360 CM2 VENTILATION GRILLE
B - " " 360 CM2 " "

NOTE: ALL DIMENSIONS ARE THEORITICAL AND REFER TO
- AXIS OF THE POSTS
- EXTERIOR EDGES OF STRUCTURES
- AXIS OF THE BULKHEADS

THEY HAVE TO BE CHECKED ON THE SPOT BEFORE STARTING THE PREFABRICATION AND INSTALLATION WORKS

ABC LETTERS CORRESPONDING TO LOW CONNECTION OF BULKHEADS
DEF " " " " TO HIGH " " "
SEE DWG PDS 000156 - 59 - 60

SEE DRAWINGS
PDS 00002 Details of window sealing
PDS 00020 Longitudinal view AA
PDS 00021 Transverse view BB
PDS 00023 Details 2man room
PDS 00024 Details 3/4 man room
PDS 00057 Details of principle for bulkheads for all levels
PDS 00059 2man room - 3/4 man room : furnitures

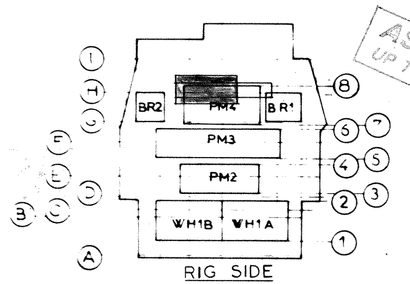

AS BUILT UP TO 20.3.80

IFC

KEY PLAN CDP1

Refer to Isolamin Drawing for panelling

elf aquitaine norge a/s
APPROVED FOR CONSTRUCTION
Name: FUNG
Signature:

REV	DATE	DESIGNATION	DRAWN BY	CHECKED	SPECIALIST	PROJ ENG	CLIENT
G	27.1.81	UP TO "AS BUILT"					
F	24.9.79	added issued for construction 3644 AFC					
E	23.8.79	UPDATED DOORS AND BULKHEADS CONNECTIONS 0168					
D	17.4.79	ADDED DOOR REFERENCE AND DAN NUMBER 1238					
C	27.3.79	Decision according to decision of 21.3.79 EAN-DNV meeting 1238					
B	19.3.79	ADDED LOCATION BULKHEADS 0558					
A		DWG ISSUE 3644					

THIS DOCUMENT IS THE PROPERTY OF E.A.N AND SUPPLIED IT SHALL NOT BE COPIED NOR COMMUNICATED TO A THIRD PARTY WITHOUT PRIOR AUTHORISATION

SCALE 1 / 25

elf aquitaine norge a/s p.o. box 168 - 4001 Stavanger

date:	
drawn by	
checked by	
appr. by	
sizes	
draw. no.	FF 91 00 34 2016

CDP1 FRIGG FIELD
SAIPEM INTEGRATION
ARCHITECTURE
SAIPEM LQ - 2nd LEVEL
PLAN VIEW

scale: 1/25 REV.: G

SOFRESID
REFERENCE NUMBER: PDS 00008 F
CLASSIFICATION CODE: G 4 2