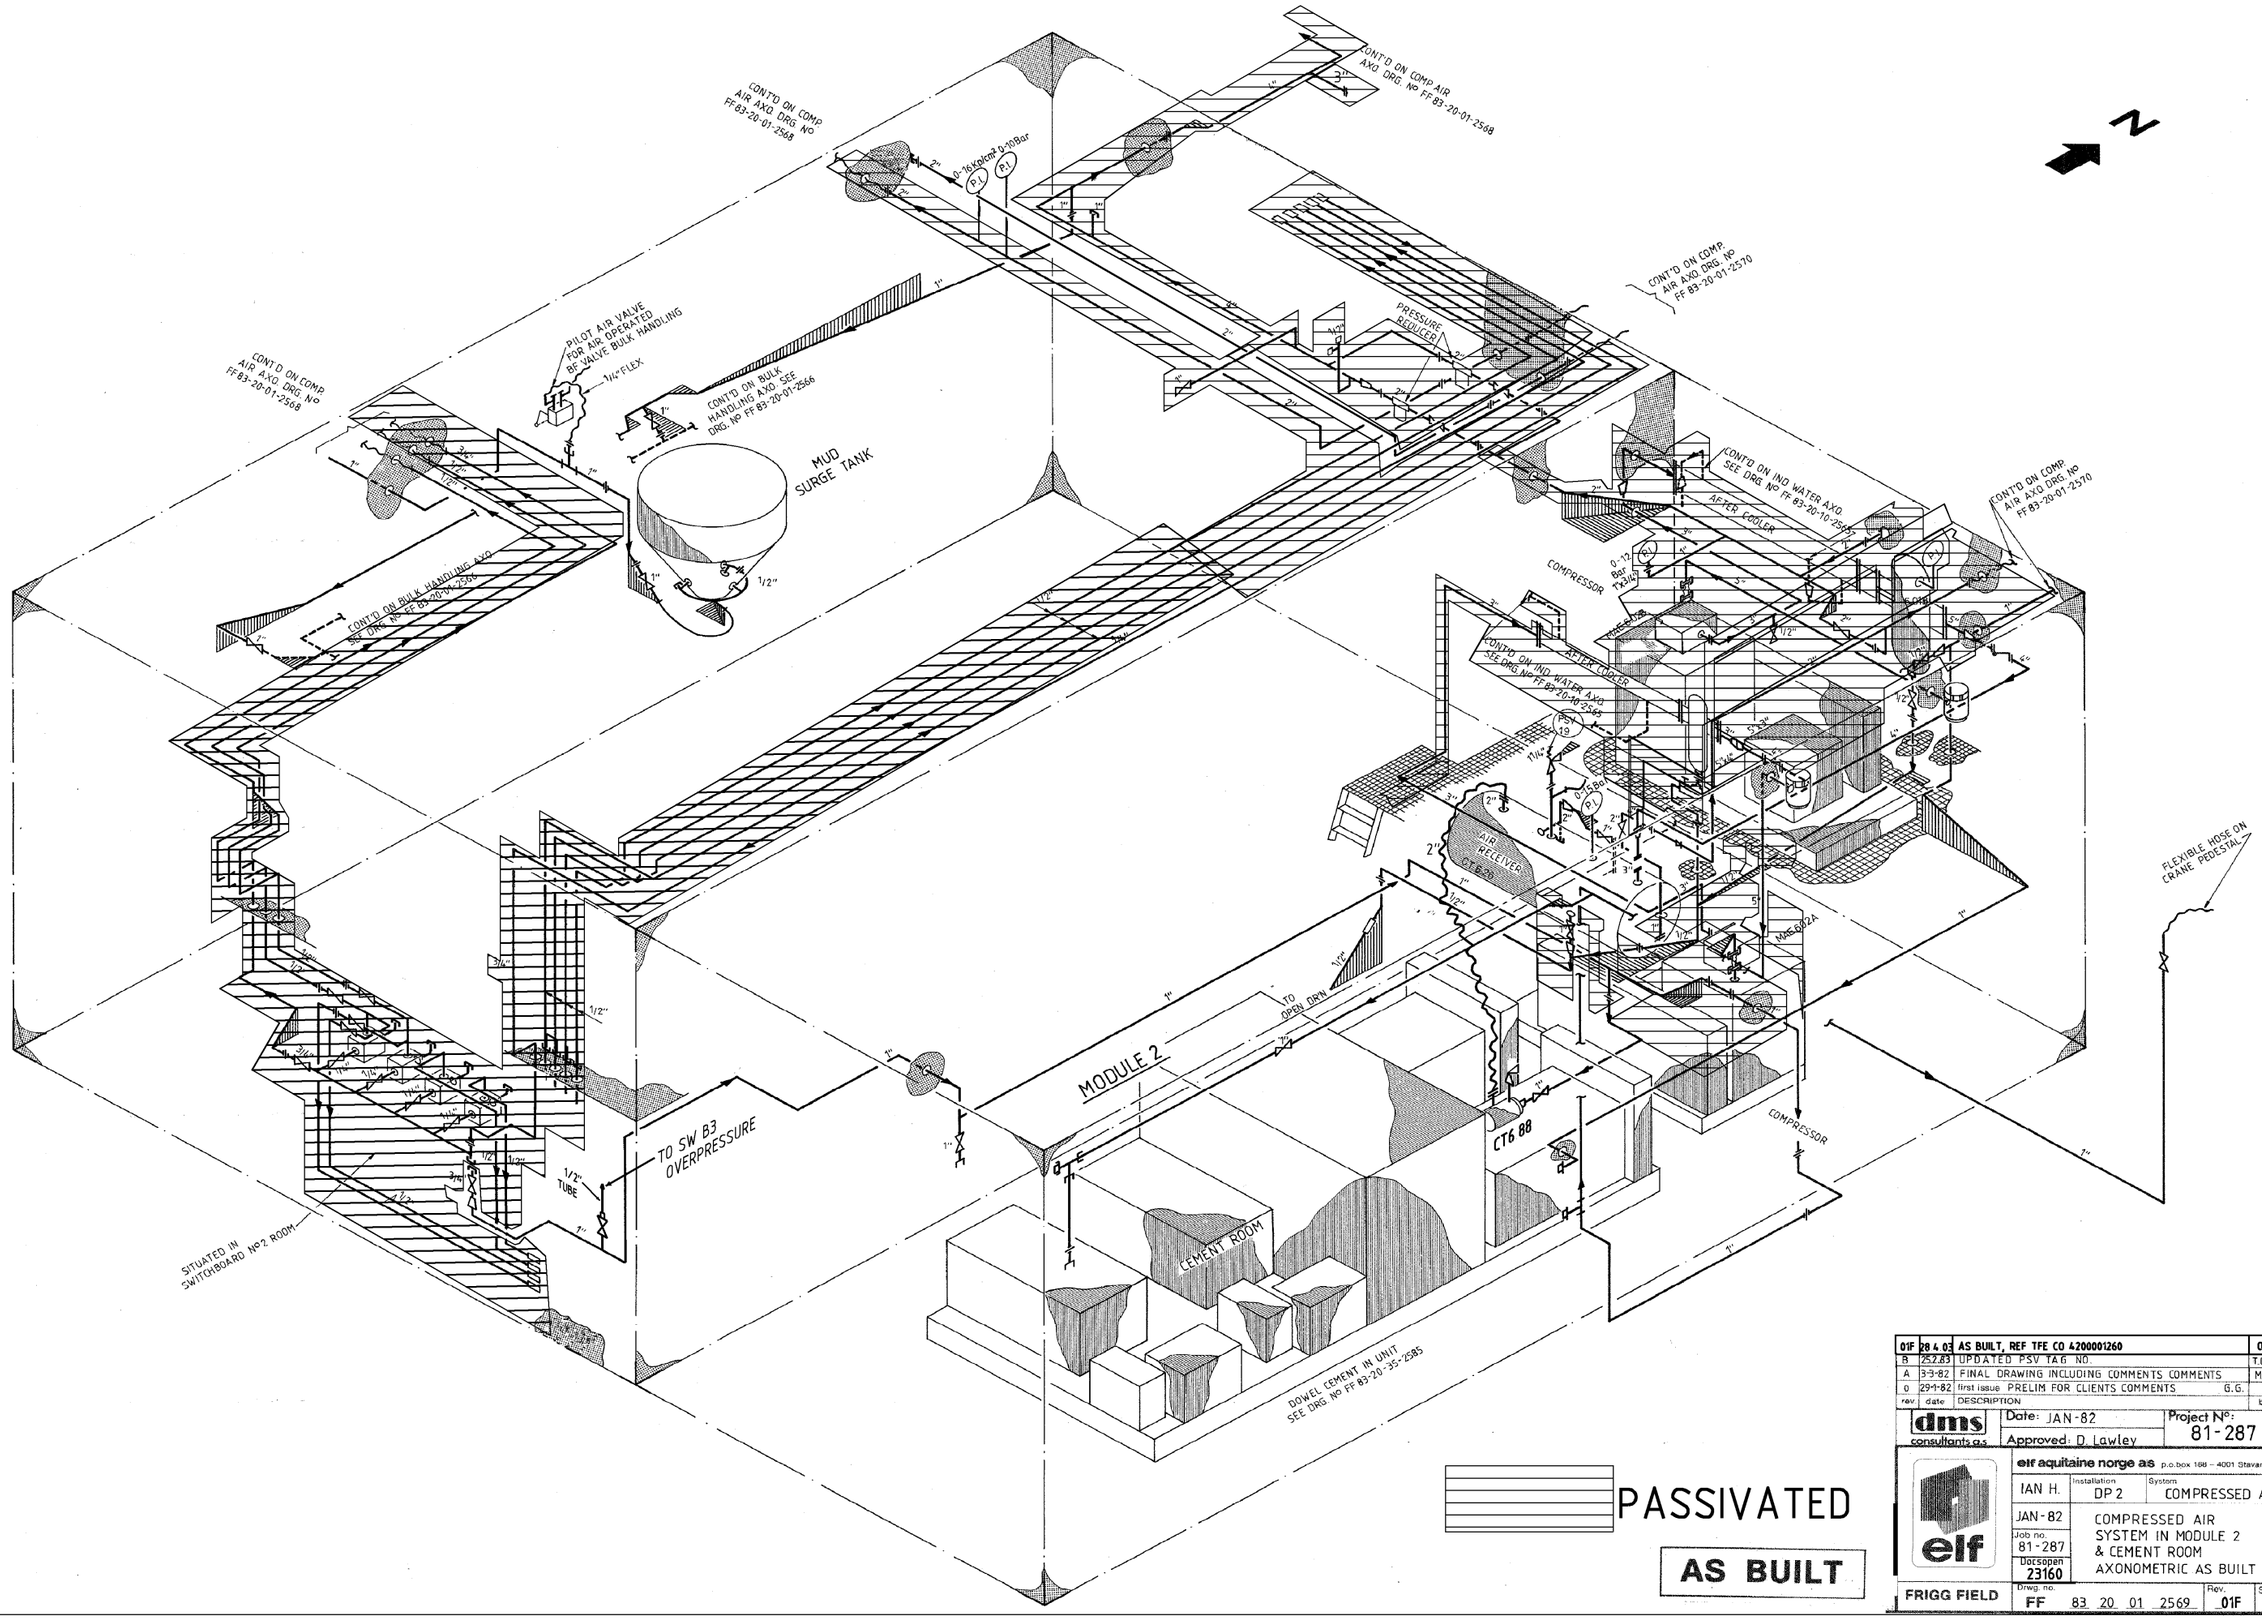

rev	date	DESCRIPTION	by	app
01F	28 4 03	AS BUILT, REF TFE CO 4200001260	OP	RWJ
B	25.2.83	UPDATED PSV TAG NO	T.O	
A	3-3-82	FINAL DRAWING INCLUDING COMMENTS COMMENTS	M.D.	
0	29-1-82	first issue PRELIM FOR CLIENTS COMMENTS	G.G.	

dms consultants as

Date: JAN-82

Approved: D. Lawley

Project N°: 81-287

elf aquitaine norge as p.o.box 168 – 4001 Stavanger

elf

IAN H.

Installation: DP 2

System: COMPRESSED AIR

JAN-82

Job no. 81-287

Docsopen 23160

COMPRESSED AIR SYSTEM IN MODULE 2 & CEMENT ROOM AXONOMETRIC AS BUILT

FRIGG FIELD

Drwg. no. FF 83 20 01 2569

Rev. 01F

Sheet 1/1

DIN A1 Format ISO 216 - C 1985