


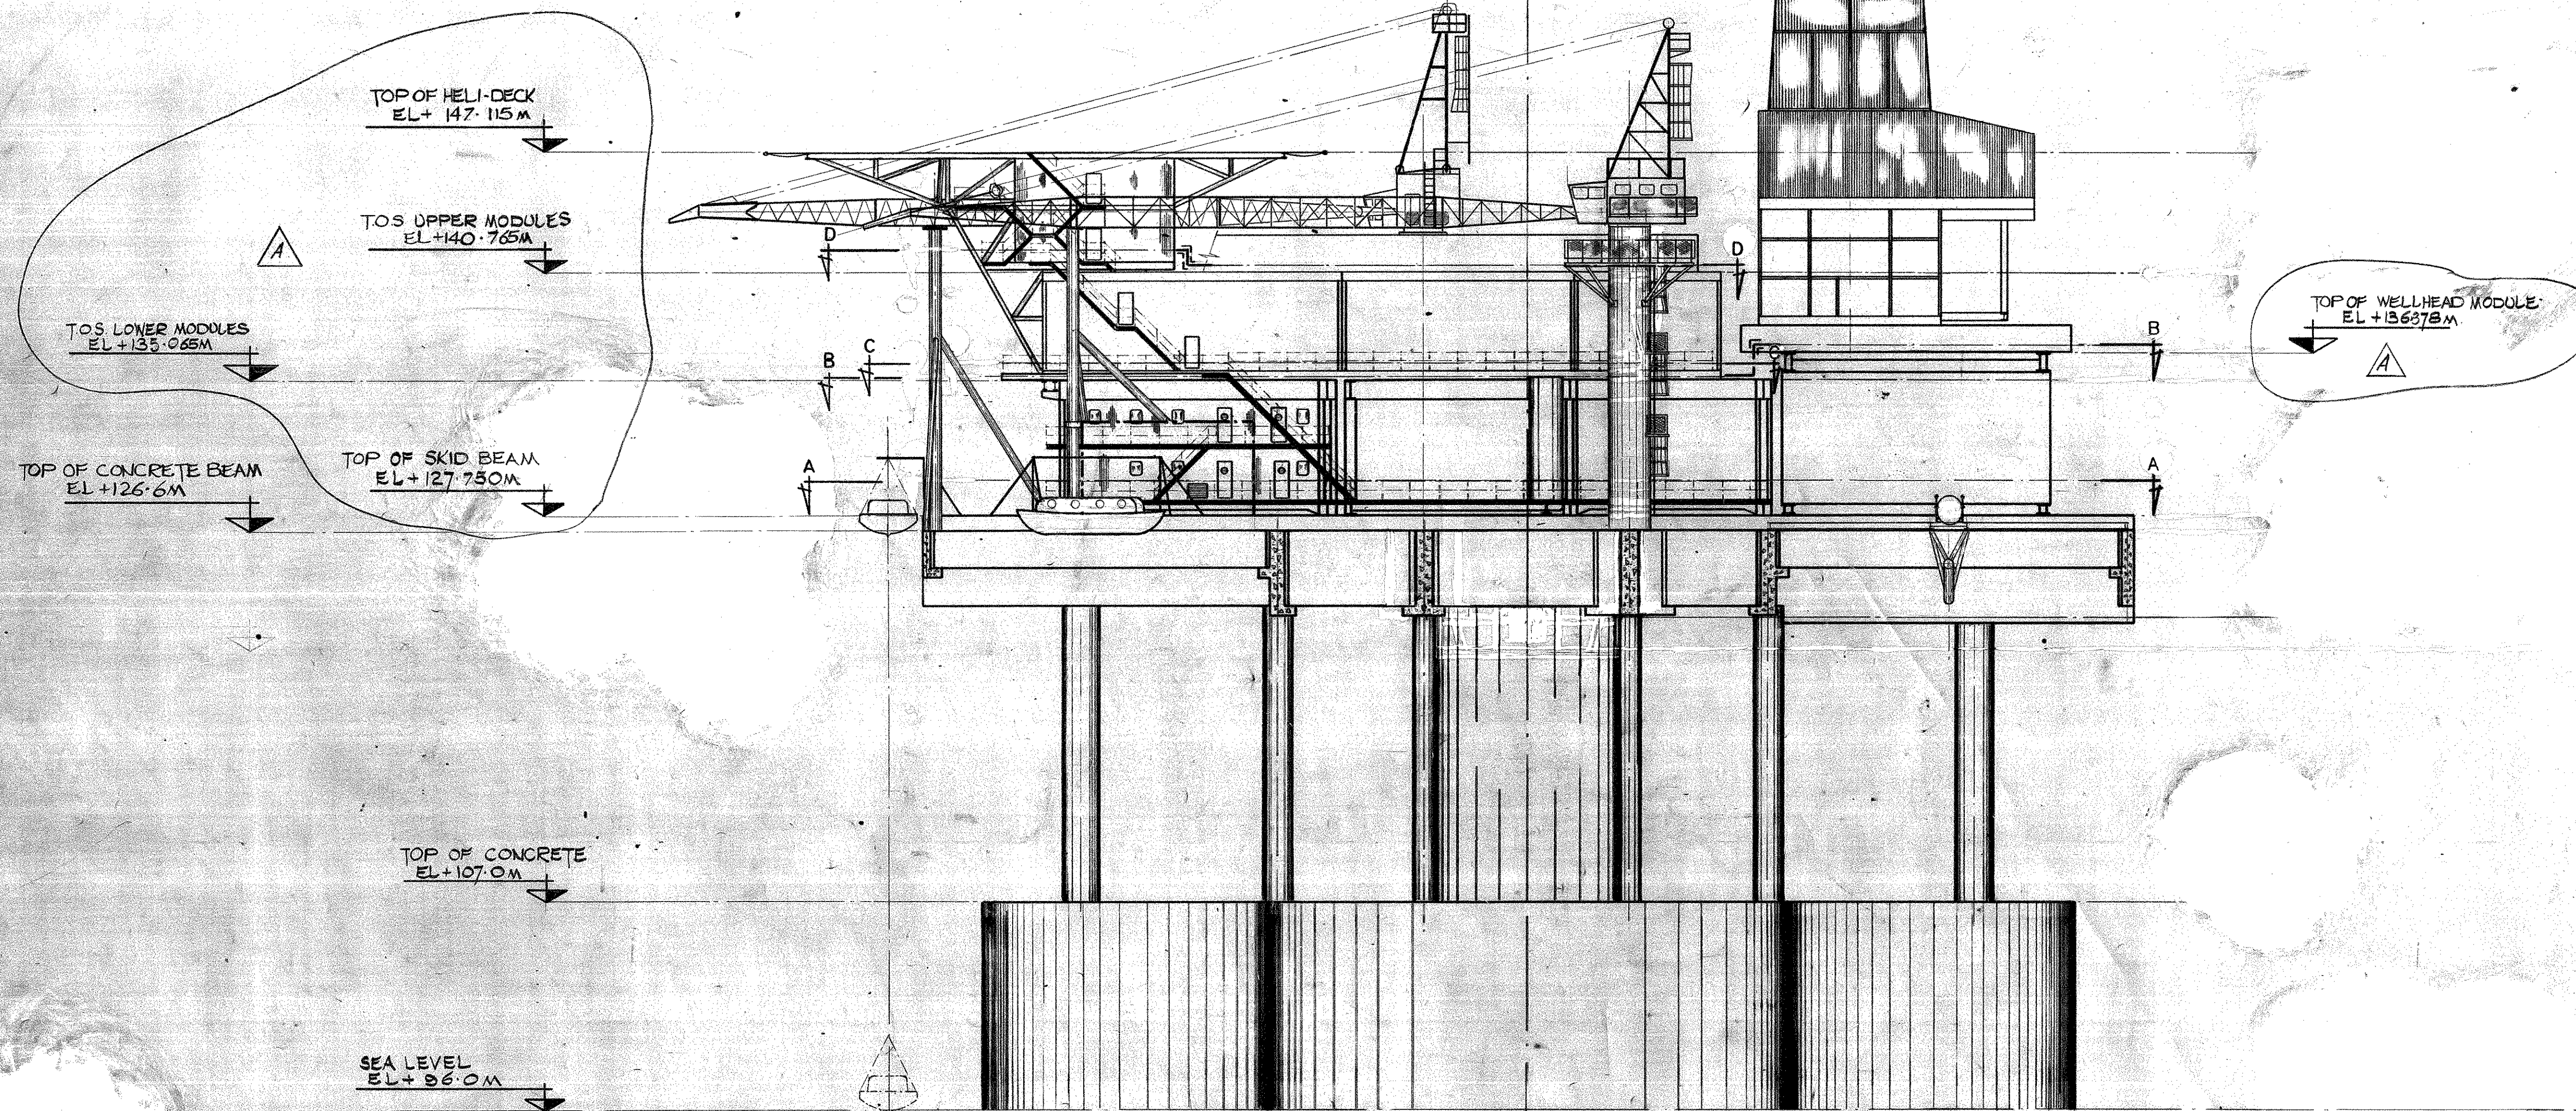


BROWN & ROOT(UK) LTD REF DRGS

EN-AA-002 EAST ELEVATION ON MODULES
 EN-AA-003 NORTH ELEVATION ON MODULES
 EN-AA-004 G.A. OF MODULES ON PLATFORM
 EN-AA-005 UPPER MODULE ROOF PLAN EL+140.765M
 EN-AA-006 UPPER MODULE FLOOR PLAN EL+135.065M
 EN-AA-007 LOWER MODULE ROOF PLAN EL+135.065M
 EN-AA-008 LOWER MODULE FLOOR PLAN EL+128.541M
 EN-AA-009 MAIN DECK, CONCRETE BEAM LAYOUT EL+126.600M
 EN-AA-010 PLAN ON SERVICE DECK EL+120.4M
 EN-AA-016 FLOOR PLAN ON MODULES BR/4 BR/2 EL+128.541M
 EN-AA-018 CRANE AND LIFE BOAT POSITIONS

WEST ELEVATION ON MODULES

PROPRIETARY INFORMATION

This drawing/report/document contains proprietary information belonging to Brown & Root, Inc. and may not be wholly or partially reproduced nor disclosed without prior written permission of Brown & Root, Inc.

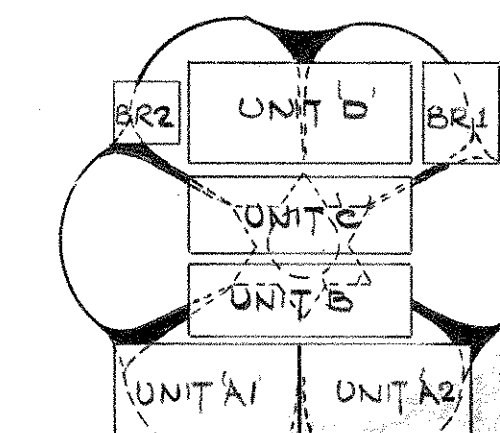

NOTES

REVISION BY DATE

REVISION BY DATE

Brown & Root, (U.K.) Ltd.



Engineers-Constructors
 LONDON, ENGLAND.

DRAWN BY: E. FOURNEL

DATE: 9.4.75

CHK'D BY:

DATE:

SCALE: 1:200

APPROVED

APPROVED

SEAL

TITLE OF DRAWING: WEST ELEVATION ON MODULES

MPX-DPI CONVERSION

NAME OF OWNER: ELF-NORGE A/S

LOCATION OF PROJECT: FRIGG FIELD

CONTRACT NO. 1-40-A3

DRAWING NO. B-EN-AA-017

SHEET OF