



LONGITUDINAL SECTION THROUGH TUNNEL 'F'

- NOTES.**
1. REFERENCE ELECTRODES TO BE SECURED TO 26" LINE BY CLAMPING. WELDING IS NOT PERMITTED. (SEE DETAIL A)
 2. ZINC BRACELET ANODES TO BE CONNECTED TO 26" LINES BY THERMO WELDING (ONE CABLE TAIL AT EACH END OF ANODE)
 3. TO ENSURE ELECTRICAL ISOLATION OF RISERS HYDRAULIC LINES TO PIPE CLAMPS TO BE REMOVED PRIOR TO FINAL FLOODING OF CORE.
 4. 26" LINES COATED WITH COAL TAR EPOXY IN ACCORDANCE WITH PARA. 14 OF B.S.R. SPEC. MPX-DPI X-1.
 5. ANODES & REF ELECTRODES TO BE SUPPLIED AND INSTALLED IN ACCORDANCE WITH CCSC SPEC. NO. CD P1-P-10/13.

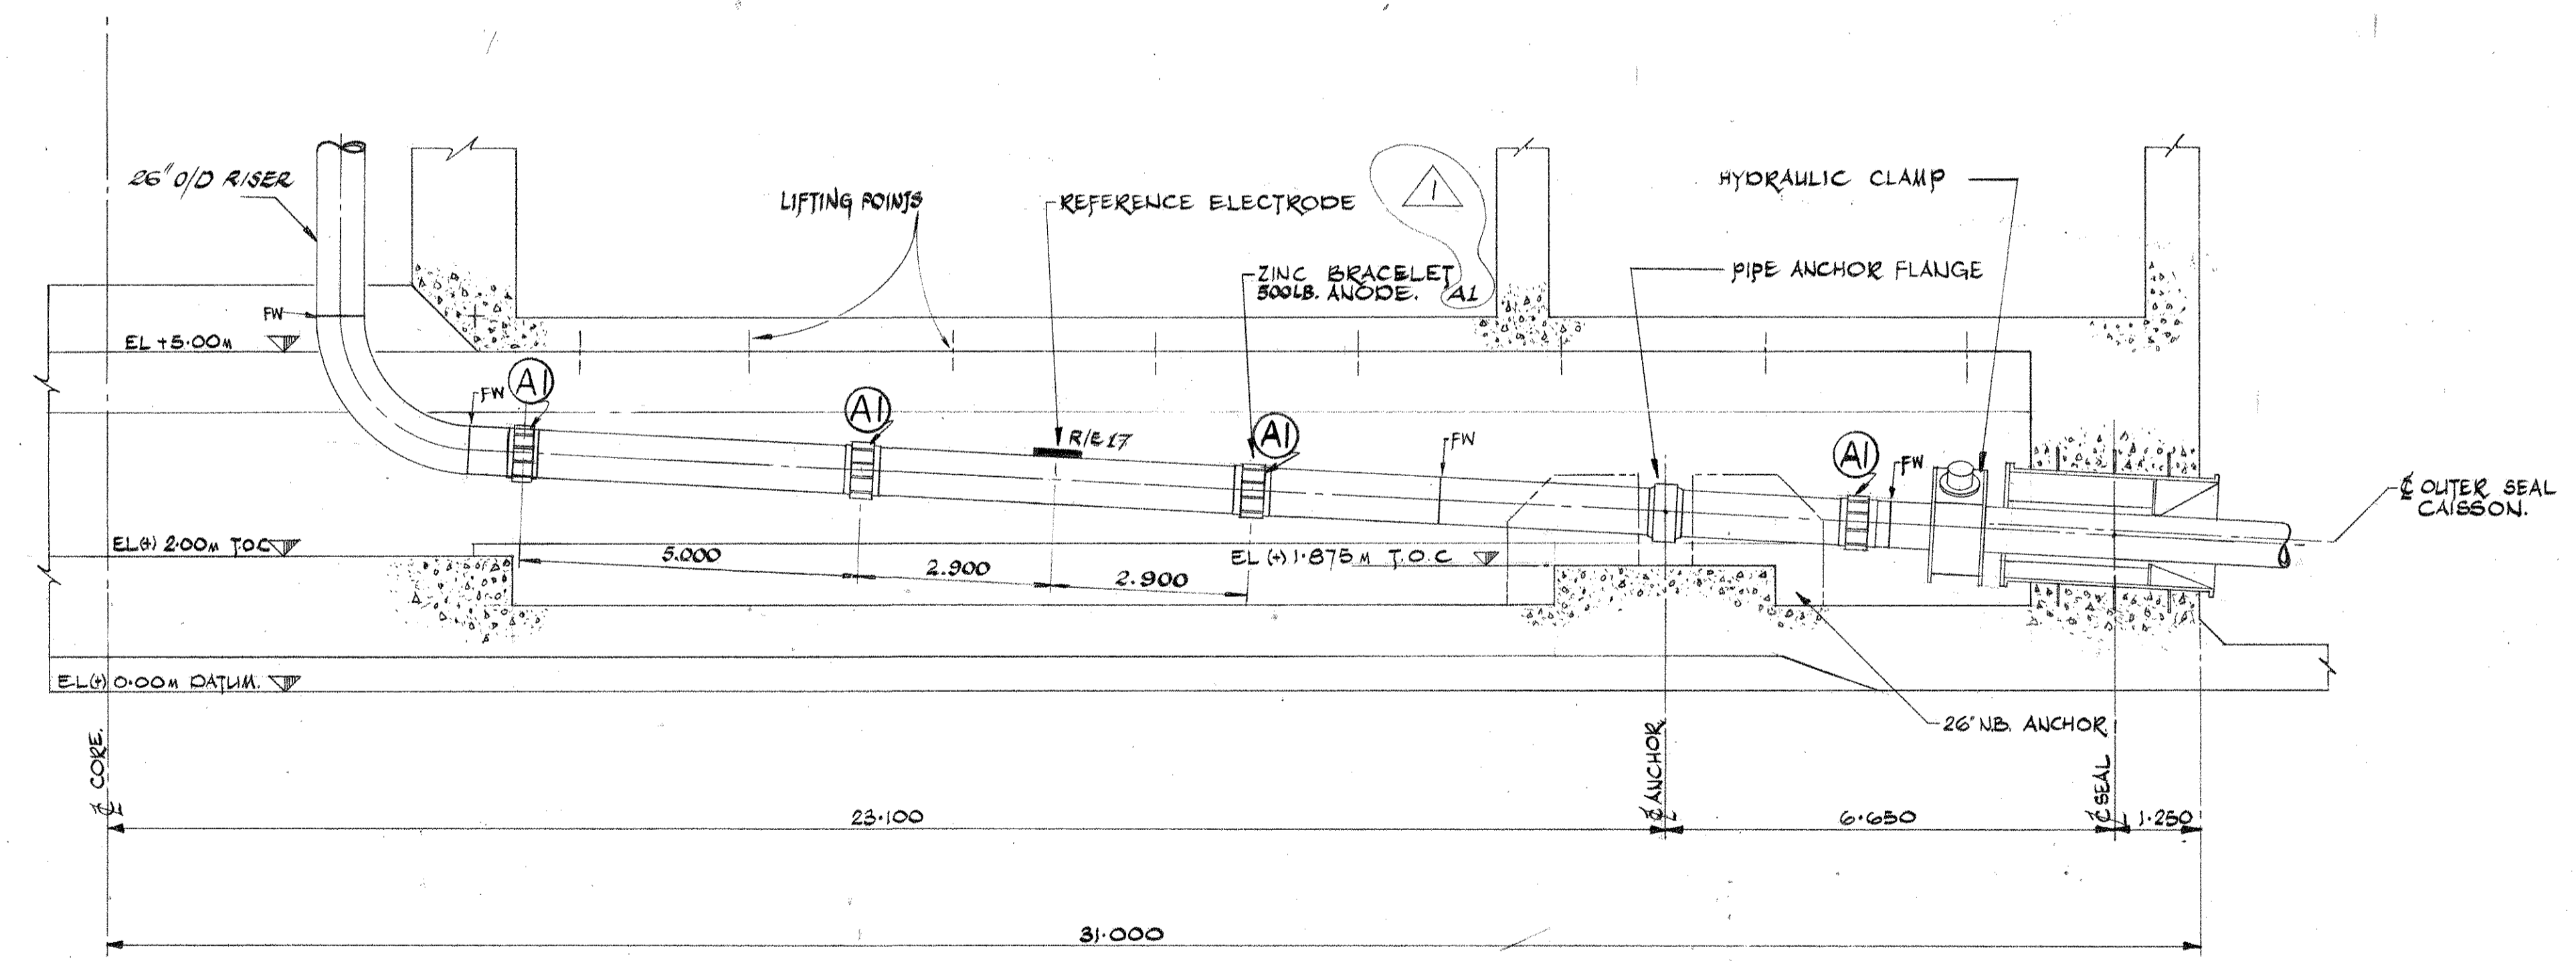

LONGITUDINAL SECTION THROUGH TUNNEL 'A'

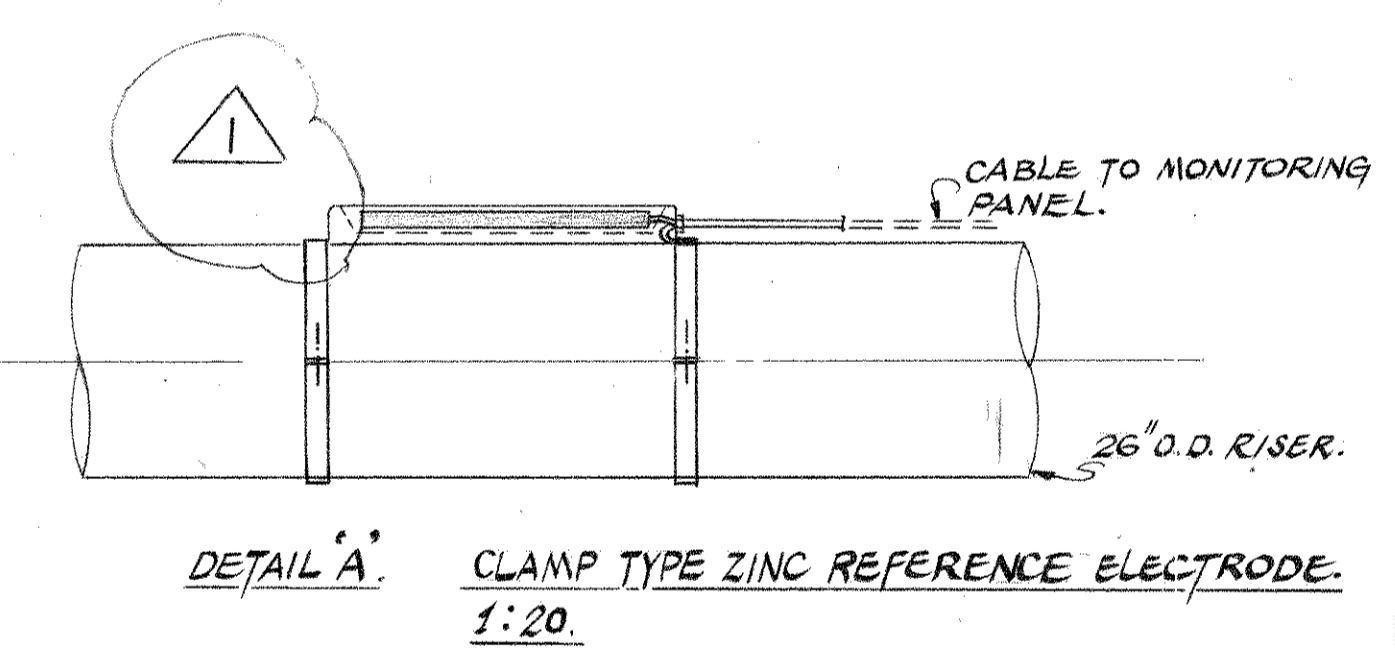

SEE DRG. A1-MPX-DPI/M7345 FOR ARRGT. OF ANODES & REF. ELECT^s IN CORE.

- NOTES.**
1. ANODES MUST NOT BRIDGE FIELD WELDS.

PROPRIETARY INFORMATION
 This drawing/report/document contains proprietary information belonging to Brown & Root, Inc. and may not be wholly or partially reproduced nor disclosed without prior written permission of Brown & Root, Inc.

REFERENCE DRAWINGS		REV. NO.	REVISION	BY	DATE	CHKD
NUMBER	TITLE					
		0	ISSUED FOR CONSTRUCTION			
		1	REMOVE BOND CONNECTIONS SEE NOTE 2.	CC	21/4/75	DWN
		2	RENUMBERED & STATUS ADDED	CC	26/4/75	
		3	RENUMBERED	TB	1/4/86	

CORROSION CONSULTING SERVICES INC		APPROVED <i>B.S.D.</i> 28/5/75		Brown & Root, (U.K.) Ltd. Engineers-Constructors LONDON, ENGLAND.		(A) TOTAL OIL MARINE LIMITED LONDON FRIGG FIELD. MPX DPI CONVERSION ANODES/REF ELECTRODES-RISERS IN TUNNELS A&F.	
SCALE	PROJECT No.	DRAWING NUMBER	REV.	BY	CHECKED	CHECKED	APPROVED
1:75 UNLESS NOTED.	2147	FF 91 36 28 1809	3	C.B. NEWBY	1/4/75		
				DATE	7th MAY, 1975		