


NOTE:-
13 IN. NO. 500/lb. BRACELET ANODES (TYPE A4)
EQUALLY SPACED FOR A DISTANCE
OF 150m. OUT FROM PLATFORM.


BRACELET ANODES
 TYPE A2 — 150 lbs. — BEVELLED-BOLTED TYPE.
 TYPE A3 — 75 lbs. — " " "
 TYPE A4 — 500 lbs. — " WELDED STRAPS.

NOTES.
 1. BRACELET ANODES TO BE POSITIONED AS SHOWN
 AND INSTALLED IN ACCORDANCE WITH SPECIFICATION
 TP-M-103 REV. 2.
 2. DIMENSION δ MUST BE MAINTAINED TO PREVENT
 POSSIBLE DAMAGE TO SEAL DURING PULL IN.
 3. LEADING EDGE OF CONCRETE BEVELLED TO AN
 ANGLE OF 30°. POINT 'A' DENOTES TERMINATION
 OF COAL TAR ENAMEL COATING 100mm. FORWARD OF ANODE
 ON 8" & 4" LINES AND 100mm. FORWARD OF
 CONCRETE ON 26" LINES.

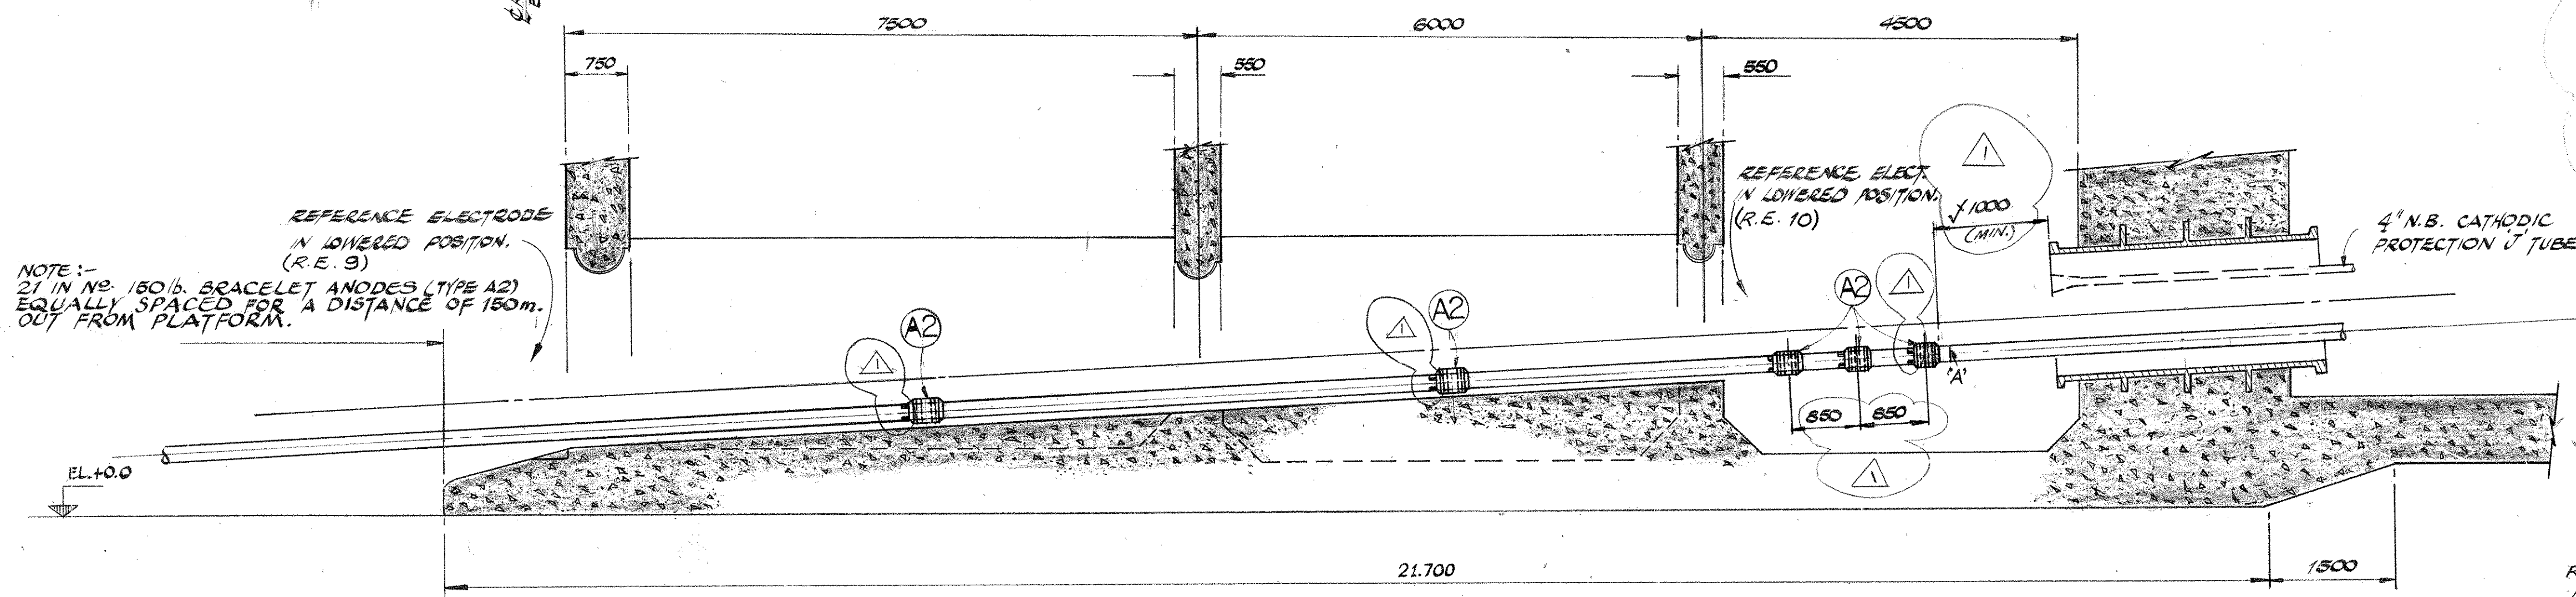

NOTE:-
21 IN. NO. 150/lb. BRACELET ANODES (TYPE A2)
EQUALLY SPACED FOR A DISTANCE OF 150m.
OUT FROM PLATFORM.

REF. DRGS.
 A1-MPX-DPI/M7345 - ARRGT ANODES & REF ELECTRODES ON
 RISERS IN CENTRAL CORE & TUNNELS B & E
 A1-MPX-DPI/M7346 - ARRGT ANODES & REF ELECTRODES
 ON RISERS IN TUNNELS A & F.
 FOR LINK UP SUBMARINE PIPE LINES TO TPI
 SEE DRG. NO. A1-TP-L-335.
 FOR POSITION ZINC REF. ELECTRODES SEE
 DRG. P7141.

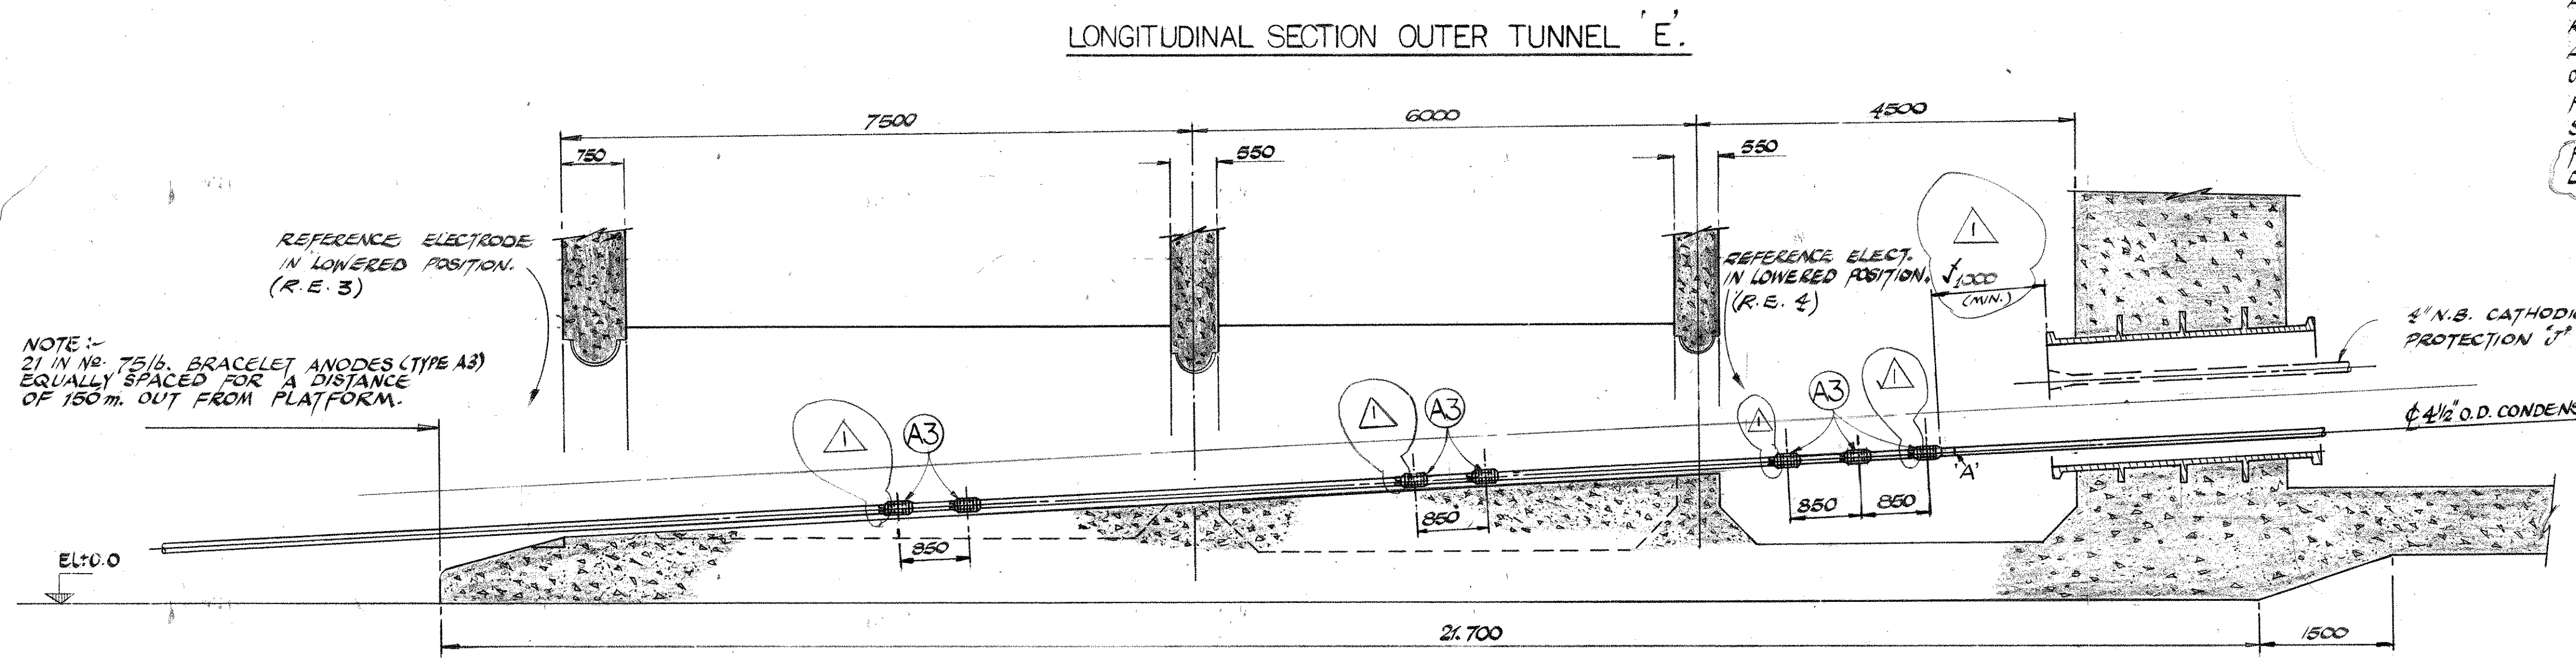

NOTE:-
21 IN. NO. 75/lb. BRACELET ANODES (TYPE A3)
EQUALLY SPACED FOR A DISTANCE
OF 150m. OUT FROM PLATFORM.

PROPRIETARY INFORMATION
 This drawing/report/document contains
 proprietary information belonging to Brown &
 Root, Inc. and may not be wholly or partially
 reproduced nor disclosed without prior written
 permission of Brown & Root, Inc.

CORROSION CONSULTING SERVICES INC.	APPROVED.	<i>Burda</i>	28/5/75	REFERENCE DRAWINGS	REV. NO.	REVISION	BY	DATE	CHKD.	Brown & Root. (U.K.) Ltd. Engineers-Constructors. LONDON, ENGLAND.	Brown & Root Logo	Brown & Root. (U.K.) Ltd. Engineers-Constructors. LONDON, ENGLAND.	TOTAL OIL MARINE LIMITED LONDON	FRIGG FIELD MPX DPI CONVERSION. CATHODIC PROTECT ² TO PIPES IN OUTER TUNNELS	SCALE	PROJECT No.	DRAWING NUMBER	REV.					
				NUMBER	TITLE	0	ISSUES FOR CONSTRUCTION								1	ANODES REVERSED, CONCRETE LENGTHS, NOTES REVISION	AS/TS	B-3	1:50.	2147	FF 91 36 28 1810	4	
						2	RENUMBERED & STATUS ADDED.	CS	26/4/75							3	RENUMBERED	TB	1/1/75				