
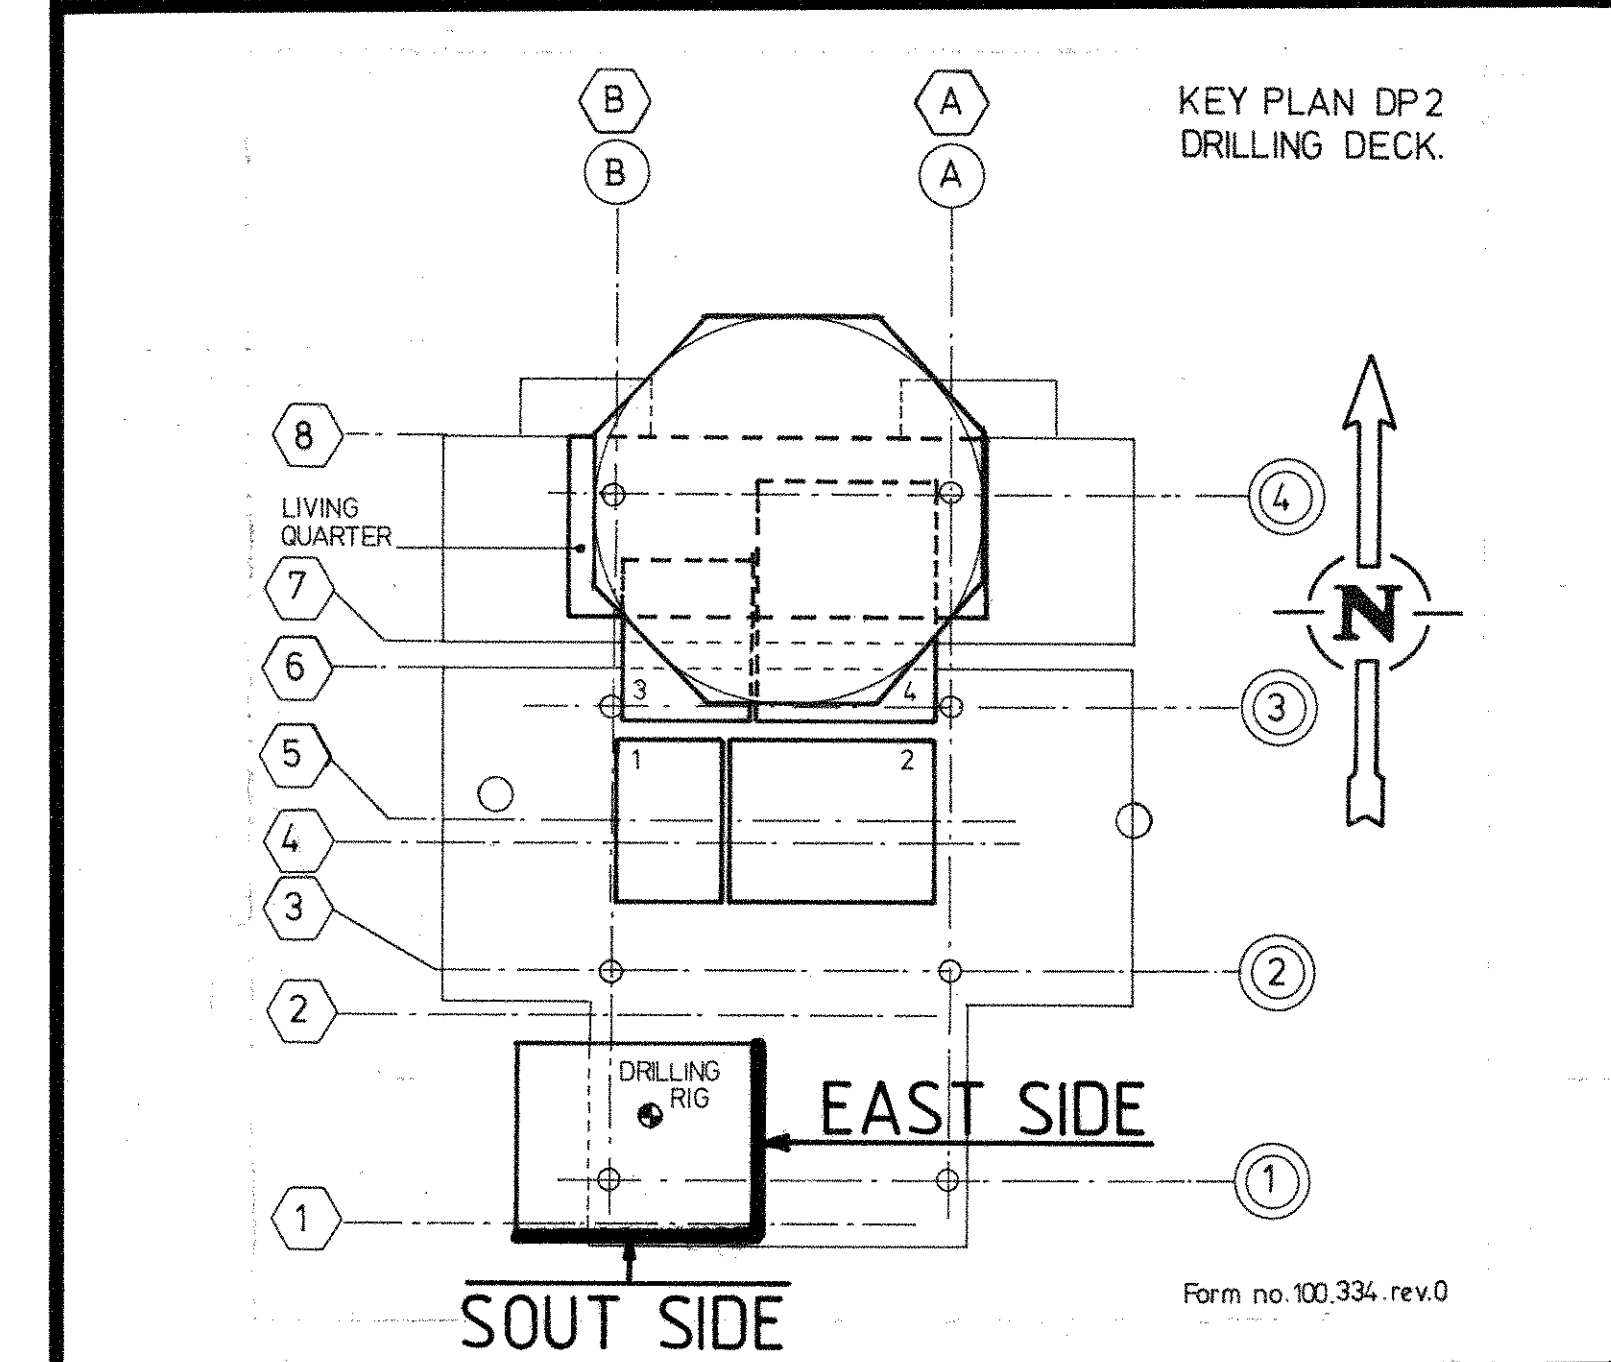


NOTES:
 ANGLE ORIENTATION: FIRST FIGURE GIVEN ON DRAWING IS VERTICAL DIMENSION.
 RIGHT SIDE OF DERRICK SIDE PLANS SHOWS ORIGINAL DESIGN, LEFT SIDE SHOWS REINFORCEMENTS AS BUILT.
 NORTH- AND WEST SIDE, SEE DRWG. FF 83 21 28 5077
 GIN POLE IS NOT SHOWN ON THESE DRAWINGS.

REFERENCE DRAWINGS:
 Con-Ecosse: FF 83 21 28 5029
 EAN FF 83 21 28 5040
 5042
 5072
 5073

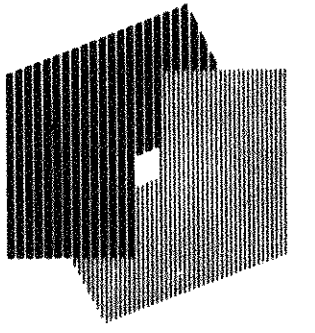

rev.	date	DESCRIPTION	by	app.
1	29.04.86	GEN. REV.		PEL
0	03.08.84	first issue		PEL

	elf aquitaine norge a/s p.o.box 168 - 4001 Stavanger	
	Installation	System
	DP 2	STRUCTURAL
	A DP 2 DRILLING DERRICK PROFILE LAYOUT NORTH AND WEST SIDE	
Job no.		
Scale		
FRIGG FIELD	Drwg. no. FF 83 21 28 5076	Rev. 1