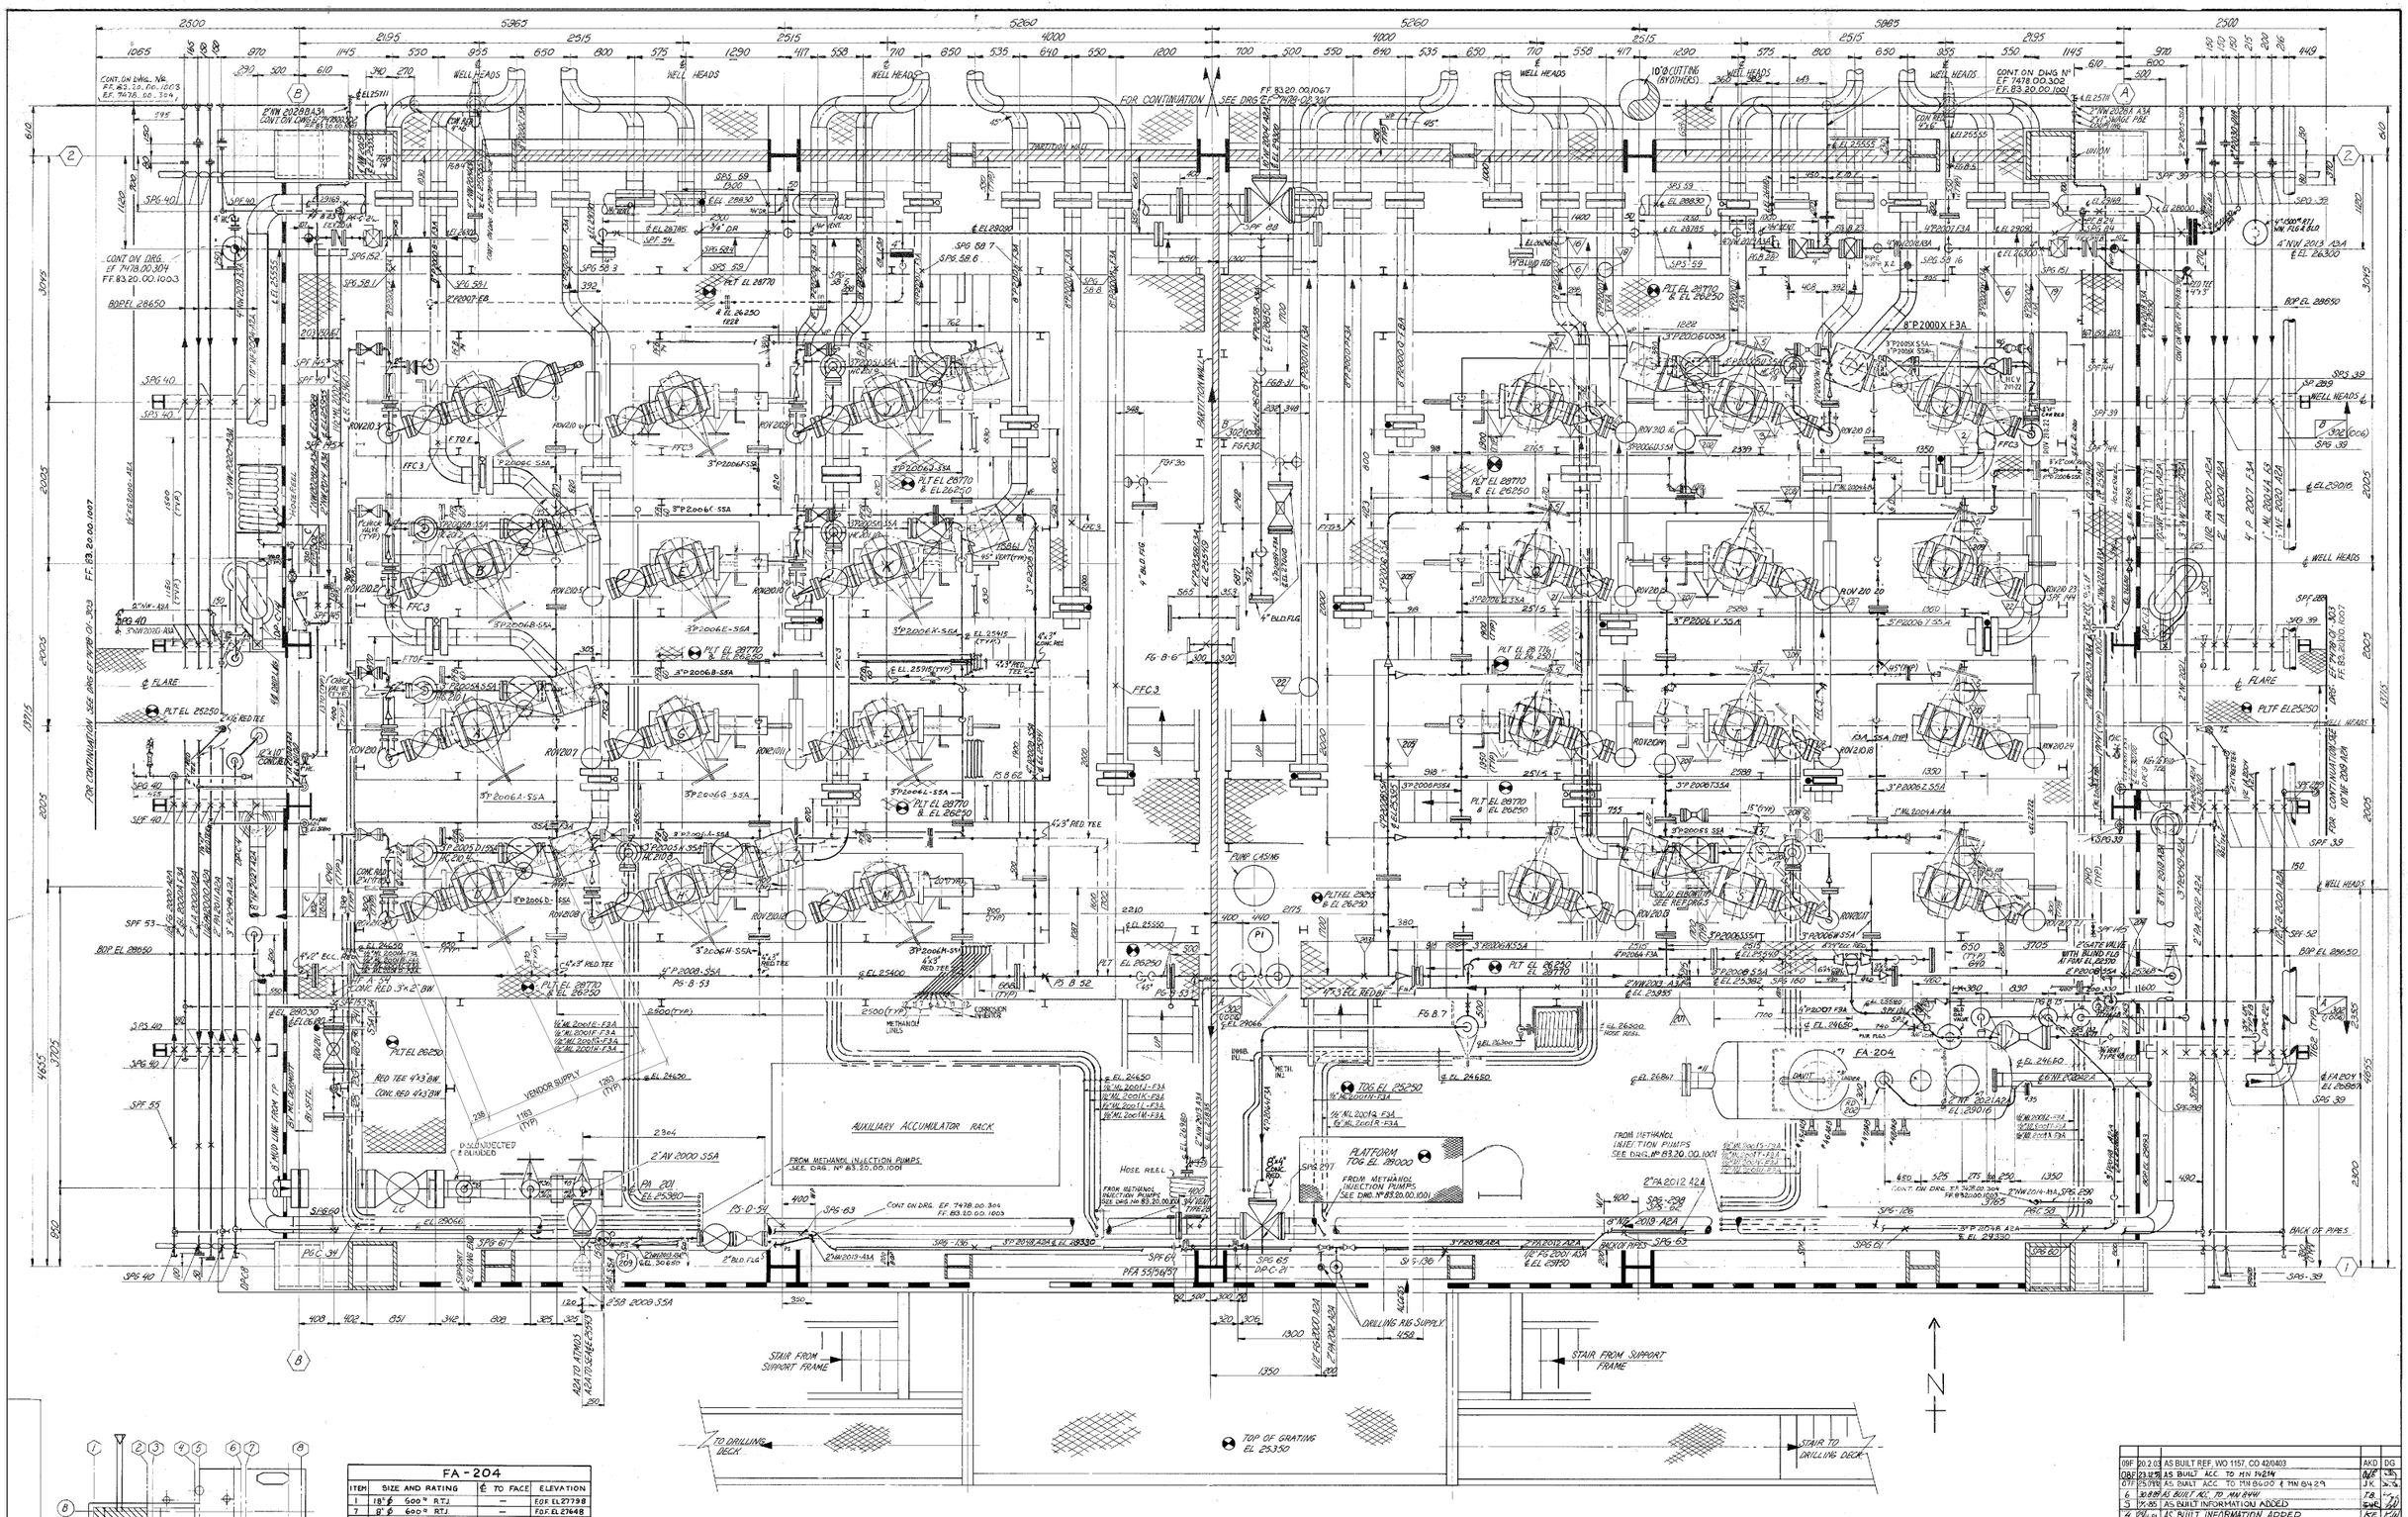
FOR CONTINUATION SEE DRG EF 7478.00.304 FF 83.20.00.1003
FOR CONTINUATION SEE DRG EF 7478.00.302 FF 83.20.00.1001
FOR CONTINUATION SEE DRG EF 7478.00.303 FF 83.20.00.1002
CONT ON DRG. EF 7478.00.304 FF 83.20.00.1003
CONT ON DWG. No. EF 7478.00.304
CONT ON DWG Nº EF 7478.00.302 FF 83.20.00.1001
AUXILIARY ACCUMULATOR RACK
PLATFORM TOG EL 29000
PARTITION WALL
PUMP CASING
METHANOL LINES
CORROSION INHIBITORS
VENDOR SUPPLY
DRILLING RIG SUPPLY
FROM METHANOL INJECTION PUMPS SEE DWG. Nº 83.20.00.1001
FROM METHANOL INJECTION PUMPS SEE DRG. Nº 83.20.00.1001
TO METHANOL INJECTION PUMPS SEE DRG. Nº 83.20.00.1001
STAIR FROM SUPPORT FRAME
STAIR TO DRILLING DECK
TO DRILLING DECK
TOP OF GRATING EL 25350
BACK OF PIPES
WELL HEADS
FLARE
PLT EL 25250
PLT EL 28770 & EL 26250
PLT EL 26850
PLT EL 28770
BOP EL 28650
BOP EL 28600
BOP EL 28300
TOG EL 25250
TOG EL 29000
